


ACCESS ROAD STA. 20+20.00  
 BEGIN CONSTRUCTION  
 FERRISBURGH CMG PARK(15)SC

ACCESS ROAD STA. 20+00.00 =  
 VT ROUTE 22A STA. 38+05.20



PROJECT NAME: FERRISBURGH/VERGS-FERRISBURGH  
 PROJECT NUMBER: CMG PARK (15)S/STP EHO(2)  
 FILE NAME: ...PlotFiles\41-49\sections.plt PLOT DATE: 4/19/2006  
 PROJECT LEADER: WLD DRAWN BY: MBL  
 DESIGNED BY: CSP/GGG CHECKED BY: GAS  
 ACCESS ROAD CROSS SECTIONS SHEET 45 OF 65

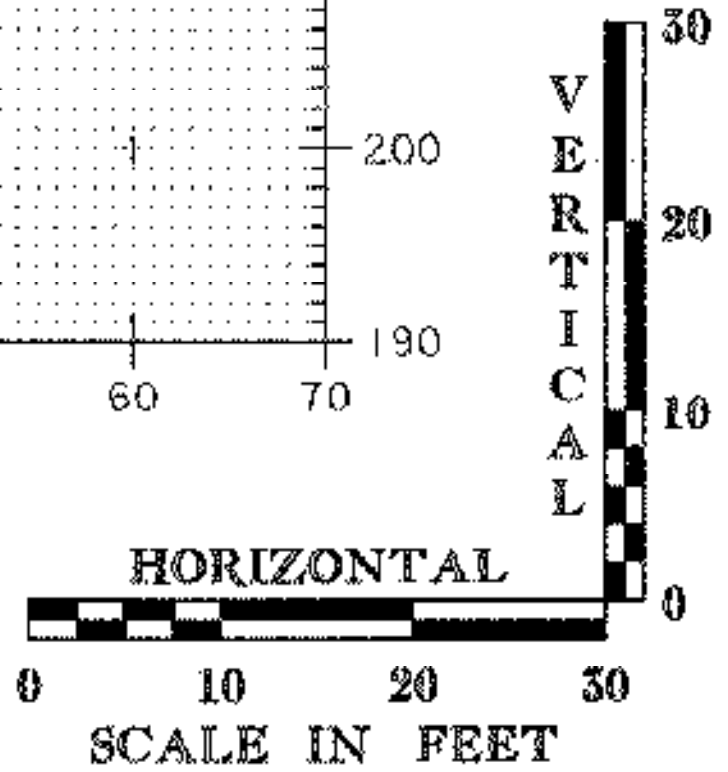