


NOTE #1: UNABLE TO LOCATE ALLEGED STUB AS DRAWN. STANTEC PROVIDED ADD'L INFO ON 10/23/06 TO LOOK 158.2FT TO THE NORTH OF DESIGN LOCATION. AT THAT APPROX. LOCATION THERE SEEMS TO BE AN AIR BLOW OFF. DRN 10/24/06

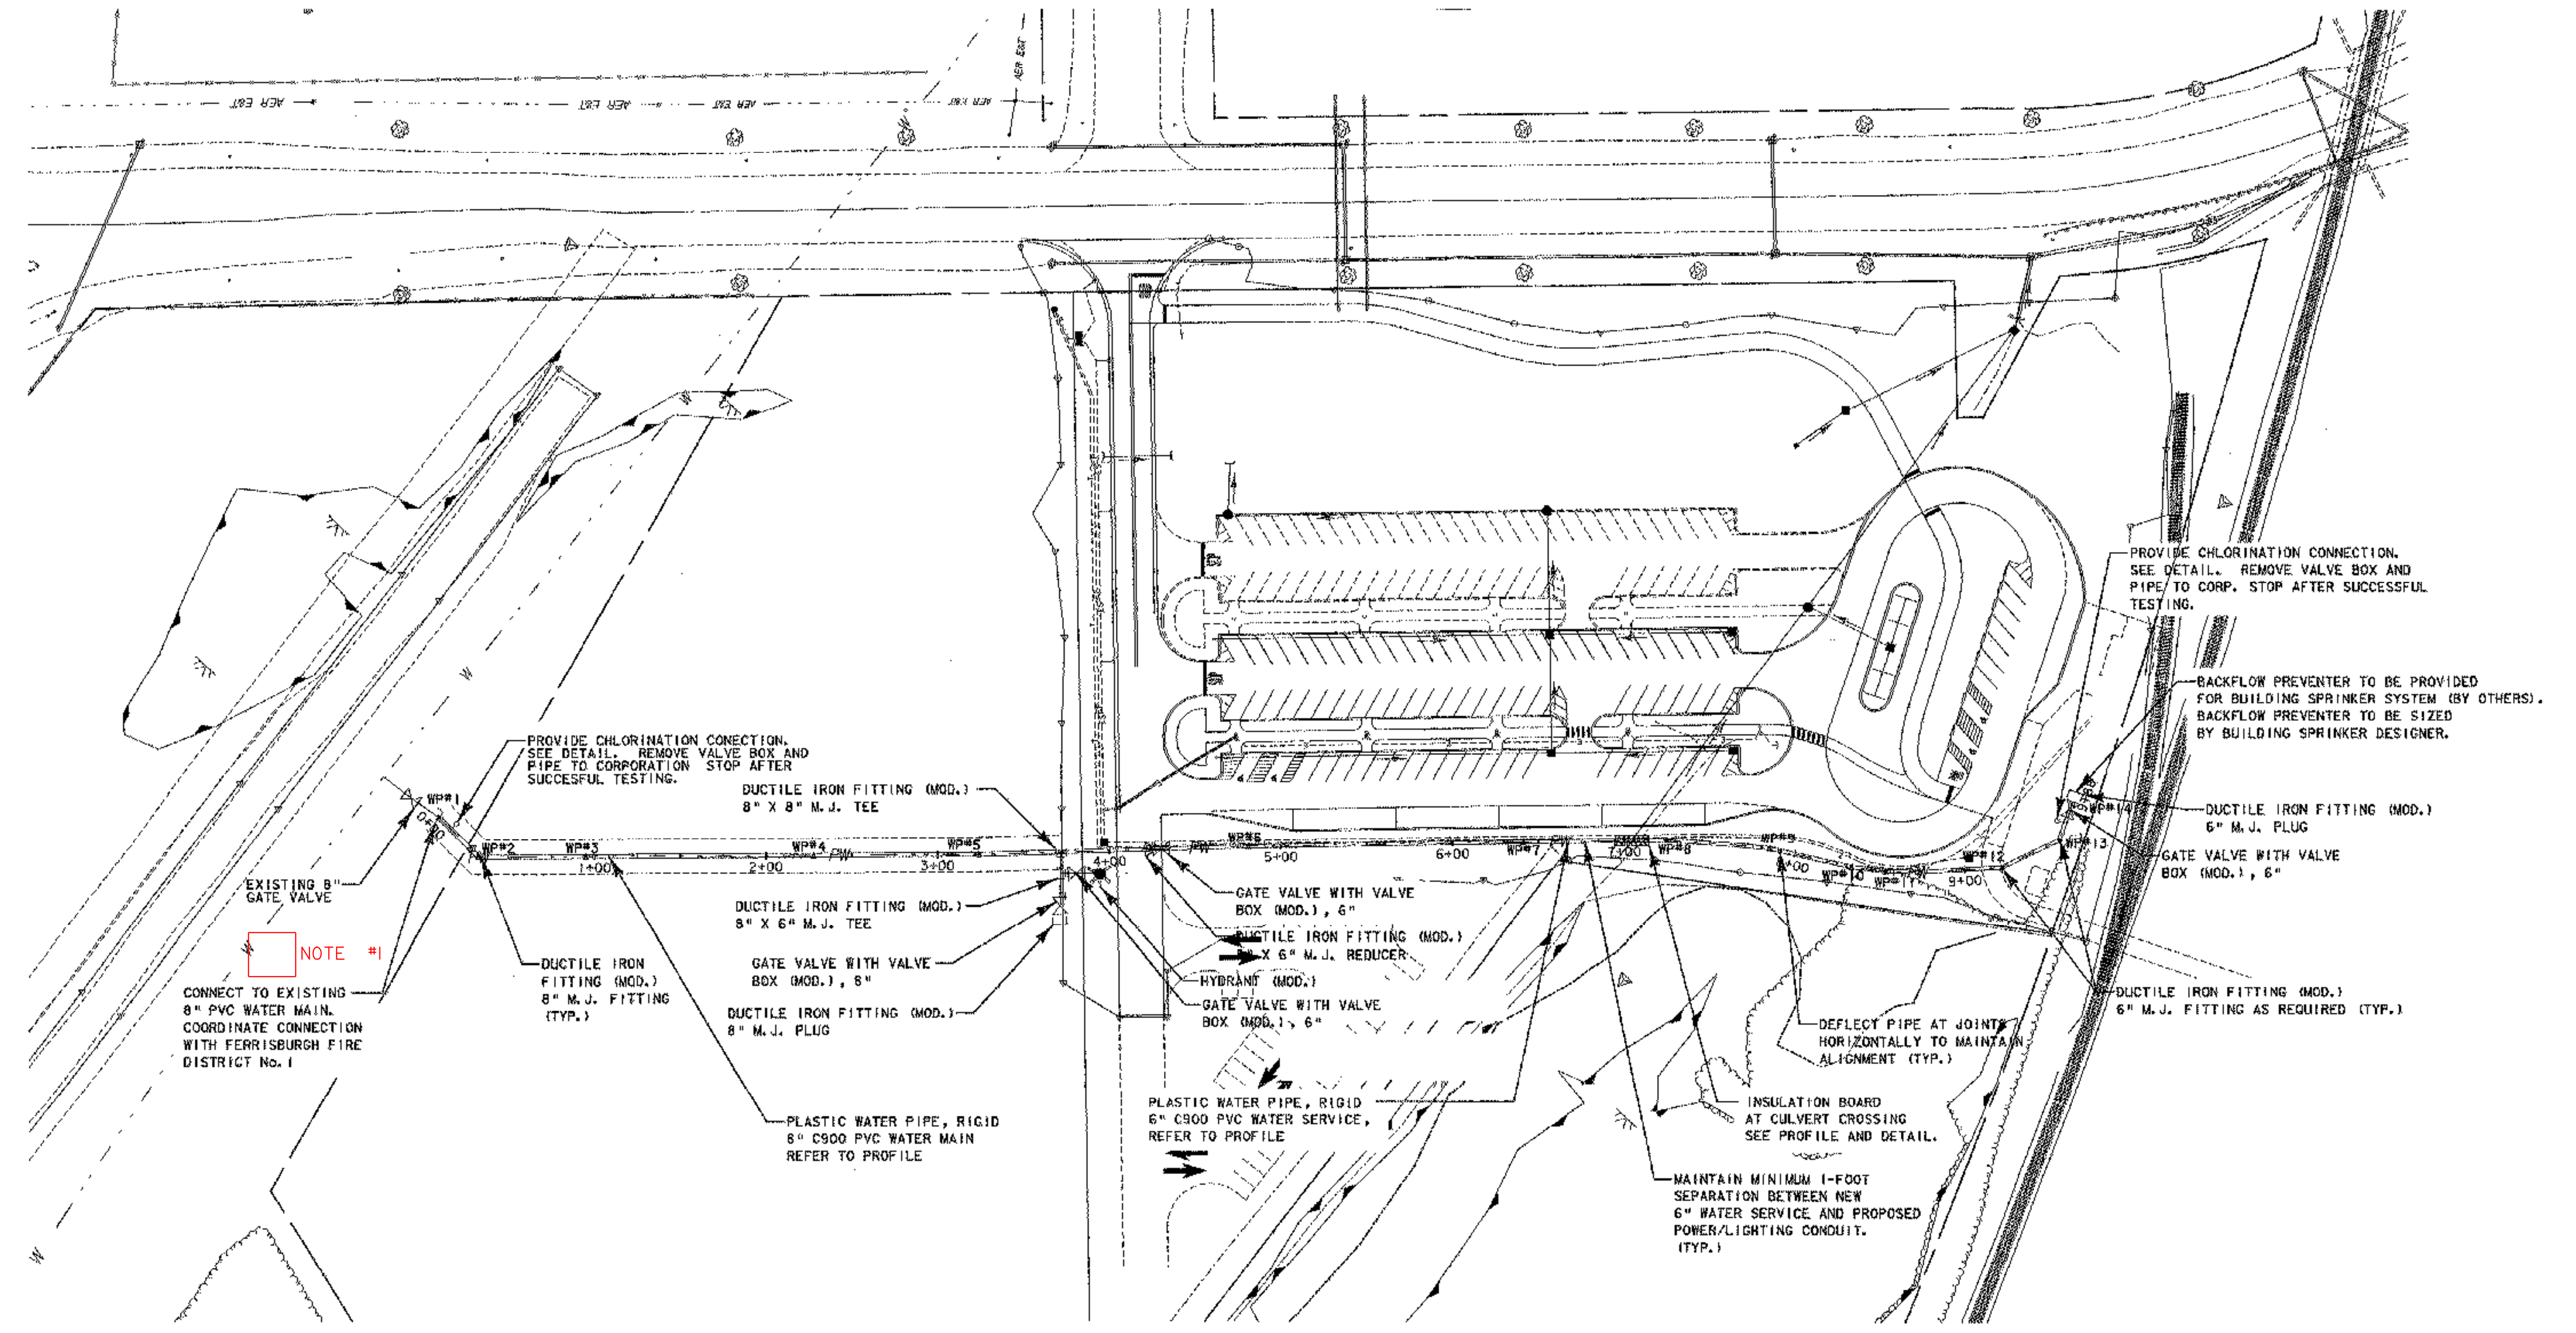

NOTE #1
 CONNECT TO EXISTING 8" PVC WATER MAIN. COORDINATE CONNECTION WITH FERRISBURGH FIRE DISTRICT No. 1

PROVIDE CHLORINATION CONNECTION. SEE DETAIL. REMOVE VALVE BOX AND PIPE TO CORPORATION STOP AFTER SUCCESSFUL TESTING.

DUCTILE IRON FITTING (MOD.)
 8" X 8" M.J. TEE

DUCTILE IRON FITTING (MOD.)
 8" X 6" M.J. TEE

GATE VALVE WITH VALVE BOX (MOD.), 8"

DUCTILE IRON FITTING (MOD.)
 8" M.J. PLUG

PLASTIC WATER PIPE, RIGID
 6" C900 PVC WATER MAIN
 REFER TO PROFILE

GATE VALVE WITH VALVE BOX (MOD.), 6"

DUCTILE IRON FITTING (MOD.)
 X 6" M.J. REDUCER

HYDRANT (MOD.)

GATE VALVE WITH VALVE BOX (MOD.), 6"

PLASTIC WATER PIPE, RIGID
 6" C900 PVC WATER SERVICE,
 REFER TO PROFILE

INSULATION BOARD
 AT CULVERT CROSSING
 SEE PROFILE AND DETAIL.

MAINTAIN MINIMUM 1-FOOT SEPARATION BETWEEN NEW 6" WATER SERVICE AND PROPOSED POWER/LIGHTING CONDUIT. (TYP.)


PROVIDE CHLORINATION CONNECTION. SEE DETAIL. REMOVE VALVE BOX AND PIPE TO CORP. STOP AFTER SUCCESSFUL TESTING.

BACKFLOW PREVENTER TO BE PROVIDED FOR BUILDING SPRINKLER SYSTEM (BY OTHERS). BACKFLOW PREVENTER TO BE SIZED BY BUILDING SPRINKLER DESIGNER.

DUCTILE IRON FITTING (MOD.)
 6" M.J. PLUG

GATE VALVE WITH VALVE BOX (MOD.), 6"

DUCTILE IRON FITTING (MOD.)
 6" M.J. FITTING AS REQUIRED (TYP.)

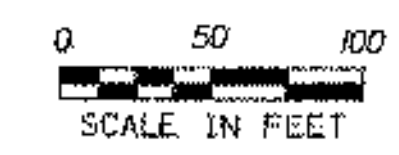

NOTE: FOR WATER LINE LAYOUT POINT INFORMATION, SEE WATER DETAILS 1.



CONTACT FOR FERRISBURGH WATER DISTRICT #1,
 BOB McNARY, TEL. NO. 877-3218

PROJECT NAME: FERRISBURGH/VERGS-FERRISBURGH
 PROJECT NUMBER: CMG PARK (15)S/STP EHO(21)

FILE NAME: ...Highway\PlotFiles\50water.plot PLOT DATE: 5/9/2006
 PROJECT LEADER: WLD DRAWN BY: JSK
 DESIGNED BY: BFR CHECKED BY: JTM
WATER LINE PLAN SHEET 50 OF 65