
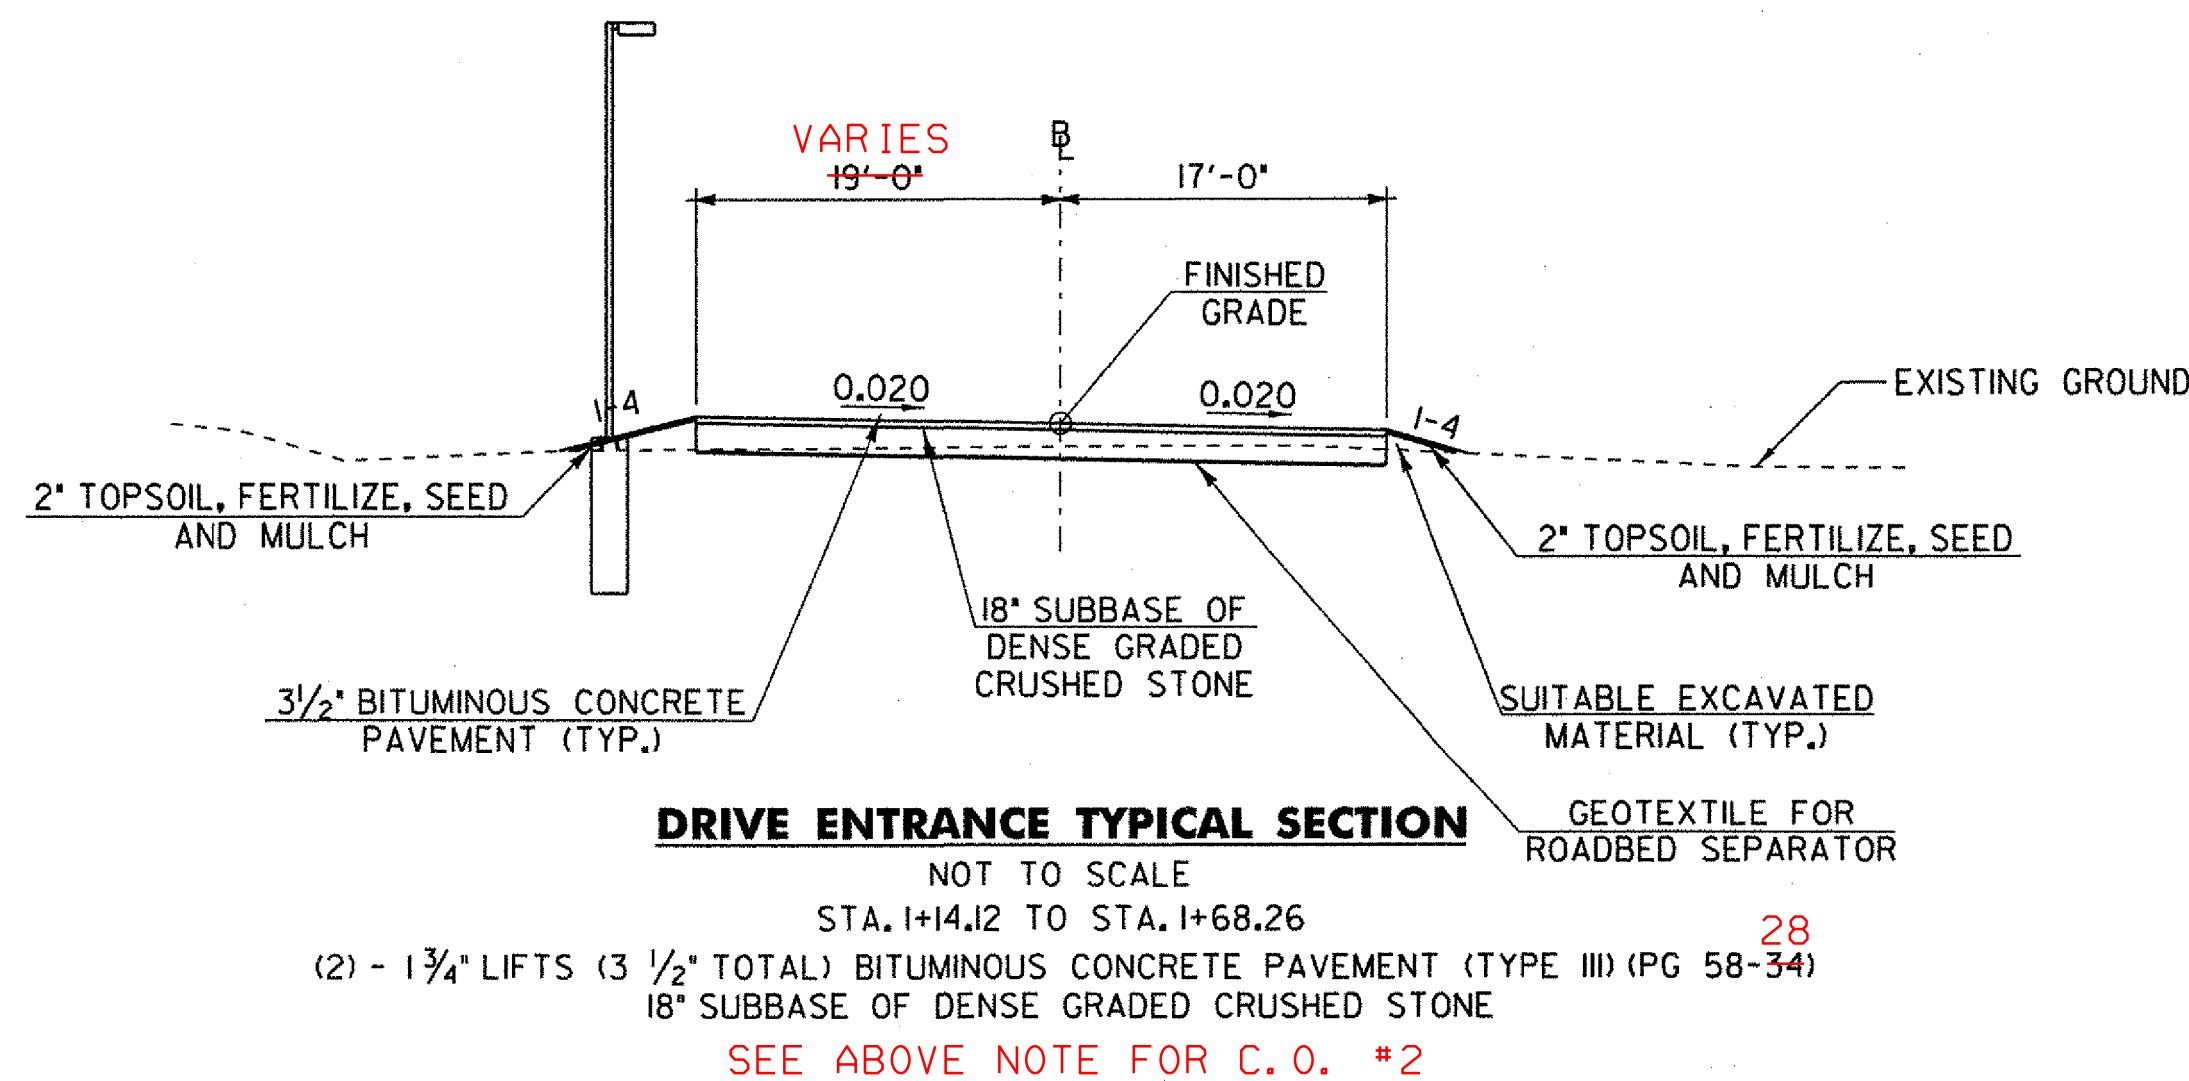
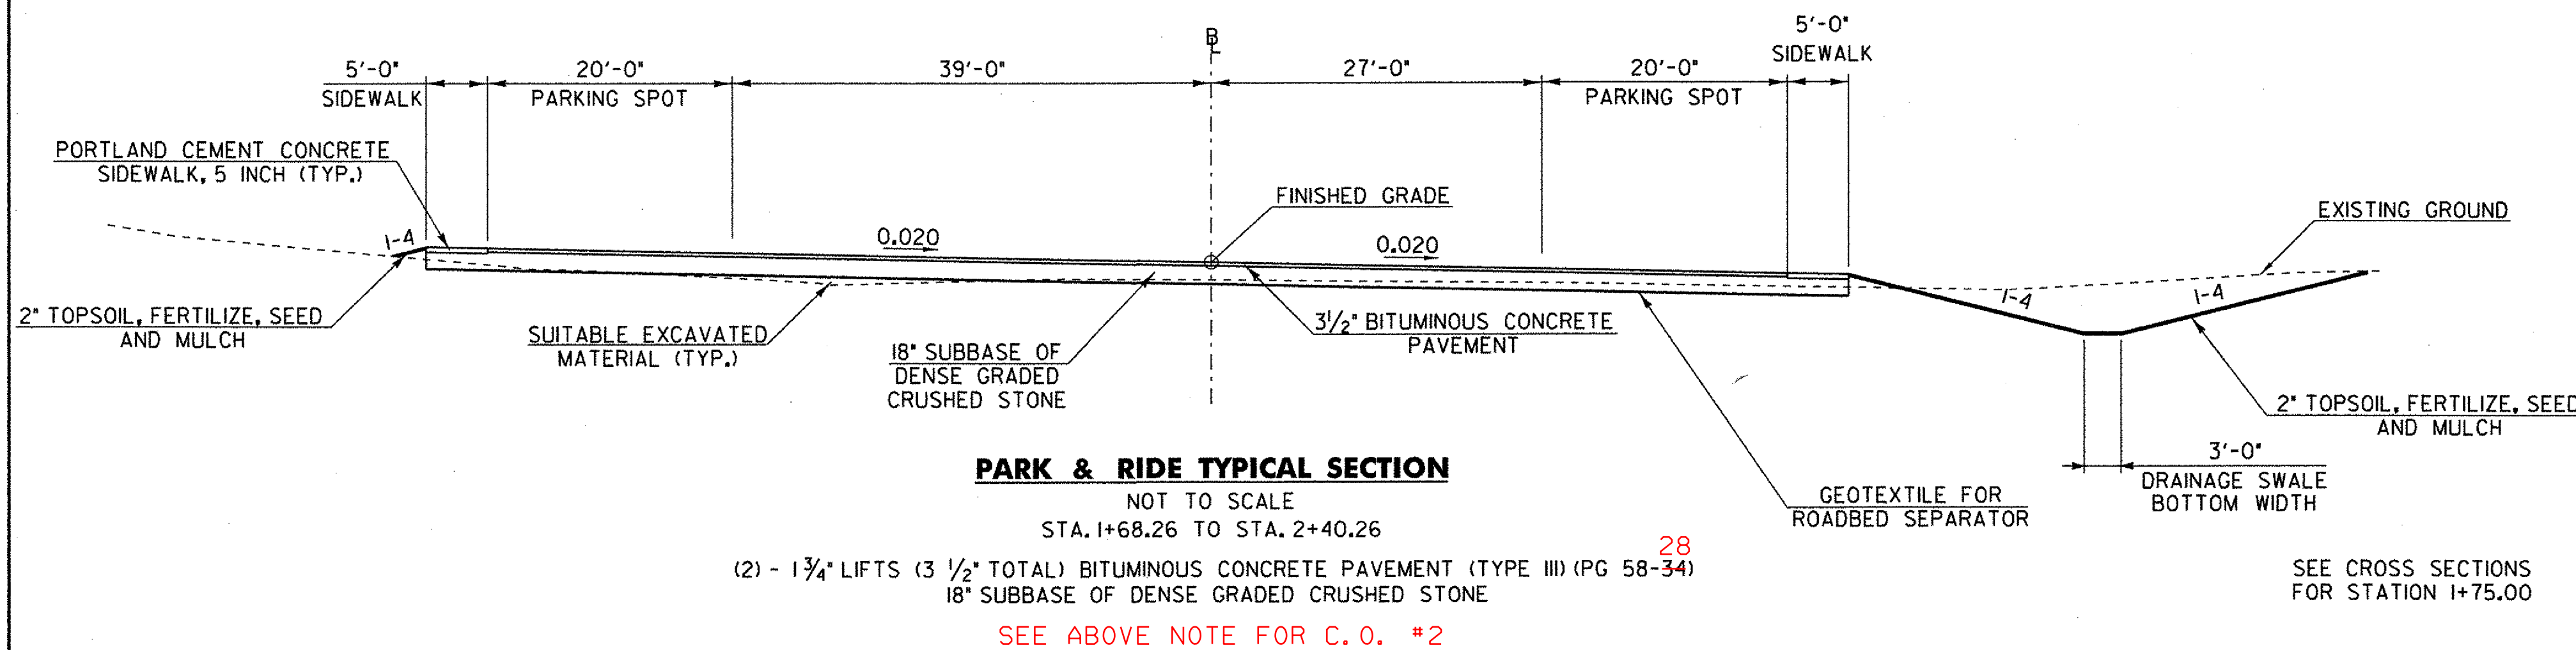
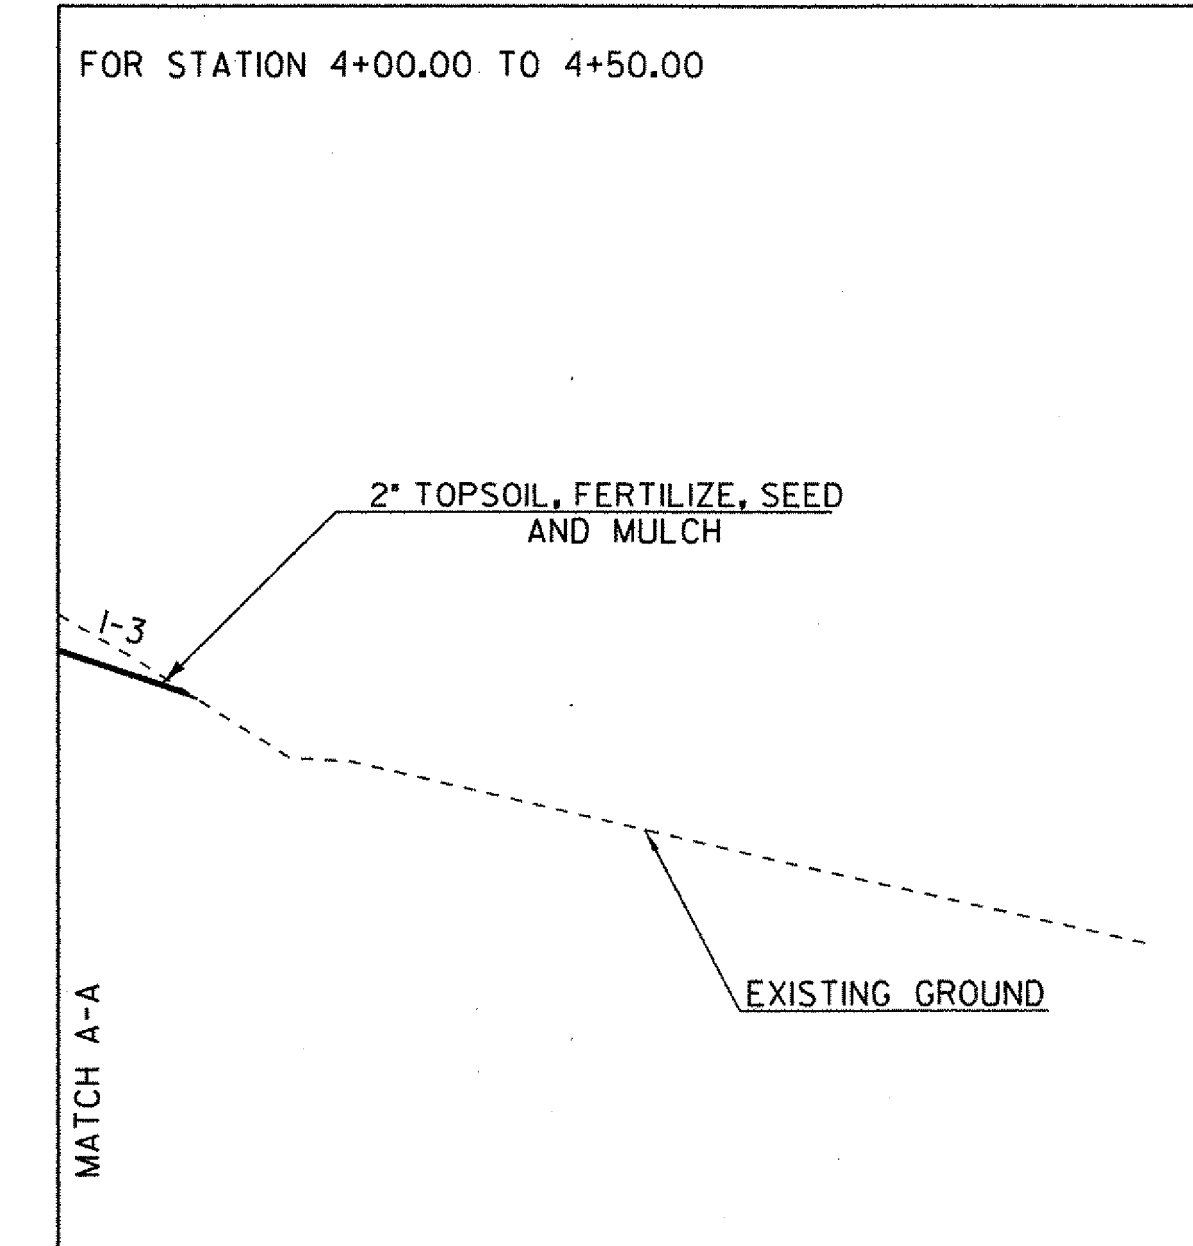


TYPICAL SHEET

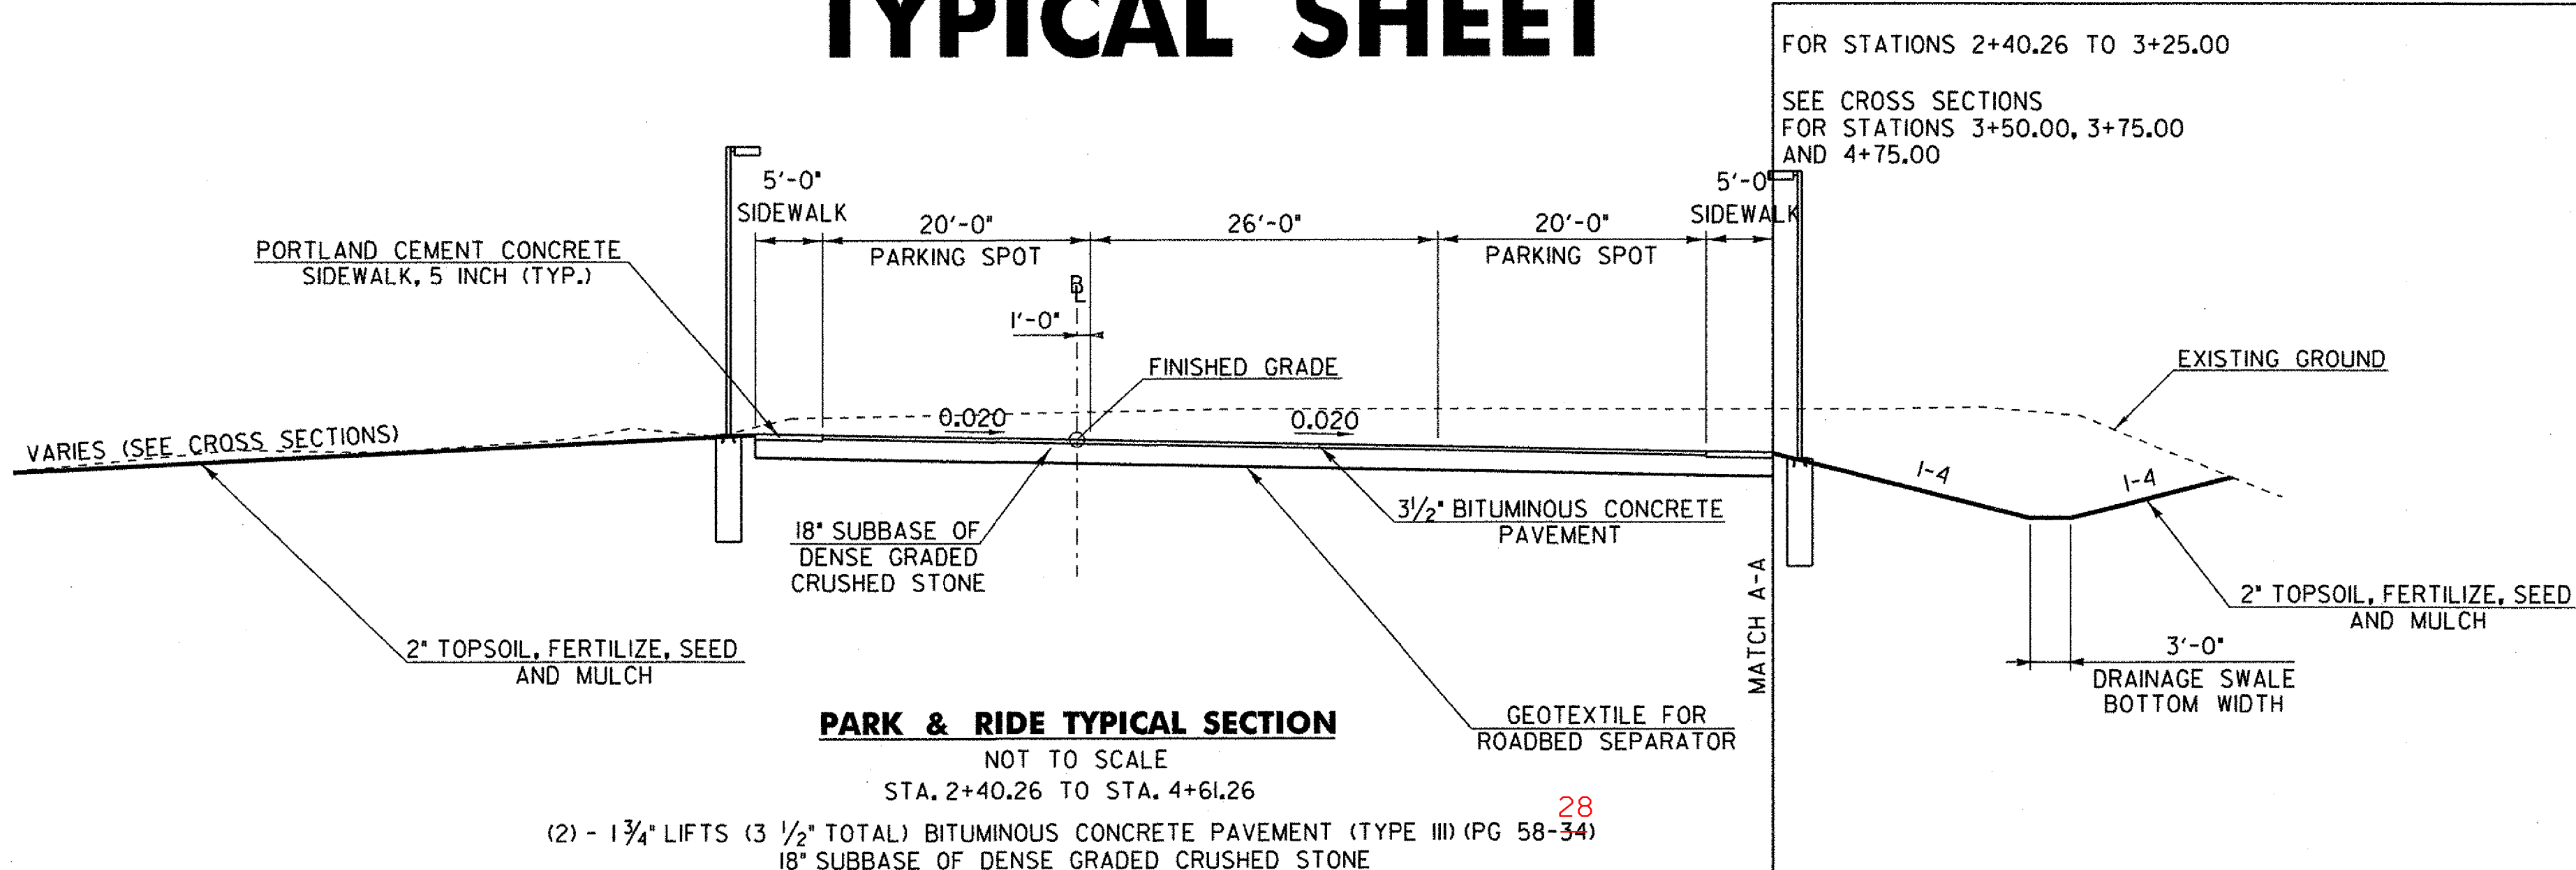

SEEDING FORMULA LOW GROW / FINE FESCUE

NAME	% WT.	LBS./AC.		GERM %
		BROADCAST	HYDROSEED	
CREeping RED FESCUE/DEN	37.6	75.2	94.0	90
SPARTAN HARD FESCUE	28.4	56.8	71.0	85
AZAY SHEEPS FESCUE	14.4	28.8	36.0	87
ANNUAL RYEGRASS	14.2	28.4	35.5	90
CROP	1.0	2.0	2.5	
INERT	4.3	8.6	10.8	
WEED	0.1	0.2	0.2	
	100.0	200.0	250.0	

PERCENT OF SEED, CROP, WEED OR INERT MAY VARY +/-2%. VARIETIES OF GRASSES MAY BE SUBSTITUTED ONLY WITH APPROVAL FROM RESIDENT ENGINEER.

MOWING: RECOMMENDED EARLY MOWING ONCE OR TWICE WHEN GRASS REACHES 6" HEIGHT MAXIMUM TO PREVENT BROADLEAF WEED COMPETITION DURING ESTABLISHMENT PERIOD.

SEEDING NOTES

SEED MIXTURE: SHALL NOT HAVE A WEED CONTENT EXCEEDING 0.40% BY WEIGHT AND SHALL BE FREE OF ALL NOXIOUS SEED.

SEED: TO BE APPLIED PER SEEDING FORMULAS OR AS DIRECTED BY THE ENGINEER.

FERTILIZER: FORMULA 10-20-10, TO BE USED WITH SEED, APPLIED AT THE RATE OF 500 LBS./ACRE. (HYDRO SEEDERS MAY USE 19-19-19 FORMULA).

AGRICULTURAL LIMESTONE: TO BE APPLIED AT THE RATE OF 2 TONS/ACRE, OR AS DIRECTED BY THE ENGINEER.

HAY MULCH: TO BE PLACED ON EARTH SLOPES AT THE RATE OF 2 TONS/ACRE, OR AS DIRECTED BY THE ENGINEER.

TOPSOIL: TO BE USED WITH SEED AS INDICATED ON THE PLANS, OR AS DIRECTED BY THE ENGINEER.

GENERAL NOTES:

- SLOPE ROUNDING: ALL CUT SLOPES TO BE ROUNDED IN ACCORDANCE WITH VTRANS STANDARD SHEET B-5.
- EMULSIFIED ASPHALT SHALL BE APPLIED TO SUCCESSIVE COURSES OF PAVEMENT AT A RATE OF 0.05 GAL/SY.

MATERIAL TOLERANCE TABLE

MATERIAL ITEM	TOLERANCE
BITUMINOUS CONCRETE PAVEMENT	± 1/4" TOTAL DEPTH
SUBBASE OF DENSE GRADED CRUSHED STONE	± 1"

Hoyle, Tanner & Associates, Inc.

HTA PROJECT MODEL
904219 Typical Sections

PROJECT NAME: WEATHERSFIELD
PROJECT NUMBER: CMG PARK(17)S

FILE NAME: z99k014sh+lay.dgn
PROJECT LEADER: Wayne L. Davis
DESIGNED BY: AGB

TYPICAL SECTIONS

PLOT DATE: 8/20/2008
DRAWN BY: AGB
CHECKED BY: SJG
SHEET 3 OF 36