

SOIL BORING LOG SUMMARY
 BASED ON A PLAN ENTITLED "BRENTWOOD PARK" BY
 "LAMOUREAX, STONE & O'LEARY"
 DATED 3/19/97, REVISED 9/18/97

B-9 (AT WHITE LINE):
 U.S. ROUTE 7
 STA. 25+04, 12' RT.
 0-18" PAVEMENT
 18" + GRAVEL


CHAIN LINK FENCE, 6 FEET (MOD.)
 U.S. ROUTE 7 STA. 24+12 TO 24+14, RT.
VERTICAL GRANITE CURB
 U.S. ROUTE 7 STA. 19+40 TO 22+75, LT.
GEOTEXTILE FOR SILT FENCE
 U.S. ROUTE 7 STA. 23+50 TO 25+50, LT.
 U.S. ROUTE 7 STA. 20+19 TO 25+50, RT.

- NOTE**
1. ASSUMED 4-ROD RIGHT-OF-WAY
 2. SILT FENCE TO BE PLACED WITHIN RIGHT-OF-WAY
 3. SEE VTrans STANDARD C-1 FOR CURB END TREATMENT DETAILS


NEW UNDERDRAIN FLUSHING BASIN
 AT INLET STA. 19+75 22' LT

U6 U.S. ROUTE 7 STA. 19+40 TO 22+50, LT.
 NEW 6" X 340' UNDERDRAIN,
 INV IN AT STA 18+00 = 222.27, INV. OUT = 216.28.66

U7 U.S. ROUTE 7 STA. 22+50 TO 25+50, LT.
 NEW 6" X 100' UNDERDRAIN CARRIER PIPE,
 INV IN = 216.28, INV. OUT = 214.39.48
 .66

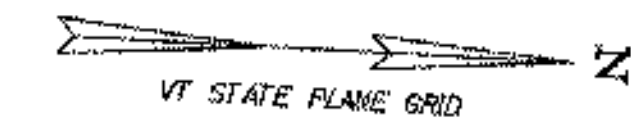

**U.S. ROUTE 7
 STA. 20+67.00
 END APPROACH
 BEGIN PROJECT
 CMG PARK(18)S**

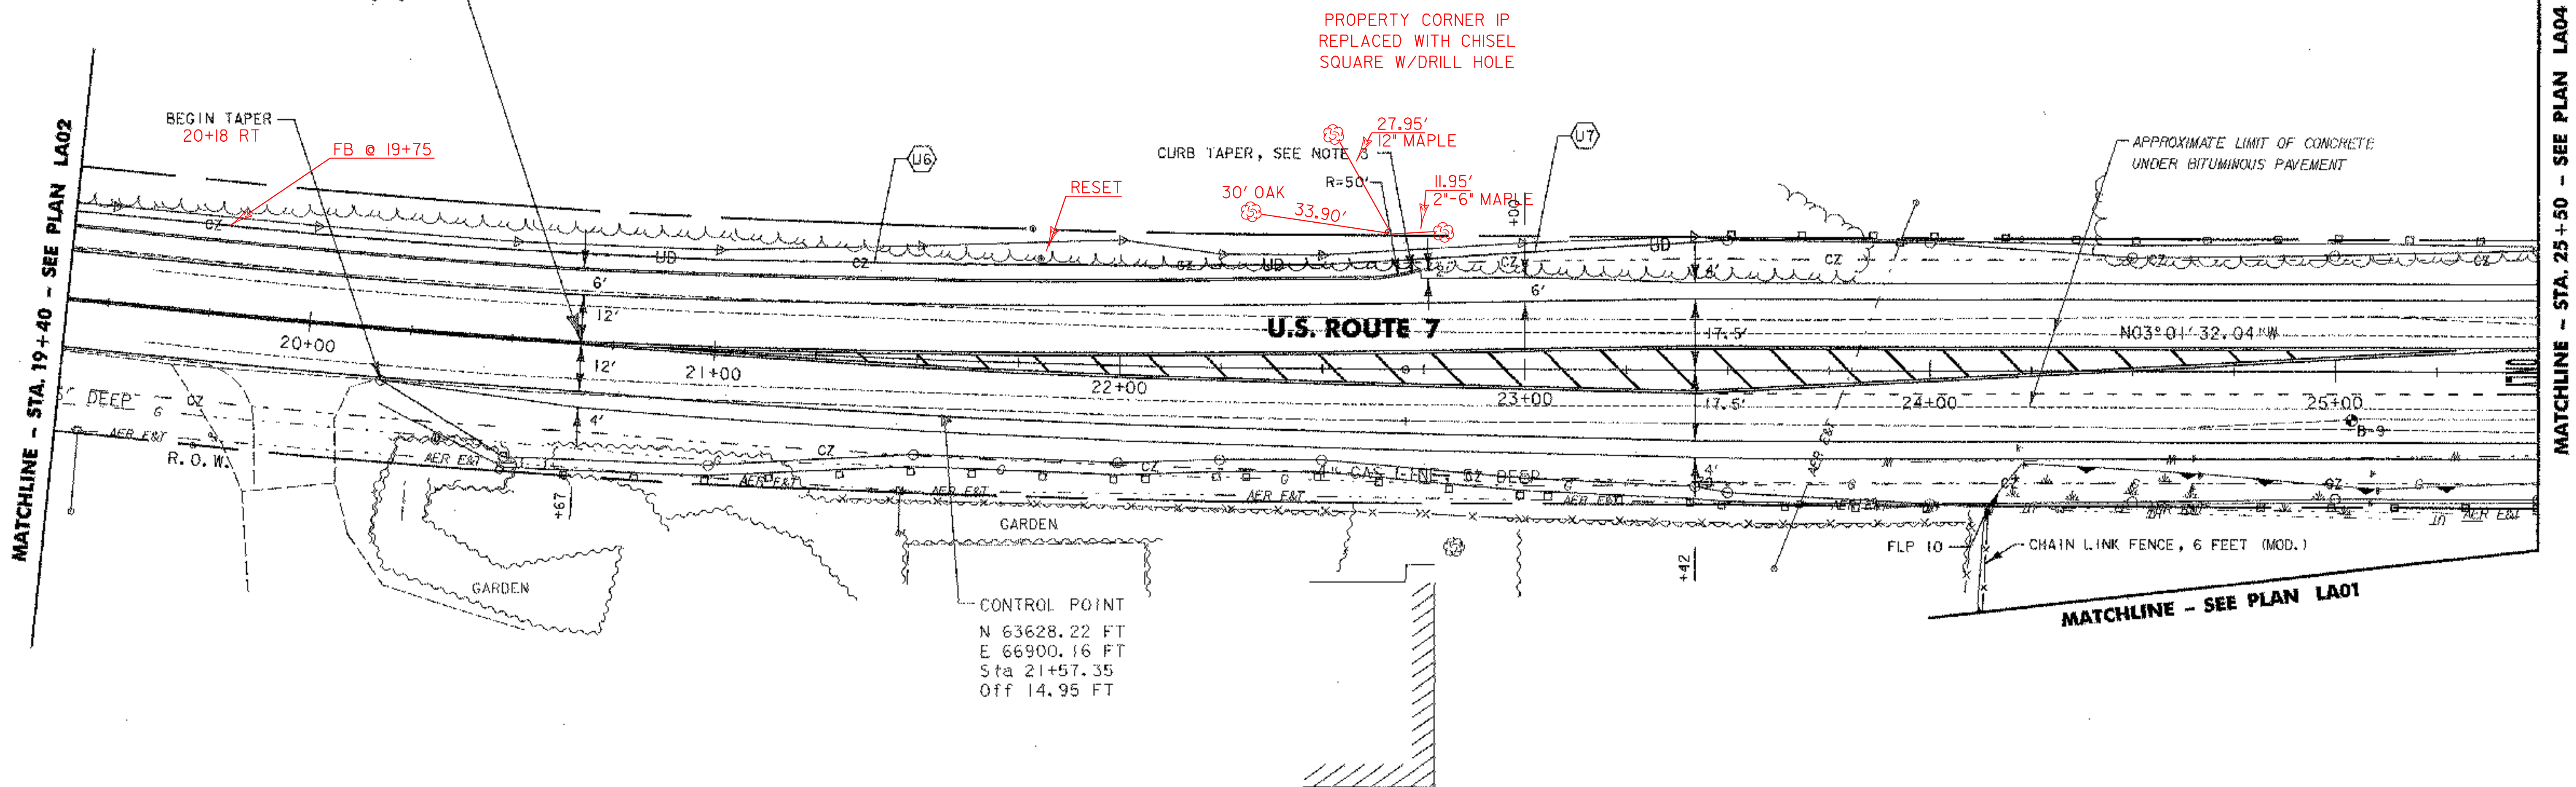

PROPERTY CORNER IP
 REPLACED WITH CHISEL
 SQUARE W/DRILL HOLE

CONTROL POINT
 N 63628.22 FT
 E 66900.16 FT
 Sta 21+57.35
 Off 14.95 FT



	PROJECT NAME: COLCHESTER PARK-AND-RIDE
	PROJECT NUMBER: CMG PARK(18)S
	FILE NAME: LA03.PTF
	DESIGNED BY: CSP
PROJECT LEADER: WLD	PLOT DATE: 07/08/02
CHECKED BY: GAE	DRAWN BY: MAM
RT. 7 LAYOUT & EROSION LA03	SHEET 15 OF 56