


MATCHLINE - STA. 31+25 - SEE PAVT MARKINGSIGN PLAN #3

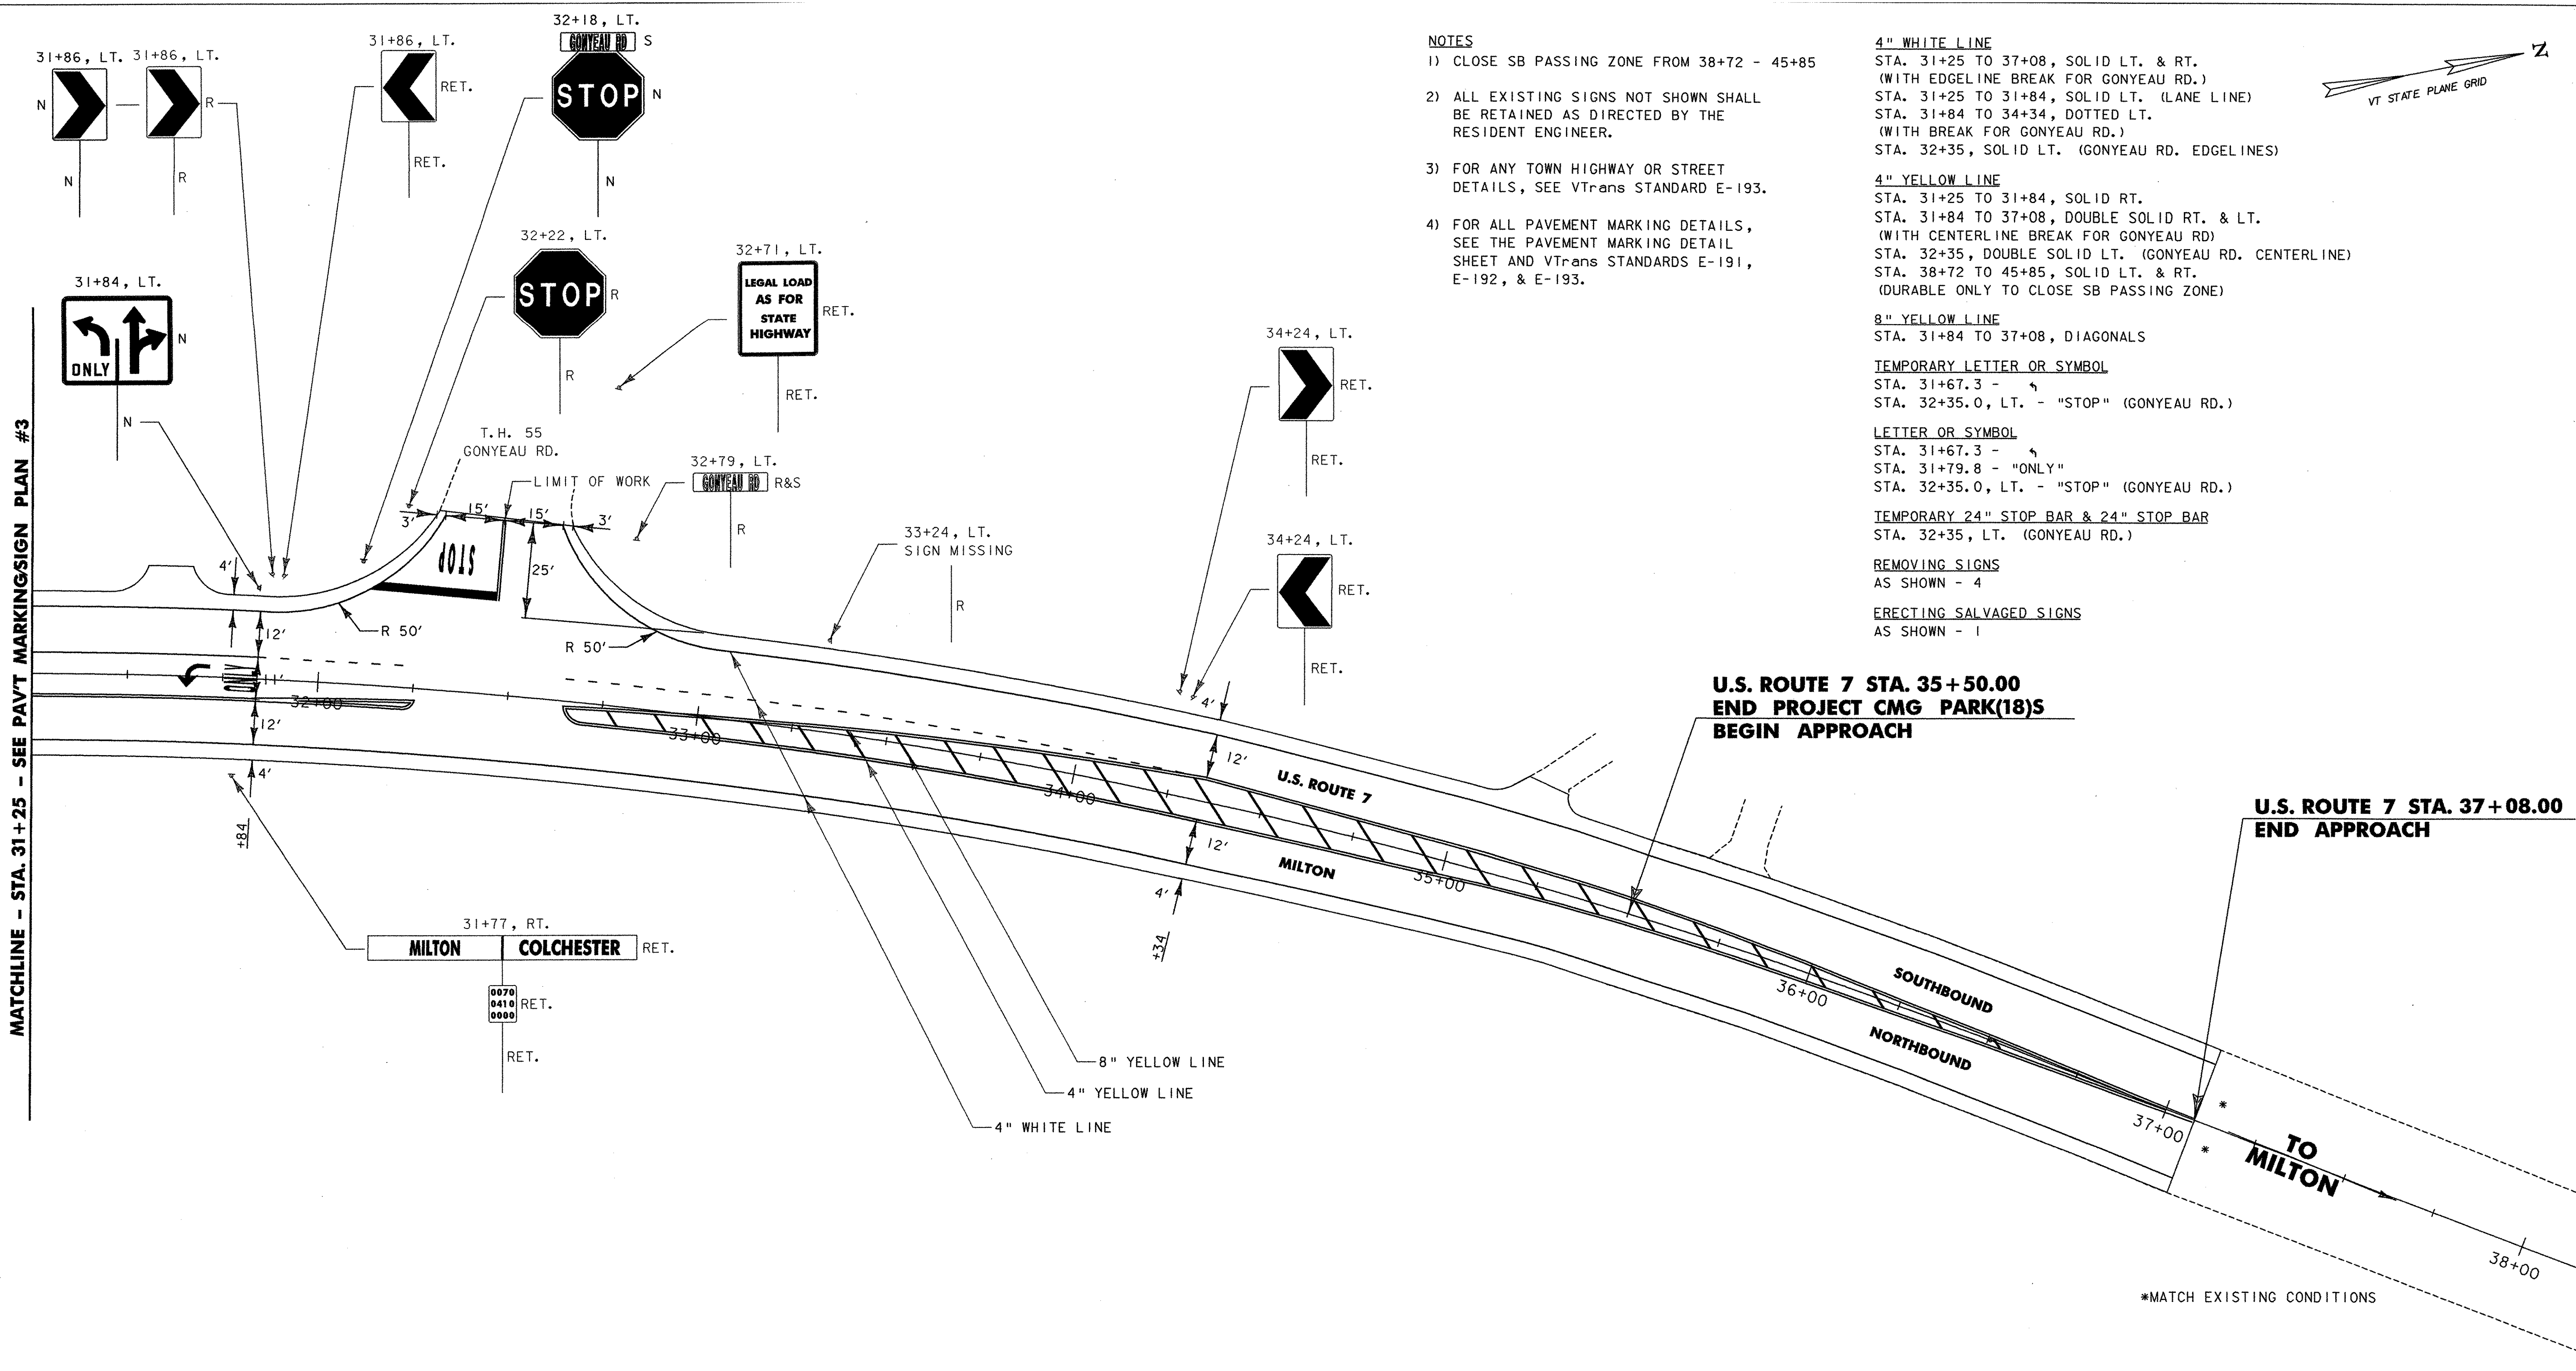

NOTES

- 1) CLOSE SB PASSING ZONE FROM 38+72 - 45+85
- 2) ALL EXISTING SIGNS NOT SHOWN SHALL BE RETAINED AS DIRECTED BY THE RESIDENT ENGINEER.
- 3) FOR ANY TOWN HIGHWAY OR STREET DETAILS, SEE VTrans STANDARD E-193.
- 4) FOR ALL PAVEMENT MARKING DETAILS, SEE THE PAVEMENT MARKING DETAIL SHEET AND VTrans STANDARDS E-191, E-192, & E-193.

4" WHITE LINE

- STA. 31+25 TO 37+08, SOLID LT. & RT. (WITH EDGELINE BREAK FOR GONYEAU RD.)
- STA. 31+25 TO 31+84, SOLID LT. (LANE LINE)
- STA. 31+84 TO 34+34, DOTTED LT. (WITH BREAK FOR GONYEAU RD.)
- STA. 32+35, SOLID LT. (GONYEAU RD. EDGELINES)

4" YELLOW LINE

- STA. 31+25 TO 31+84, SOLID RT.
- STA. 31+84 TO 37+08, DOUBLE SOLID RT. & LT. (WITH CENTERLINE BREAK FOR GONYEAU RD.)
- STA. 32+35, DOUBLE SOLID LT. (GONYEAU RD. CENTERLINE)
- STA. 38+72 TO 45+85, SOLID LT. & RT. (DURABLE ONLY TO CLOSE SB PASSING ZONE)

8" YELLOW LINE

- STA. 31+84 TO 37+08, DIAGONALS

TEMPORARY LETTER OR SYMBOL

- STA. 31+67.3 - "ONLY"
- STA. 32+35.0, LT. - "STOP" (GONYEAU RD.)

LETTER OR SYMBOL

- STA. 31+67.3 - "ONLY"
- STA. 31+79.8 - "ONLY"
- STA. 32+35.0, LT. - "STOP" (GONYEAU RD.)

TEMPORARY 24" STOP BAR & 24" STOP BAR

- STA. 32+35, LT. (GONYEAU RD.)

REMOVING SIGNS

- AS SHOWN - 4


ERECTING SALVAGED SIGNS

- AS SHOWN - 1

**U.S. ROUTE 7 STA. 35+50.00
END PROJECT CMG PARK(18)S
BEGIN APPROACH**

**U.S. ROUTE 7 STA. 37+08.00
END APPROACH**

- SIGN LEGEND**
- N = NEW
 - R = REMOVE
 - R&S = REMOVE & SALVAGE
 - S = SALVAGE SIGN
 - RET = RETAIN
 - B-B = BACK TO BACK

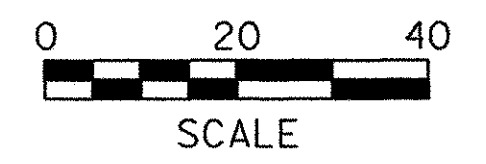

PROJECT NAME: COLCHESTER PARK-AND-RIDE	PLOT DATE: 07/08/02
PROJECT NUMBER: CMG PARK(18)S	DRAWN BY: GGG
FILE NAME: zk062+fc.dgn	CHECKED BY: JLL
PROJECT LEADER: WLD	SHEET 25 OF 56
DESIGNED BY: CSP	
PAVT MARKINGSIGN PLAN #4	

C:\PAVT MARKINGSIGN\PAVT 07/08/02 11:45:39 AM