


- LEGEND**
- U4 PROPOSED UNDERDRAIN (SEE DRAINAGE PLAN, SHEET 20)
 - 3 PROPOSED STORMWATER PIPE (SEE DRAINAGE PLAN, SHEET 20)
 - A PROPOSED CONDUIT FOR LIGHTING (SEE LIGHTING PLAN, SHEET 31)
 - UT EXISTING UNDERGROUND TELEPHONE
 - W EXISTING WATER
 - UD EXISTING UNDERDRAIN
 - G EXISTING GAS

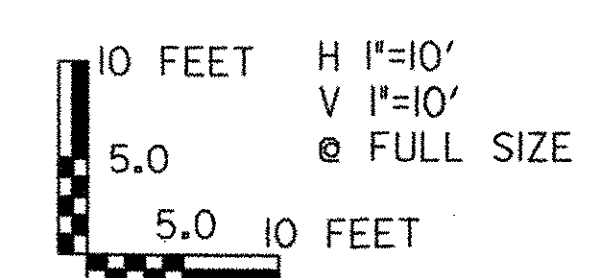

DH Dufresne-Henry	PROJECT NAME: COLCHESTER PARK-AND-RIDE	PLOT DATE: 07/08/02
	PROJECT NUMBER: CMG PARK(18)	DRAWN BY: MAM
FILE NAME: zk062xsl.dgn	DESIGNED BY: DH	CHECKED BY: GAE
PROJECT LEADER: CSP	PARK-AND-RIDE CROSS SECTION	
		SHEET 39 OF 56

3:35 PM X 8/8/02 12:12:06 PM