


LEGEND

- (U4) PROPOSED UNDERDRAIN (SEE DRAINAGE PLAN, SHEET 20)
- (3) PROPOSED STORMWATER PIPE (SEE DRAINAGE PLAN, SHEET 20)
- (A) PROPOSED CONDUIT FOR LIGHTING (SEE LIGHTING PLAN, SHEET 31)
- UT EXISTING UNDERGROUND TELEPHONE
- W EXISTING WATER
- UD EXISTING UNDERDRAIN
- G EXISTING GAS

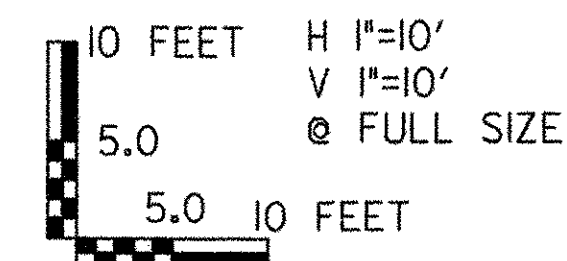

PROJECT NAME: COLCHESTER PARK-AND-RIDE
 PROJECT NUMBER: CMG PARK(18)S
 FILE NAME: zk062xsl.dgn
 PROJECT LEADER: CSP
 DESIGNED BY: DH
 PLOT DATE: 07/08/02
 DRAWN BY: MAM
 CHECKED BY: GAE
PARK-AND-RIDE CROSS SECTION
 SHEET 42 OF 56

13:56 X SECTIONS.PLT 07/08/02 12:12:19 PM