


LEGEND

- Ⓧ PROPOSED UNDERDRAIN
(SEE DRAINAGE PLAN, SHEET 20)
- Ⓧ PROPOSED STORMWATER PIPE
(SEE DRAINAGE PLAN, SHEET 20)
- Ⓧ PROPOSED CONDUIT FOR LIGHTING
(SEE LIGHTING PLAN, SHEET 31)
- UT EXISTING UNDERGROUND TELEPHONE
- W EXISTING WATER
- UD EXISTING UNDERDRAIN
- G EXISTING GAS

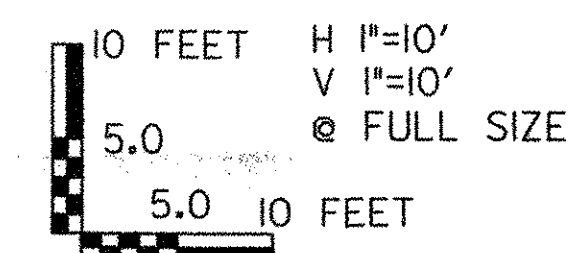

PROJECT NAME: COLCHESTER PARK-AND-RIDE
 PROJECT NUMBER: CMG PARK(18)S
 FILE NAME: zk062xsl.dgn
 PROJECT LEADER: CSP
 DESIGNED BY: DH
 PLOT DATE: 07/08/02
 DRAWN BY: MAM
 CHECKED BY: GAE
 SHEET 44 OF 56

ACCESS ROAD CROSS SECTIONS