


- LEGEND**
- (U6) PROPOSED UNDERDRAIN  
(SEE DRAINAGE PLAN, SHEET 20)
  - (3) PROPOSED STORMWATER PIPE  
(SEE DRAINAGE PLAN, SHEET 20)
  - (A) PROPOSED CONDUIT FOR LIGHTING  
(SEE LIGHTING PLAN, SHEET 31)
  - UT EXISTING UNDERGROUND TELEPHONE
  - W EXISTING WATER
  - UD EXISTING UNDERDRAIN
  - G EXISTING GAS

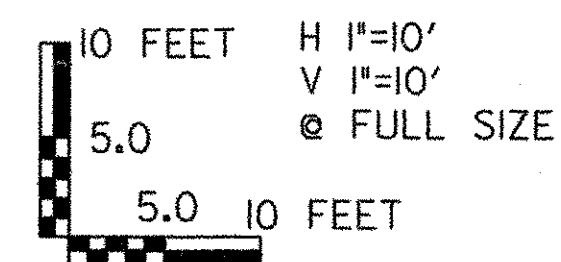

PROJECT NAME: COLCHESTER PARK-AND-RIDE  
 PROJECT NUMBER: CMG PARK(18)S  
 FILE NAME: zk062xsl.dgn  
 PROJECT LEADER: CSP  
 DESIGNED BY: DH  
 PLOT DATE: 07/08/02  
 DRAWN BY: GGG  
 CHECKED BY: GAE  
 SHEET 46 OF 56

**U.S. ROUTE 7 - CROSS SECTION**