


- LEGEND**
- ④ PROPOSED UNDERDRAIN (SEE DRAINAGE PLAN, SHEET 20)
 - ③ PROPOSED STORMWATER PIPE (SEE DRAINAGE PLAN, SHEET 20)
 - Ⓐ PROPOSED CONDUIT FOR LIGHTING (SEE LIGHTING PLAN, SHEET 31)
 - UT EXISTING UNDERGROUND TELEPHONE
 - W EXISTING WATER
 - UD EXISTING UNDERDRAIN
 - G EXISTING GAS

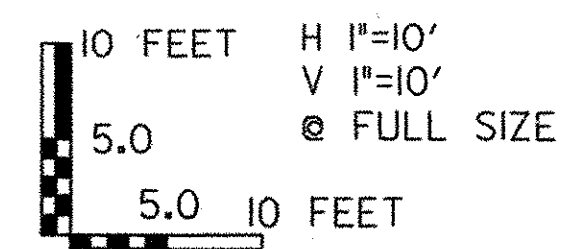

PROJECT NAME: COLCHESTER PARK-AND-RIDE
 PROJECT NUMBER: CMG PARK(18)S
 FILE NAME: zk062xsl.dgn
 PROJECT LEADER: CSP
 DESIGNED BY: DH
 U.S. ROUTE 7 - CROSS SECTION

PLOT DATE: 07/08/02
 DRAWN BY: MAM
 CHECKED BY: GAE
 SHEET 53 OF 56

...:03:56 X:8201005.PLT 07/08/02 12:15:27 PM