


KEUFFEL & ESSER CO.  
NEW YORK

THREE STANDARD MARK  
CROSS SECTION 10 X 10  
100% MADE IN U.S.A.

KEUFFEL & ESSER CO.  
NEW YORK

THREE STANDARD MARK  
CROSS SECTION 10 X 10  
100% MADE IN U.S.A.

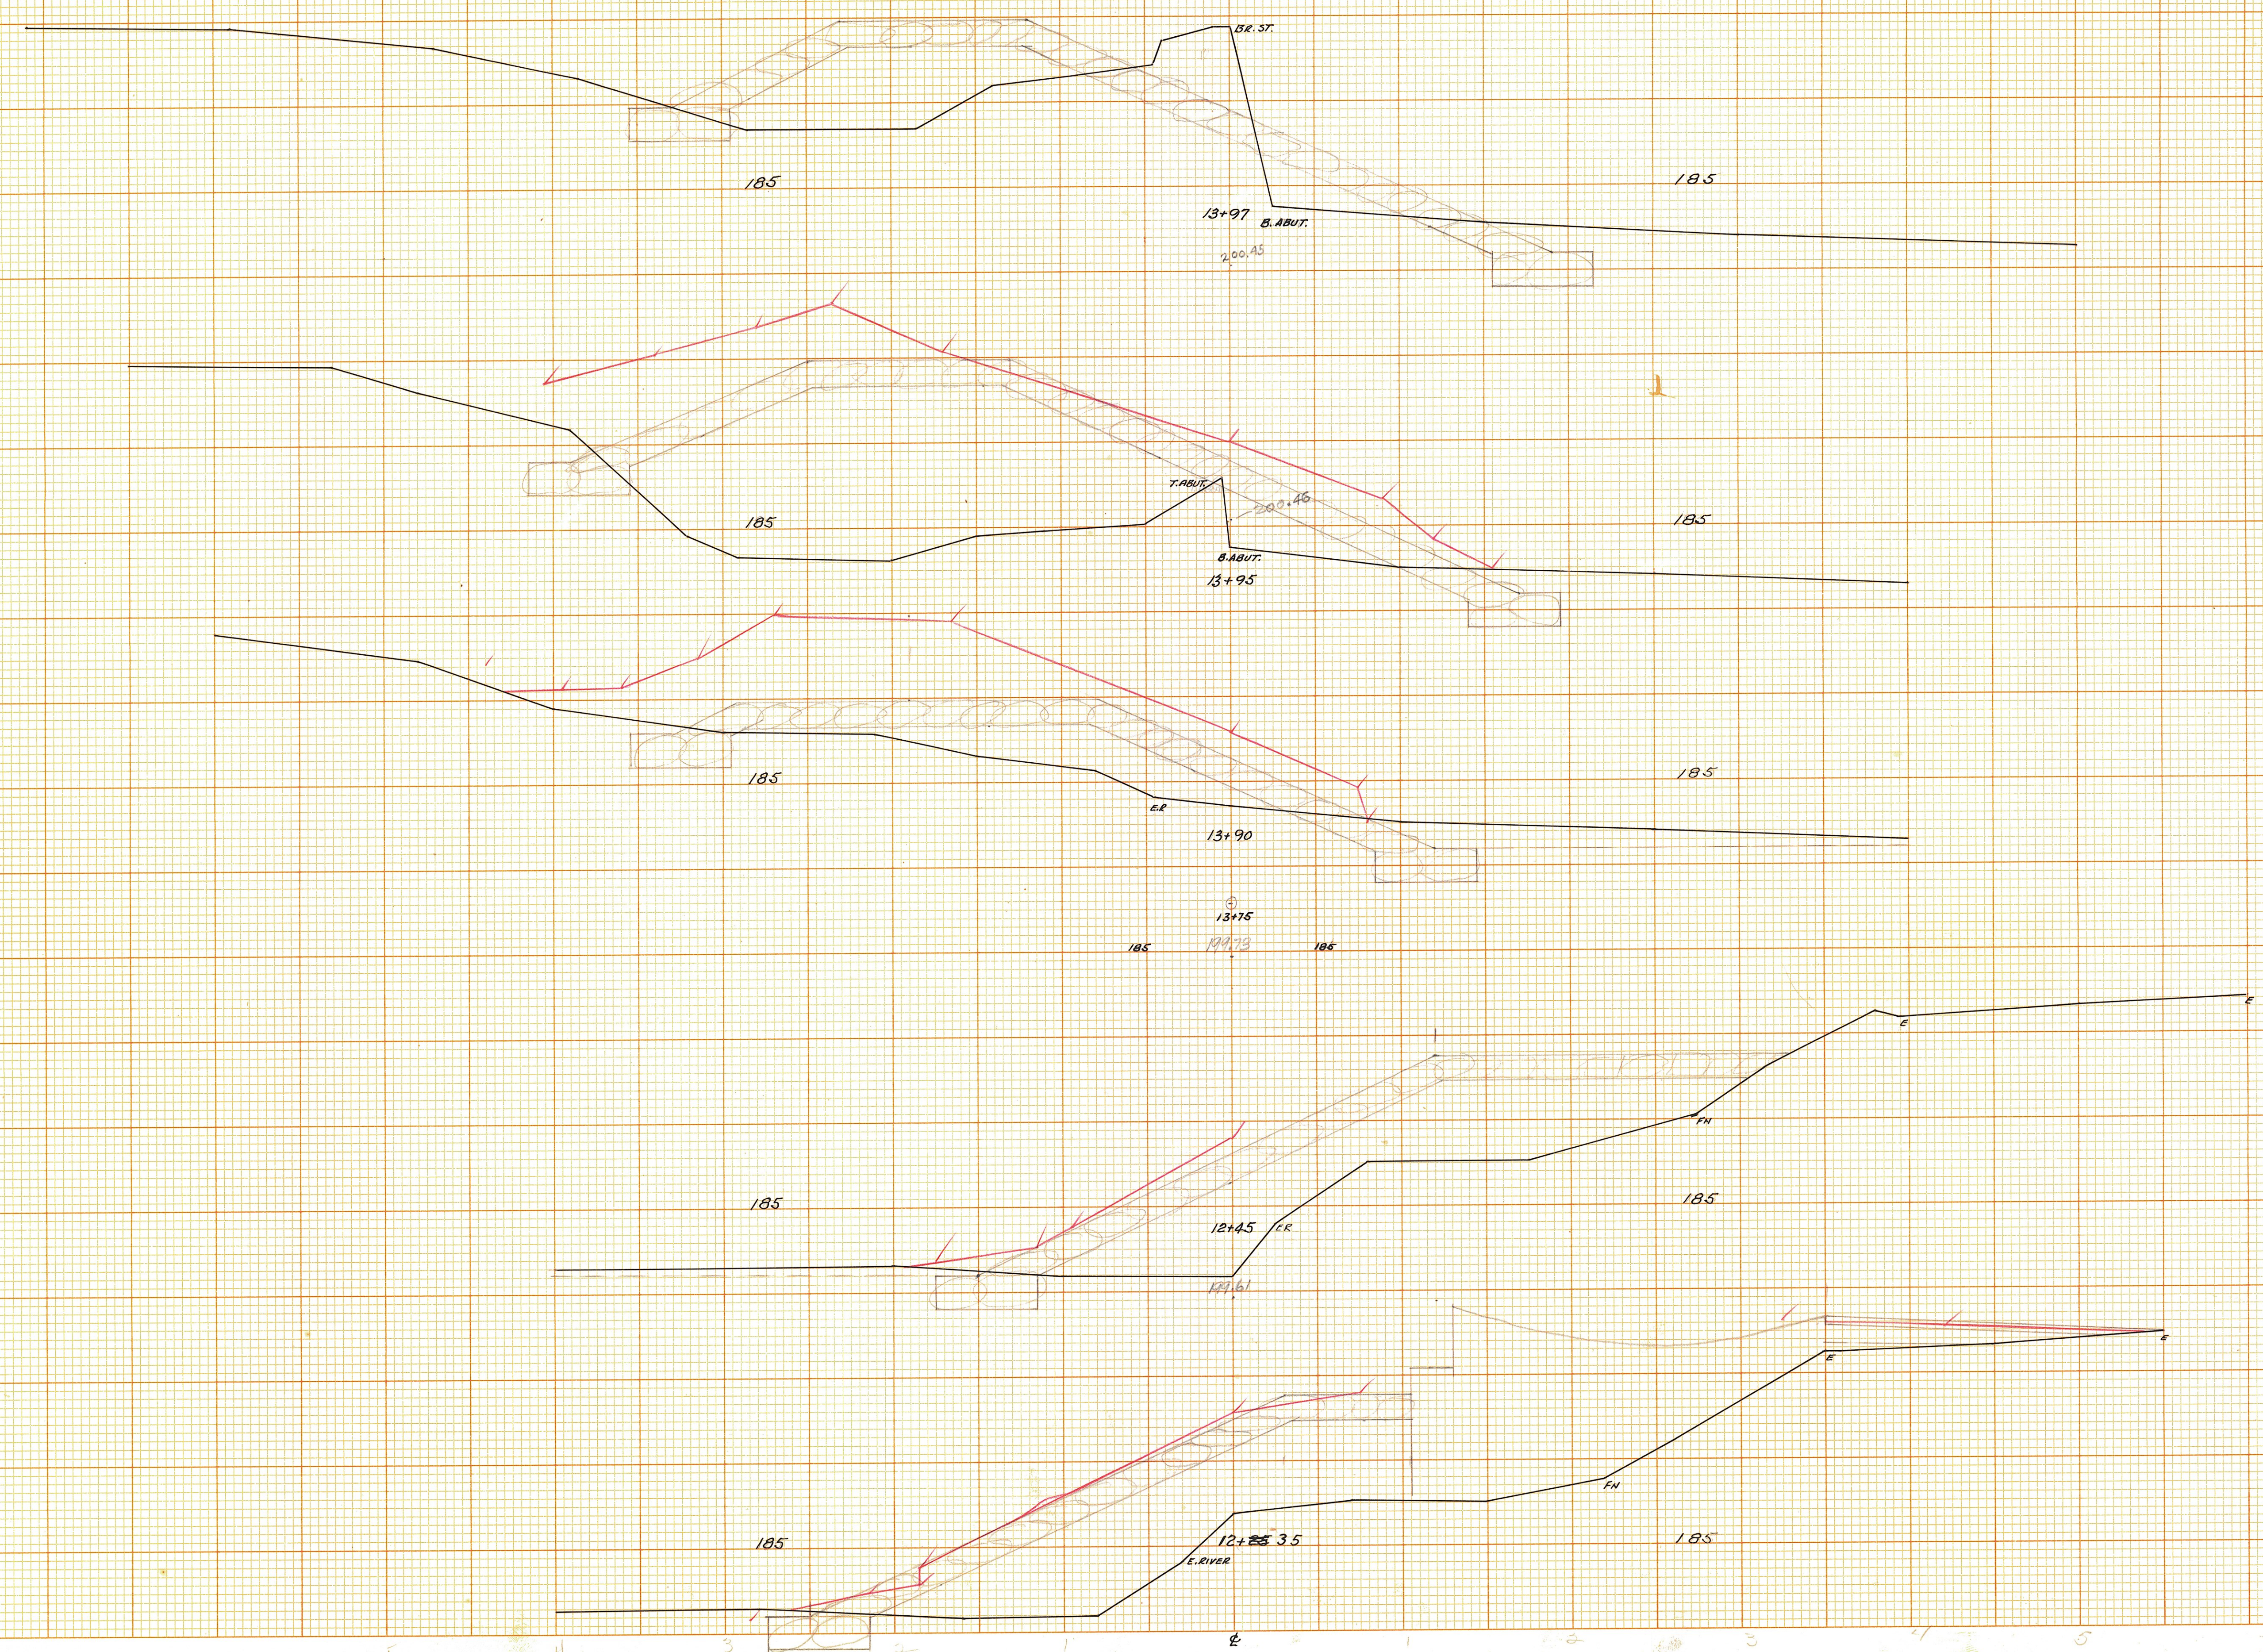

MARKET BRIDGE  
TUNBRIDGE  
ST. 199-L  
SHEET 14 OF 17