


STANDARD
CROSS SECTION 10 X 10
NEW YORK

KEUFFEL & ESSER CO.
NEW YORK

STANDARD
CROSS SECTION 10 X 10
NEW YORK

KEUFFEL & ESSER CO.
NEW YORK

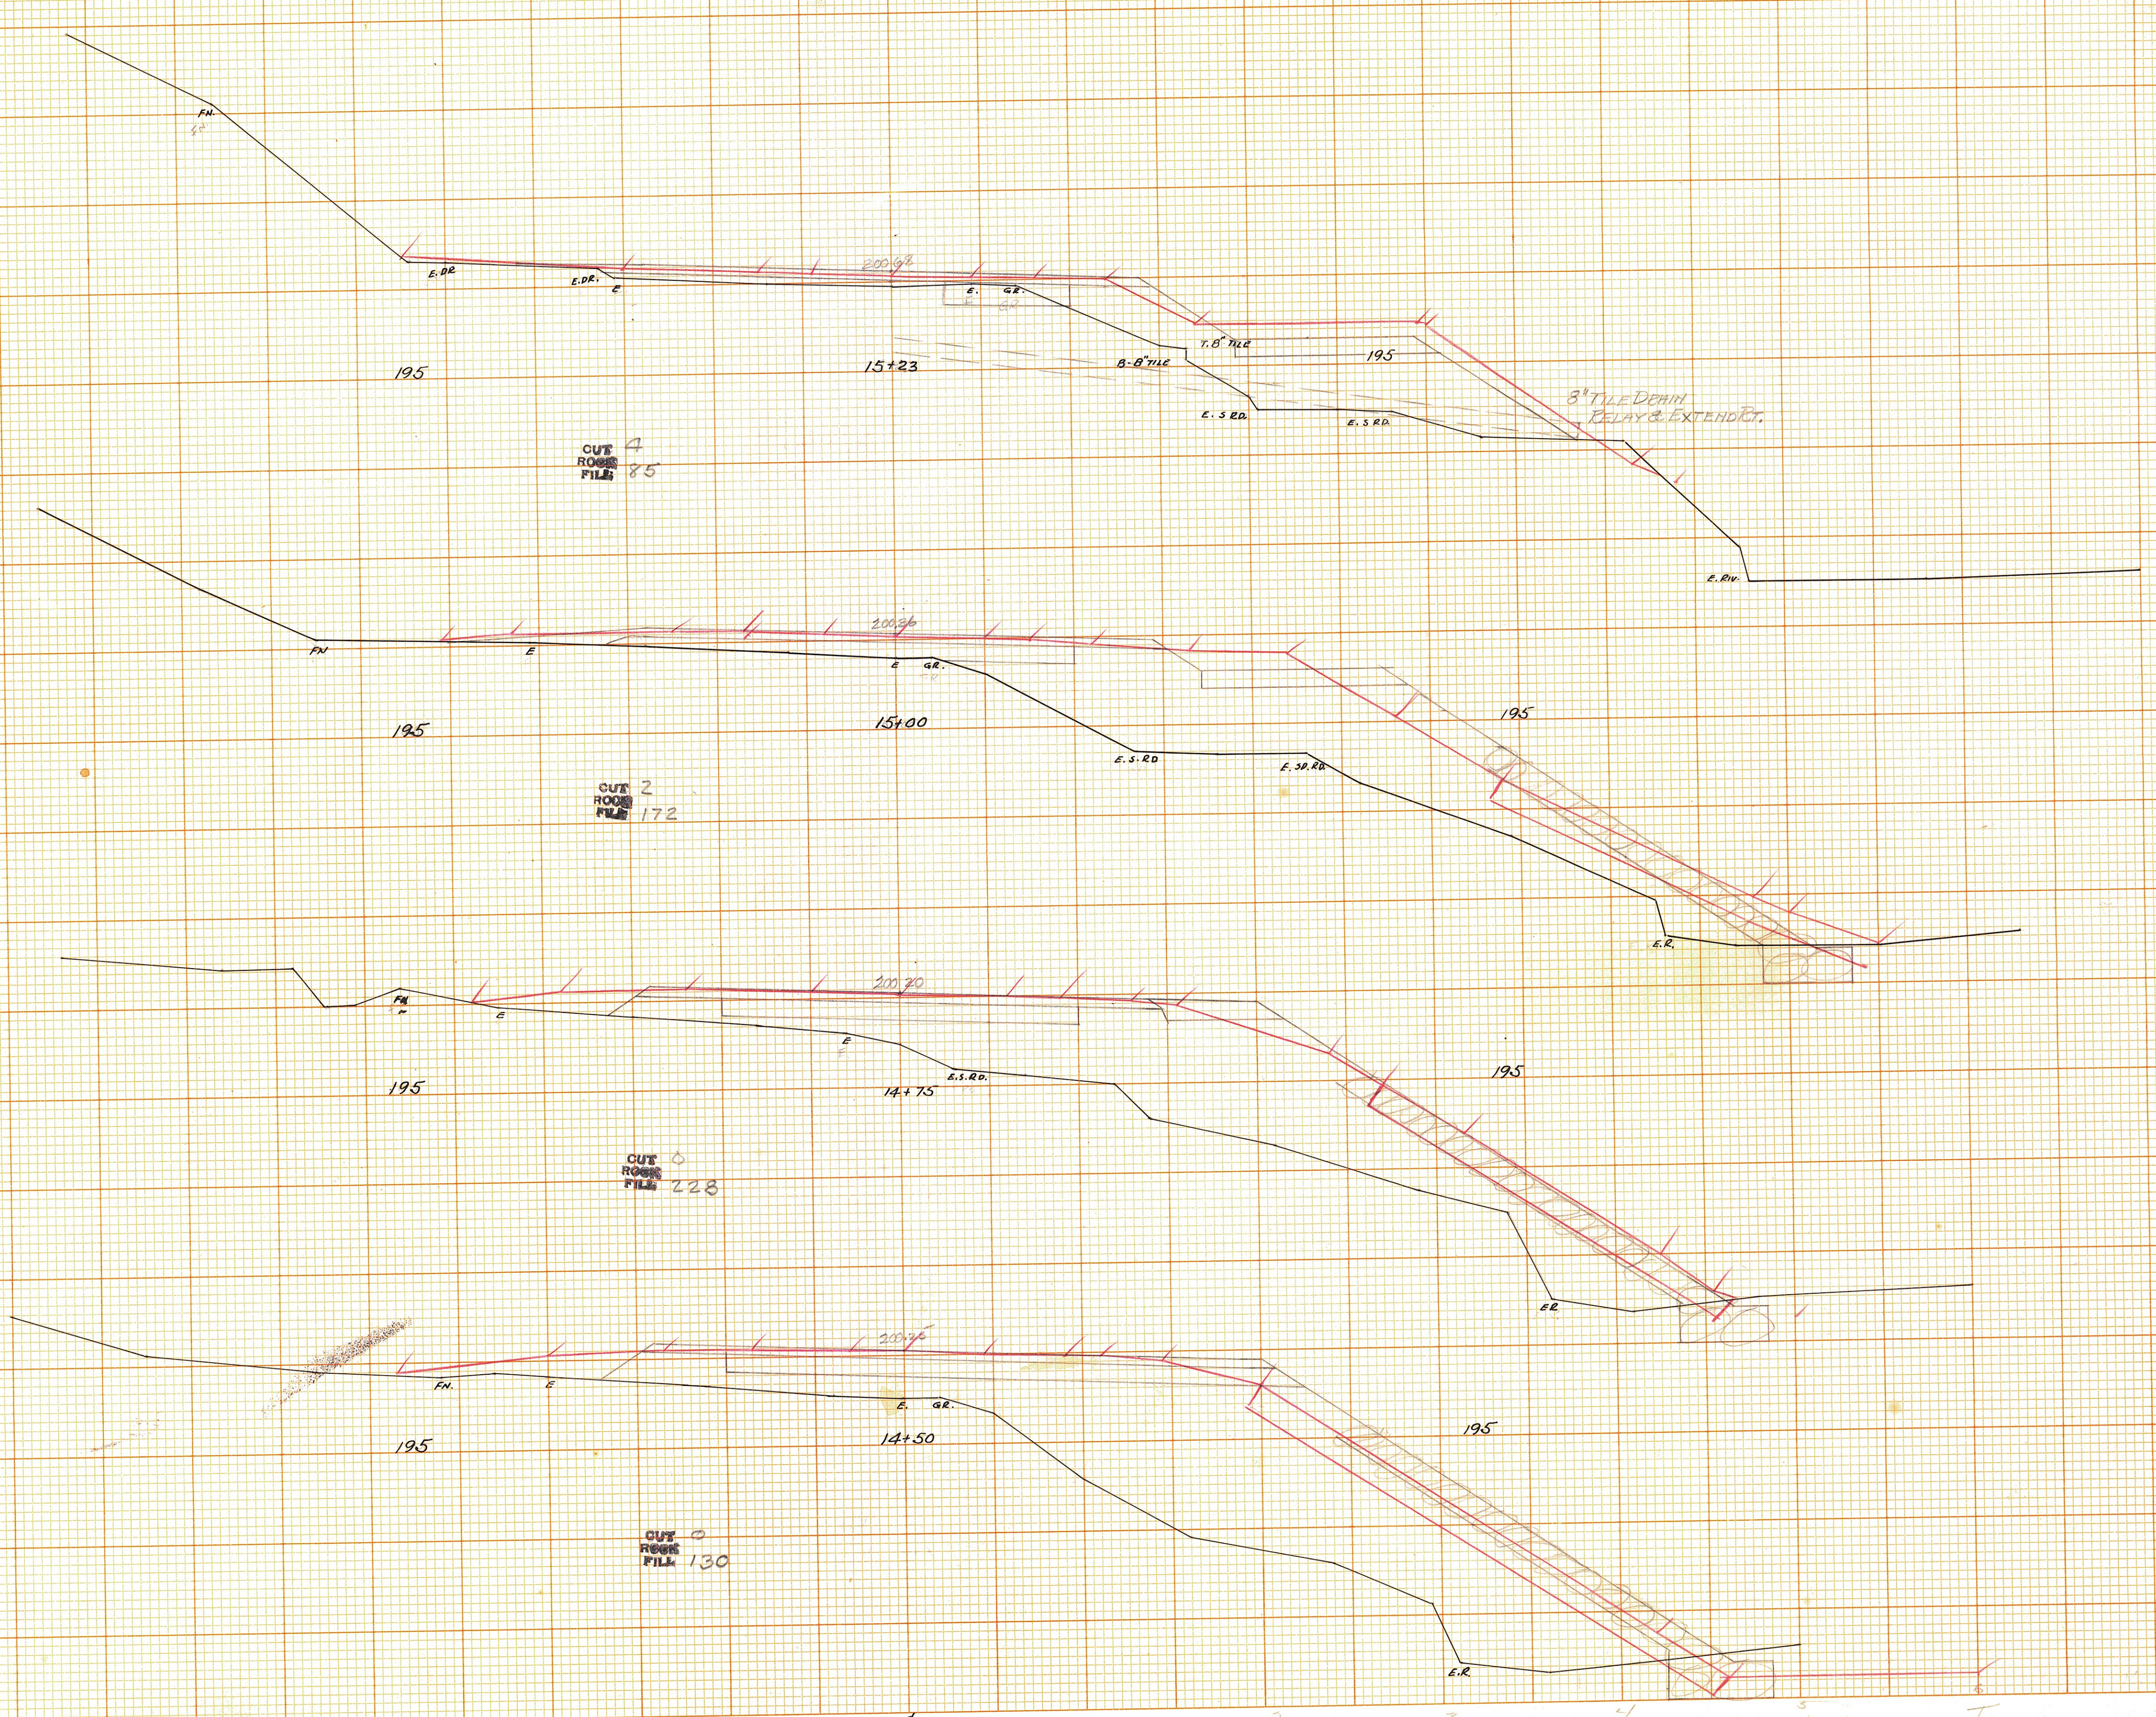

CUT ROADS
FILE 85

CUT ROADS
FILE 172

CUT ROADS
FILE 228

CUT ROADS
FILE 130

MARKET BRIDGE
TUNBRIDGE
ST. 199-L
SHEET 16 OF 17