
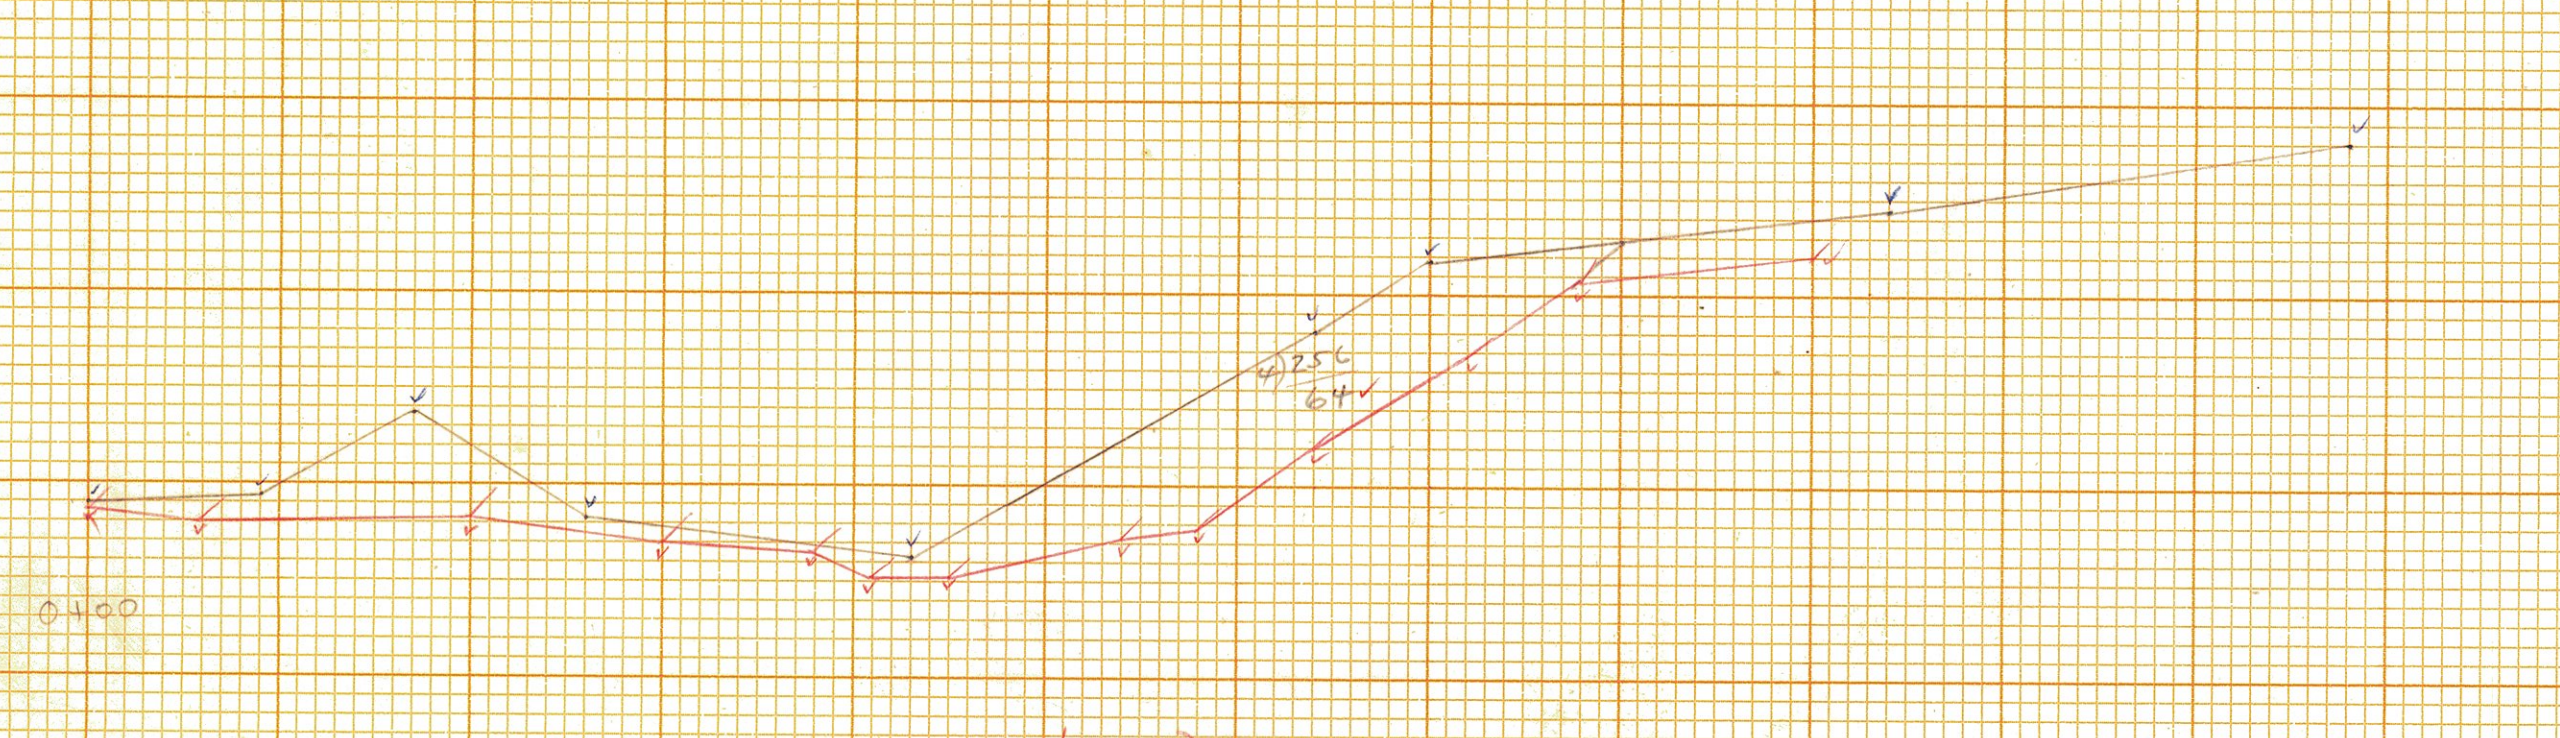
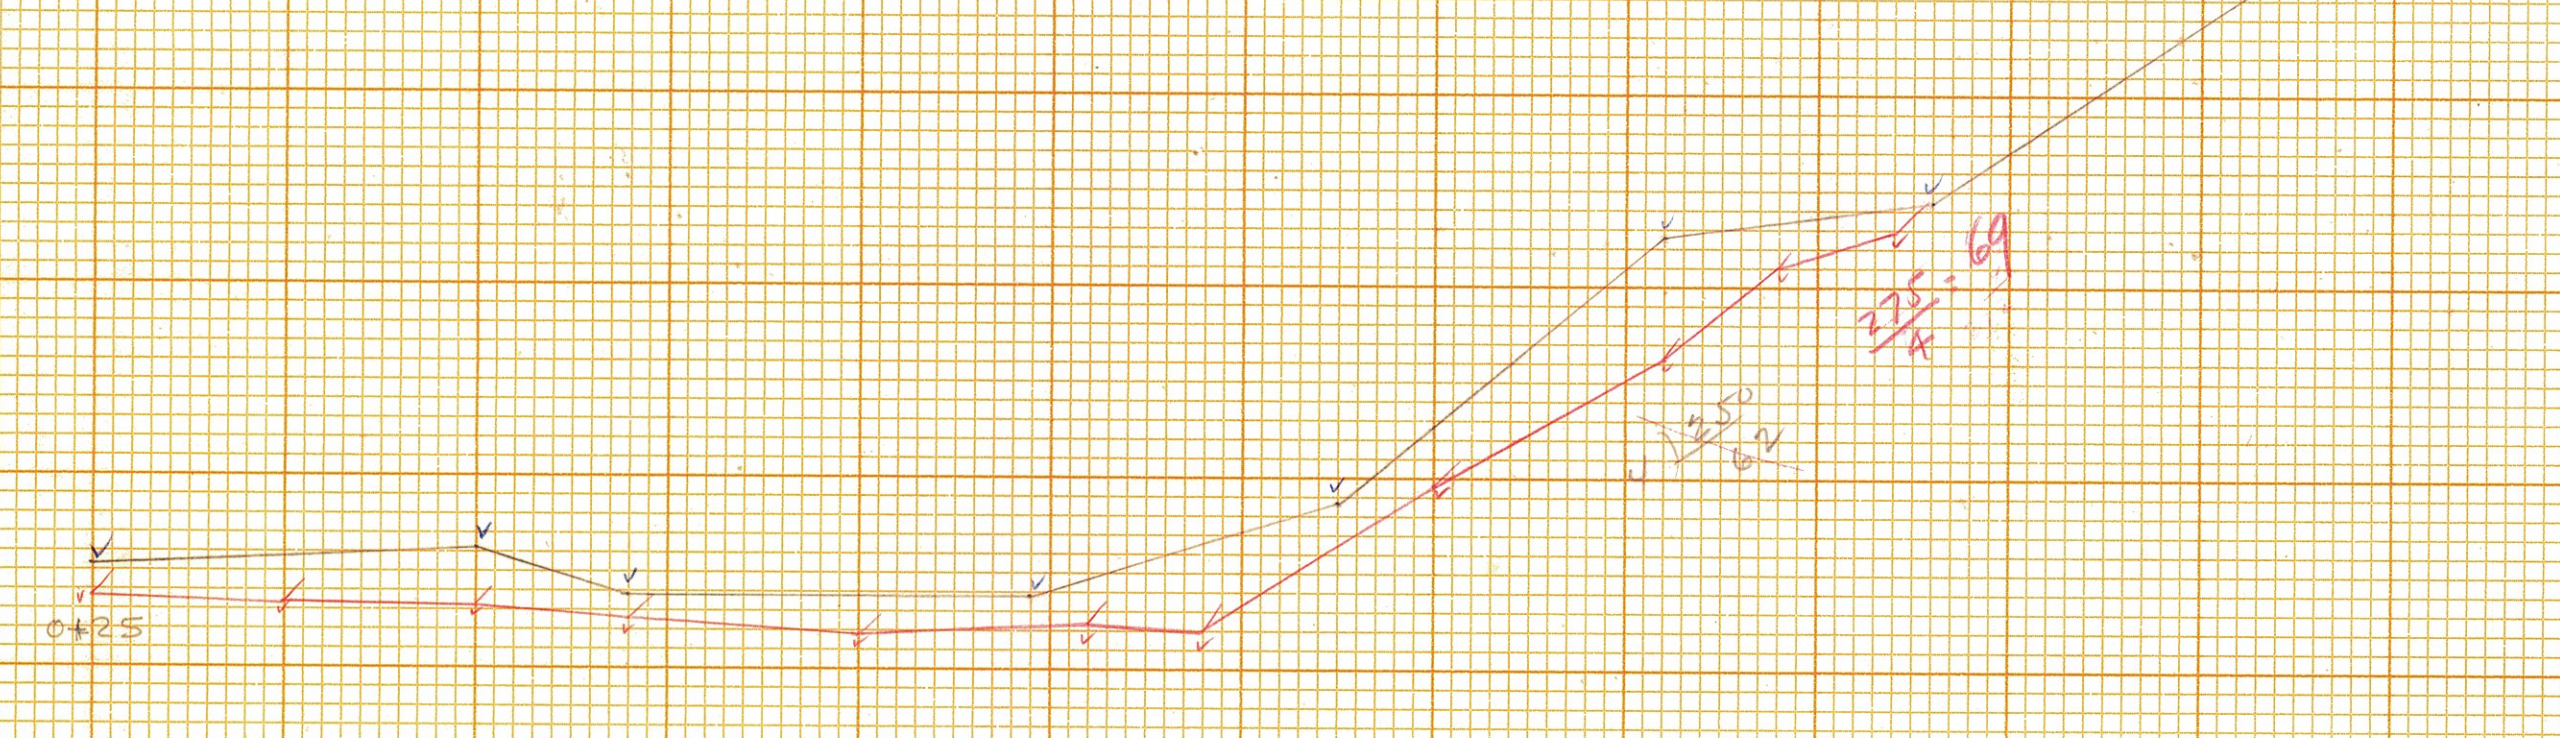
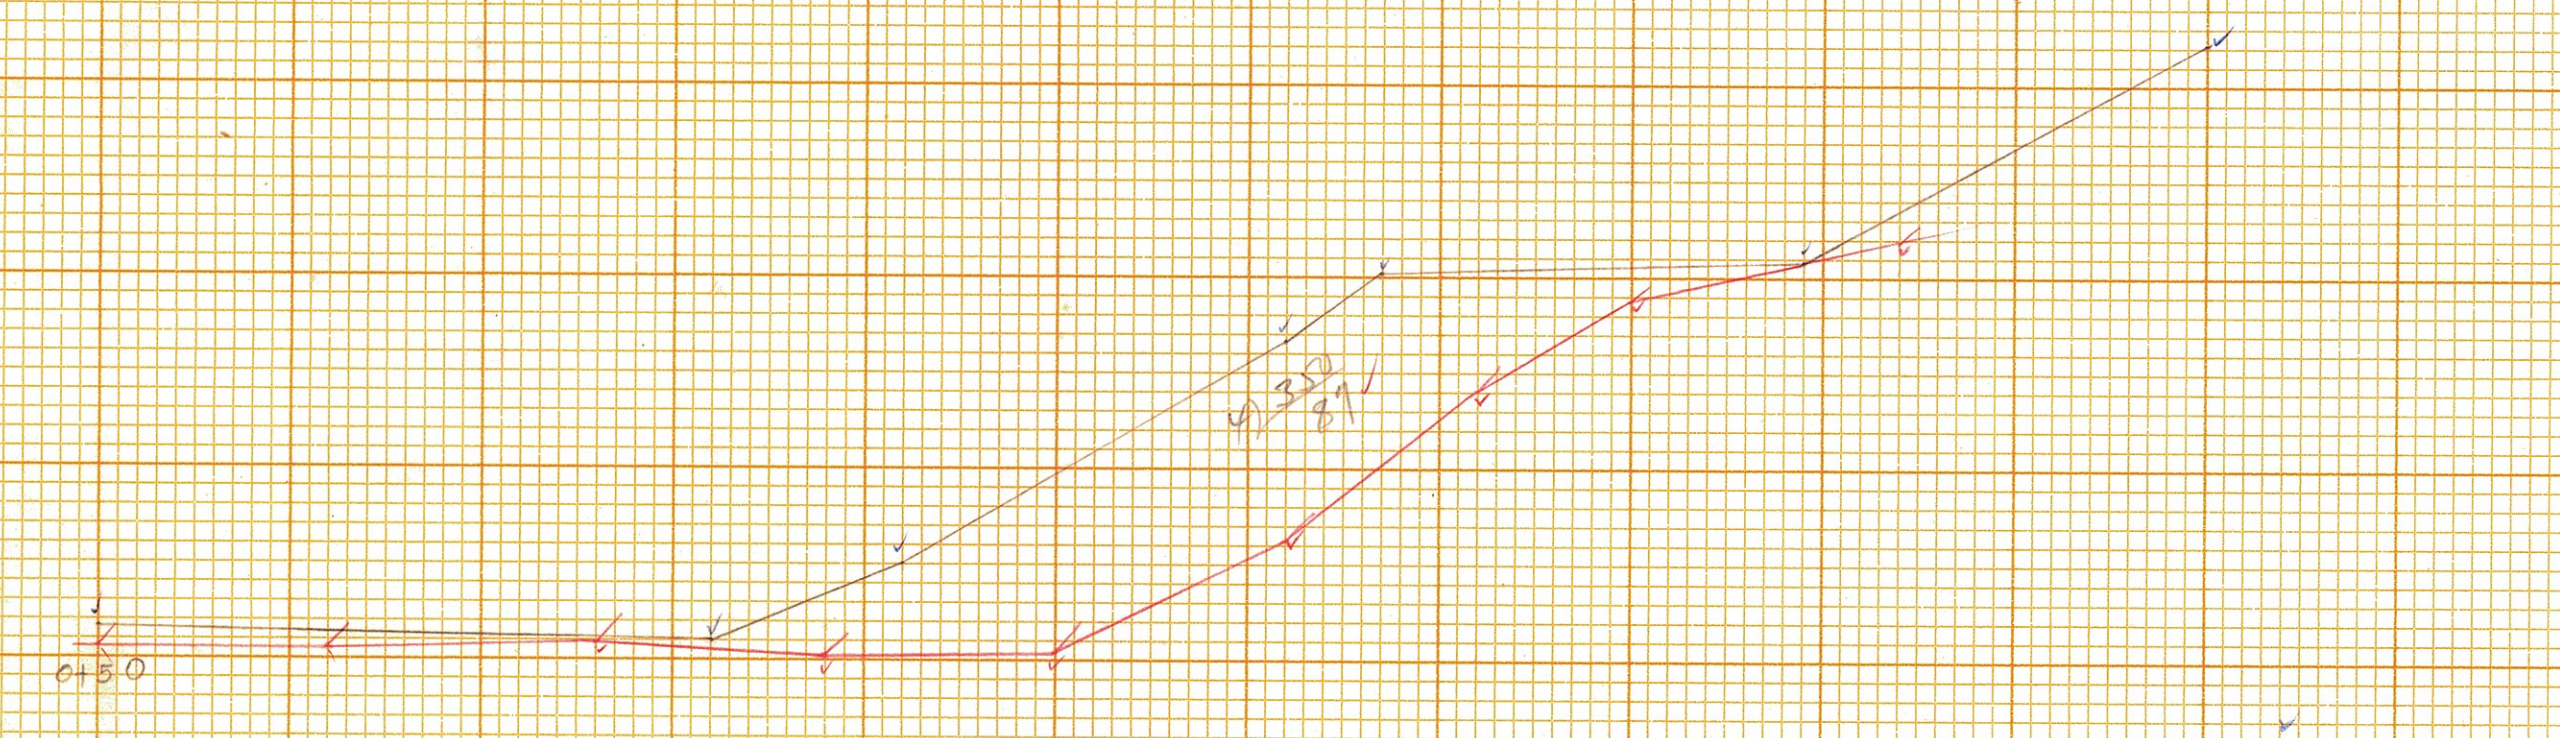





Hayward Berrow Pt.

STA	Area	Dist	Vol
0+00	64	10	320
+25	82.69	25	1443
+50	87	25	1675
+75	85	25	2150
+100	95	25	2250
+125	54	25	1675
+150	145	25	2238
+175	0	25	1812
TOTAL			13820
CY			512

O-CUT = 1+75

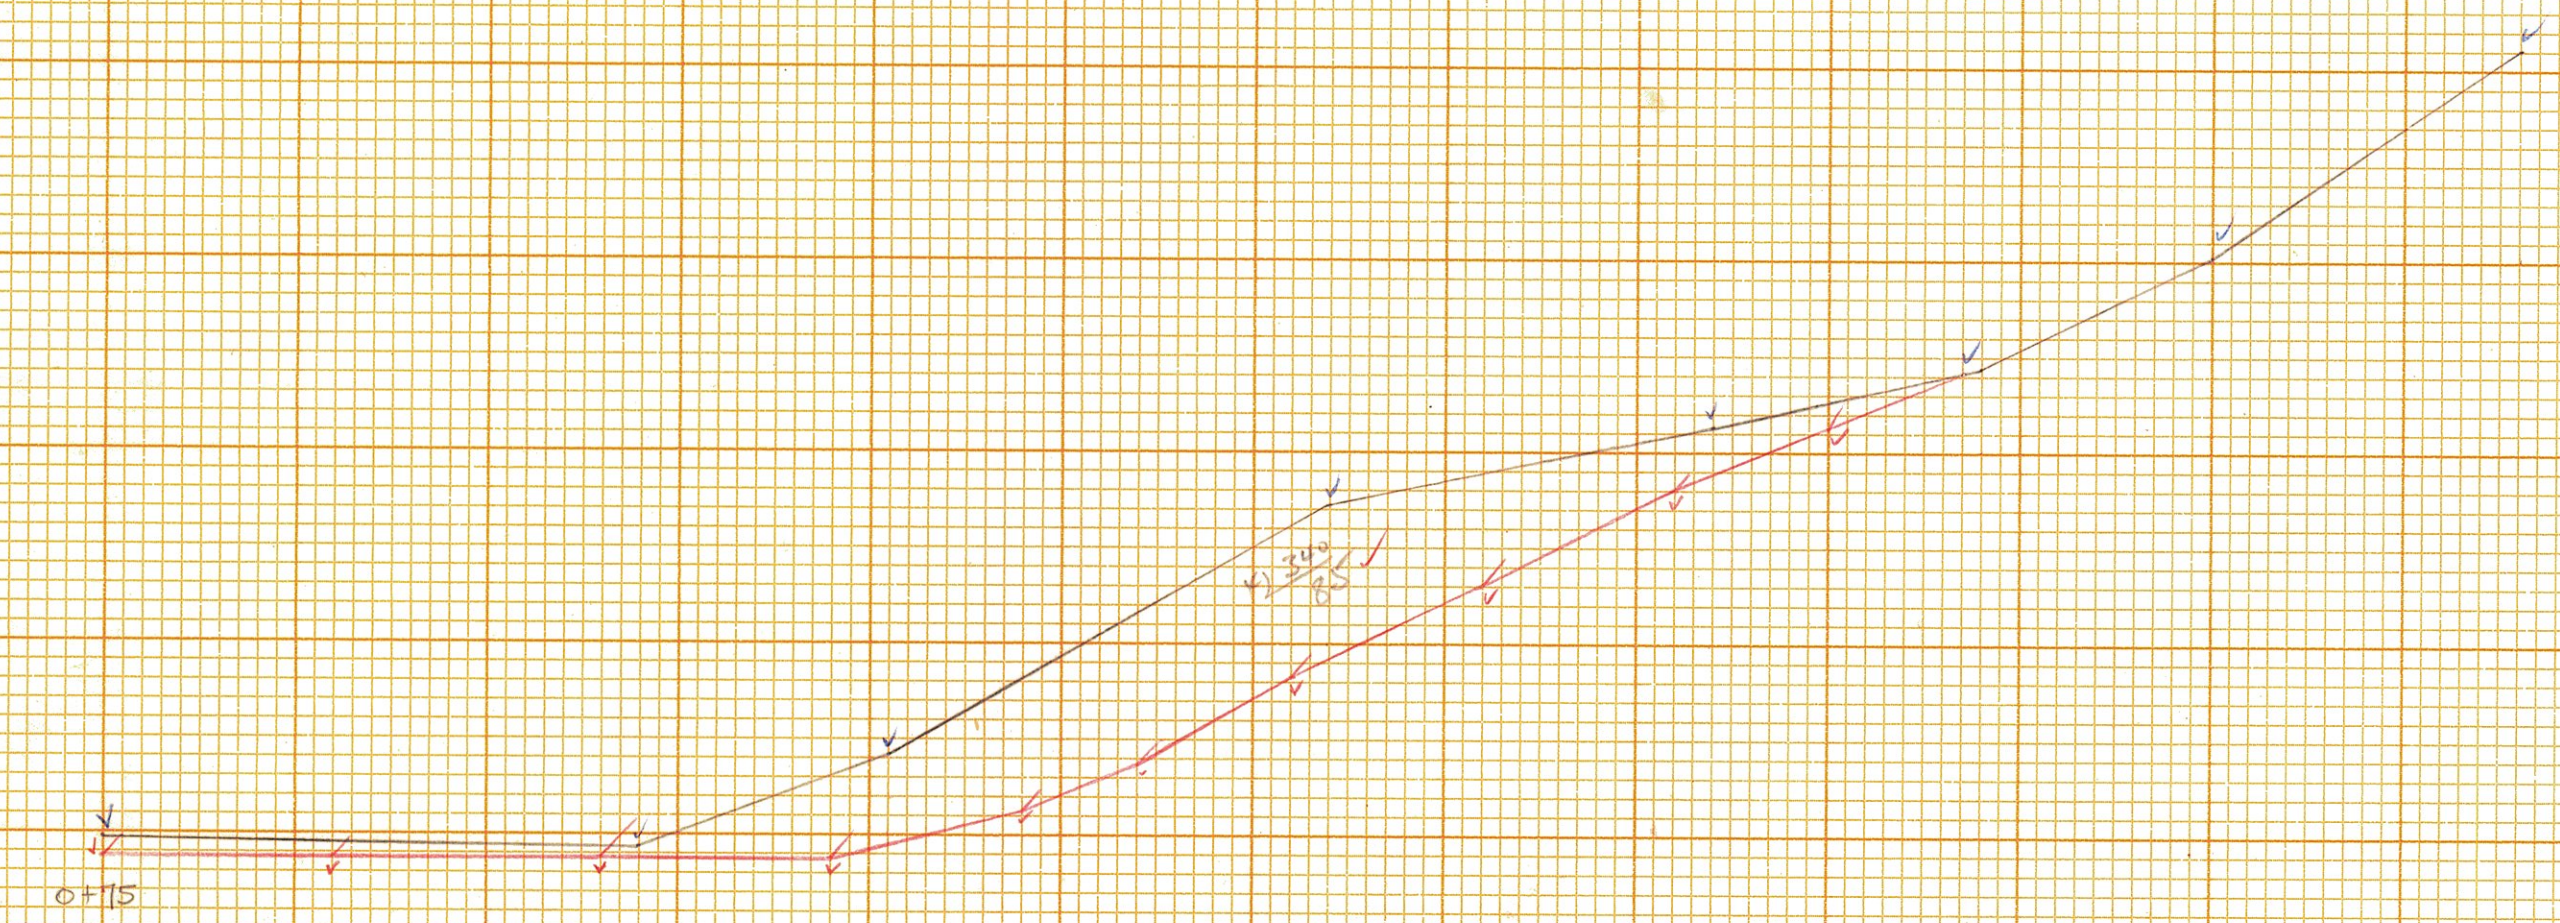

O-CUT = -(0+10)

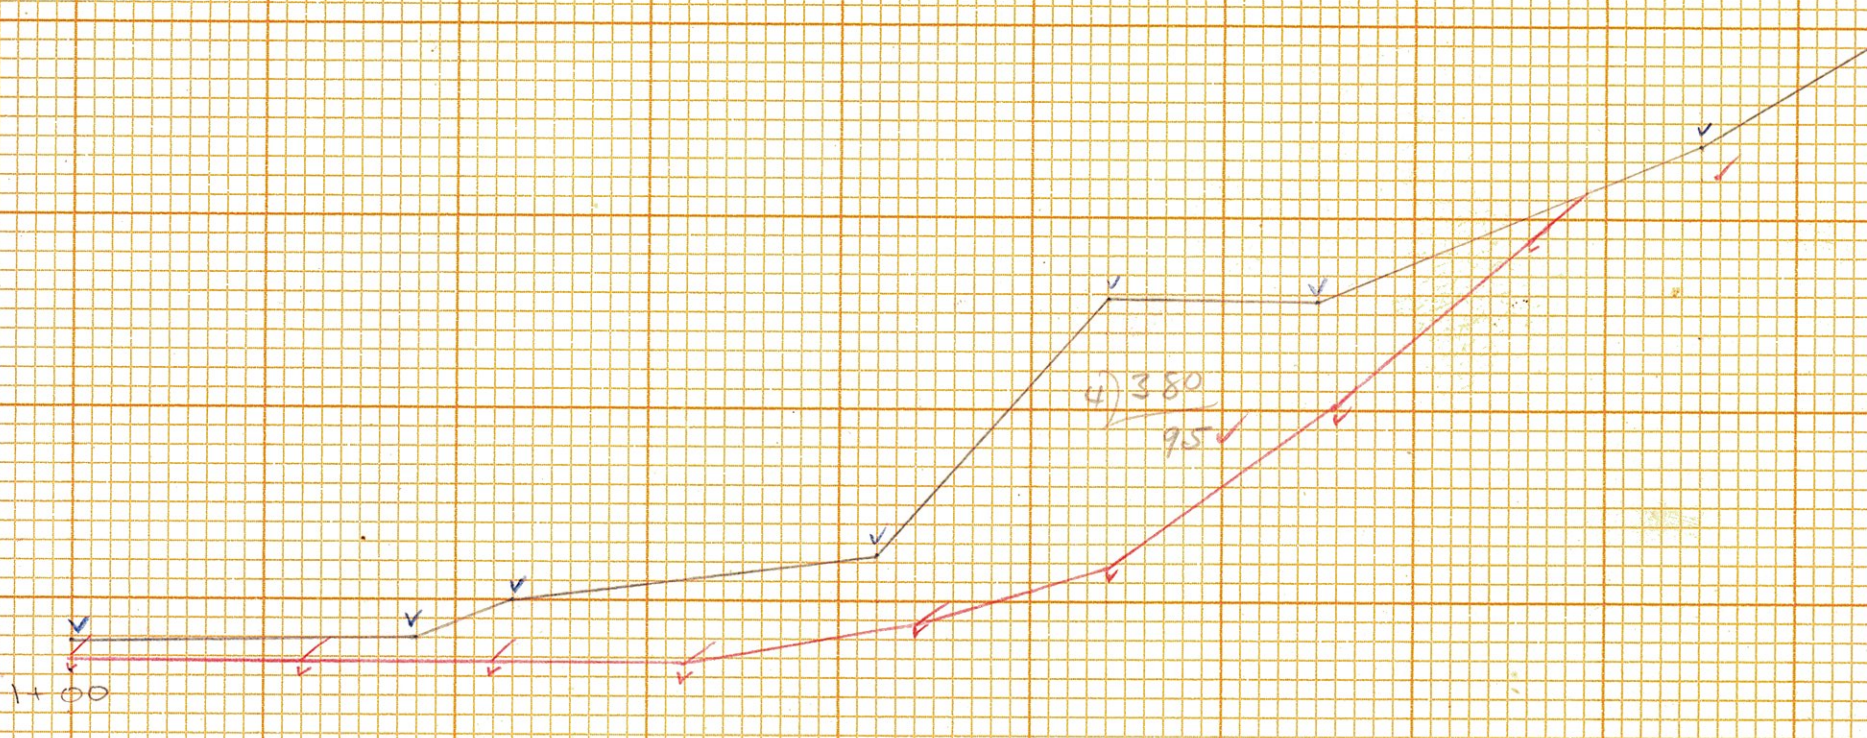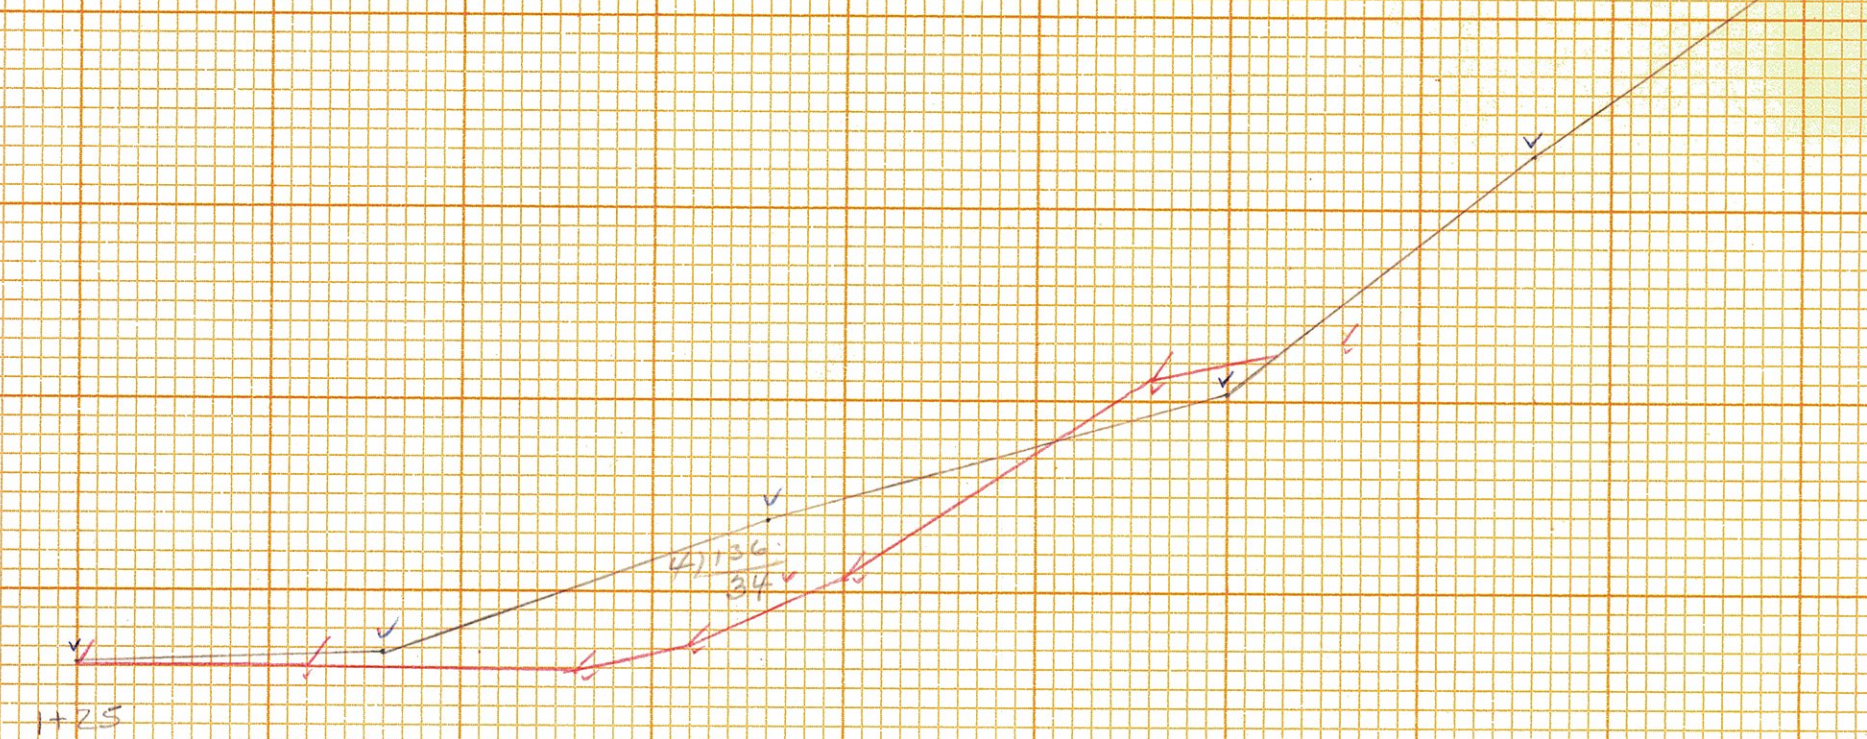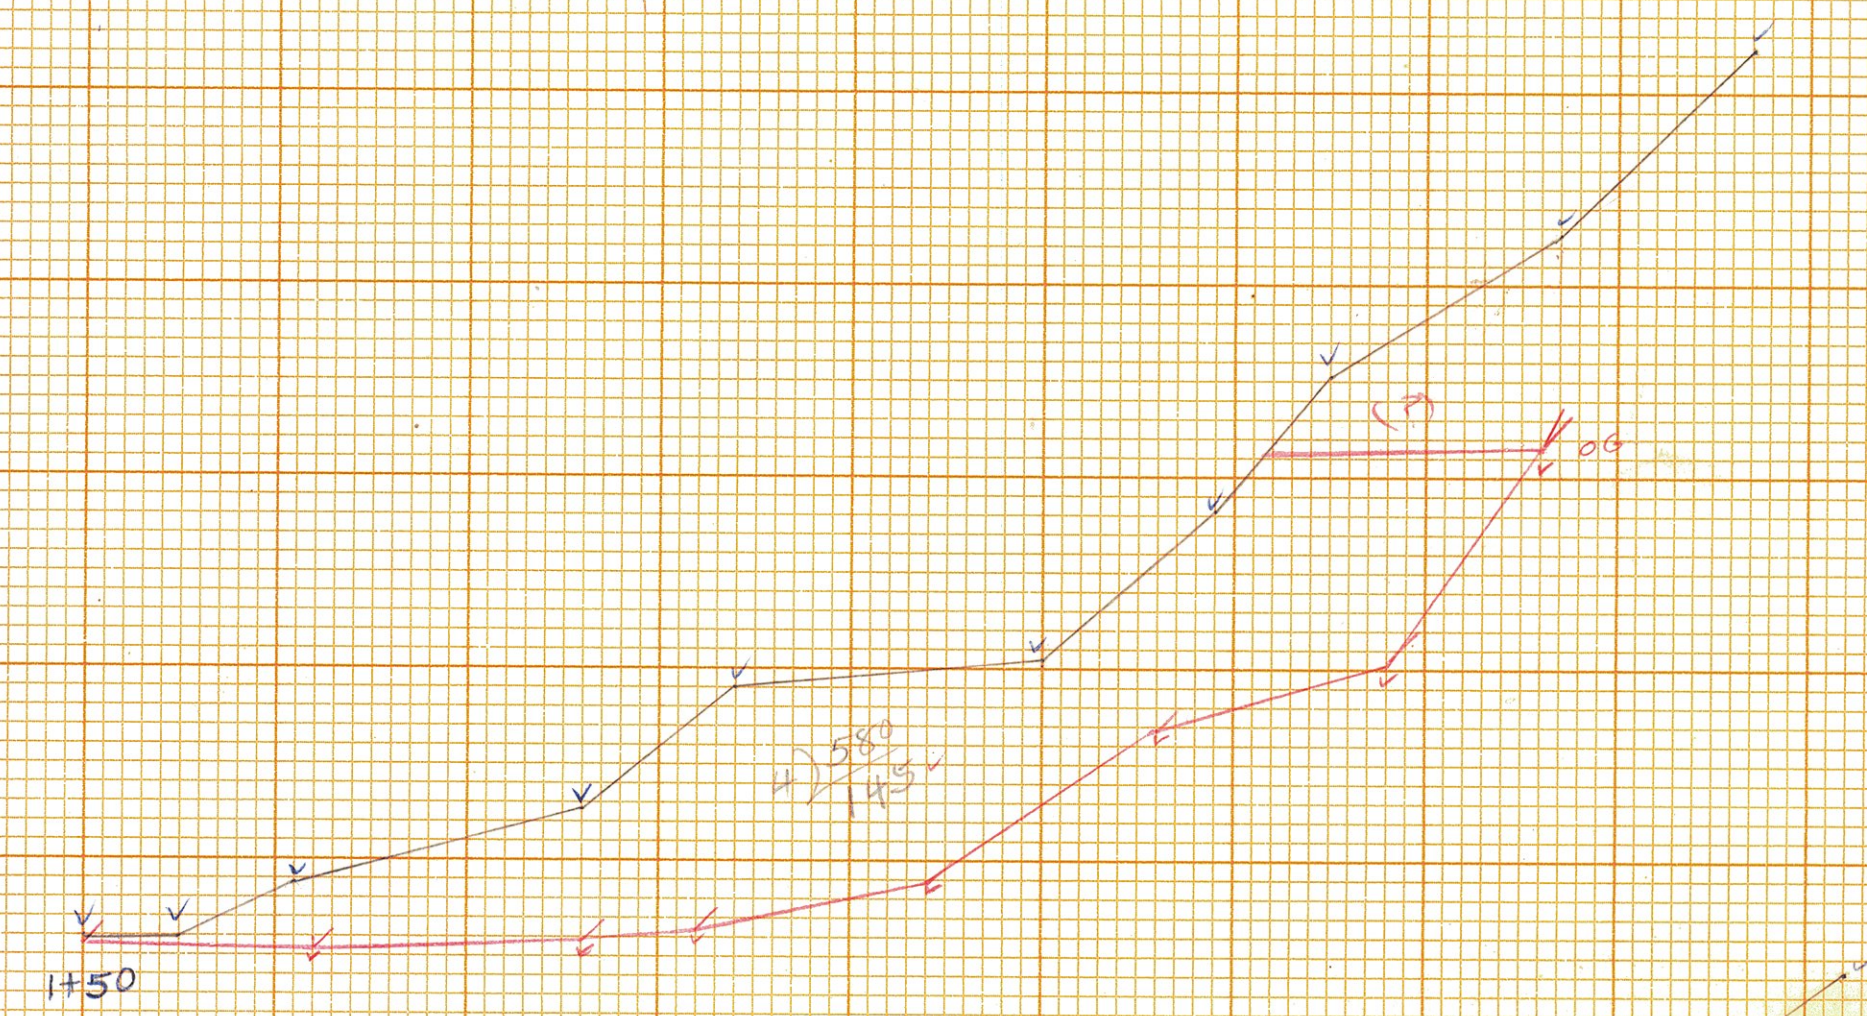

TENBRIDGE STATE 194L  
MARKET BRIDGE  
Hayward Berrow Pt.