


LINES SHOWN ON THIS PLAN AS EXISTING PROPERTY LINES P/L ARE BELIEVED TO BE ACCURATE BUT SHOULD NOT BE RELIED UPON FOR PURPOSES UNRELATED TO THE TOWN OF CAMBRIDGE'S ACQUISITION OF LAND AND RIGHTS FOR THIS PROJECT.

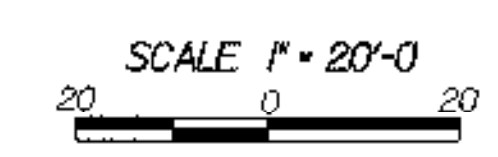

SIGN LAYOUT SHEET			
PROJECT NAME:	CAMBRIDGE		
PROJECT NUMBER:	BHO 1448(31) C/2		
FILE NAME:	/00J244/str/sj244bdr.dgn	PLOT DATE:	07-AUG-2002
PROJECT LEADER:	D. HOYNE	DRAWN BY:	R. PELLETT
DESIGNED BY:	M. FOWLER	CHECKED BY:	M. GAGULIC
			SHEET # OF 62