
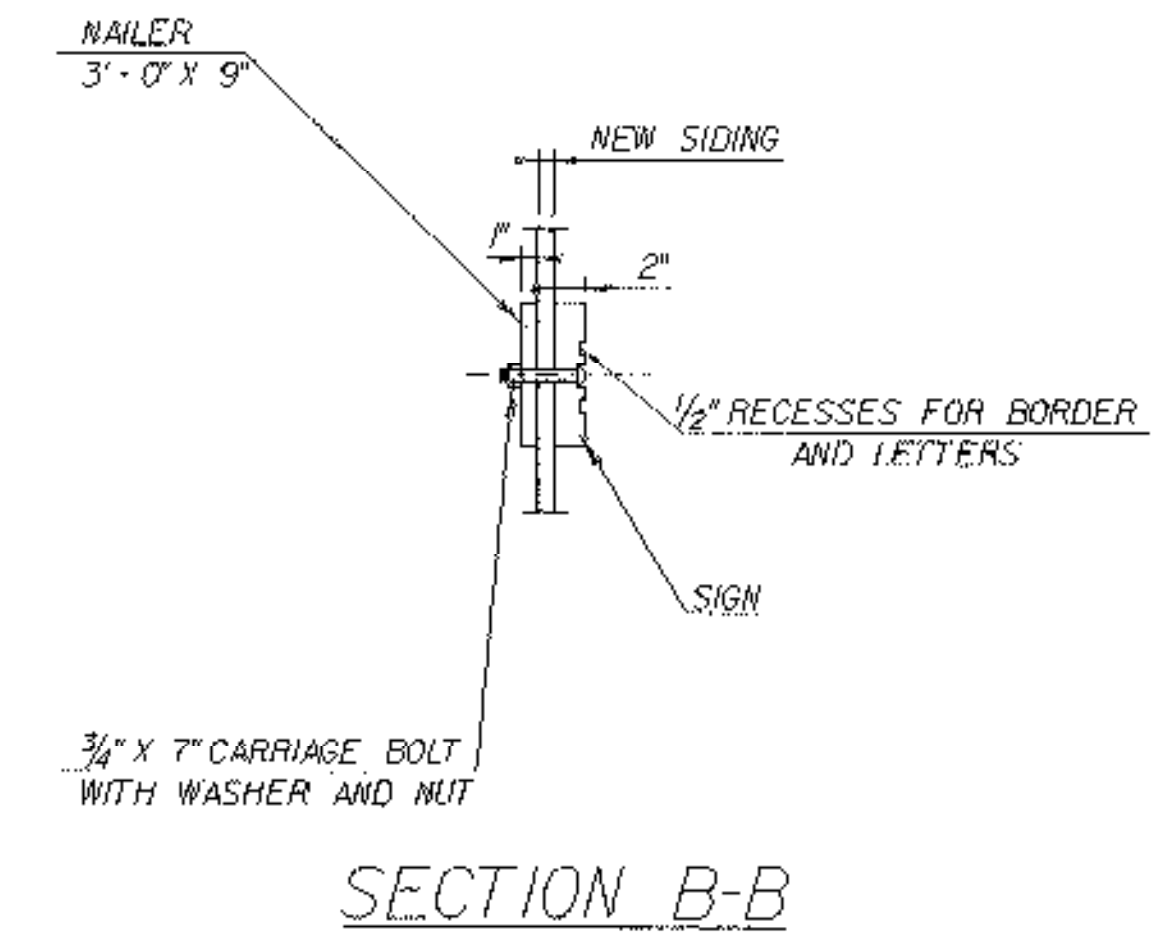


VR352A
 1.500" RADIUS, 0.625" BORDER, 0.375" INDENT, BLACK ON WHITE;
 "ONE" C, "VEHICLE" C, "ONE BRIDGE" C SPECIFIED LENGTH;
 "AT A TIME" C SPECIFIED LENGTH;

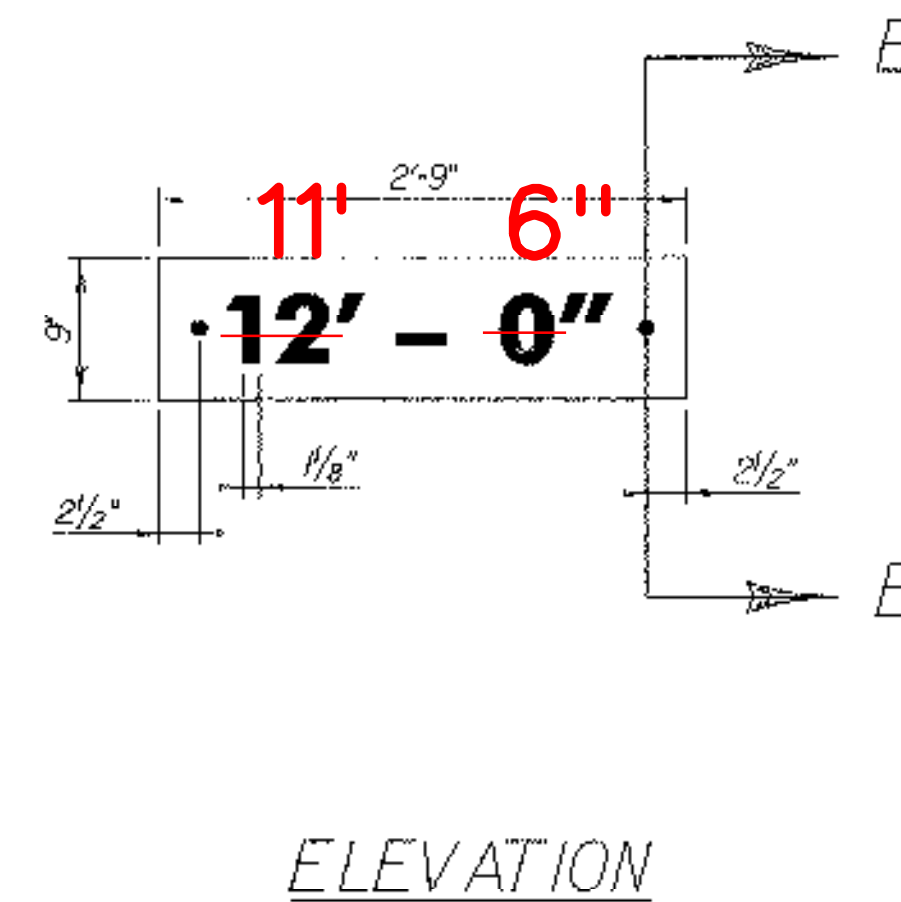

TRAFFIC SIGN DETAIL SHEET

PROJECT NAME:	CAMBRIDGE	PLOT DATE:	07-AUG-2002
PROJECT NUMBER:	BHO 1448(31) C/2	DRAWN BY:	R. PELLETT
FILE NAME:	/00J244/str/sj244sign.dgn	CHECKED BY:	M. FOWLER
PROJECT LEADER:	D. HOYNE	SHEET	13 OF 62
DESIGNED BY:	M. GAGULIC		