


EXISTING SIDE FRAMING PLAN TRUSS 1

TRUSS 2 SIMILAR - SEE TABLE FOR MEMBERS TO BE REPLACED

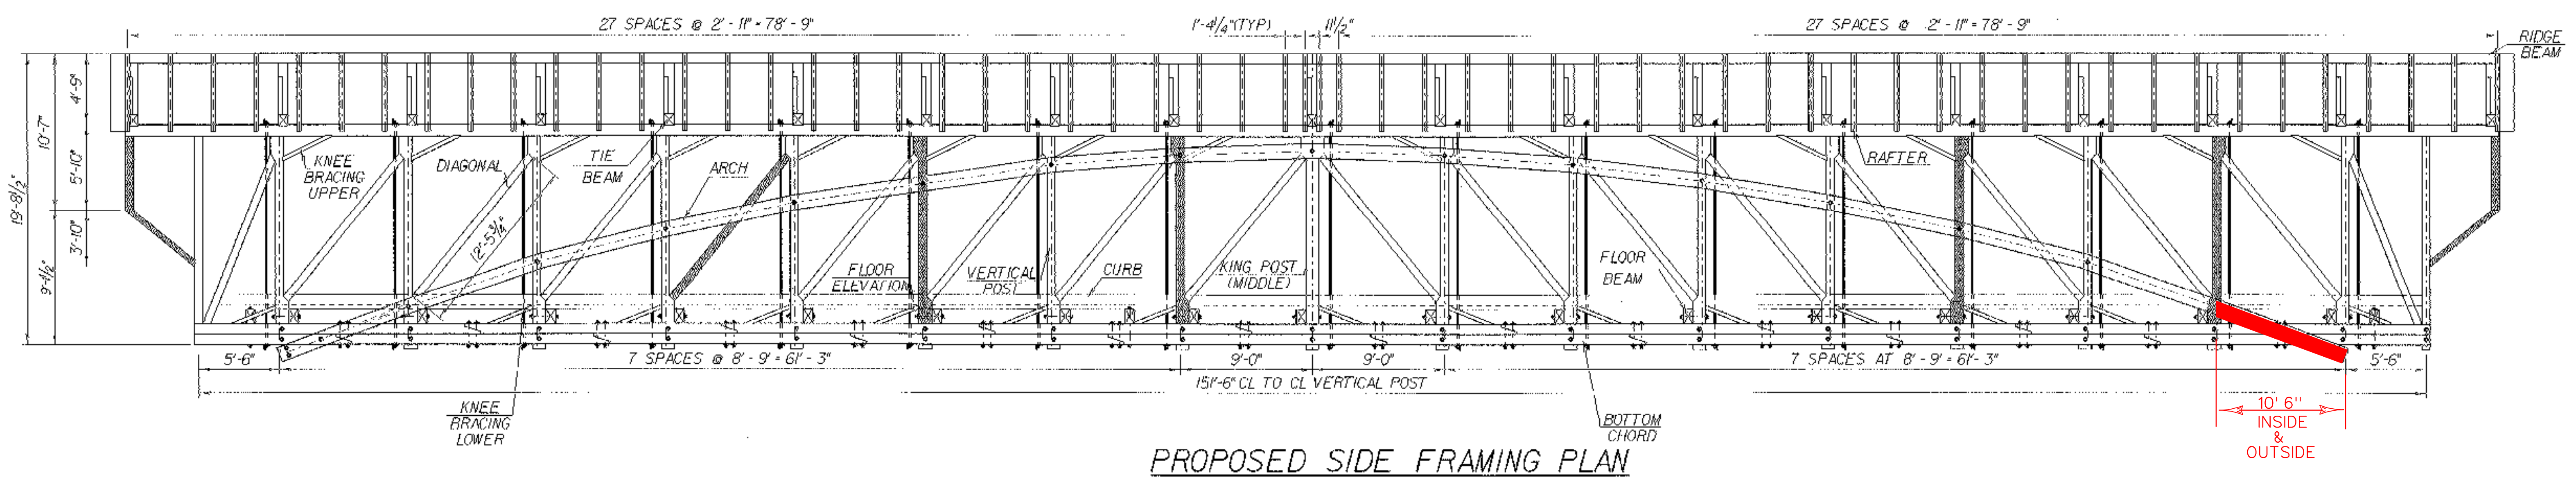


PROPOSED SIDE FRAMING PLAN

MEMBER	SYMBOL	LENGTH	WIDTH	THICKNESS	TOTAL NO.	REPLACE	
						TRUSS 1	TRUSS 2
DIAGONAL	D	12' - 5 3/4"	10"	6"	38	D5,6	D15, D18, D19, D3
RAFTER	R	12' - 10"	3 1/2"	5"	116	KBU 1,3,4,5,6,7,12,14,15,16	KBU 11,12,13,14,15,1
KNEE BRACING UPPER	KBU	3' - 9 5/8"	10"	3"	32	KBL 1,2,3,4,5,6,7,8,10,11,13,14,15,16,17	KBL 16,17,10,11,12,13,14,15,1,2,3,4,5,6,7,8
KNEE BRACING LOWER	KBL	3' - 0 1/8"	10"	4"	34	VB 1,2,4,6,7,8,10,14,15,16	VB 12,4,8,9,10,11,6,7,15,16,17
KING BRACING	VB	5' - 0 3/8"	4"	5"	38	KP1, KP2, KP3, KP5, KP8, KP15, KP16	
ARCH SEGMENT	AS						
KING POST	KP	15' - 3 1/2"	10"	15 1/2" @ 1/2"	38	KP7, KP9, KP17, KP18, KP19	KP9, KP15, KP17, KP18, KP19
VERTICAL OVERHANG	VO	5' - 0"	4"	4"	4	V01, V02	V03, V04
DIAGONAL OVERHANG	DO	6' - 0 3/4"	4"	4"	4	DO1, DO2	DO3, DO4
VERTICAL RODS	VR	15' - 7 1/2"			34		

NOTE:
BOTTOM CHORD HARDWARE INSTALLED IN CONTRACT / NOT SHOWN FOR CLARITY

LEGEND:
 - REMOVE SHADED MEMBERS
 - REPLACE HATCHED MEMBERS

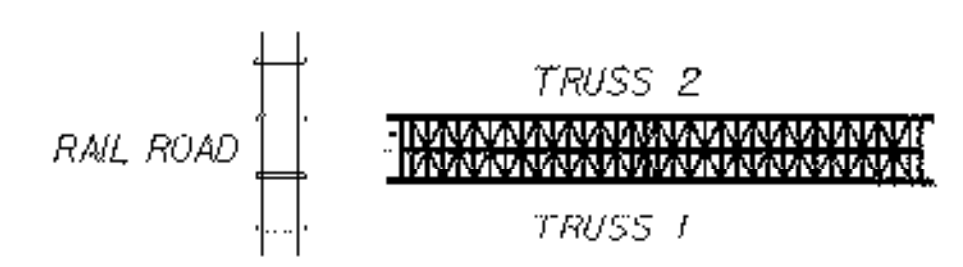

ELEVATION FRAMING SHEET

PROJECT NAME: CAMBRIDGE
 PROJECT NUMBER: BHO 1448(31) C/2

FILE NAME: /00244/sjr/sj244bdg.dgn
 PROJECT LEADER: DAVID HOYNE
 DESIGNED BY: M. GAGULIC
 sj244@fp.i

PLOT DATE: 07-AUG-2002
 DRAWN BY: R. PELLETT
 CHECKED BY: M. FOWLER
 SHEET 16 OF 62

SCALE 3/16" = 1'-0"