

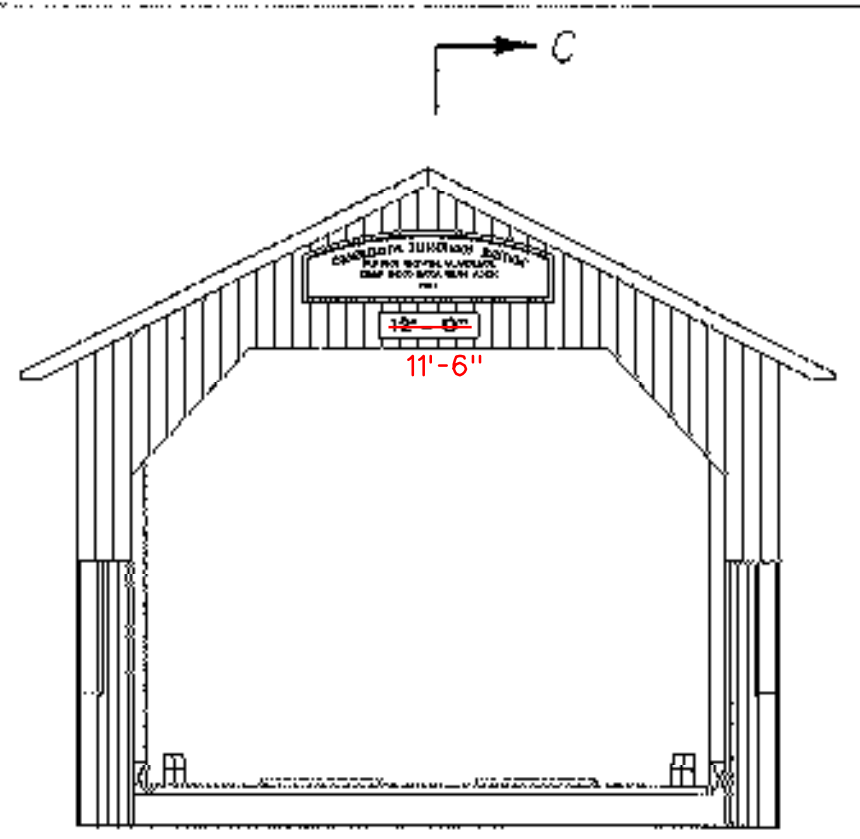
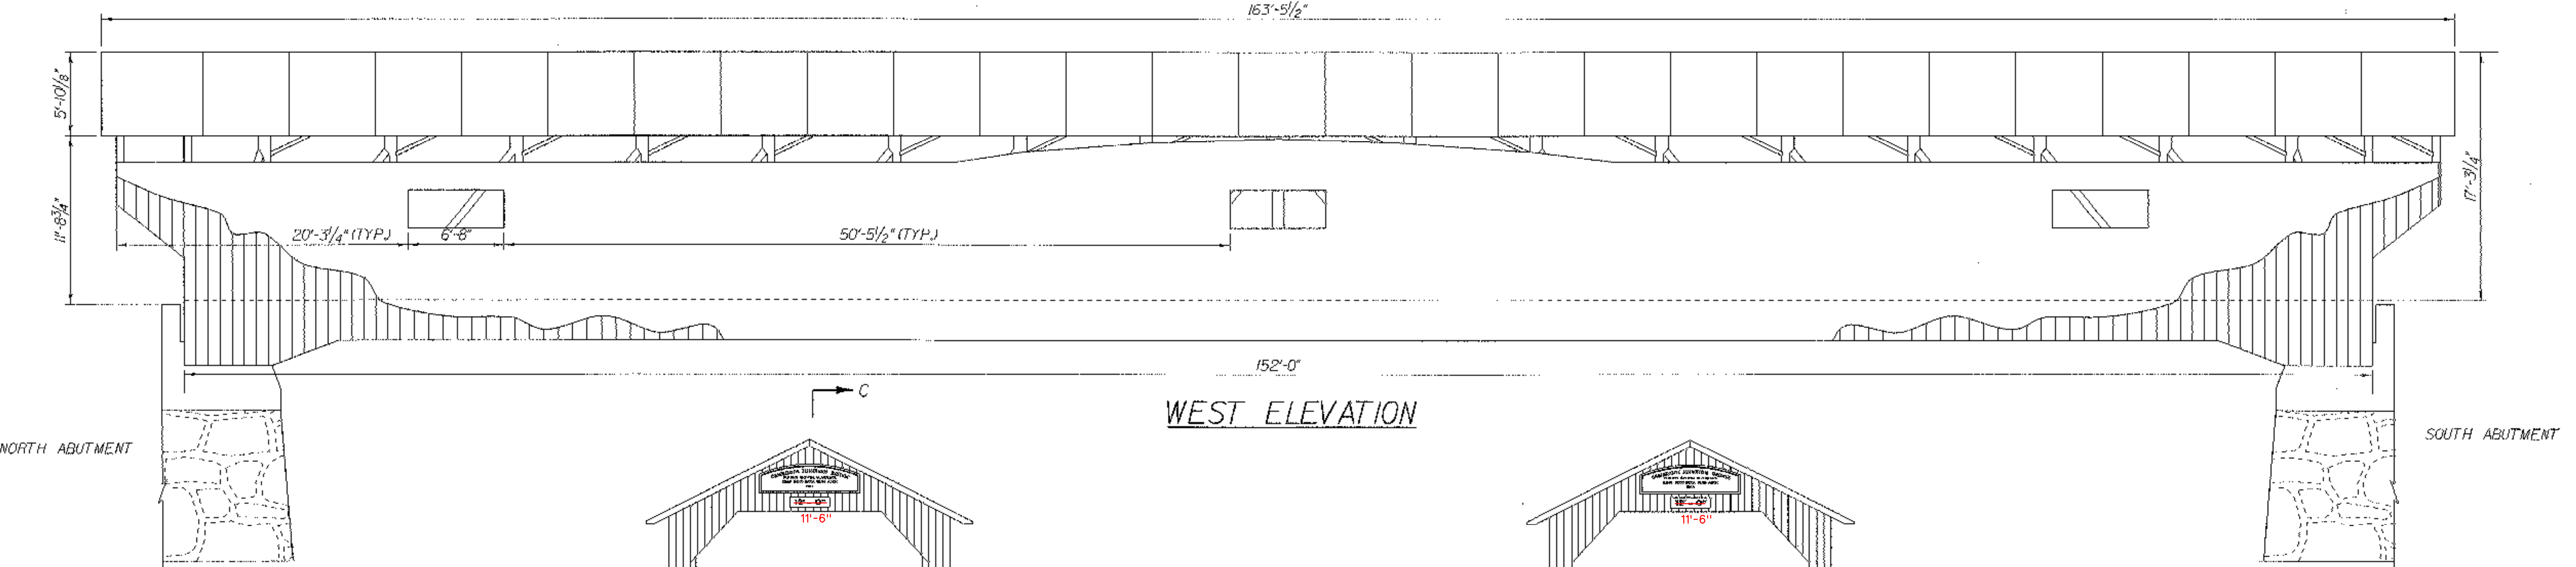


PROPOSED ELEVATIONS

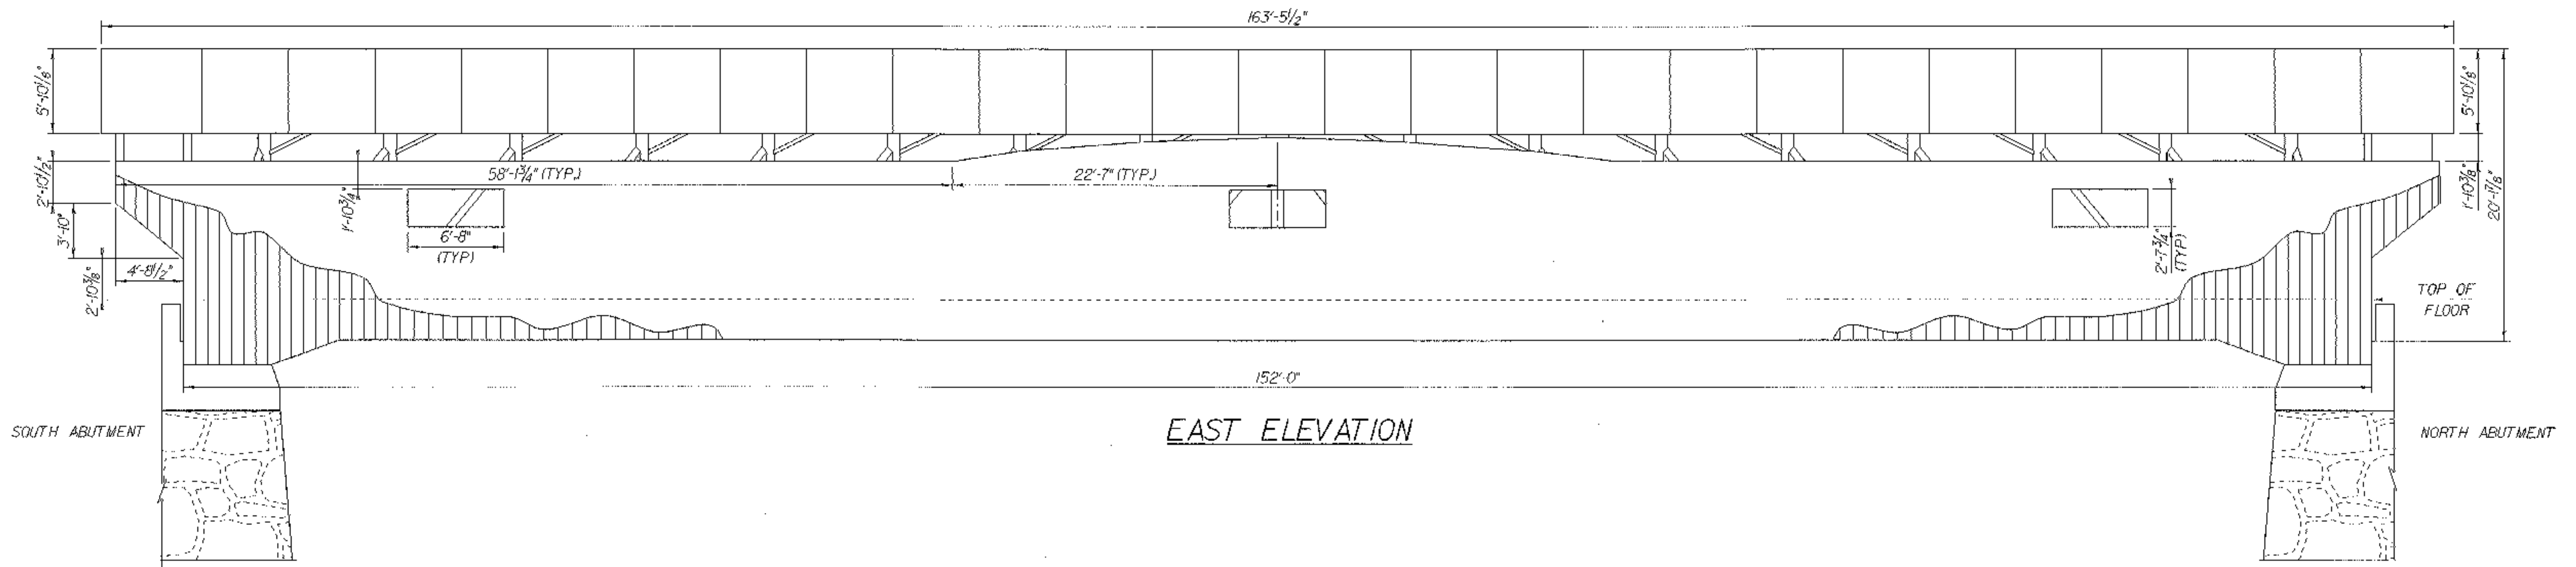

SEE SHEET 22 FOR SECTION C-C

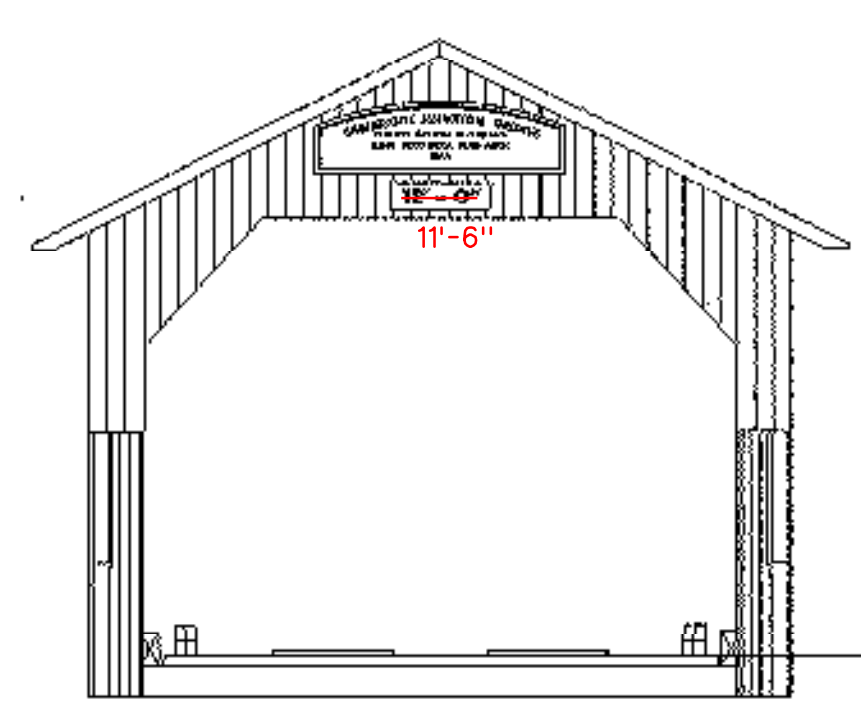

SCALE 3/16" = 1'-0"
1 0 2 4 6 8

ELEVATION SHEET

PROJECT NAME: CAMBRIDGE	PLOT DATE: 07-AUG-2002
PROJECT NUMBER: BHO 1448(31) C/2	DRAWN BY: R. PELLETT
FILE NAME: /001244/str/sj244bdg.dgn	CHECKED BY: M. FOLWER
PROJECT LEADER: DAVID HOYNE	SHEET 21 OF 62
DESIGNED BY: M. GAGULIC	
sj244elev.l	