
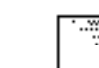
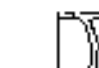
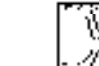


-  NEW CONCRETE
-  NEW STONE WALL
-  EXISTING LAID UP STONE

ABUTMENT 1 PLAN & ELEVATION SHEET

PROJECT NAME:	CAMBRIDGE	PLOT DATE:	07-AUG-2002
PROJECT NUMBER:	BHO 1448(31) C/2	DRAWN BY:	R. PFLIETT
FILE NAME:	/00J244/str/sj244abut1.dgn	CHECKED BY:	M. FOWLER
PROJECT LEADER:	D. HOYNE	SHEET	29 OF 62
DESIGNED BY:	M. GAGULIC		

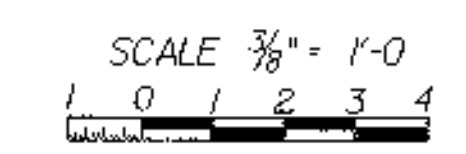

ELEVATION ABUTMENT 1