

# RIGHT - OF - WAY DETAIL SHEET


TABLE OF PROPERTY ACQUISITION

PARCEL NO.	PROPERTY OWNER	SHEET NO.	BEGINNING STATION	ENDING STATION	TAKE AREA±	REMAINDER AREA±	RIGHT			RECORDING DATA				REMARKS
							TYPE	(T)/(P)	AREA ±	TITLE	DATE	TOWN / CITY	BOOK	
1	BEANE, VANCE G. & VIOLA S.	7	7+14.8 RT.				INSTALL	(T)						GUY ANCHOR
2	MELVILLE, DIANNA	7	7+07.3 LT. 7+16.6 LT. 7+47.9 LT. 7+94.6 LT.	7+96.1 LT. 7+92.5 LT. 9+78.7 LT.			INSTALL SLOPE DETOUR	(T) (T) (T)	863 SF 164 SF 0.09 A			HUNTINGTON		MONITOR WELL EROSION CONTROL  3,766 SF±; INCL. EROSION CONTROL & TEMP. UTILITY RELOCATION EROSION CONTROL 1,692 SF±
			8+27.6 LT. 8+30.8 LT. 8+73.9 LT. 8+77.9 LT. 8+78.2 LT.	8+76.2 LT. 9+78.7 LT. 9+21.5 LT. 8+95.7 LT. 9+03.2 LT.			INSTALL UTILITY CHANNEL SLOPE INSTALL	(T) (P) (P) (P) (T)	1216 SF 0.04 A 821 SF 55 SF 115 SF					EROSION CONTROL
3	LACAILLADE, LEIGH	7	8+33.0 RT. 9+03.9 RT. 9+51.4 RT. 9+18.5 RT.	9+70.0 RT. 10+11.2 RT. 10+56.1 RT.			ACCESS CHANNEL CONST.	(T) (P) (T)	1,050 SF 976 SF 2,650 SF			HUNTINGTON		EXCEPT & RESERVE SEPTIC SYSTEM  INCL. EROSION CONTROL
4	BRACE, LISA M. & DELISLE, LESTER J.	7	9+32.7 LT.	12+78 LT.			DETOUR	(T)	0.29 A			HUNTINGTON		12,590 SF±; INCL. EROSION CONTROL, TEMP. UTILITY RELOCATION, & PDF 2,999 SF±
			9+54.5 LT. 10+59.0 LT. 10+81.0 LT. 10+84.3 LT. 11+30.0 LT. 12+84 LT.	11+61.6 LT. 10+85.2 LT. 10+95.6 LT. 12+15.0 LT.			UTILITY CHANNEL CUL., DIT. & DR. SLOPE INSTALL DRIVE	(P) (P) (P) (P) (T) (T)	0.07 A 55 SF 546 SF					GUY ANCHOR 12' GRAVEL
5	BLODGETT, GARY A. & RUTH A.	7	10+30.1 RT.	11+56.0 RT.			CONST.	(T)	0.05 A			HUNTINGTON		2,203 SF±; INCL. EROSION CONTROL & PDF
			10+88.2 RT. 11+15.1 RT. 11+15.8 RT. 11+70.7 RT. 12+44.6 RT. 12+68 RT. 12+70.1 RT. 12+83.9 RT.	11+18.4 RT. 12+60.5 RT. 11+36.0 RT. 12+34.1 RT.			CHANNEL INSTALL SLOPE SLOPE DRIVE INSTALL SLOPE	(P) (T) (P) (T) (T) (T) (T)	309 SF 0.03 A 58 SF 221 SF					PDF, 1296 SF±; INCL. EROSION CONTROL INCLUDES EROSION CONTROL INCLUDES EROSION CONTROL MONITOR WELL 10' GRAVEL PDF, INCLUDES EROSION CONTROL
6	WISNIOWSKI, MARK & JENNIFER A.	7	12+87.6 RT. 12+87.6 RT. 12+89.6 RT.	13+09.8 RT. 14+01.6 RT. 12+93.6 RT.			SLOPE INSTALL INSTALL	(T) (T) (T)	34 SF 0.02 A					PDF, 1120 SF±; INCL. EROSION CONTROL GUY ANCHOR
7	GREEN MOUNTAIN POWER CORPORATION													UTILITY
8	CHAMPLAIN VALLEY TELECOM													UTILITY
9	ADELPHIA CABLE COMMUNICATIONS													UTILITY

TABLE OF REVISIONS

REVISION NO.	SHEET NO.	DESCRIPTION	DATE
1	6,7	PARCEL NO. 3 LACAILLADE, CHANGE ENDING STA. OF ACCESS (T) FROM 9+99.9 TO 9+70.0 ; 1,050 SF±. CHANGE BEGINNING STA. OF CONST. (T) FROM 9+83.0 TO 9+18.5 ; 2,650 SF±. PER C.O. 9444. MADE BY: MR APPROVED BY: RD	10/06/06

PLAN LEGEND

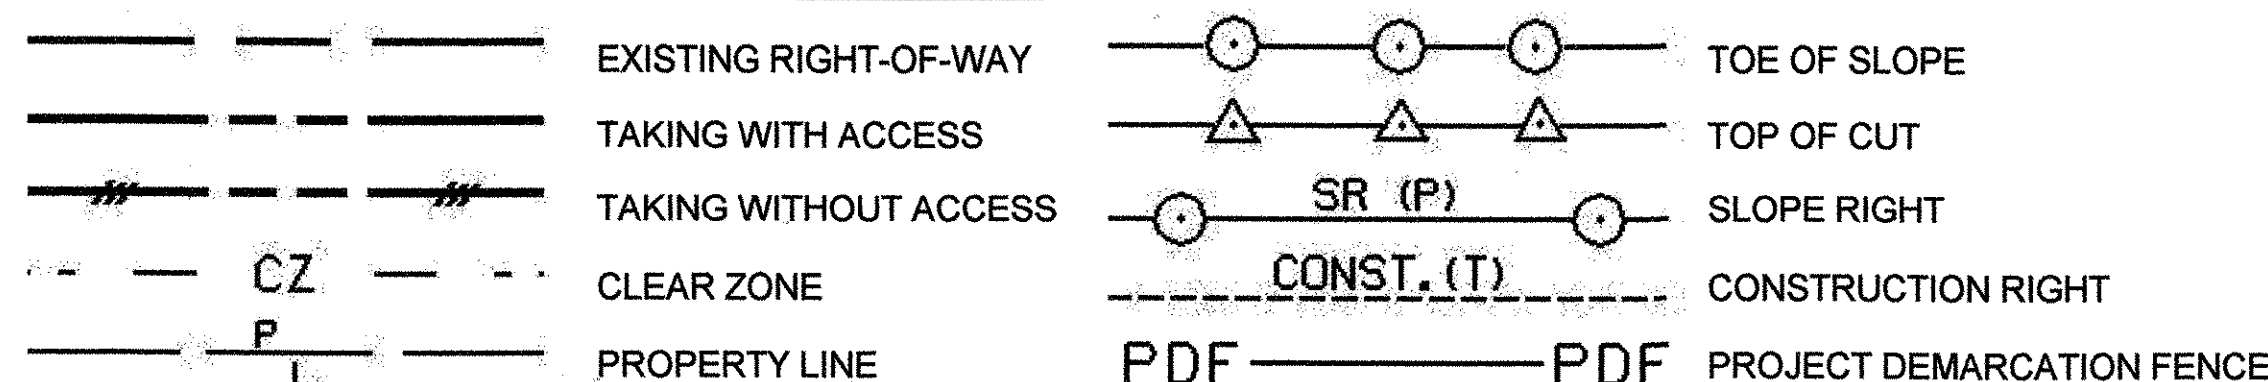

- EC - EROSION CONTROL
- (P) - PERMANENT
- (T) - TEMPORARY
- DR. - DRAINAGE RIGHT
- DIT. - DITCHING RIGHT
- CH. - CHANNEL RIGHT
- DRIVE - DRIVE RIGHT
- CUL. - CULVERT RIGHT
- C&T - CLEARING & TRIMMING RIGHT
- SR - SLOPE RIGHT
- UE - UTILITY EASEMENT

APPROVED: ROGER P. DUMAS DATE: 07-18-05  
CHIEF, PLANS & TITLES

PLOT DATE 10/06/05

PROJECT NAME:	<b>HUNTINGTON</b>	PLOT DATE:	4/25/05
PROJECT NUMBER:	<b>BRO 1445 (29)</b>	DRAWN BY:	MR
FILE NAME:	r01j302.xls	CHECKED BY:	GF
PROJECT LEADER:	M. CHENETTE	R.O.W. SHEET	6 OF 7
DESIGNED BY:	D. ALTERI		