


SURVEYED BY: VERMONT SURVEY AND ENGINEERING, INC.
 SURVEYED DATE: 7/2001

DATUM
 VERTICAL: NAVD88 (US FEET)
 HORIZONTAL: NAD83 (1996) SPC VT (US FEET)

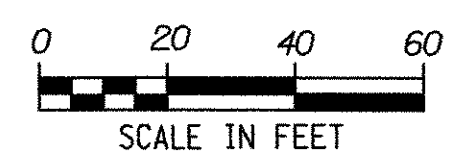

PROJECT NAME: HUNTINGTON
 PROJECT NUMBER: BRO 1445 (29)

FILE NAME: ...Cadd\Trans\z01j302exist.dgn PLOT DATE: 1/12/2006
 PROJECT LEADER: M. CHENETTE DRAWN BY: D. HARRINGTON
 DESIGNED BY: D-H CHECKED BY: M. CHENETTE
EXISTING CONDITIONS SITE PLAN SHEET 13 OF 63