


NOTES:
 1. PLEASE REFER TO THE PROFILE (SHEET 12), ROADWAY AND CHANNEL CROSS SECTIONS (SHEETS 56-63) FOR FINAL GRADING.

SURVEYED BY: VERMONT SURVEY AND ENGINEERING, INC.
 SURVEYED DATE: 7/2001

DATUM
 VERTICAL: NAVD88 (US FEET)
 HORIZONTAL: NAD83 (1996) SPC VT (US FEET)

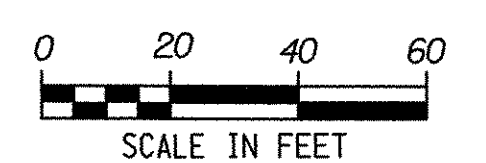

PROJECT NAME: HUNTINGTON
 PROJECT NUMBER: BRO 1445 (29)

FILE NAME: ...\\Cadd\Trans\z01J302finalpln.dgn PLOT DATE: 1/30/2006
 PROJECT LEADER: M. CHENETTE DRAWN BY: S. BURBANK
 DESIGNED BY: D-H CHECKED BY: M. CHENETTE

FINAL CONDITIONS SITE PLAN SHEET 20 OF 63