



APPROACH SLAB NO. 1

SCALE 1/4" = 1'-0"
 1 0 2 4 6

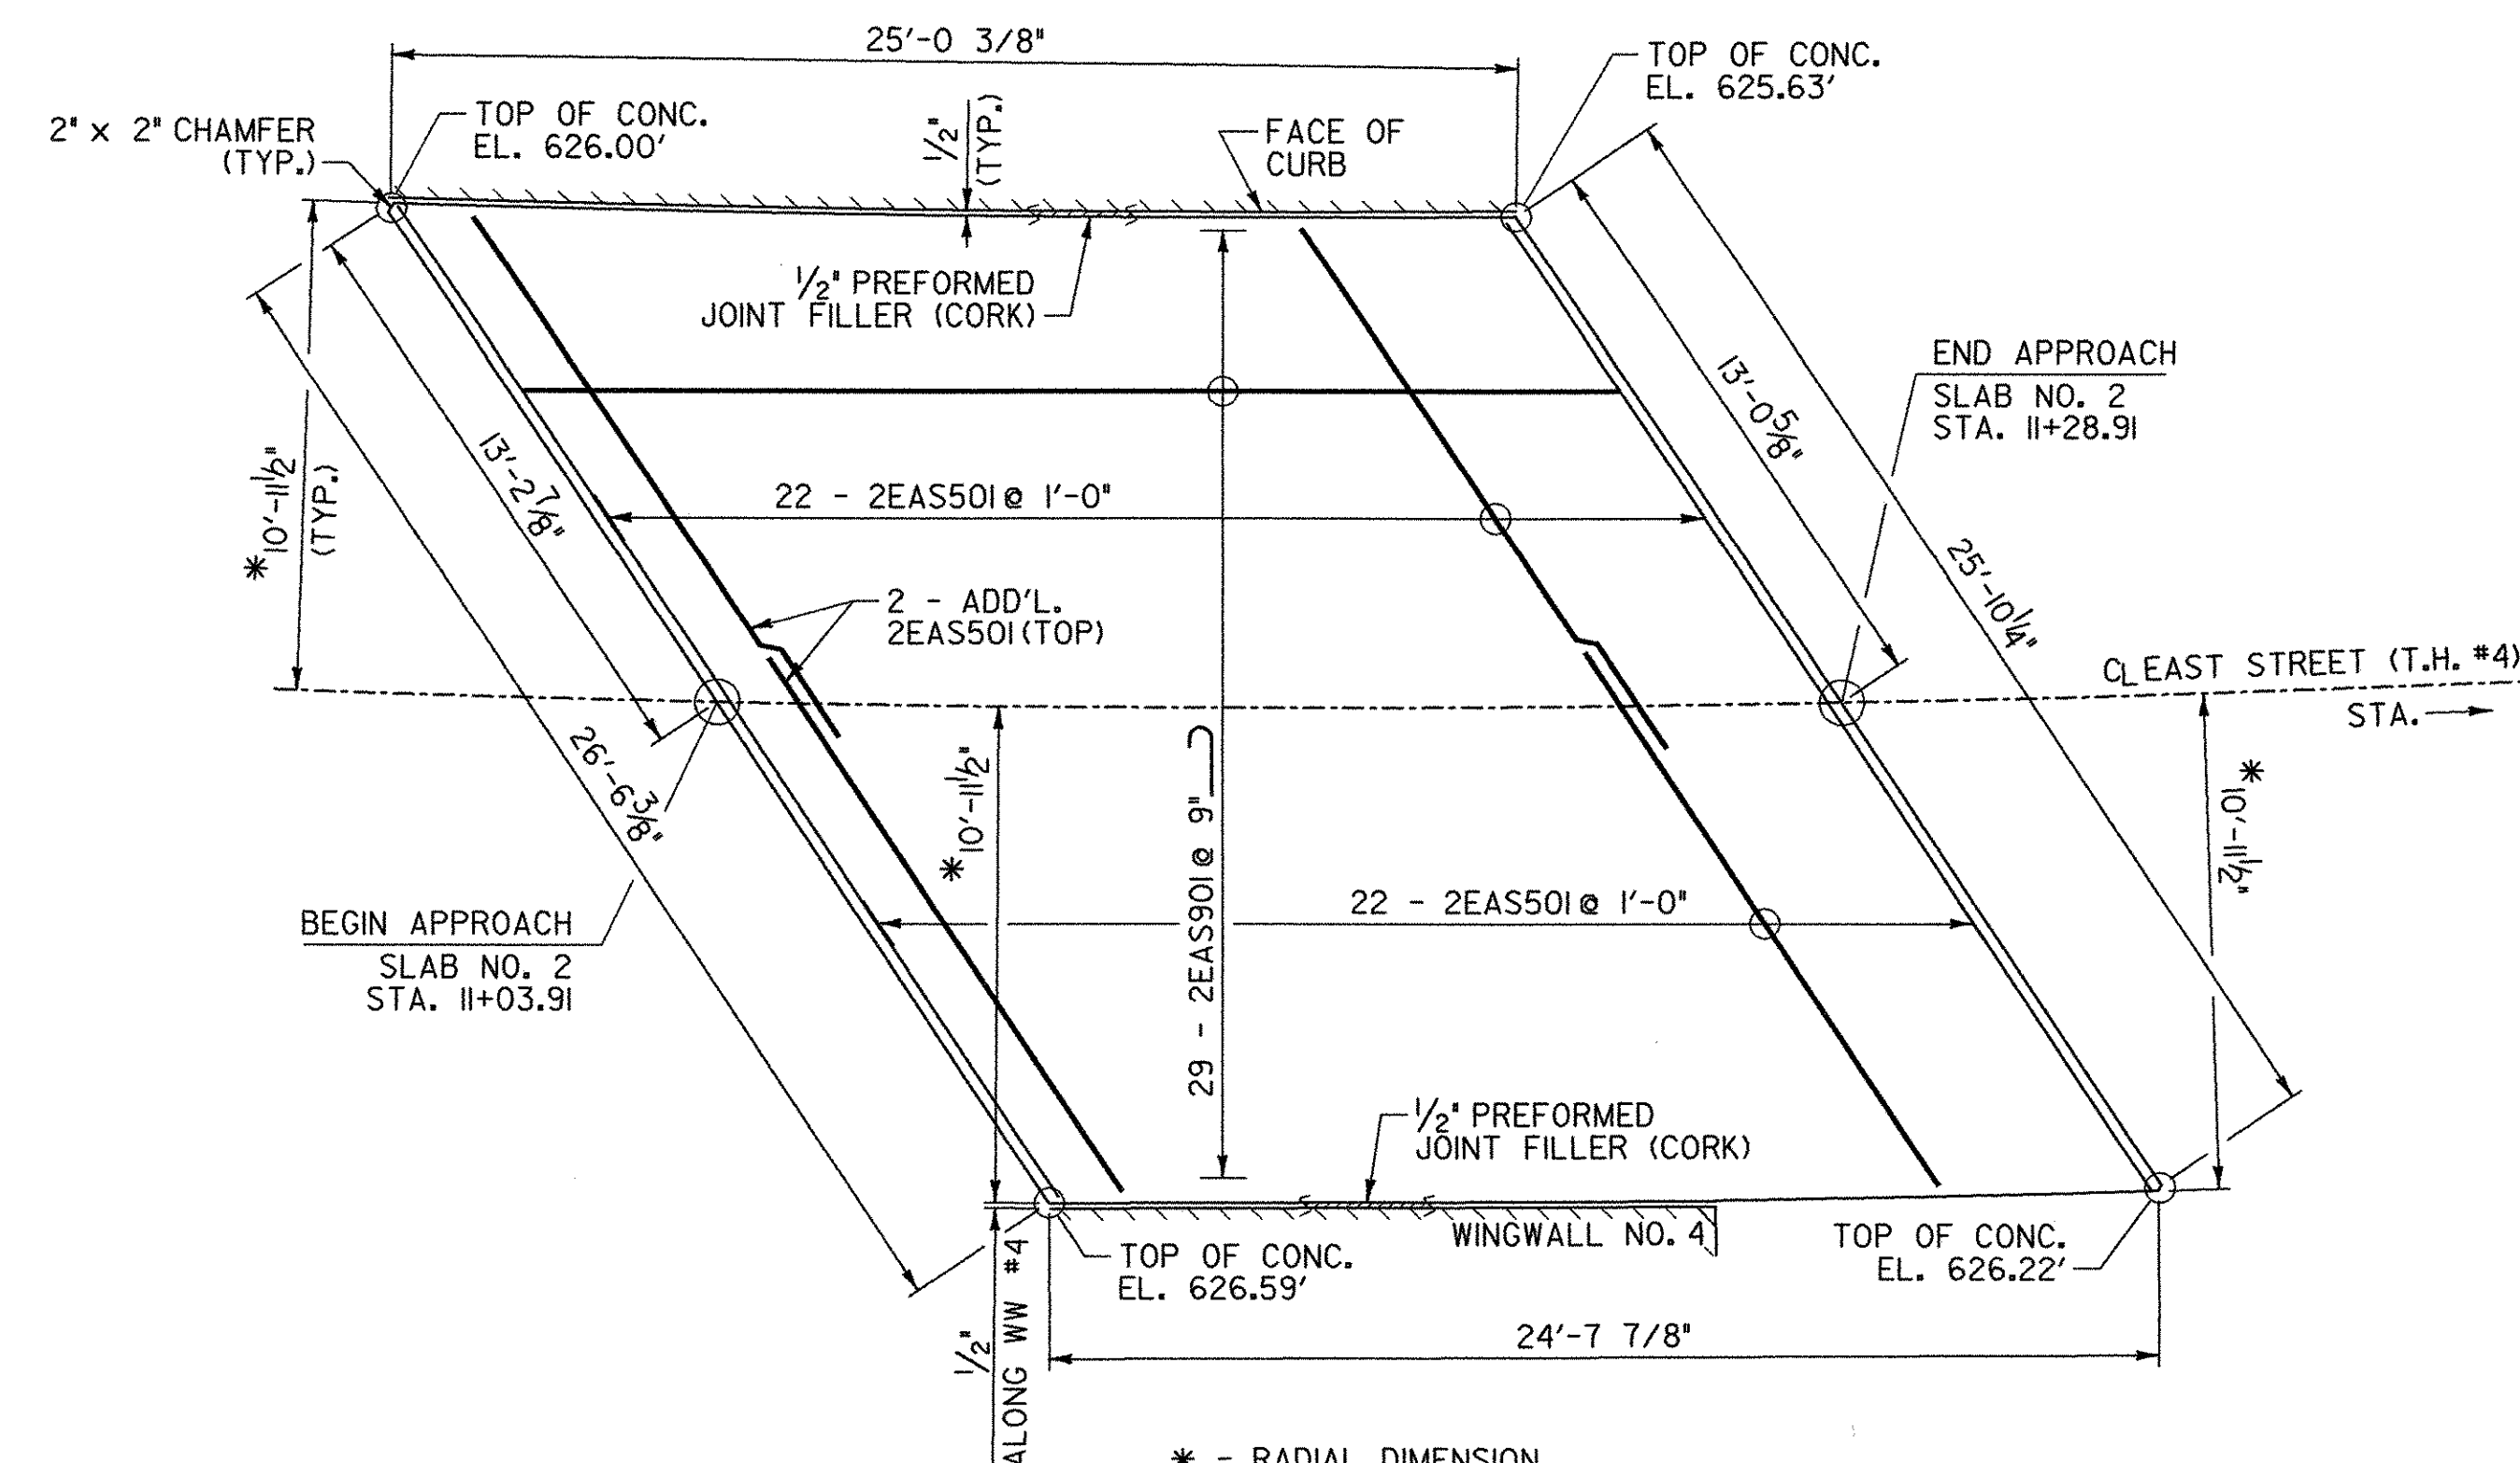


APPROACH SLAB NO. 2

SCALE 1/4" = 1'-0"
 1 0 2 4 6

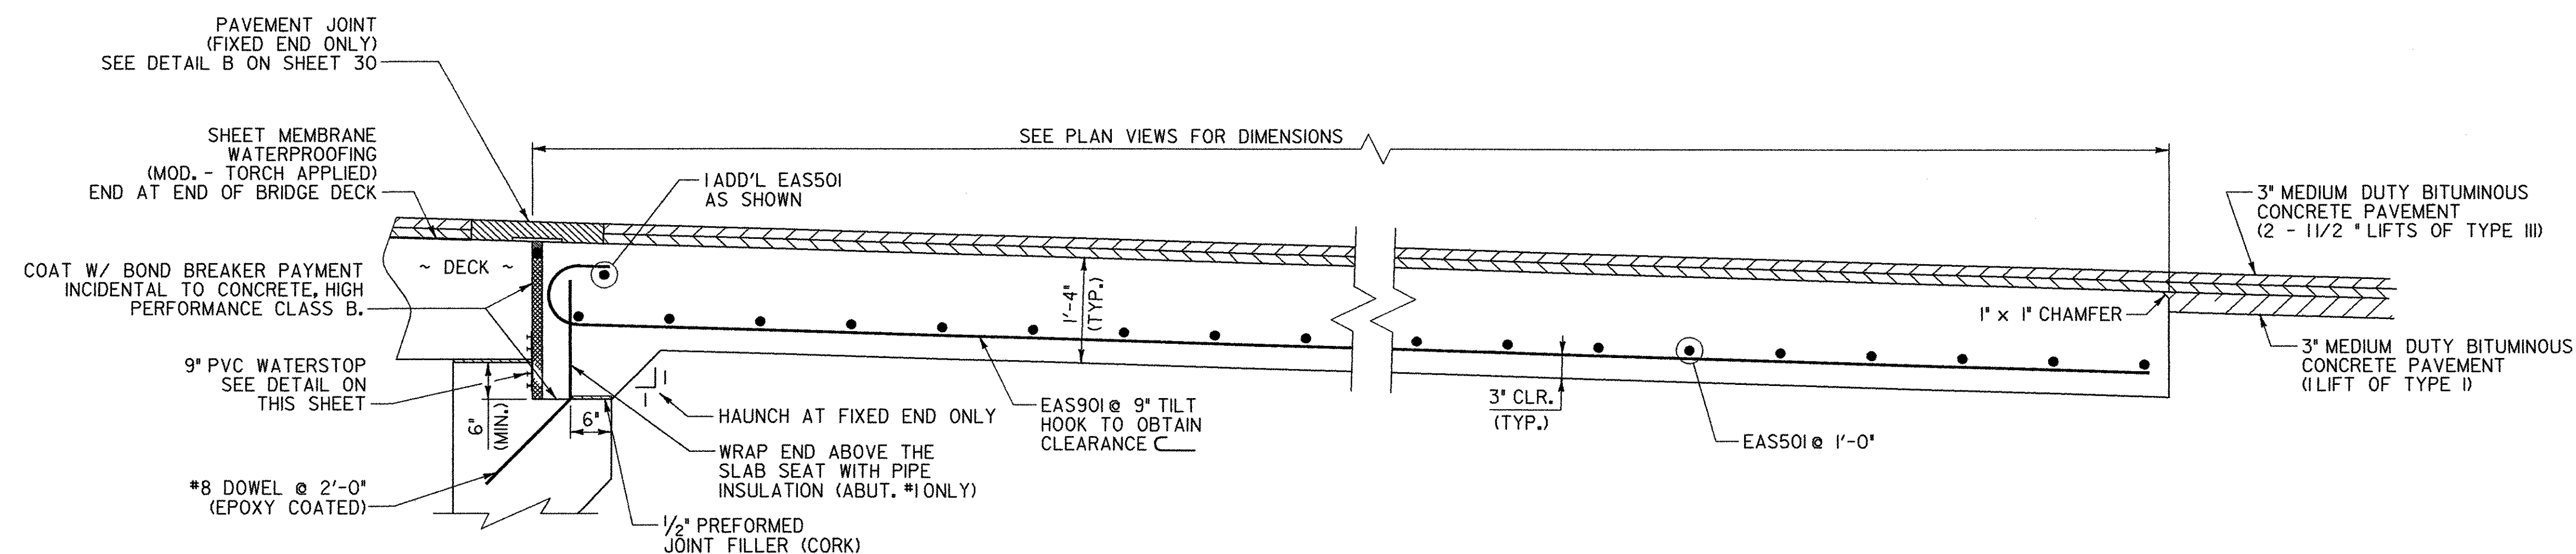

APPROACH SLAB SECTION

SCALE 3/4" = 1'-0"
 0 1 2

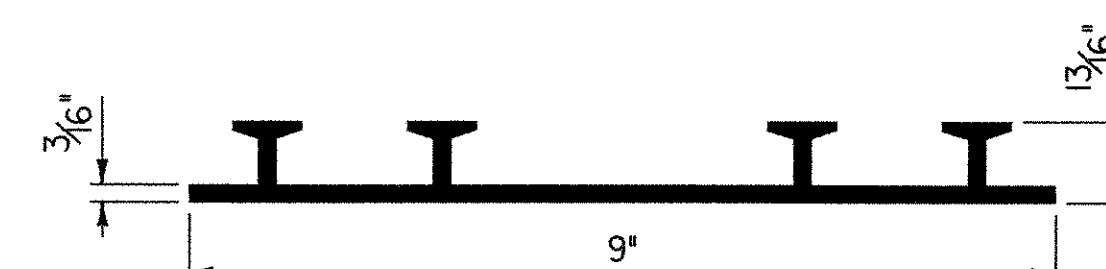

THE COSTS FOR P.V.C. WATERSTOP SHALL BE INCLUDED IN THE UNIT PRICE BID FOR CONCRETE, HIGH PERFORMANCE CLASS B. OTHER CONFIGURATIONS MAY BE USED UPON APPROVAL OF THE STRUCTURES ENGINEER.

P. V. C. WATERSTOP FOR CONSTRUCTION JOINTS

NOT TO SCALE

**STATE OF VERMONT
 AGENCY OF TRANSPORTATION**

Town Of	HUNTINGTON	Bridge No.	42
Highway No.	T.H. 4	Log Sta.	
		Surv. Sta.	

EAST STREET (T.H. #4) OVER HUNTINGTON RIVER

APPROACH SLAB DETAILS

Designed By	S. BURBANK	Drawn By	S. BURBANK
Checked By	Date	Bridge Design Supervisor	Date
M. CHENETTE	08/05	M. CHENETTE	09/05

PROJECT	HUNTINGTON	PROJECT NO.	BRO 1445 (29)
---------	------------	-------------	---------------

