


ABUTMENT 2 - FOOTING PLAN & PILE LAYOUT

SCALE 3/8" = 1'-0"
 0 1 2 3 4


↓ DENOTES 12x74 PILE W/ 3/4" BATTER
 | DENOTES 12x74 PILE W/ NO BATTER

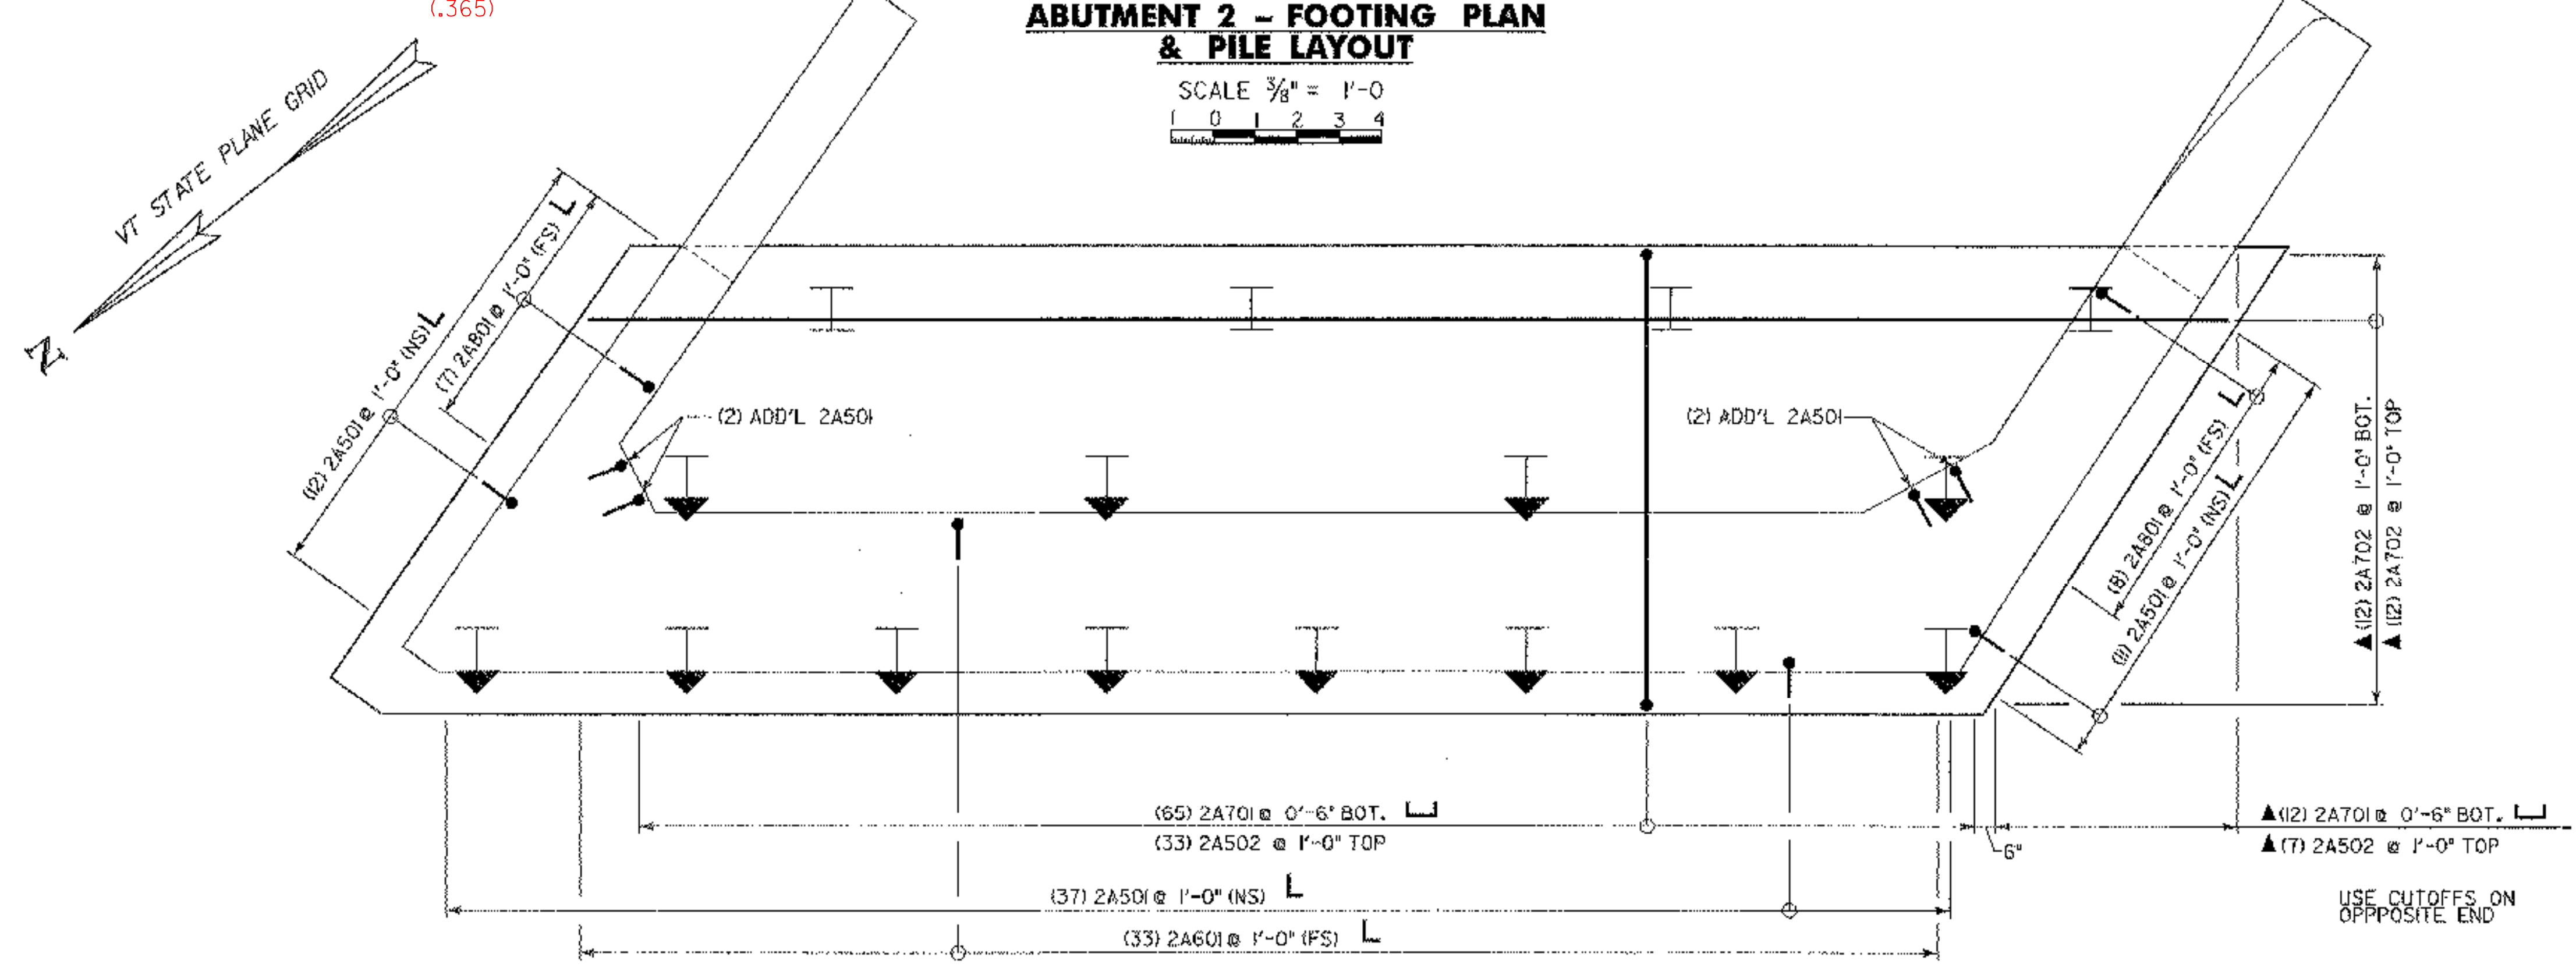

ABUTMENT 2 - FOOTING REINFORCEMENT PLAN

SCALE 3/8" = 1'-0"
 0 1 2 3 4

▲ DENOTES BAR TO BE CUT IN FIELD

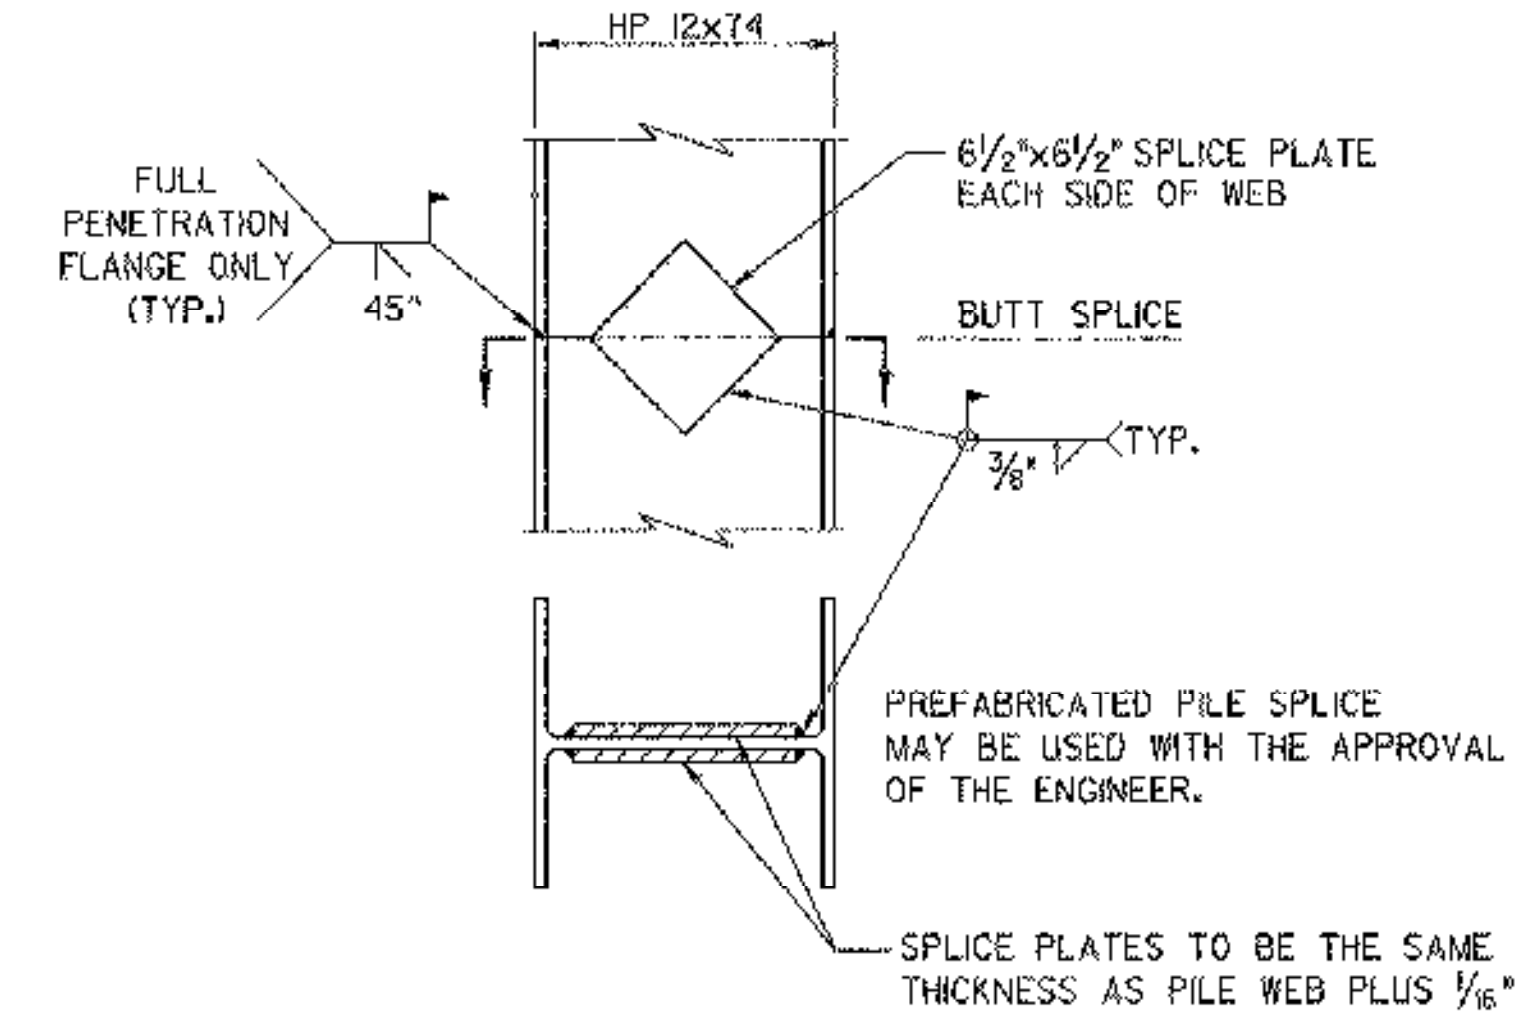

DETAIL OF TYPICAL PILE SPlice
 NOT TO SCALE

	INFO	DRIVEN	
P.34	TEST PILE	10/5	RETEST-PAY
			CUTOFF @612.5
P.35		10/5	INCOMPLETE
P.32	48'	10/5	
P.27	46'	10/5	
P.26	46'	10/5	
P.25	50'	10/6	
P.24	46'	10/6	
P.23	46.5'	10/6	
P.22	47'	10/6	
P.33	48'	10/5	
P.21	50'	10/9	
P.20	46'	10/9	
P.35	86'	10/10	
P.28	51'	10/9	
P.29	49'	10/10	
P.30	52'	10/10	
P.31	48'	10/10	
760 TOTAL			

ADD'L PILE LENGTH DUE TO OVER EXCAVATION BY THE CONTRACTOR. EXCAVATION USED TO DETERMINE PILE LENGTH, VS TRANSIT GRADE USED TO DETERMINE CUT OFF LOCATION.

NOTE:

NF = NEAR FACE
 FF = FAR FACE
 EF = EACH FACE
 ▲ = CUT TO FIT IN FIELD
 3" CLR. UNLESS OTHERWISE SPECIFIED ON THE PLANS.

STATE OF VERMONT AGENCY OF TRANSPORTATION

Town Of	HUNTINGTON	Bridge No.	42
Highway No.	T.H. 4	Log Sta.	
		Surv. Sta.	
EAST STREET (T.H. #4) OVER HUNTINGTON RIVER			
ABUTMENT NO. 2 FOOTING PLAN			
Designed By	T. KNIGHT	Drawn By	T. KNIGHT
Checked By	Date	Bridge Design Supervisor	
S. BURBANK	06/05	M. CHENETTE	Date 09/05
PROJECT	HUNTINGTON	PROJECT NO.	BRO 1445 (29)
DH Lgn: ...Code\Trans\20130201\ftg2.dgn Plot Date: 1/12/2006		Bridge Sheet No.	Sheet 46 of 63