




11+50

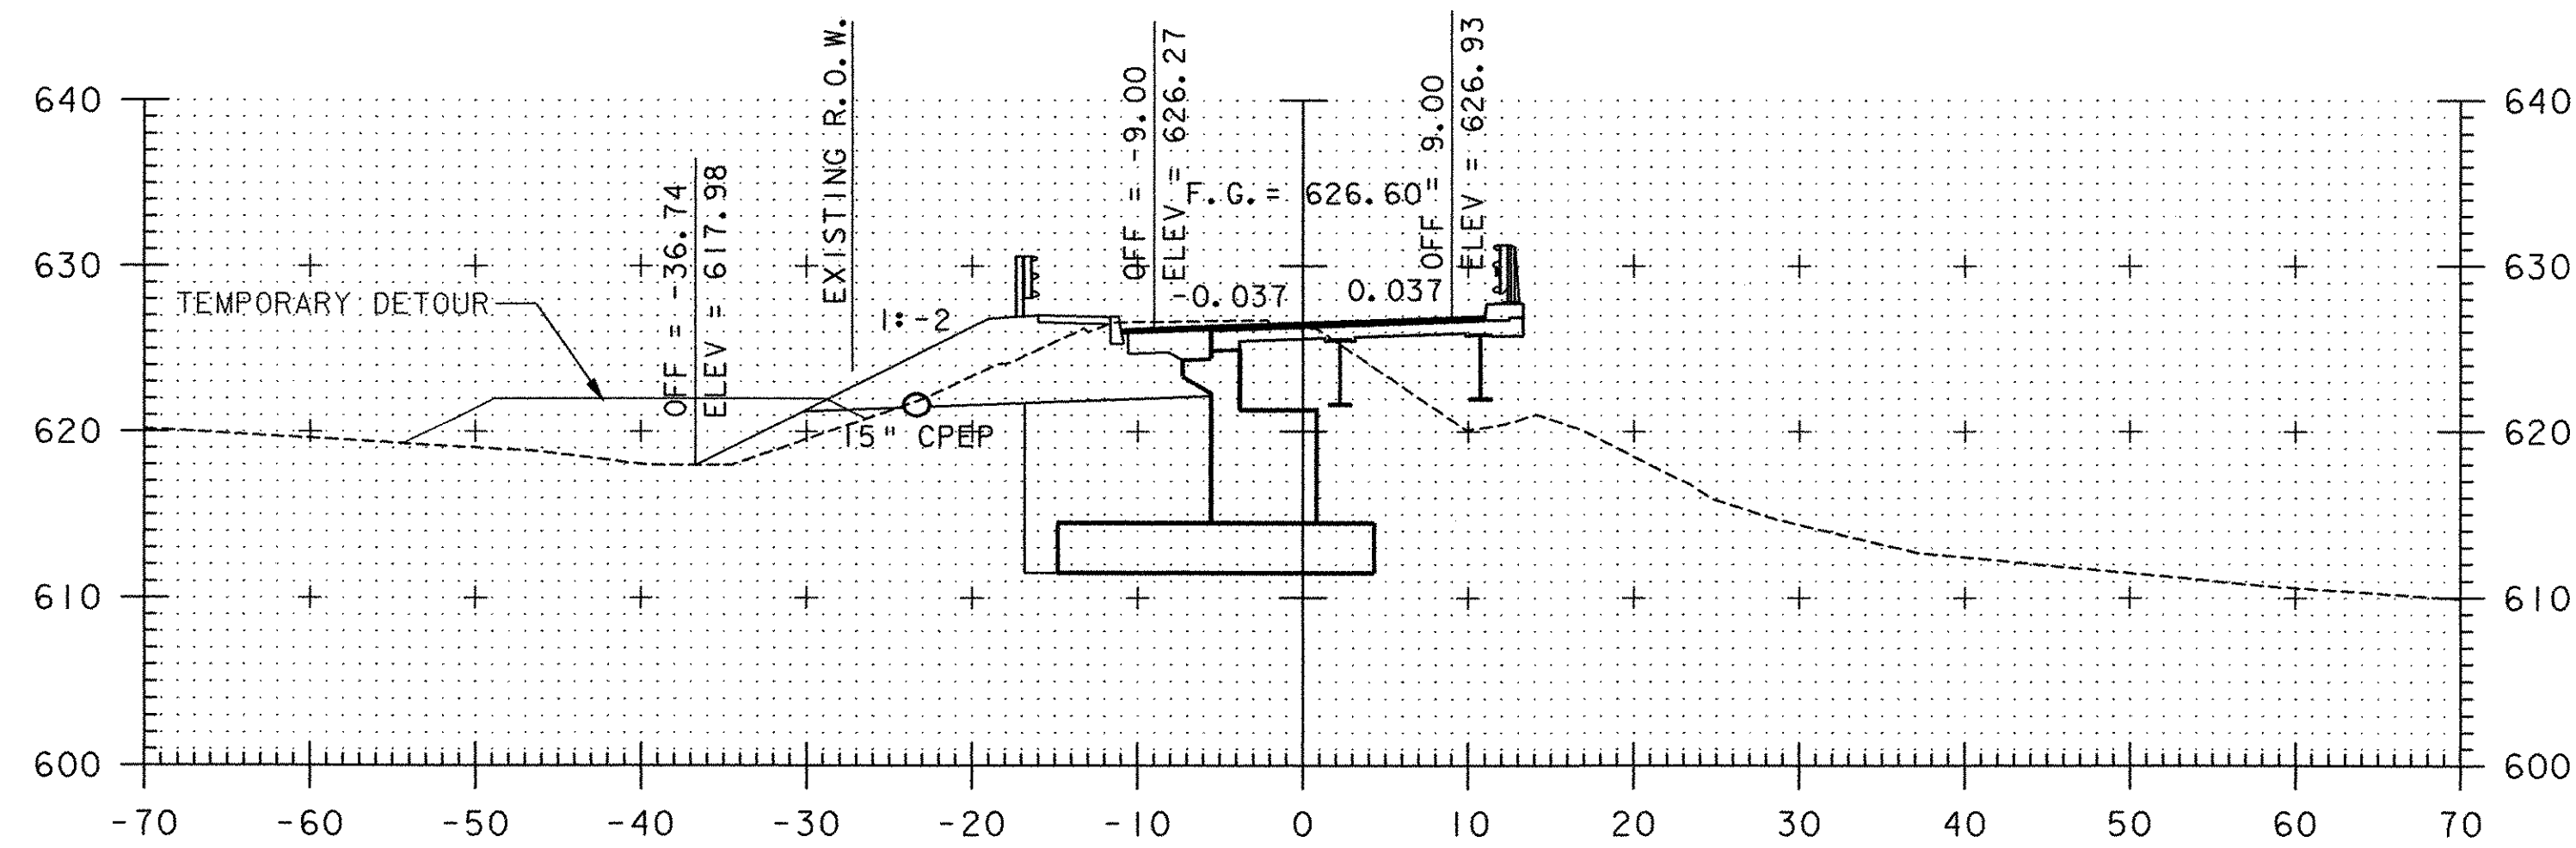


11+00

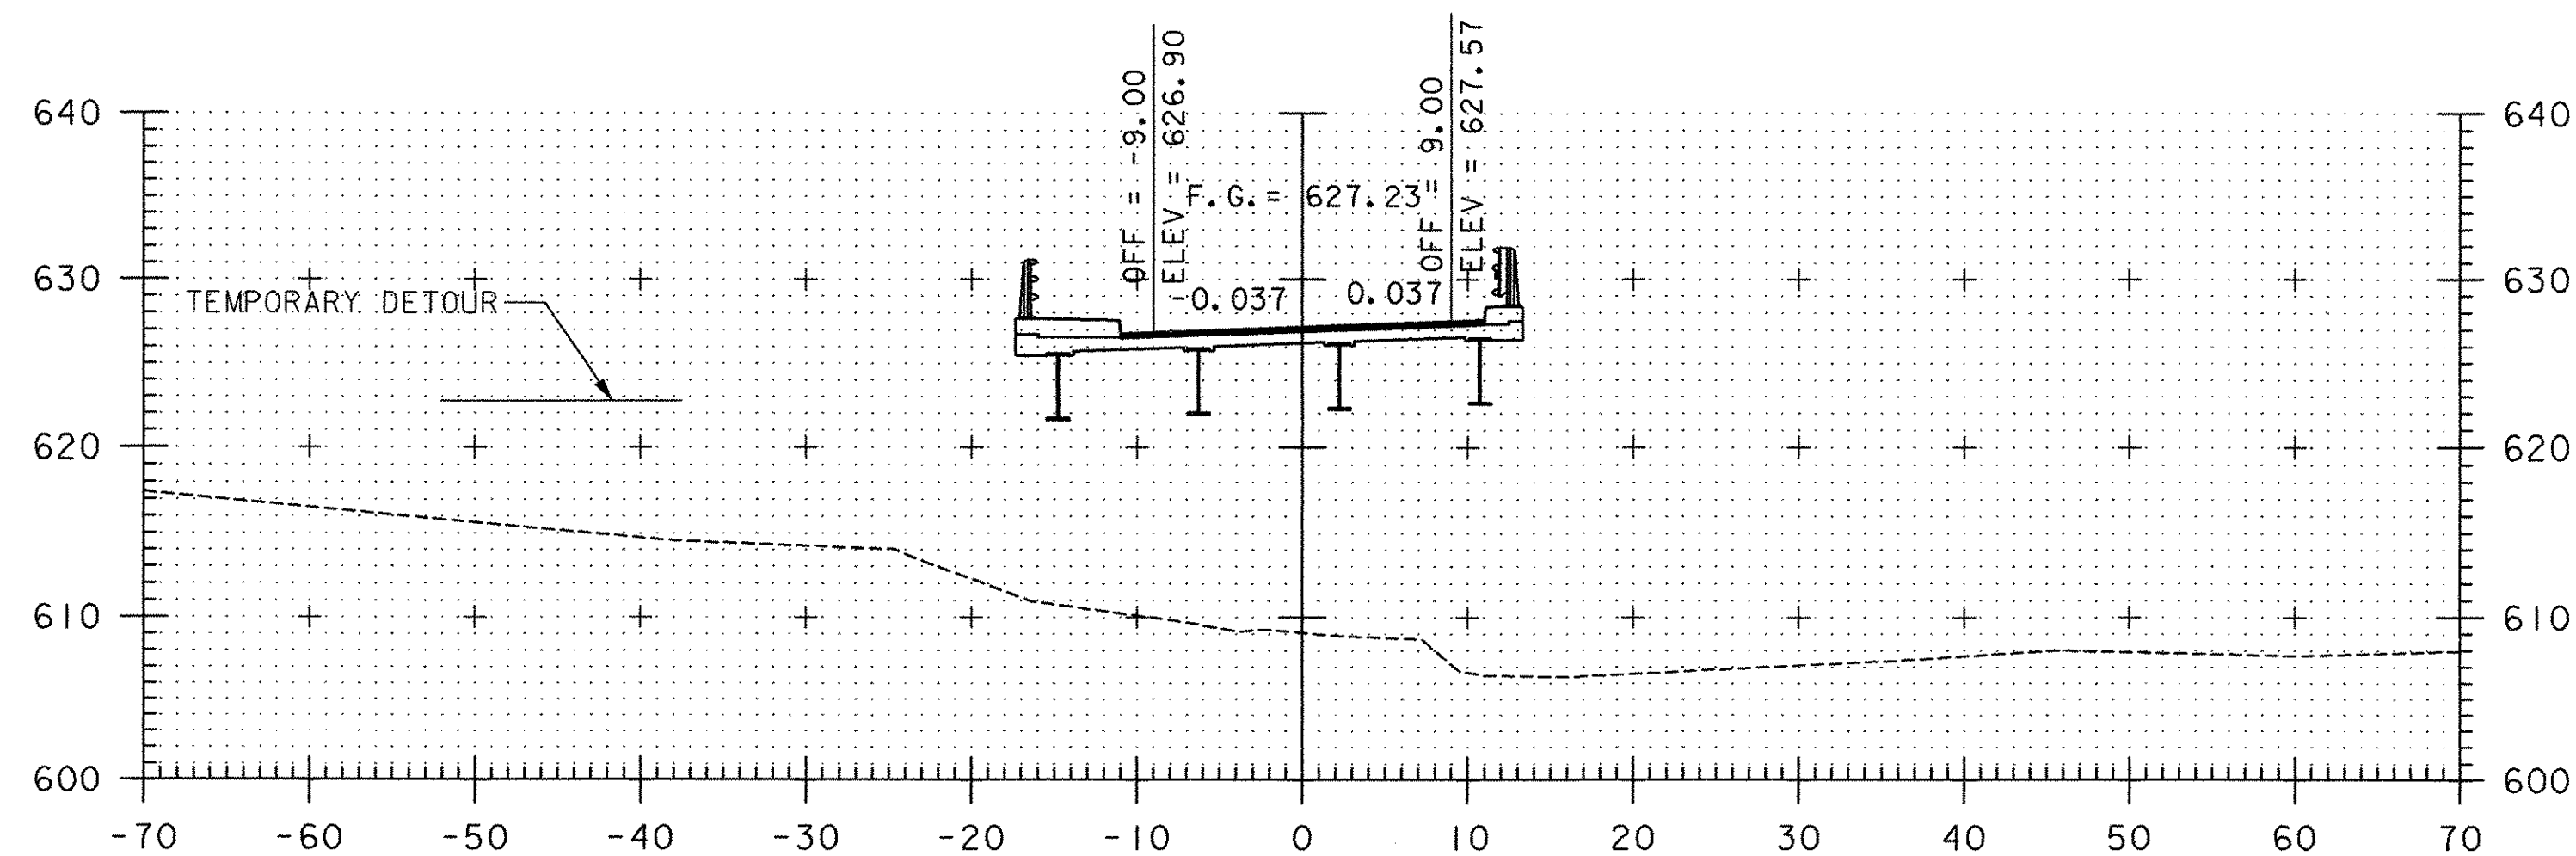


10+50

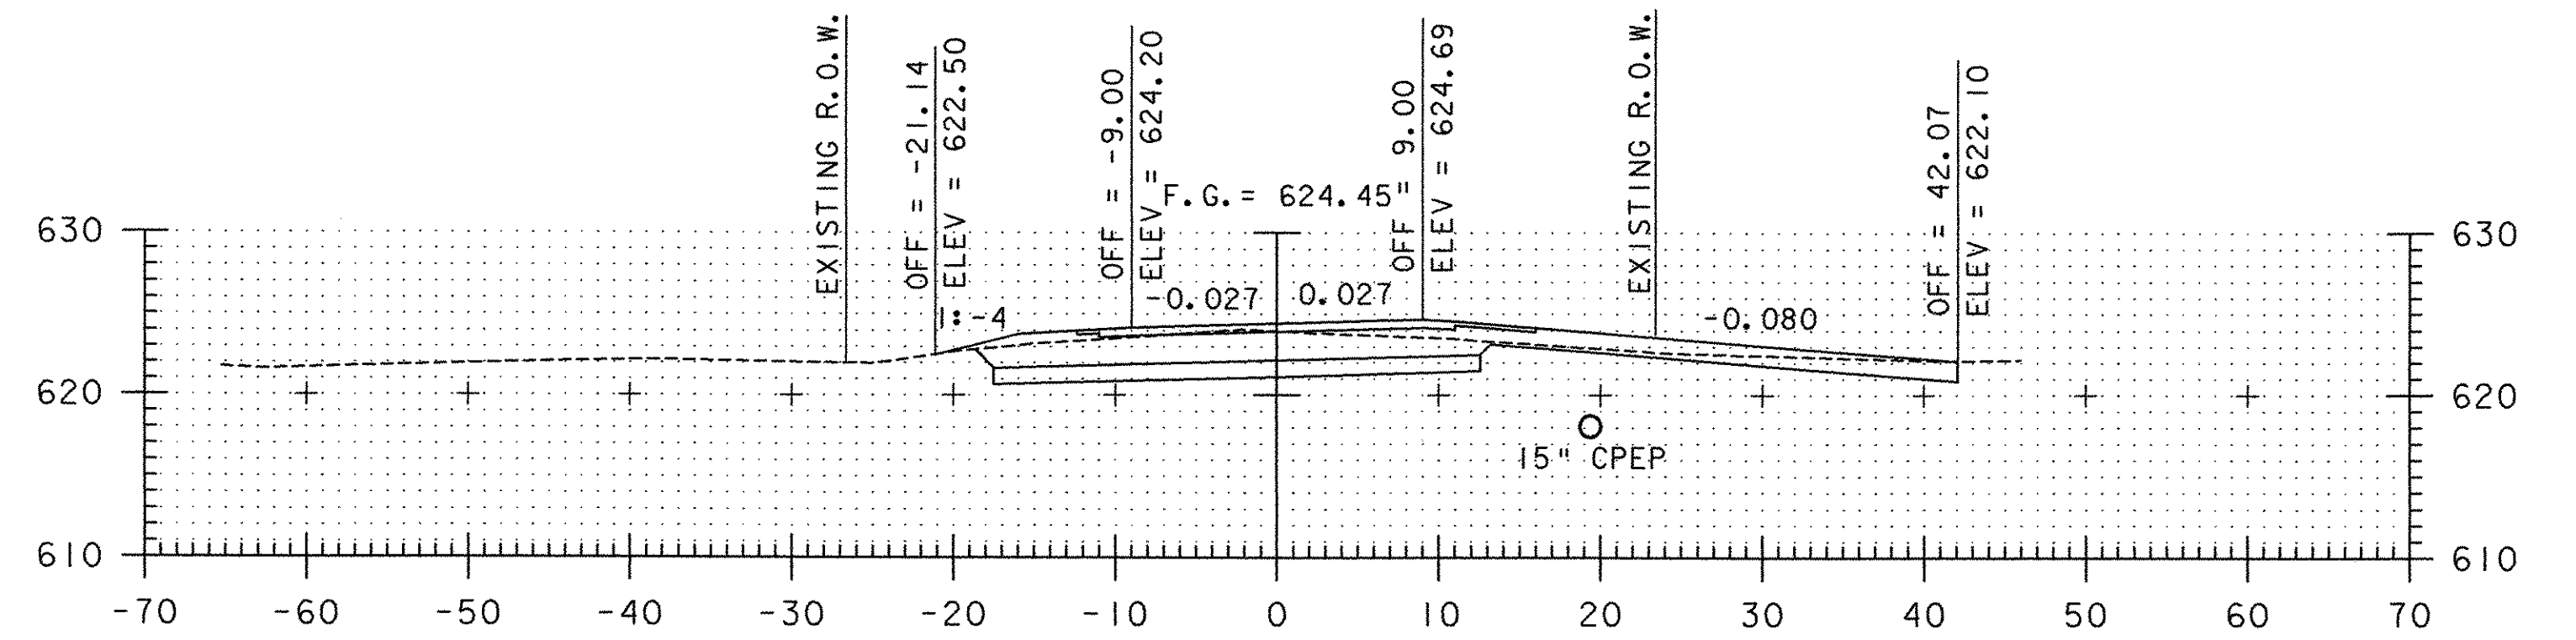


12+68

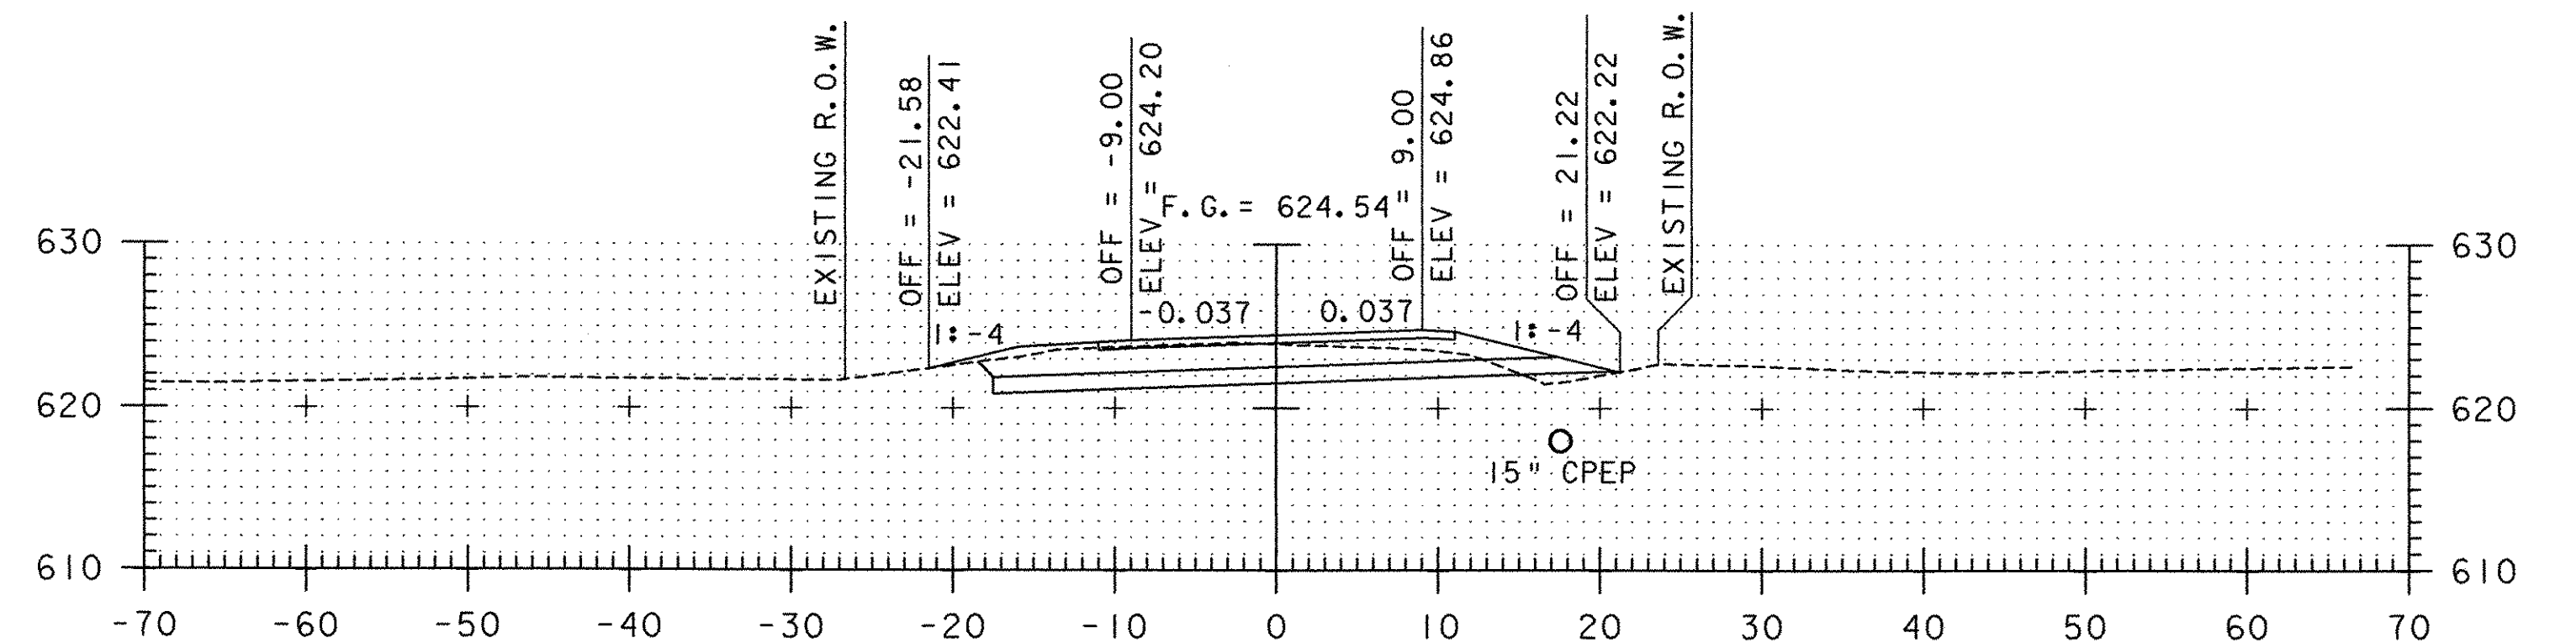

12+50

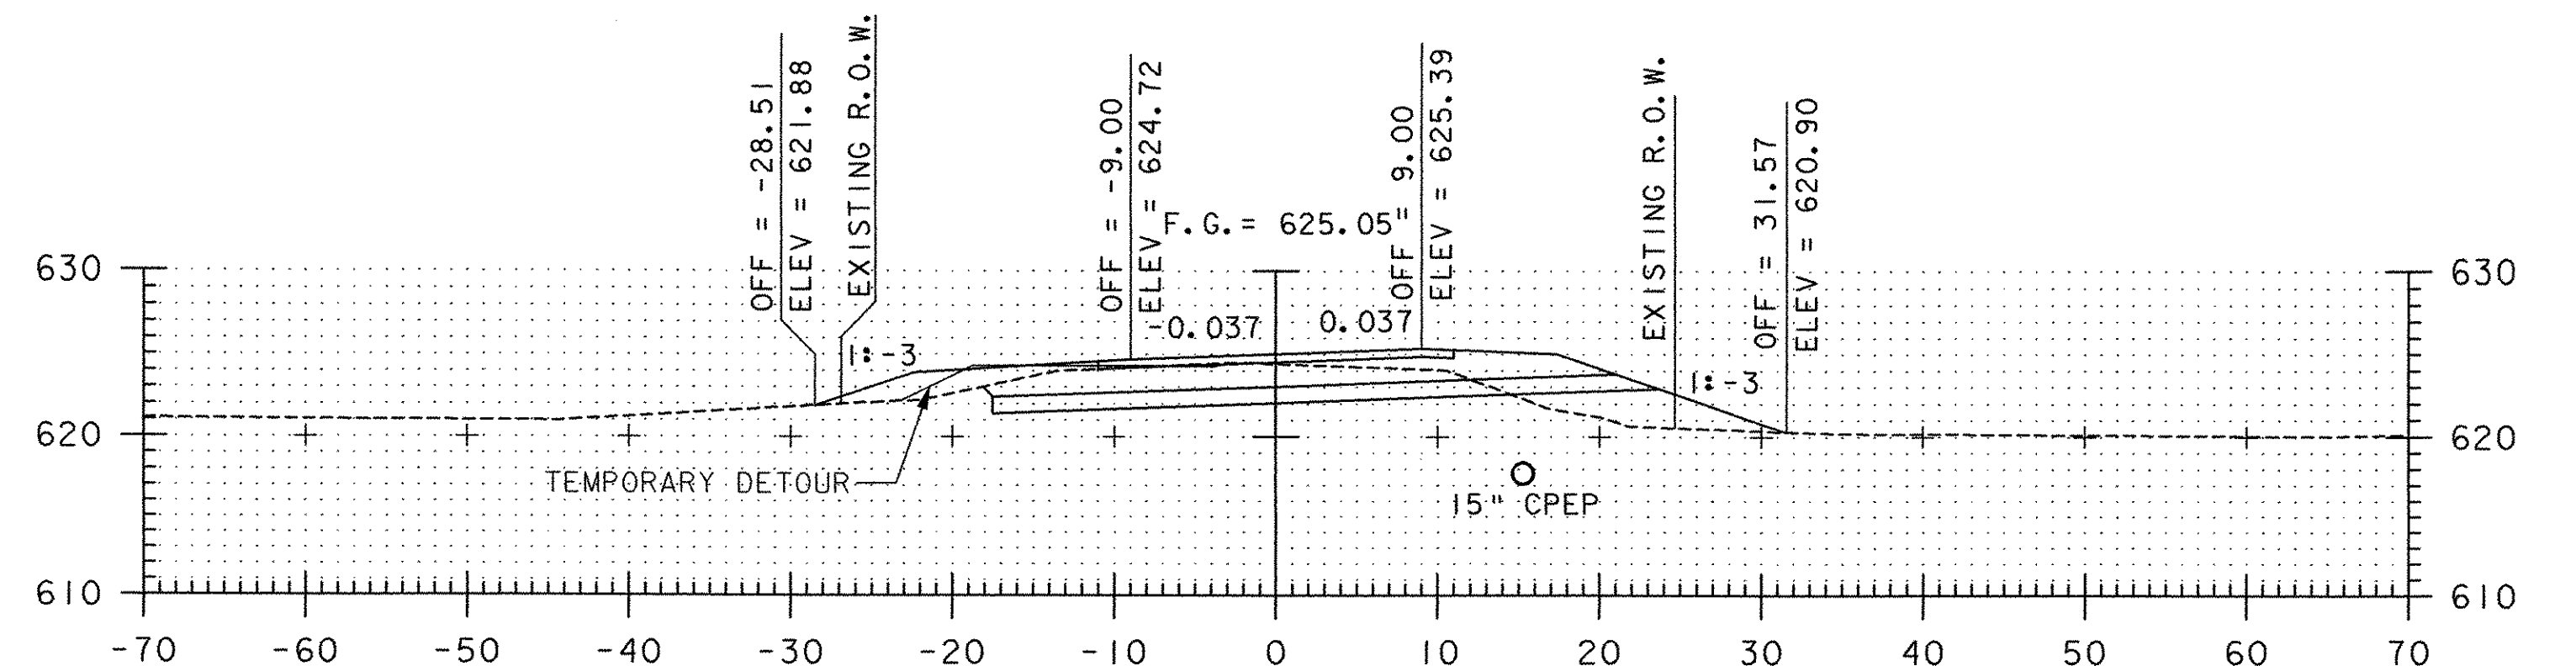

12+00

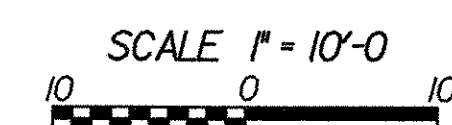

STA. 10+50 TO STA. 12+68



PROJECT NAME: HUNTINGTON
PROJECT NUMBER: BRO 1445 (29)

FILE NAME: ...Cadd\Trans\z0j302xsl.dgn
PROJECT LEADER: M. CHENETTE
DESIGNED BY: D. ALTERI

PLOT DATE: 1/12/2006
DRAWN BY: J. OAKMAN
CHECKED BY: D. ALTERI

ROADWAY CROSS SECTION

SHEET 58 OF 63