




13+25

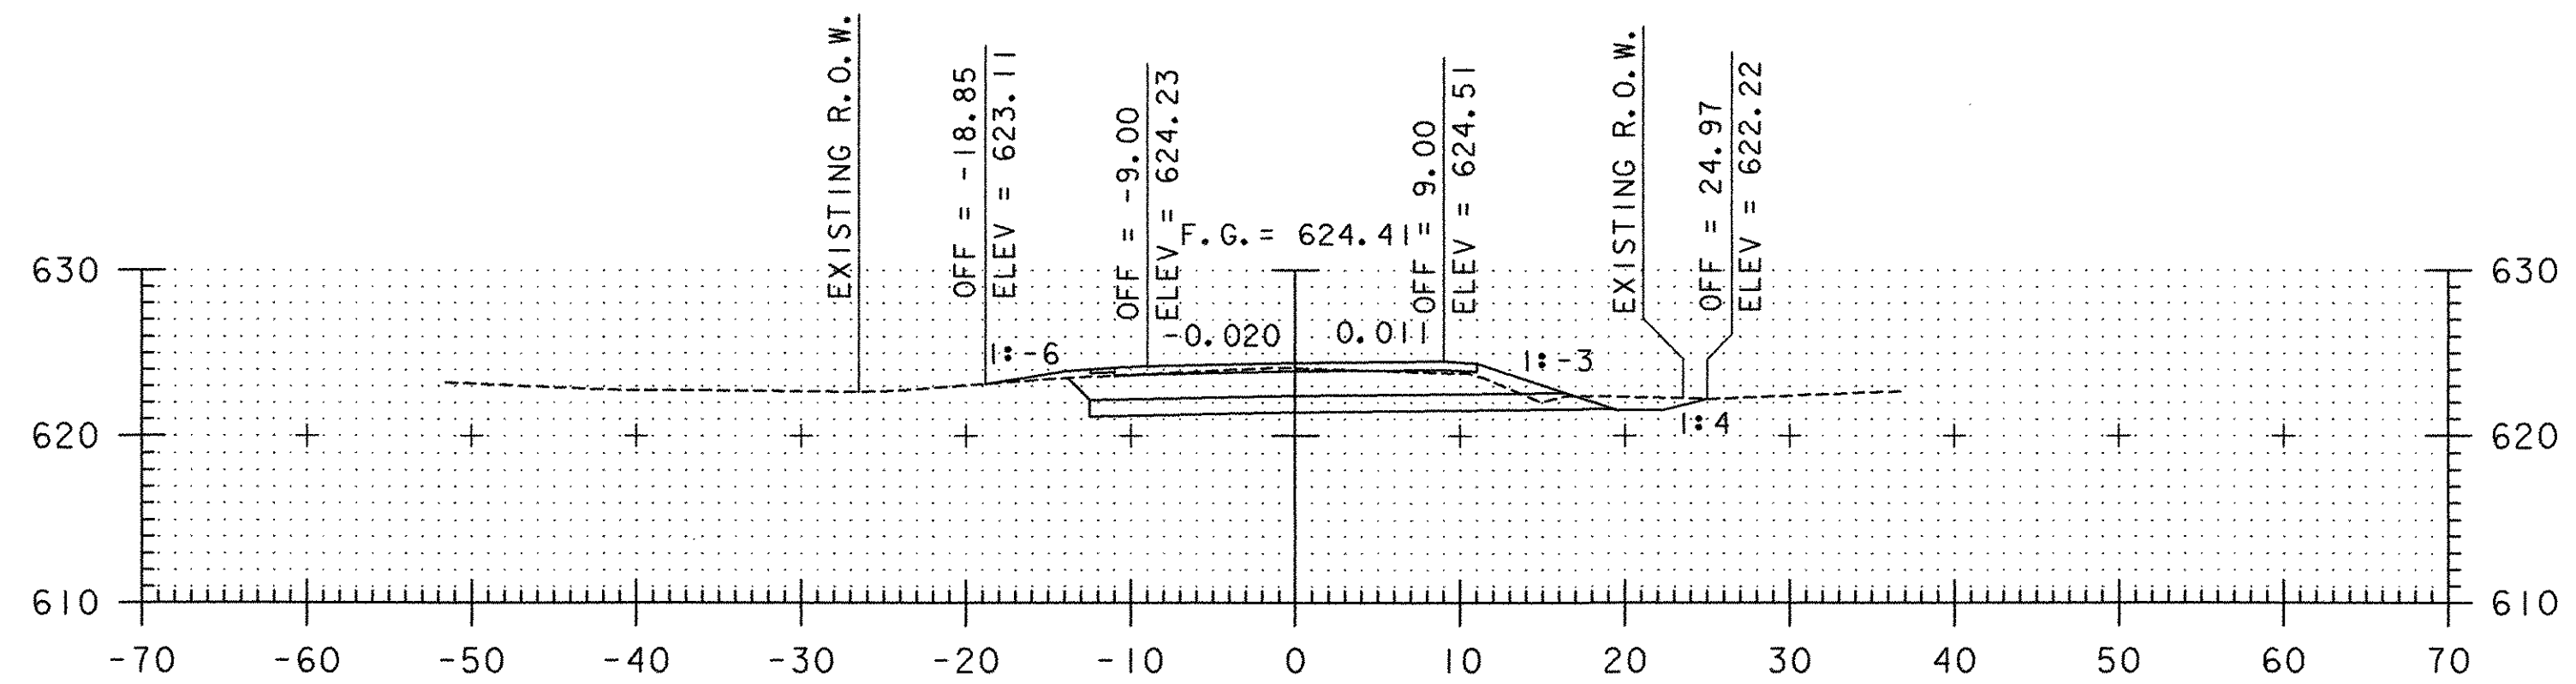


13+00

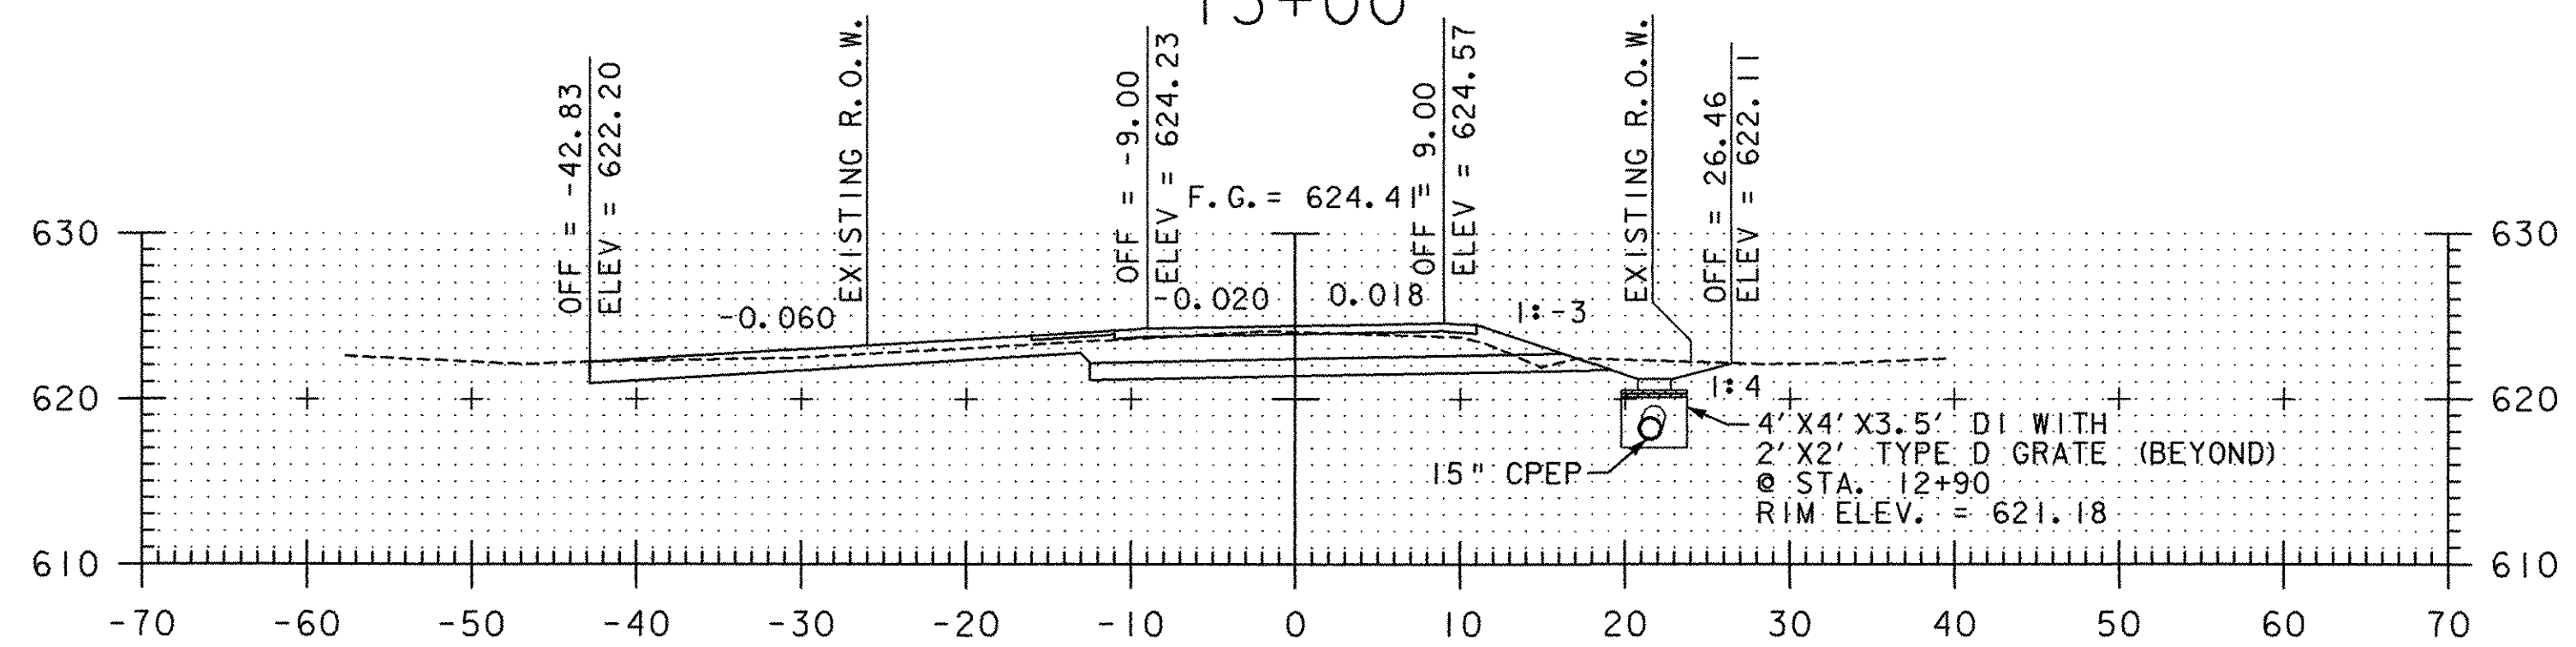


12+86

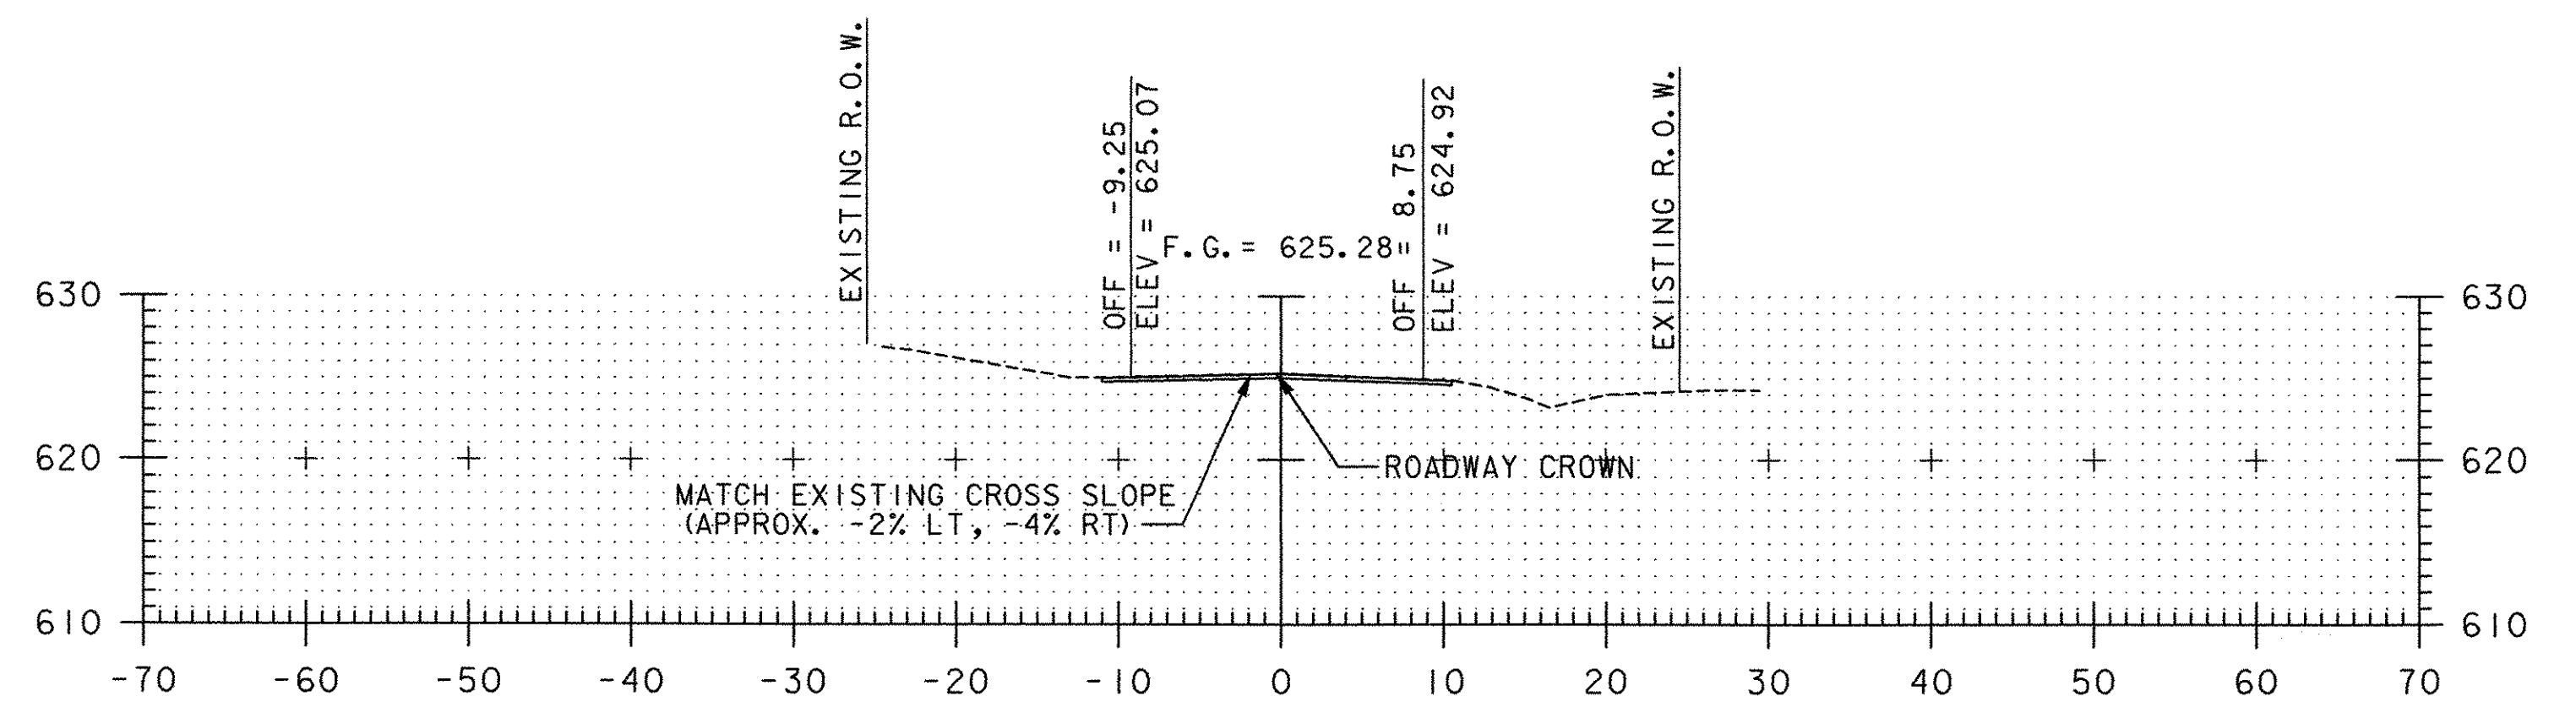

14+00

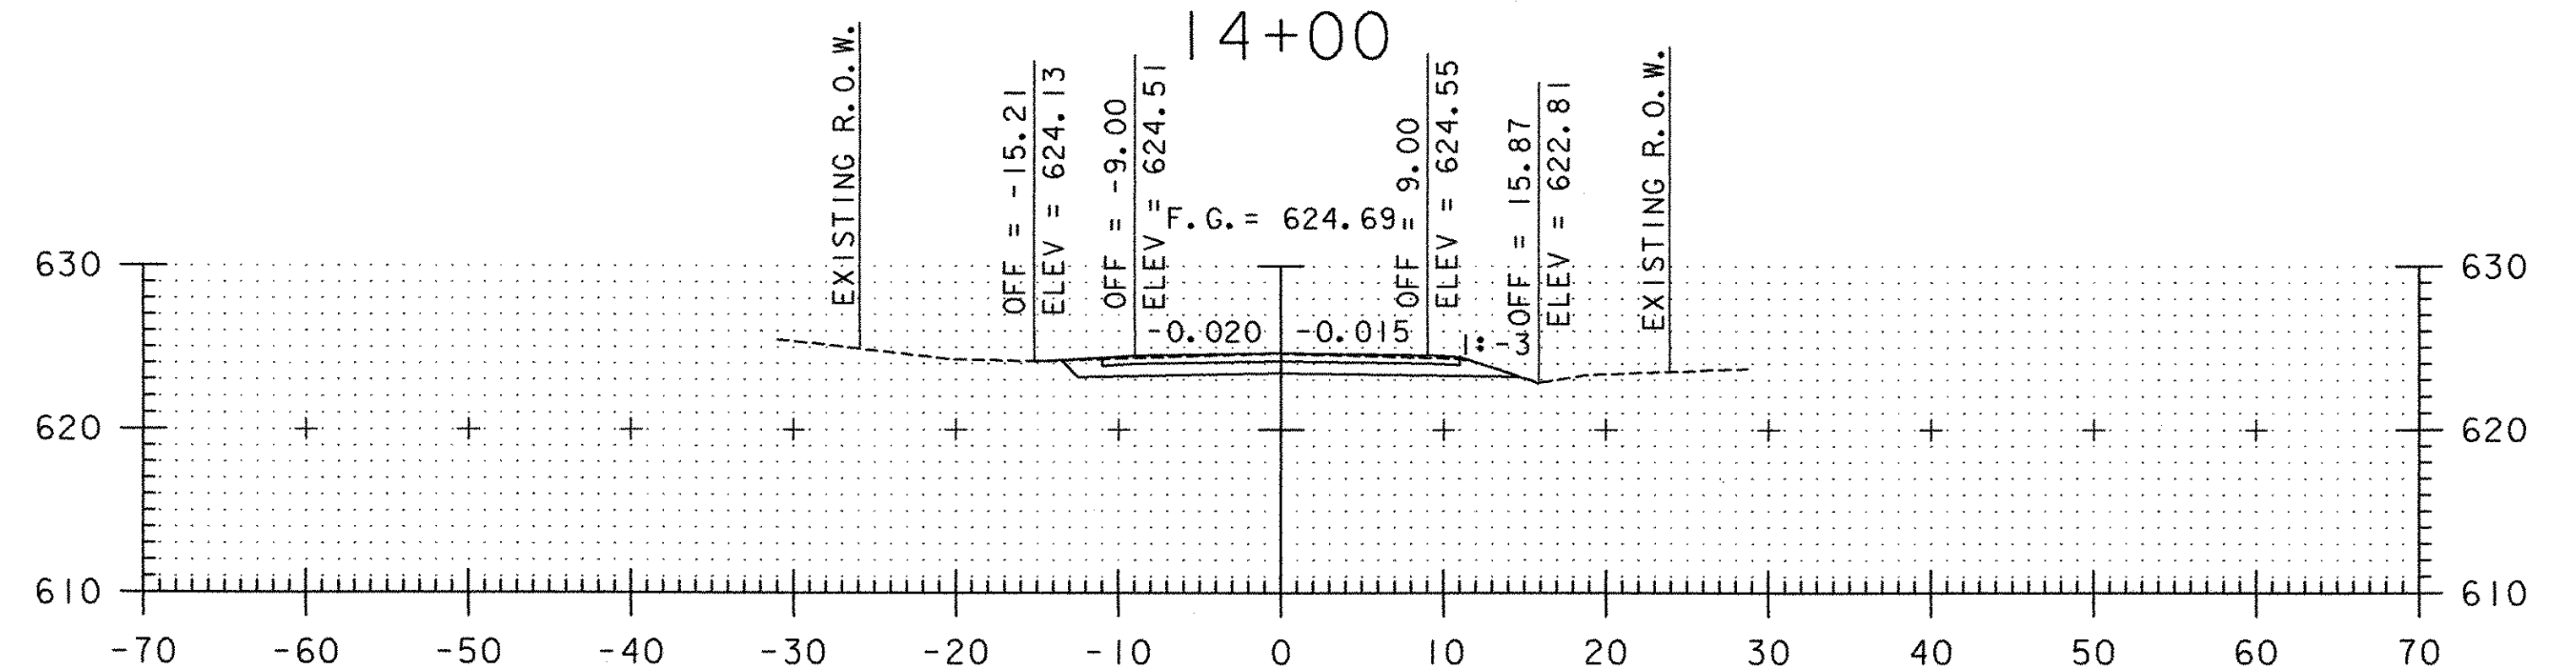

13+50

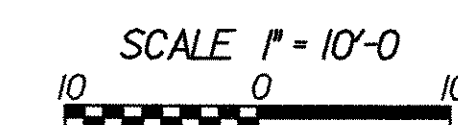

STA. 12+86 TO STA. 14+00



PROJECT NAME: HUNTINGTON
PROJECT NUMBER: BRO 1445 (29)

FILE NAME: ...Cadd\Trans\z01j302xsl.dgn
PROJECT LEADER: M. CHENETTE
DESIGNED BY: D. ALTERI
PLOT DATE: 1/12/2006
DRAWN BY: J. OAKMAN
CHECKED BY: D. ALTERI
SHEET 59 OF 63

ROADWAY CROSS SECTION