



50+50


STA. 50+30 (ABUTMENT NO. 2)
 BEGIN UNCLASSIFIED CHANNEL EXCAVATION
 GEOTEXTILE UNDER STONE FILL
 STONE FILL, TYPE IV

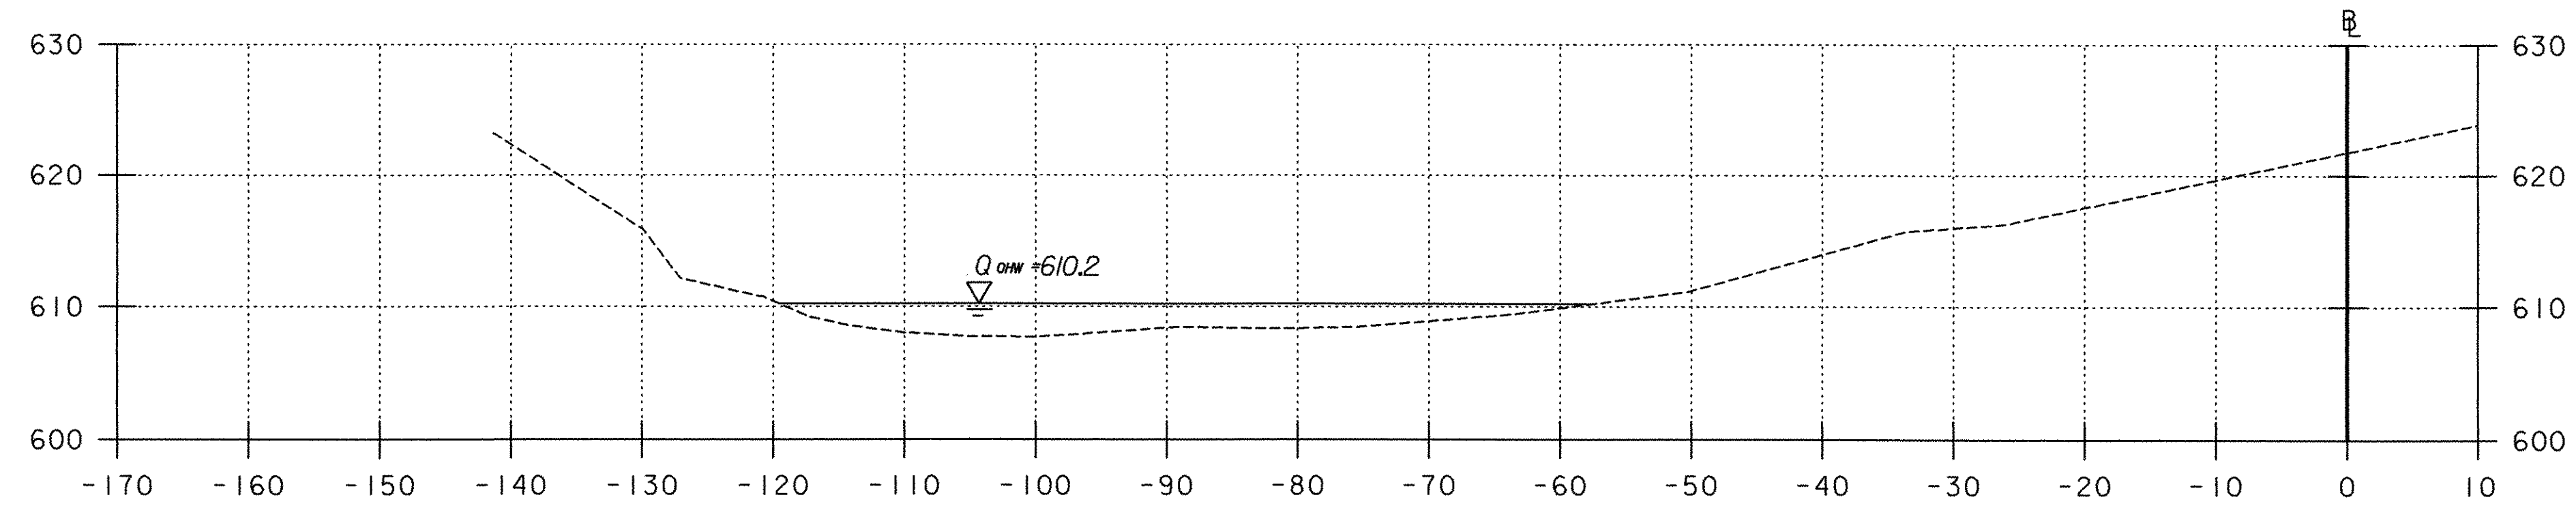

50+25

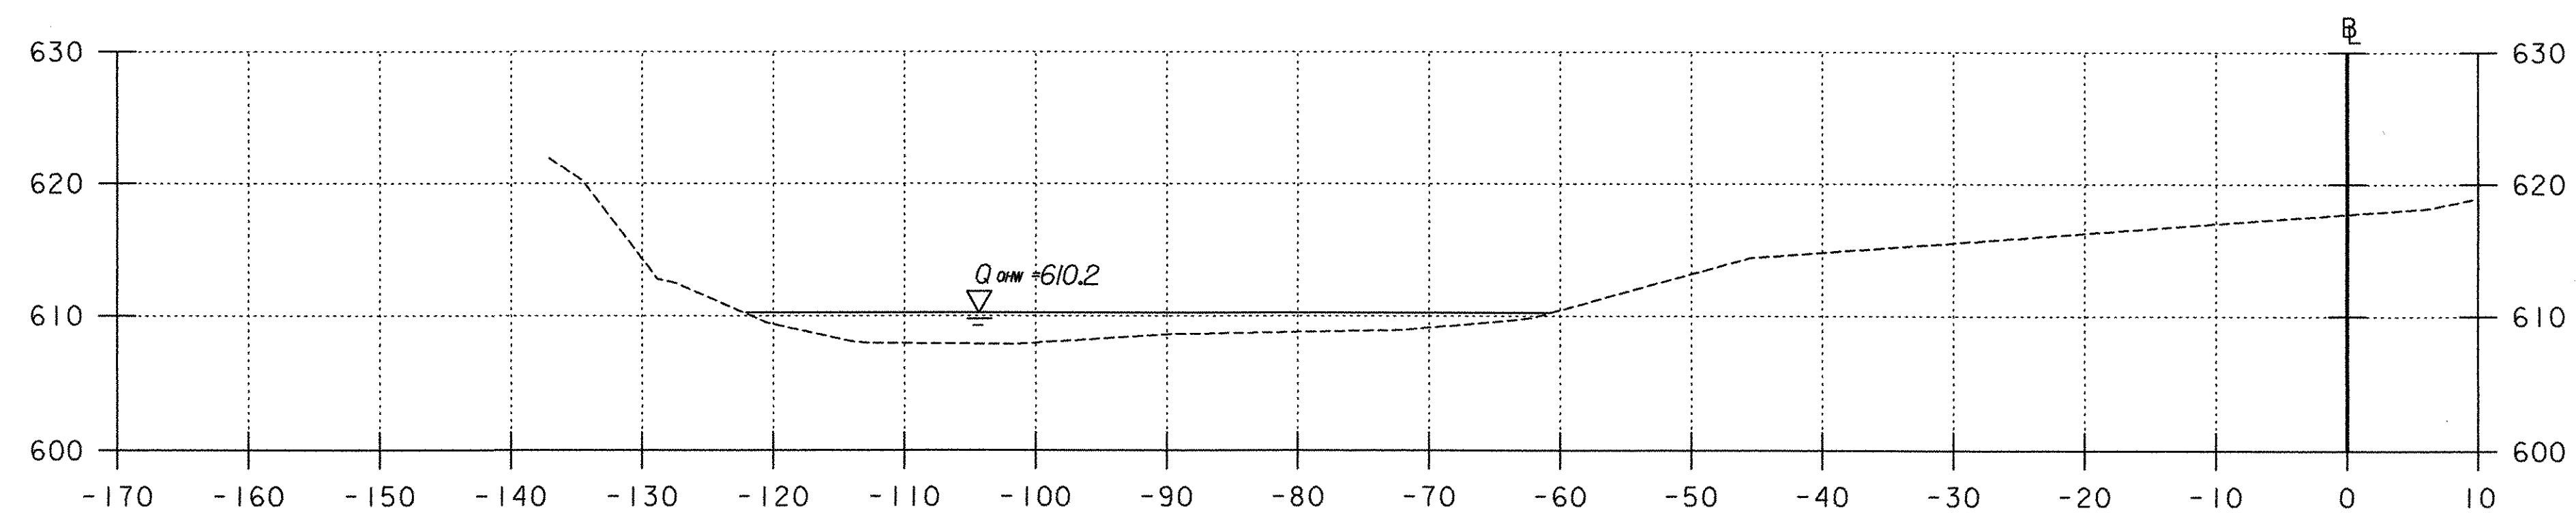

50+00

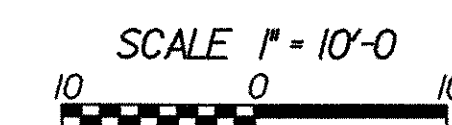

STA. 50+00 TO STA. 50+50



PROJECT NAME:	HUNTINGTON	FILE NAME:	...\\Cadd\Trans\z0j302xsl.dgn	PLOT DATE:	1/12/2006
PROJECT NUMBER:	BRO 1445 (29)	PROJECT LEADER:	M. CHENETTE	DRAWN BY:	D. HARRINGTON
		DESIGNED BY:	T. KNIGHT	CHECKED BY:	M. CHENETTE
				SHEET	60 OF 63

CHANNEL CROSS SECTIONS