


STA. 51+45 (PIER)
 END COFFERDAM
 COFFERDAM EXCAVATION, EARTH
 STONE FILL, TYPE IV



STA. 51+50 TO STA. 52+00

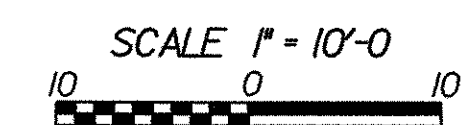

PROJECT NAME: HUNTINGTON
 PROJECT NUMBER: BRO 1445 (29)

FILE NAME: ...Cadd\Trans\z01j302xsl.dgn
 PROJECT LEADER: M. CHENETTE
 DESIGNED BY: T. KNIGHT

PLOT DATE: 1/12/2006
 DRAWN BY: D. HARRINGTON
 CHECKED BY: M. CHENETTE
 SHEET 62 OF 63

CHANNEL CROSS SECTIONS