



52+75

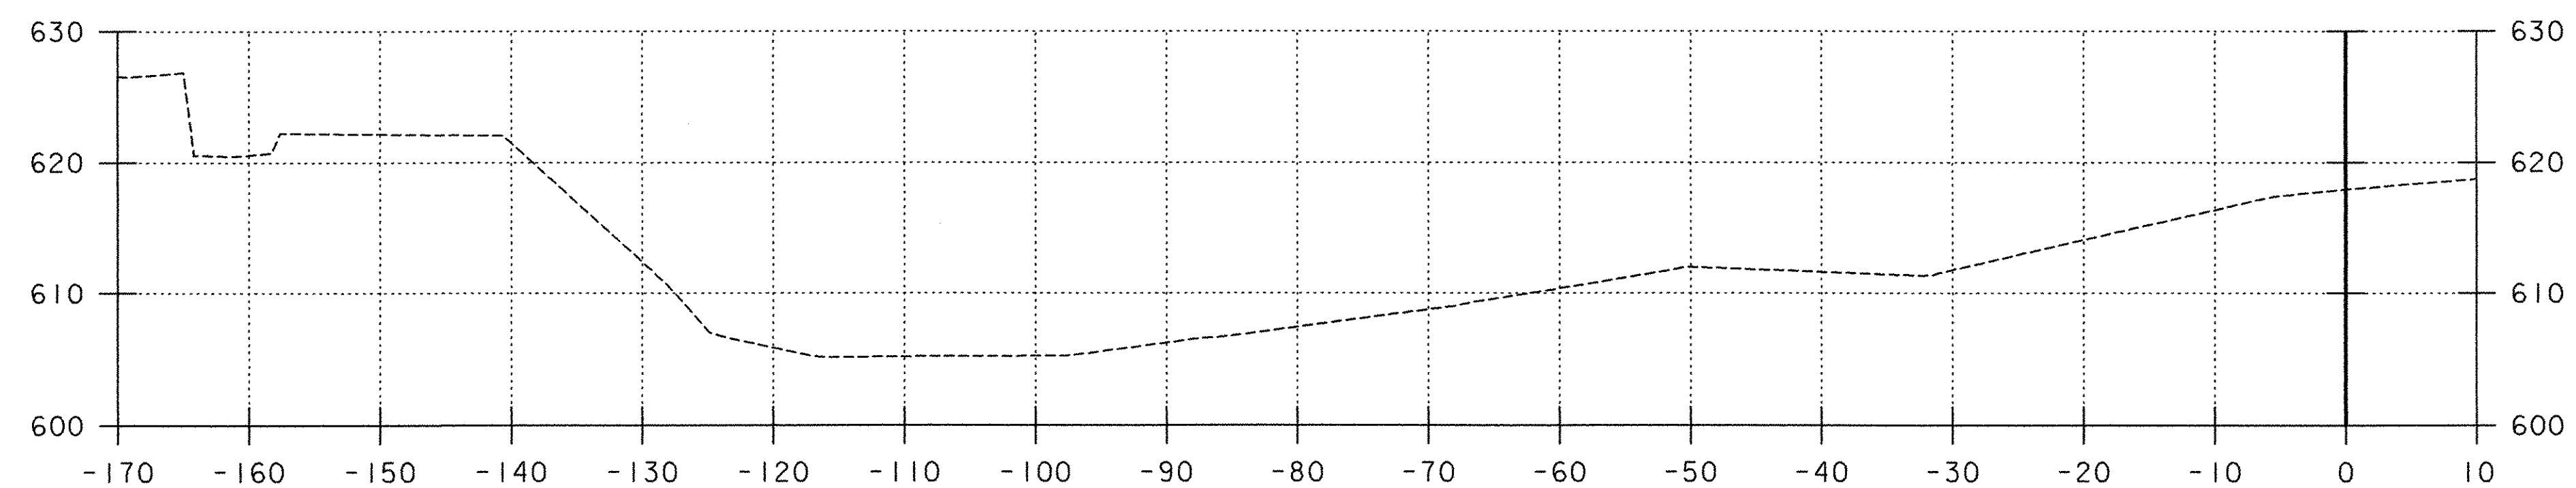


52+50

STA. 52+50 (ABUTMENT NO. 1)
 END UNCLASSIFIED CHANNEL EXCAVATION
 GEOTEXTILE UNDER STONE FILL
 STONE FILL, TYPE IV

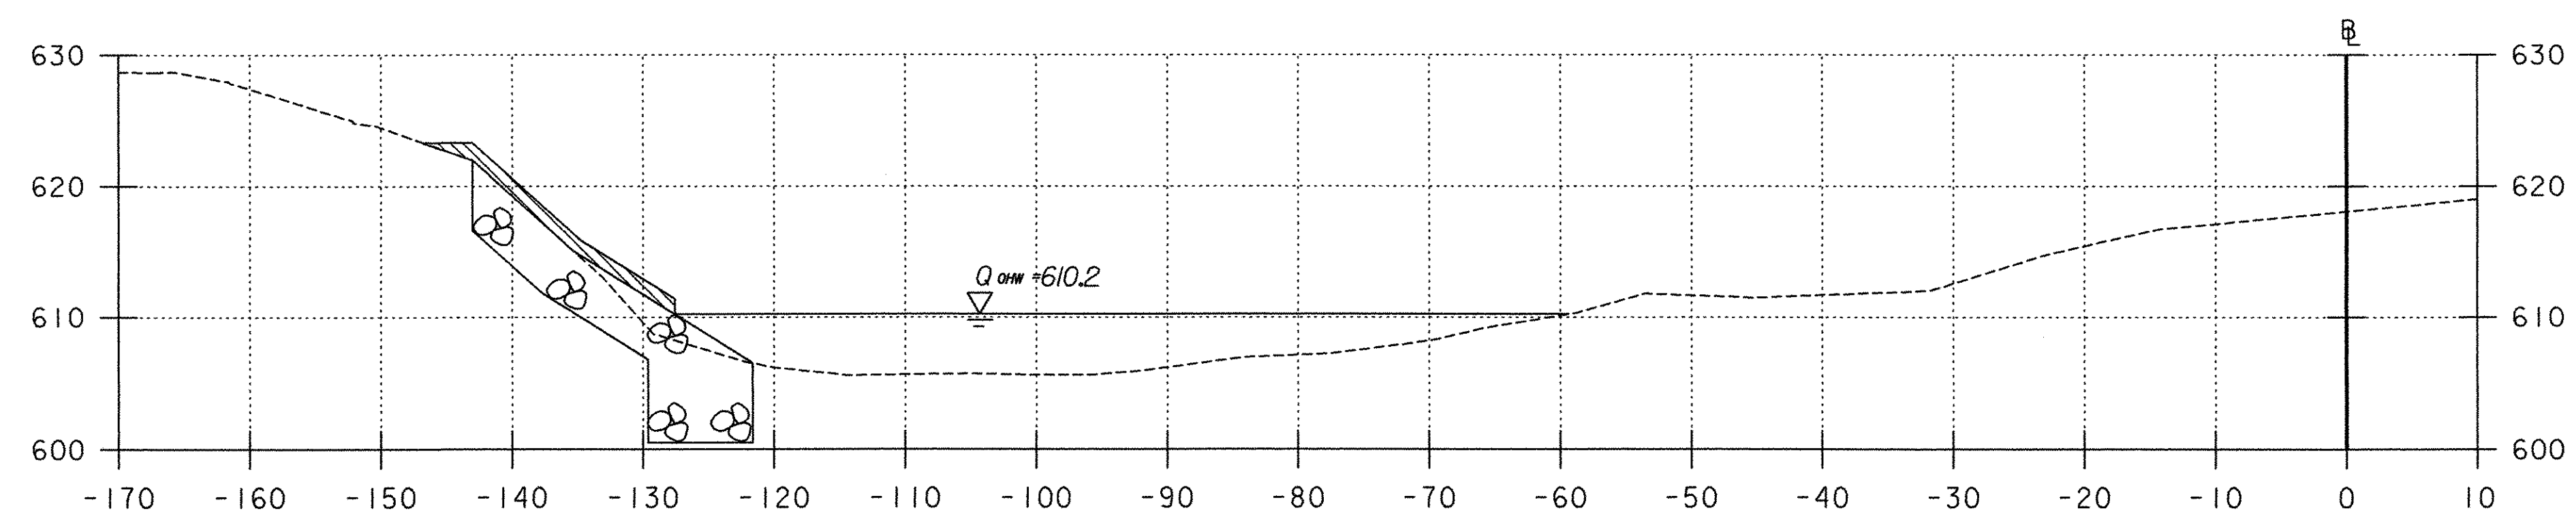

52+25

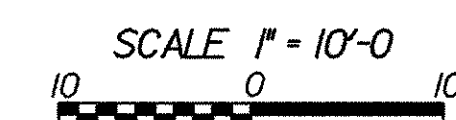

STA. 52+25 TO STA. 52+75



PROJECT NAME: HUNTINGTON
 PROJECT NUMBER: BRO 1445 (29)

FILE NAME: ...Cadd\Trans\z01j302xsl.dgn
 PROJECT LEADER: M. CHENETTE
 DESIGNED BY: T. KNIGHT

PLOT DATE: 1/12/2006
 DRAWN BY: D. HARRINGTON
 CHECKED BY: M. CHENETTE
 SHEET 63 OF 63

CHANNEL CROSS SECTIONS