


CK'D BY OK'D BY
 FEB 7 - 2007
 RESUBMIT APPROVED
 BY DATE 2/22/07

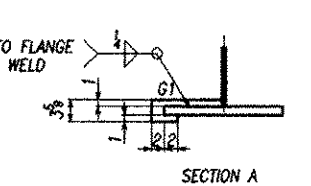

STA 9+18.57 TO STA 11+01.07
 BRIDGE # 42 EAST STREET (TH # 4)
 HUNTINGTON, VT
 CANTONMENT COUNTY

DESIGNED BY	SCALE	DATE
CHECKED BY	PROJECT	NO.
APPROVED BY	LOCATION	DATE
BY	DATE	

UNIVERSITY OF MASSACHUSETTS
 COLLEGE OF ENGINEERING
 CIVIL ENGINEERING DEPARTMENT
 100 SOUTH GATE STREET
 AMHERST, MASSACHUSETTS 01003

09455