


SHOP BILL									
NO.	QTY.	DESCRIPTION	SIZE	GRADE	FINISH	WELD.	WELD. SPEC.	WELD. DET.	WELD. DET.
24	15F1	CROSSFRAMES							
48	WT	6x12	8	10 1/2	A	V	M270-50W		
24	L	6x8x5	3	8 1/2	C	V	M270-50W		
24	L	6x8x5	3	10 1/2	D	V	M270-50W		
48	PL	3/8	11	1	E	V	M270-50W		
48	PL	3/8	11	3/8	E	V	M270-50W		
24	PL	3/8x12	1	8 1/2	H	V	M270-50W		
4	15F2	CROSSFRAMES							
8	WT	6x12	8	10 1/2	A	V	M270-50W		
4	L	6x8x5	3	8 1/2	C	V	M270-50W		
4	L	6x8x5	3	10 1/2	D	V	M270-50W		
8	PL	3/8	11	1	E	V	M270-50W		
8	PL	3/8	11	3/8	E	V	M270-50W		
4	PL	3/8x12	1	8 1/2	H	V	M270-50W		

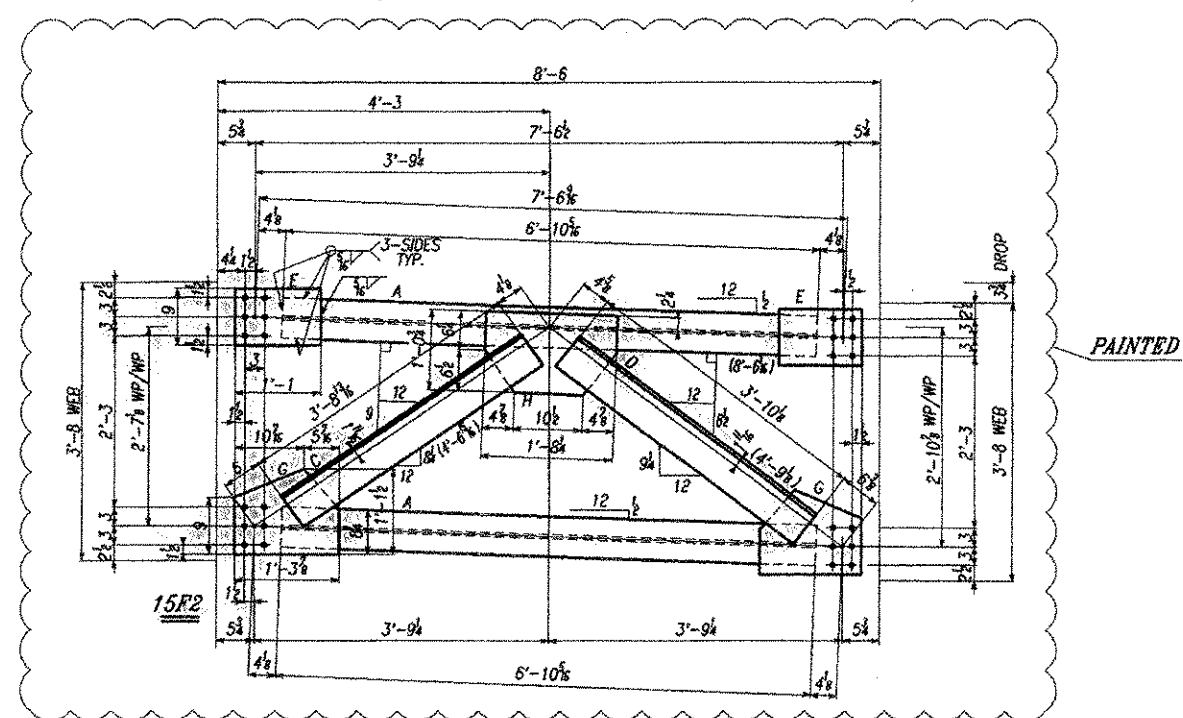

STA 8+19.57 TO STA 11+01.07  
 BRIDGE # 42 EAST STREET (NH 4)  
 HUNTINGTON, VT  
 CHITTENDEN COUNTY

DESIGNED BY: [Signature]  
 DRAWN BY: [Signature]  
 CHECKED BY: [Signature]  
 DATE: [Date]

PROJECT: BRIDGE # 42 EAST STREET (NH 4)  
 CLASS: LOCAL ROAD

CONTRACT NO.: [Number]  
 CONTRACTOR: [Name]

CAROLINA SYSTEMS CORPORATION  
 1000 W. 10th Street  
 Raleigh, NC 27603