
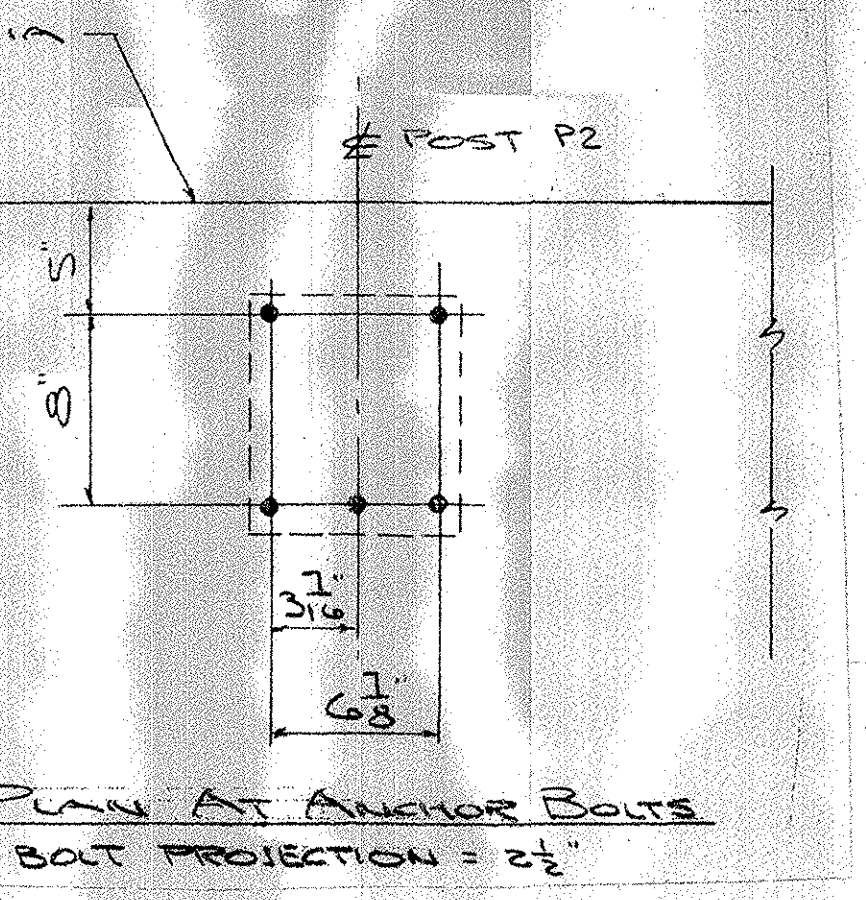
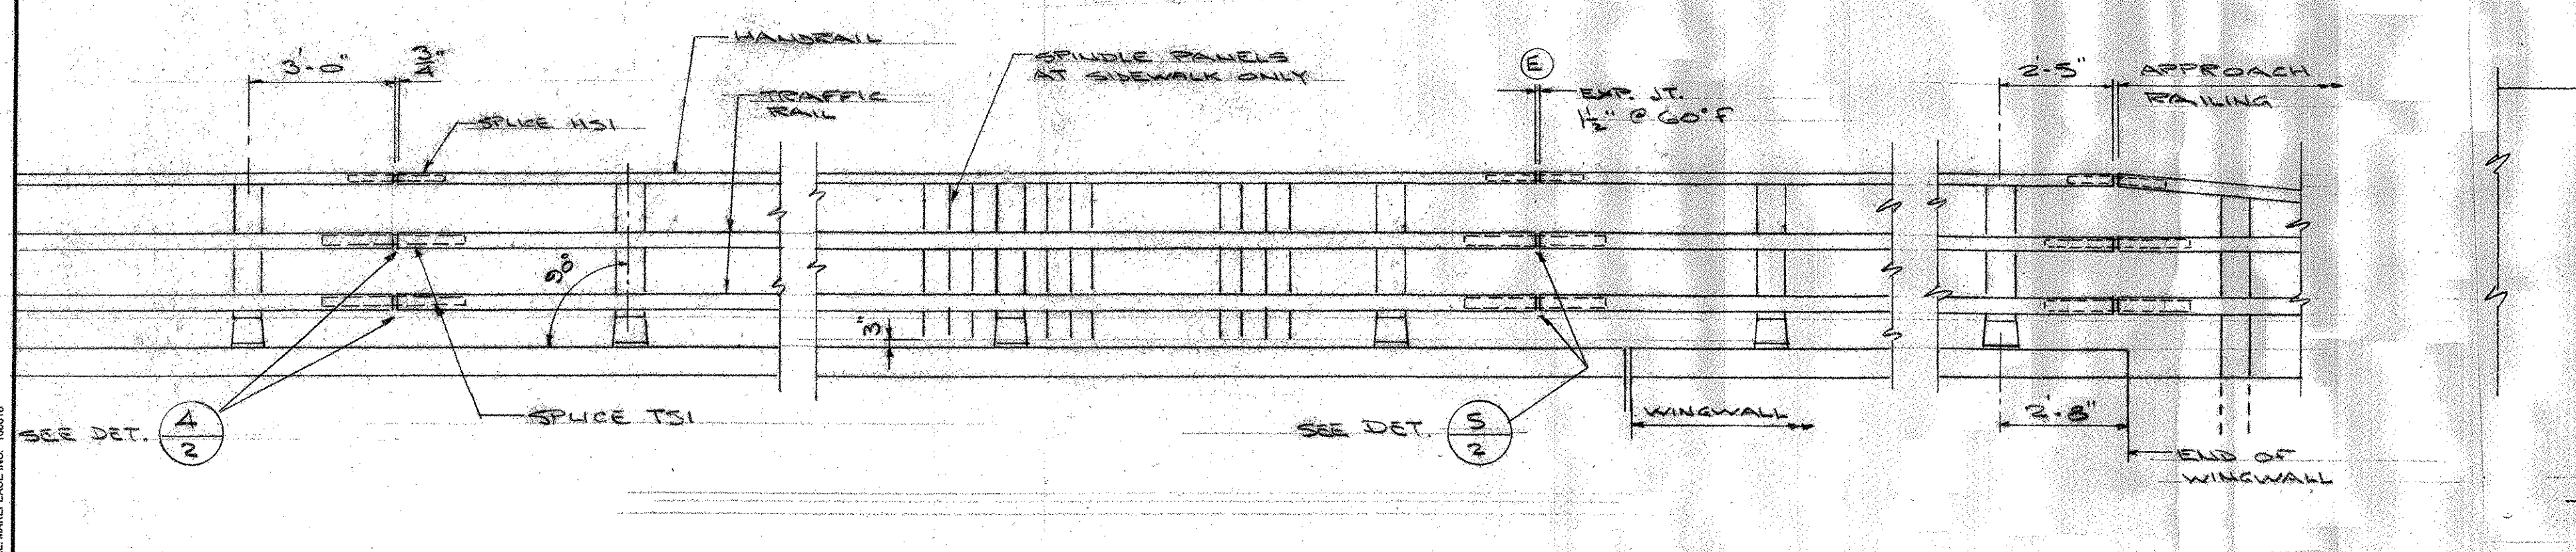
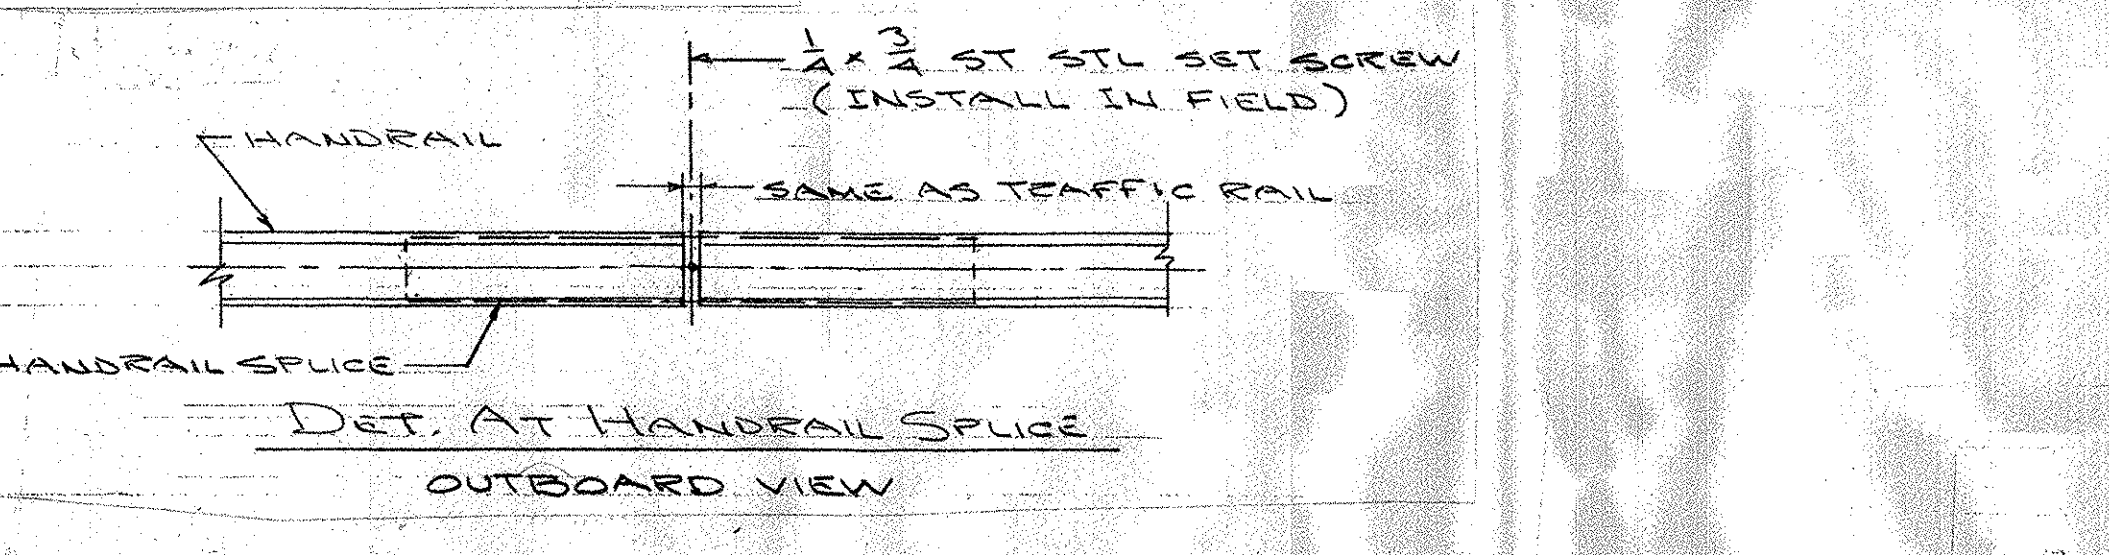
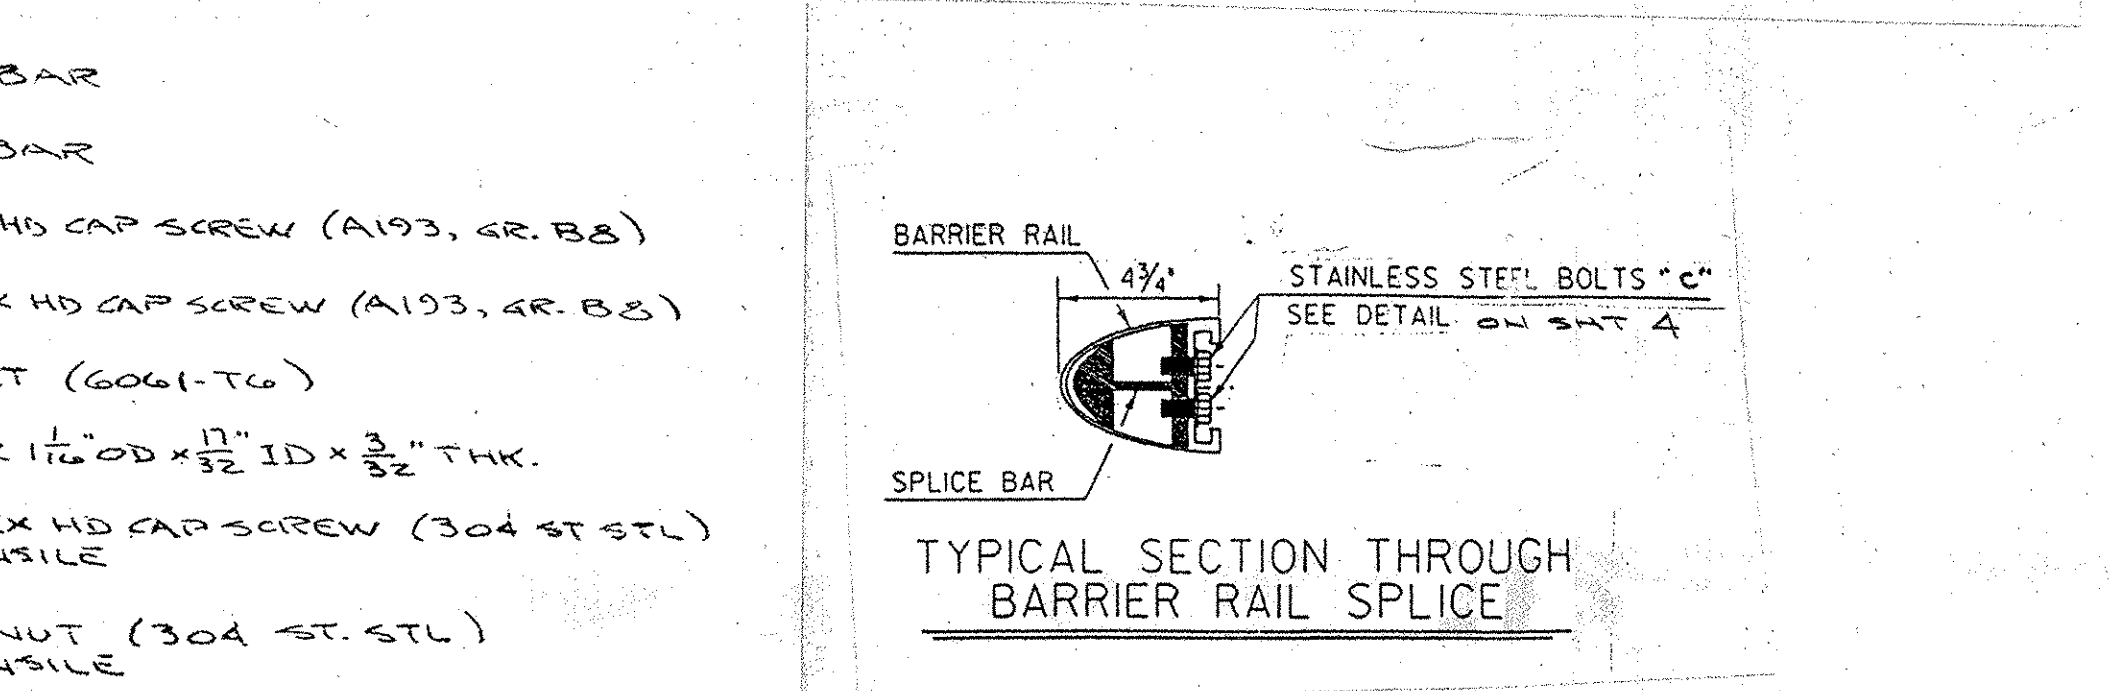


POST NO.	RAIL HEIGHT DIMENSIONS			OFFSET BLOCK DIMENSIONS			
	A	B	C	D	E	F	G
1	4'-1 1/8"	3'-2 1/8"	1'-9"	11/16"	1'-5 1/8"	2'-9 1/8"	
2	3'-9 3/8"	3'-0 3/8"	1'-8 3/4"	9/8"	1'-3 3/8"	2'-6 3/8"	
3	3'-7 3/8"	2'-11 1/2"	1'-8 3/4"	8/8"	1'-2 3/8"	2'-3 1/4"	
4	3'-4 1/8"	2'-10 1/8"	1'-9 3/8"	6/16"	1'-1 1/4"	2'-0 1/4"	

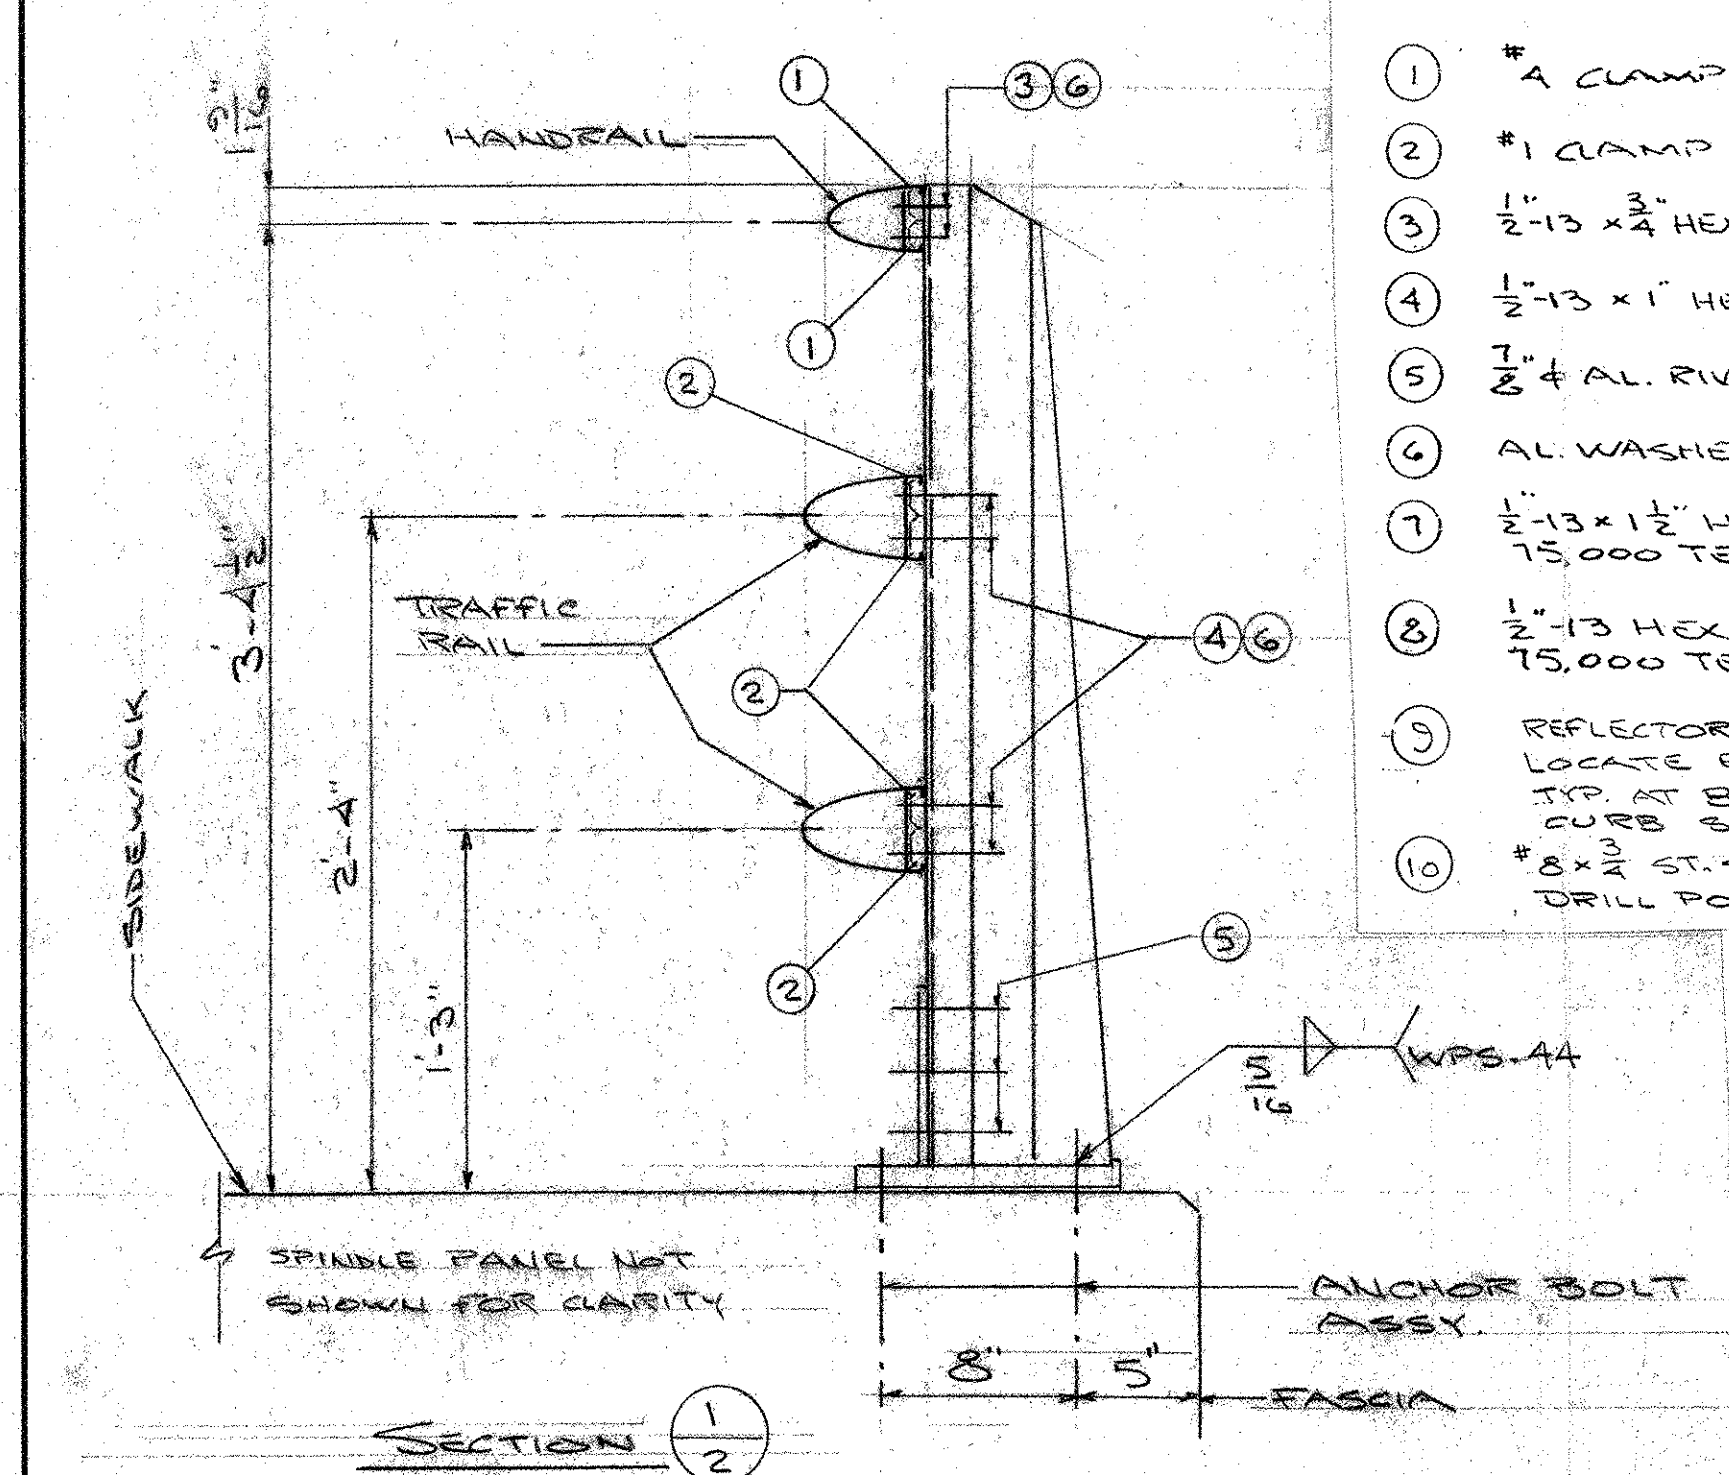

REVIEW DRAWINGS ARE REVIEWED UNLESS NOTED OTHERWISE

NO EXCEPTION TAKEN	<input checked="" type="checkbox"/>
REVIEW AS NOTED	<input type="checkbox"/>
RESUBMISSION NOT REQUIRED	<input type="checkbox"/>
REVIEW AS NOTED	<input type="checkbox"/>
RESUBMISSION REQUIRED	<input type="checkbox"/>
REJECTED	<input type="checkbox"/>

DATE: 3/14/07

SIGNATURE: *Michael Chavitt*

REVIEWER'S STATEMENT: I, THE REVIEWER, HAVE REVIEWED THE DRAWINGS FOR THE SOLE PURPOSE OF ASCERTAINING GENERAL CONFORMITY WITH DIMENSIONS, FABRICATION AND CONSTRUCTION METHODS. COORDINATION OF SUB TRADES, DETAIL DESIGN OF COMPONENTS AND ERRORS OR OMISSIONS ON SHOP DRAWINGS.

AUCIELLO IRON WORKS INC
560 MAIN ST. HUDSON, MA (978) 568-8382

VT AGENCY OF TRANSPORTATION
HUNTINGTON PROJ BRO 1445 (29)
BRIDGE # 42
EAST ST. OVER HUNTINGTON RIVER

AL. BRIDGE & APPROACH RAILING

SURFACE PREP: NONE	FINISH: MILL FINISH
FOR: A.D. ROSSI CORP.	
DRWM 2-16-07	DWG. NO. BR-2898
CHKD 2-18-07	JOB NO. AB10002-1001
DATE	SHEET 2 OF 8

RECEIVED

CHK'D BY: *[Signature]* DATE: *[Date]*

RESUBMITTED: *[Date]*

APPROVED: *[Signature]* DATE: *[Date]*

1	2-22-07	FOR APPROVAL	BY: <i>[Signature]</i>
ISSUE	DATE	DESCRIPTION	BY