



1/8	PANEL No.	QUAN	A	B	C	D
	T1	20	7'-11"	7'-2 1/2"	11 SP. @ 7" = 6'-5"	9"

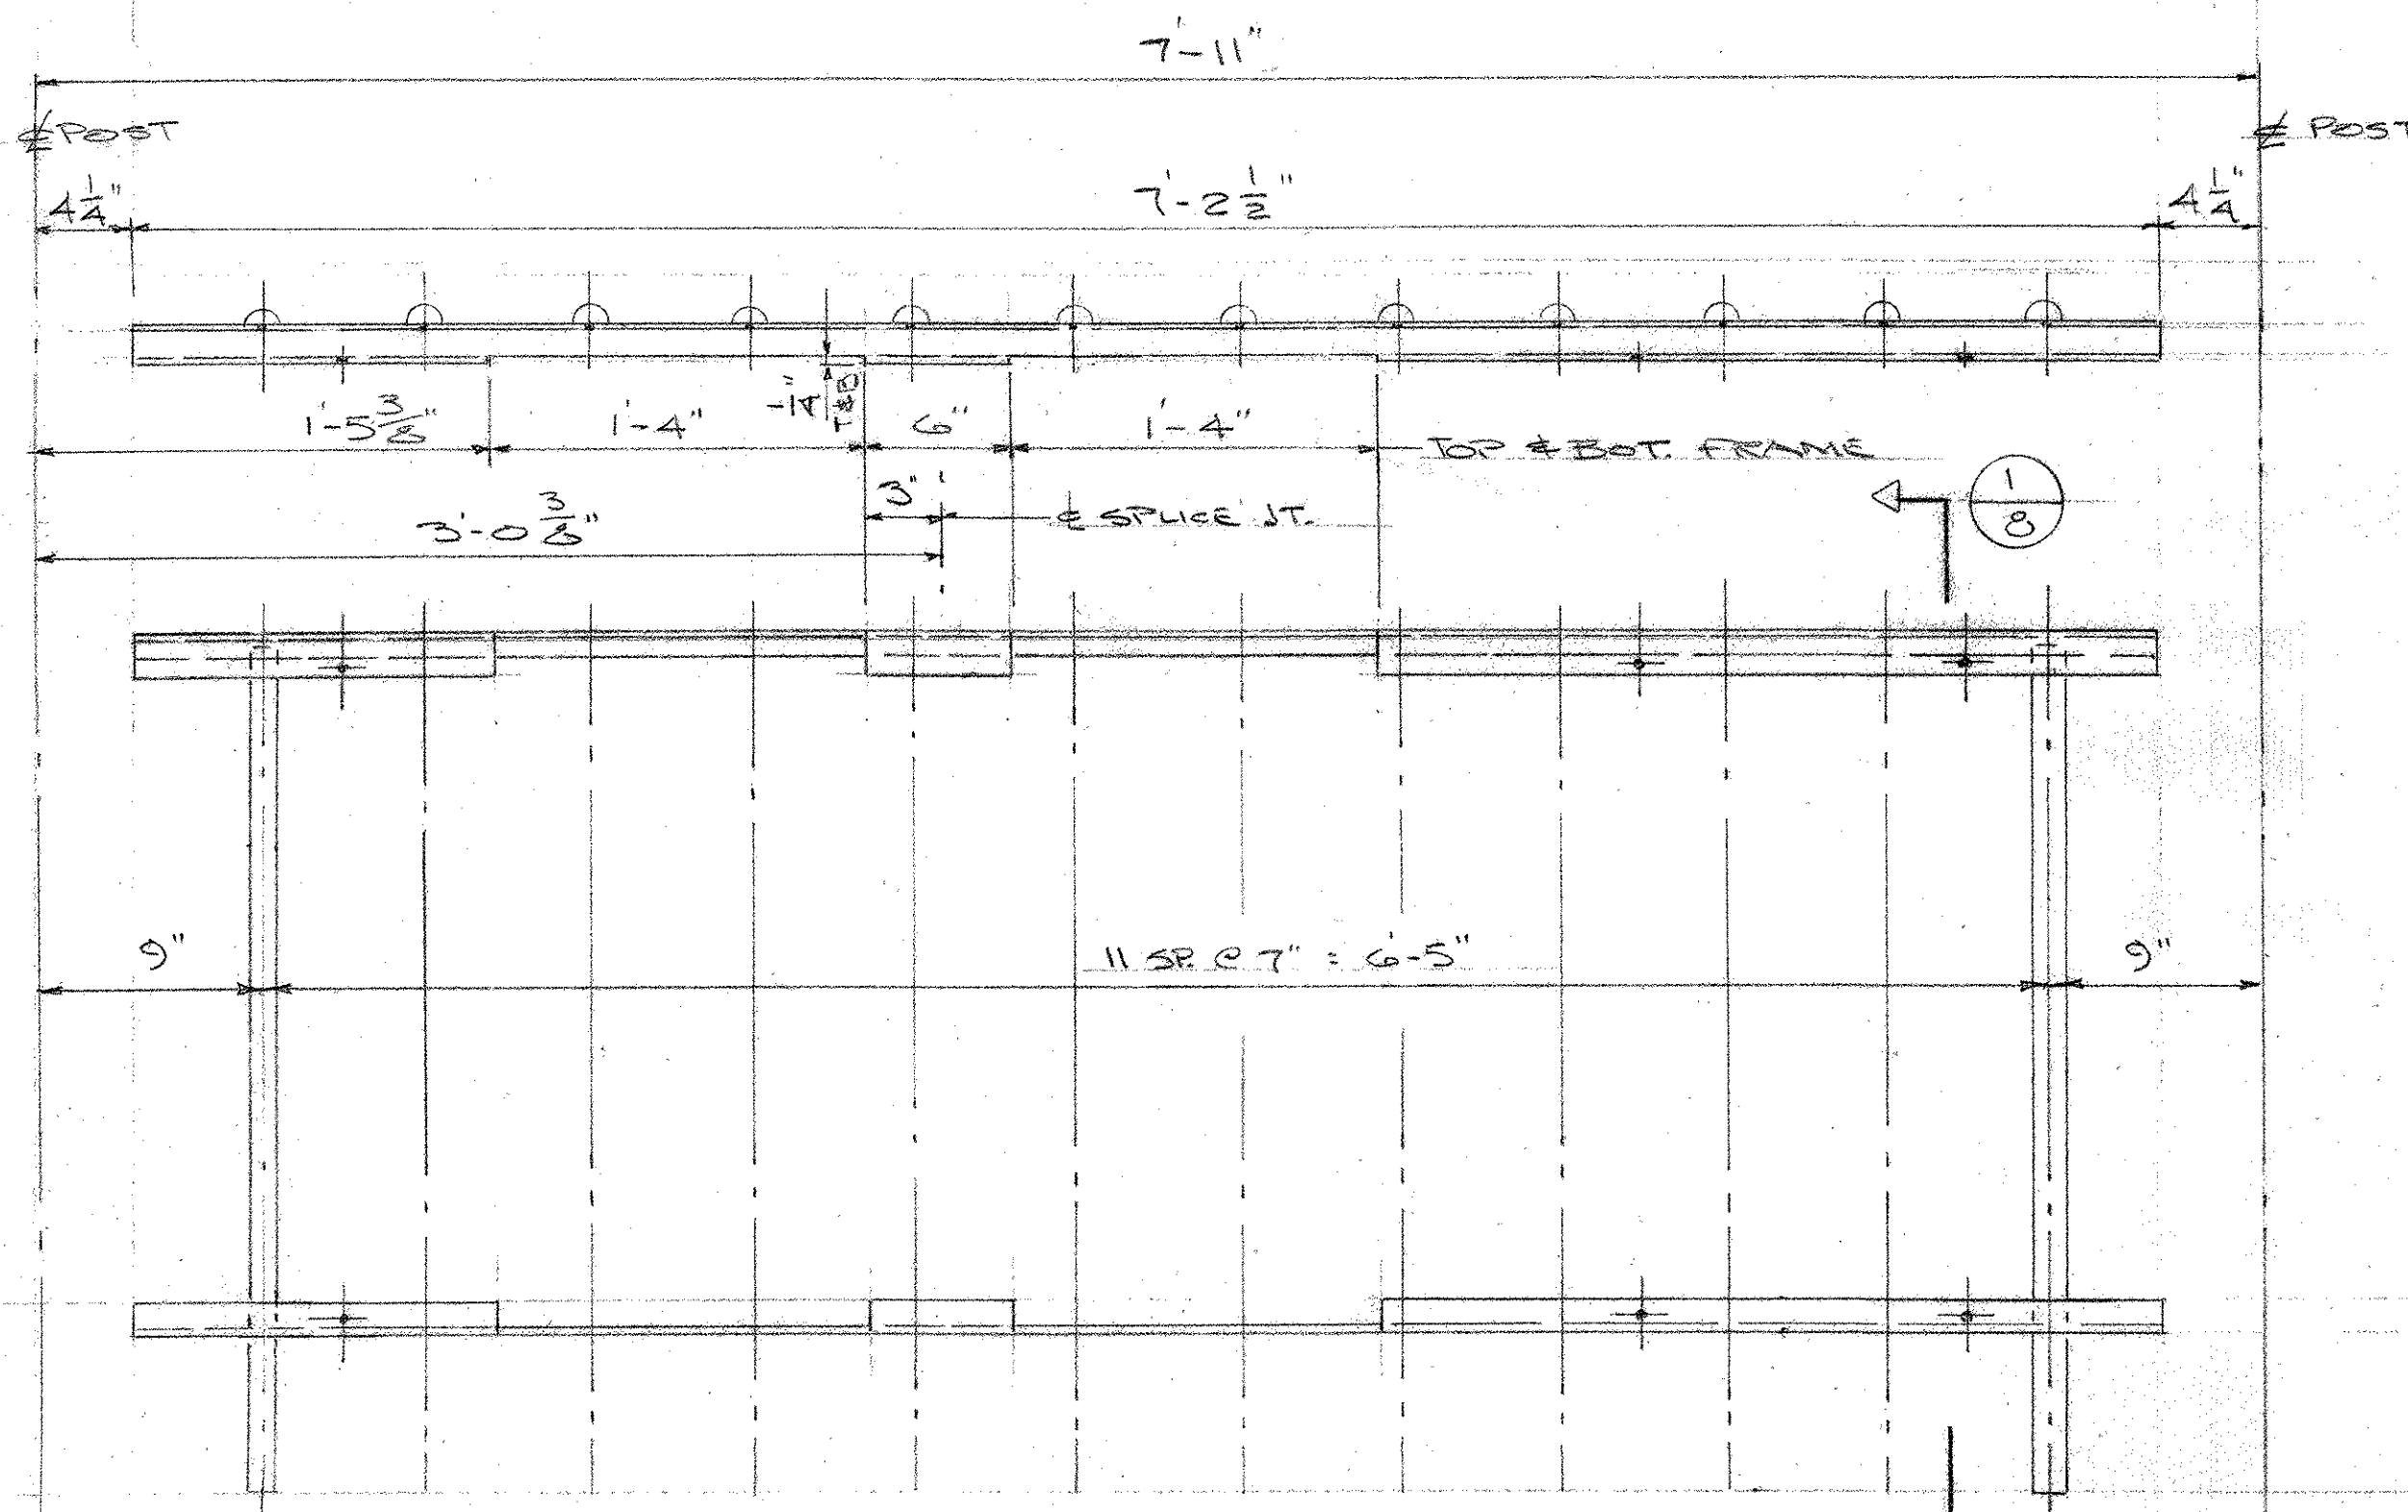

PANEL T2 (7-REQD)

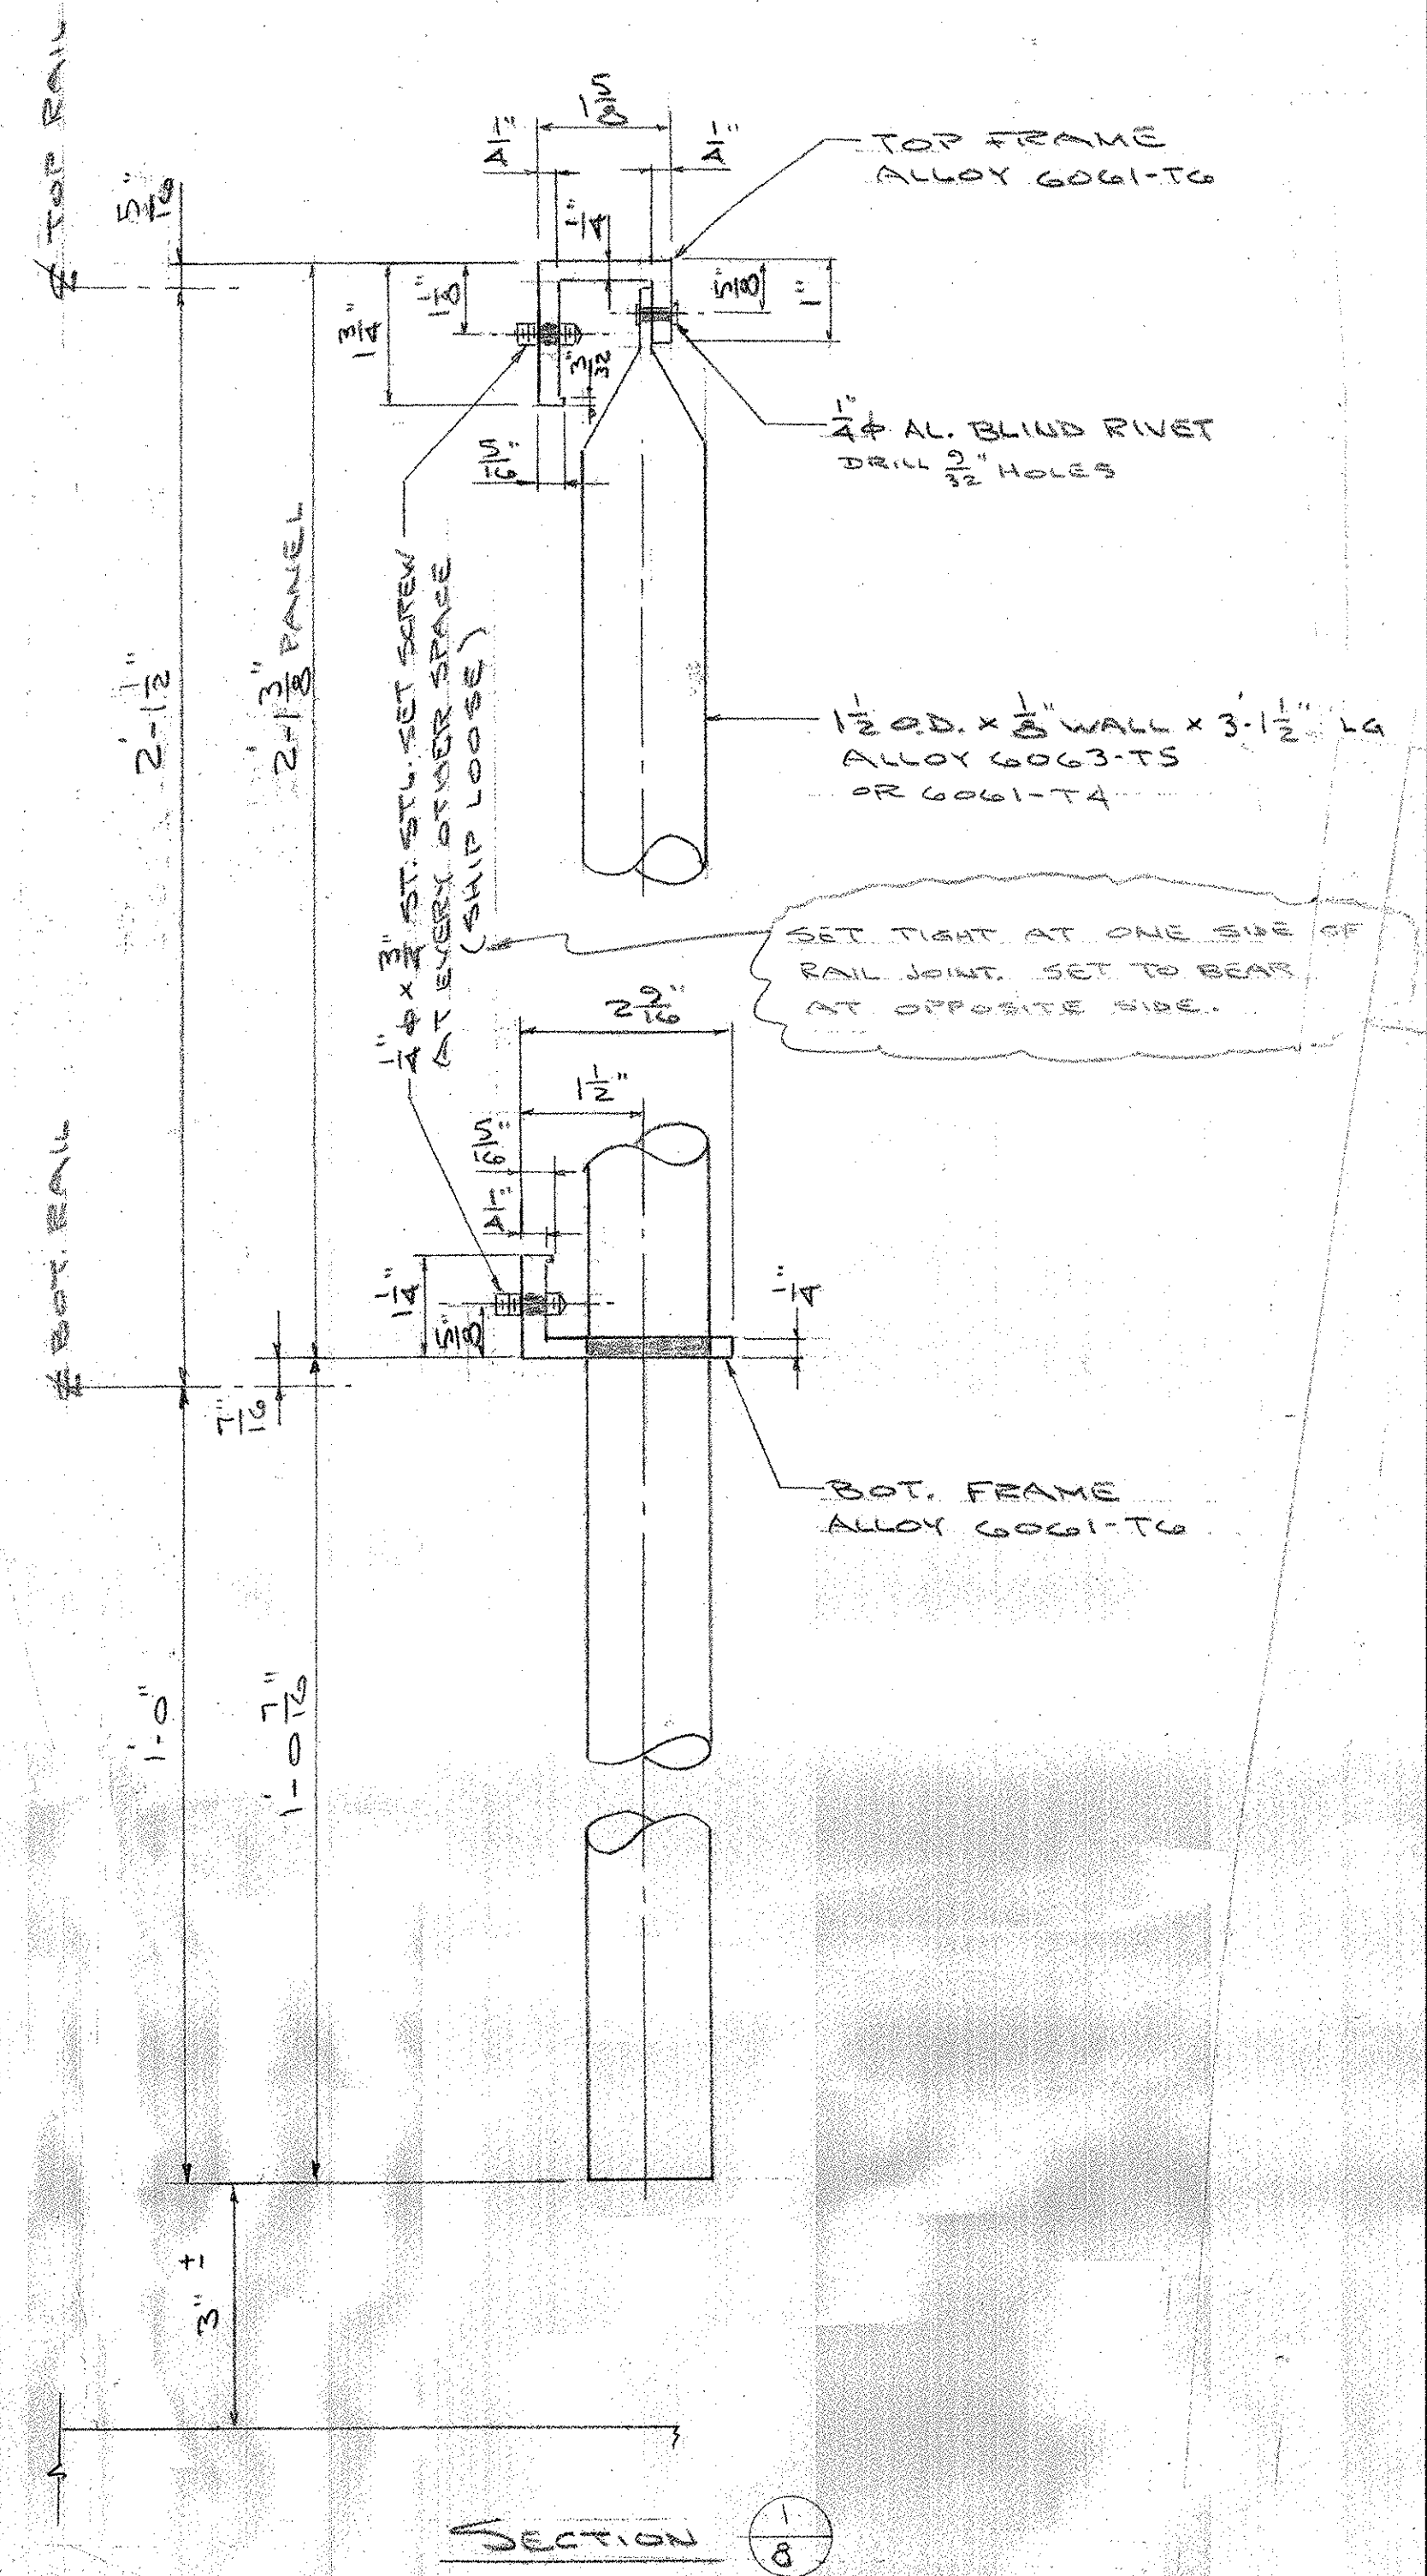

REVISIONS

NO EXCEPTION TAKEN	
REVISION AS NOTED	
RESUBMISSION NOT REQUIRED	
REVISION AS NOTED	
RESUBMISSION REQUIRED	
REJECTED	

DATE: 3/26/07

SIGNATURE: *Michael Chmilt*

REVIEW BY STANTEC IS FOR THE SOLE PURPOSE OF ASCERTAINING GENERAL CONFORMITY WITH DESIGN. CONTRACTOR IS RESPONSIBLE FOR DIMENSIONS, FABRICATION AND CONSTRUCTION METHODS, COORDINATION OF SUB-TRADES, DETAIL DESIGN OF COMPONENTS, AND ERRORS OR OMISSIONS ON EACH DRAWING.

RECEIVED

CHKD BY: *[Signature]* DATE: FEB 28 2007

RESUBMIT BY: *[Signature]* APPROVED DATE: *[Signature]*

1 2-28-07 FOR APPROVAL

ISSUE DATE DESCRIPTION BY

**AUCIELLO IRON WORKS INC**  
560 MAIN ST. HUDSON, MA (978) 568-8382

VT AGENCY OF TRANSPORTATION  
HUNTINGTON PROJ. BRO 1445 (29)  
BRIDGE #42  
EAST ST. OVER HUNTINGTON RIVER

ALUM. PICKET PANELS

SURFACE PREP: NONE	FINISH: MILL FINISH
FOR: A.D. ROSSI CORP.	DWG. NO. BR-2898
DR: WM 02-12-07	CHKD: 02-17-07
JOB NO. AB10002-1001	SHEET 8 OF 8

128BR