



-RECLAIMING/OVERLAY DETAIL @ BRIDGES-

LOCATION: LUNENBURG BRIDGE #16 STATION: 7+203 (FIELD MEASURED)

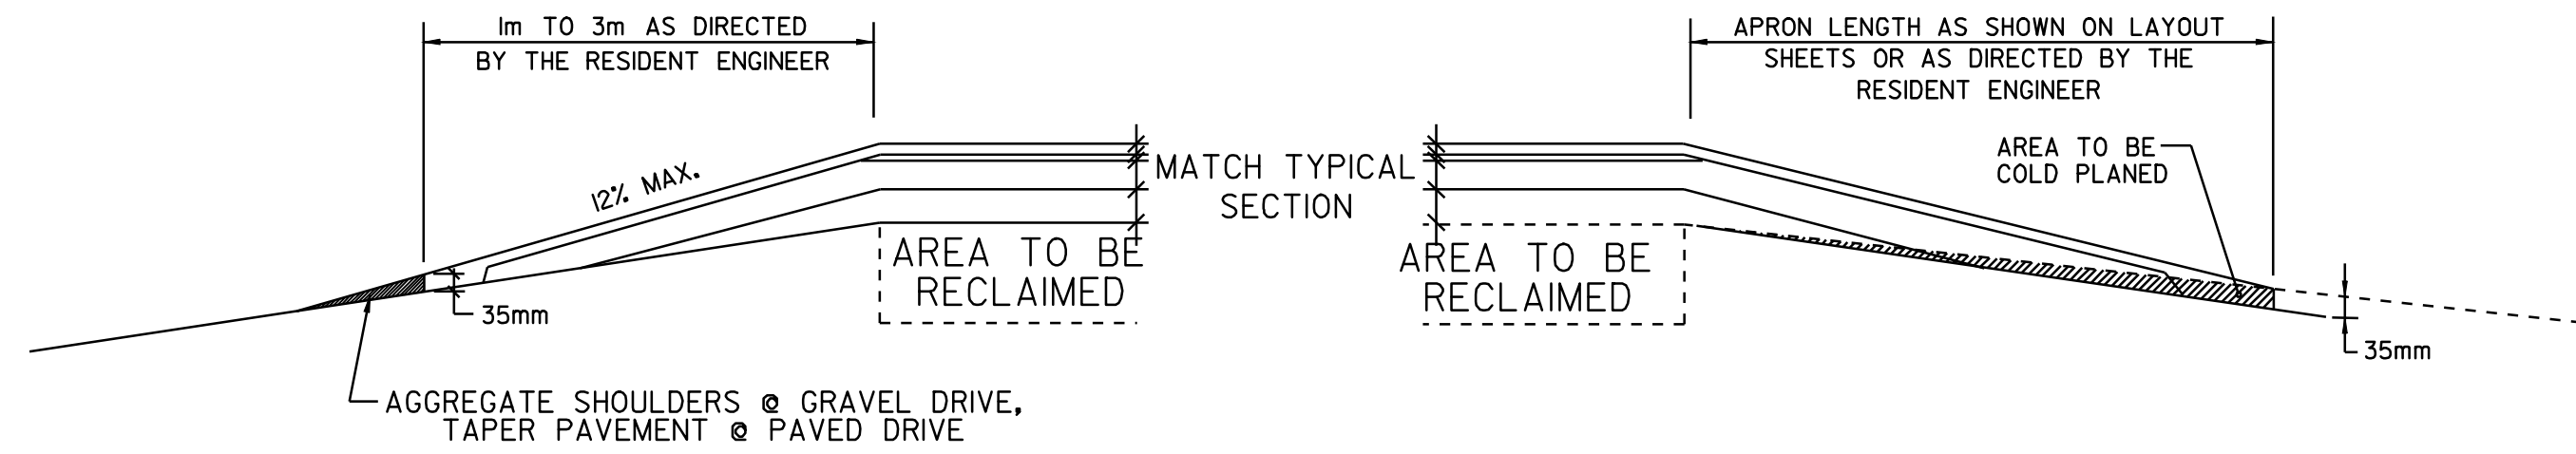


DRIVEWAY TRANSITION DETAIL @ RECLAIMED STABILIZED BASE AREAS

TOWN HIGHWAY TRANSITION DETAIL @ RECLAIMED STABILIZED BASE AREAS

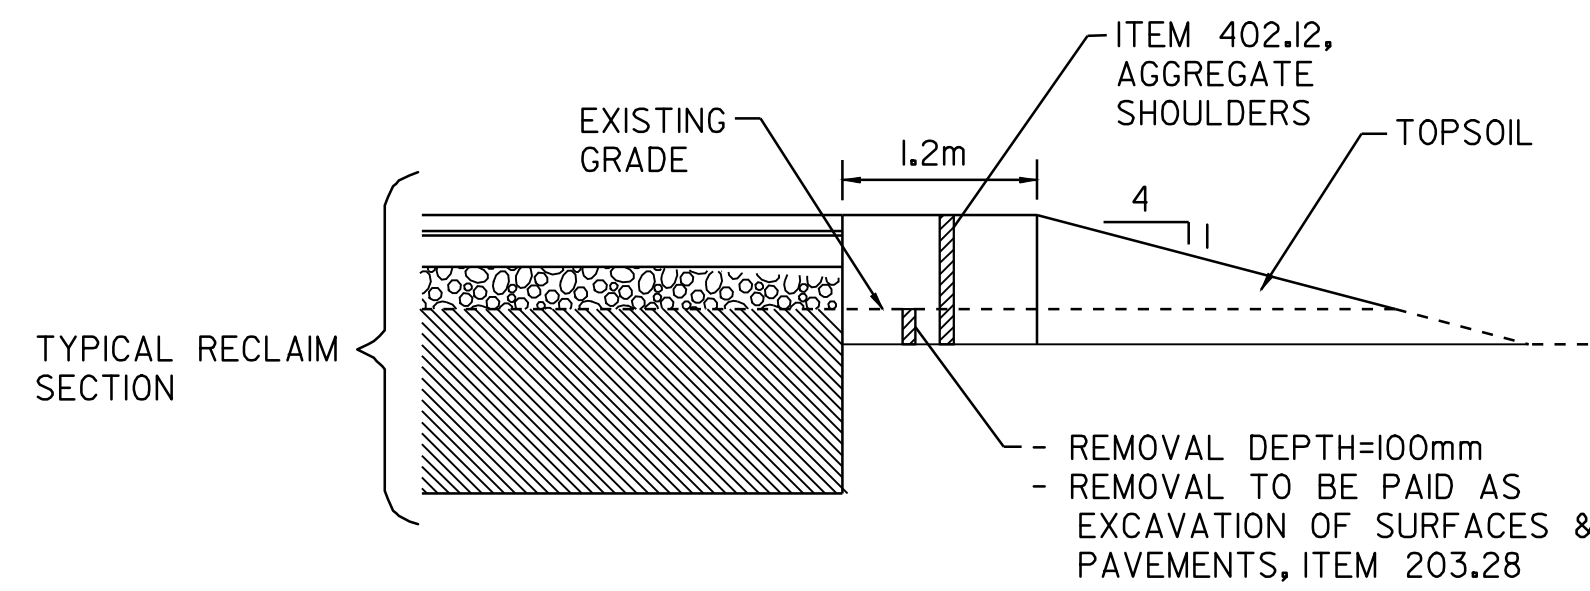


ROAD SECTION AT RECONSTRUCTED INTERSECTIONS

**TH#2 LUNENBURG ROAD
TH#4 COVERED BRIDGE ROAD**

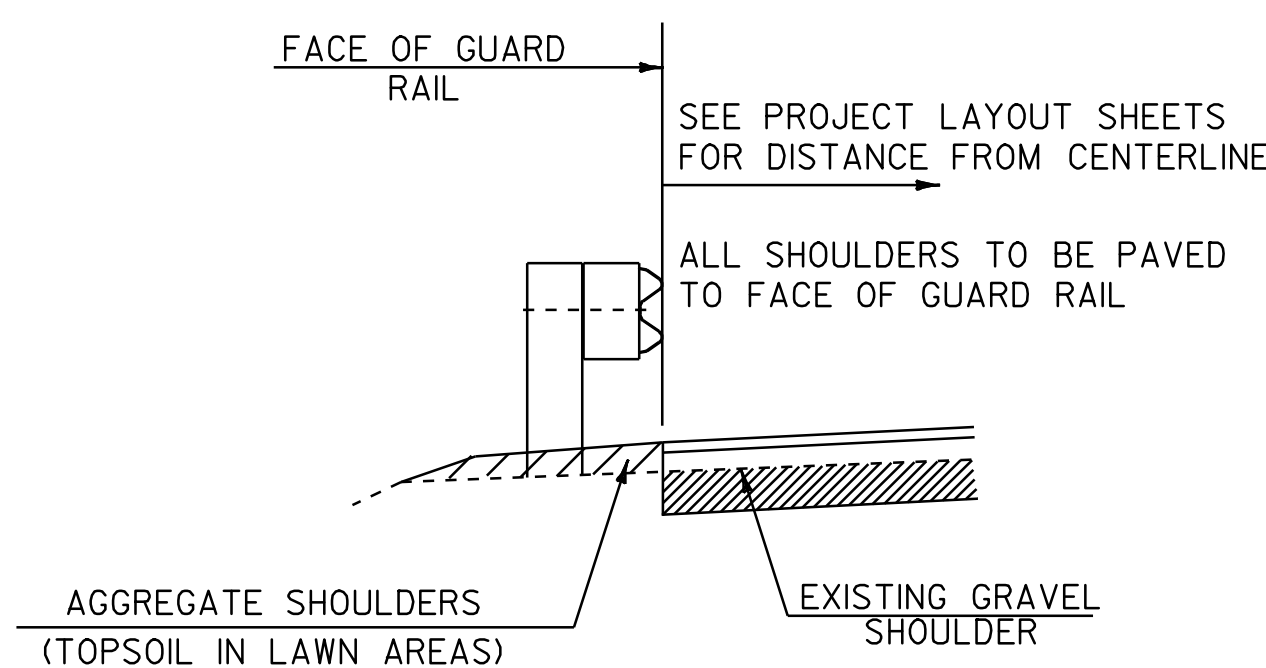


- TYPICAL SECTION AT GUARD RAIL - RECLAIMING SECTION

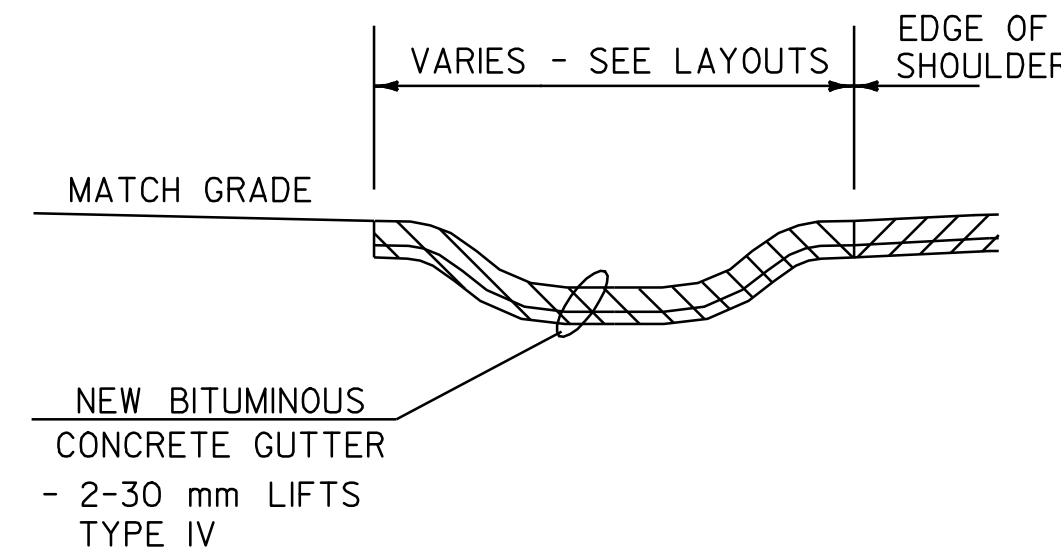

BITUMINOUS CONCRETE GUTTER DETAIL

LUNENBURG
STA 11+254 TO 11+290 LT

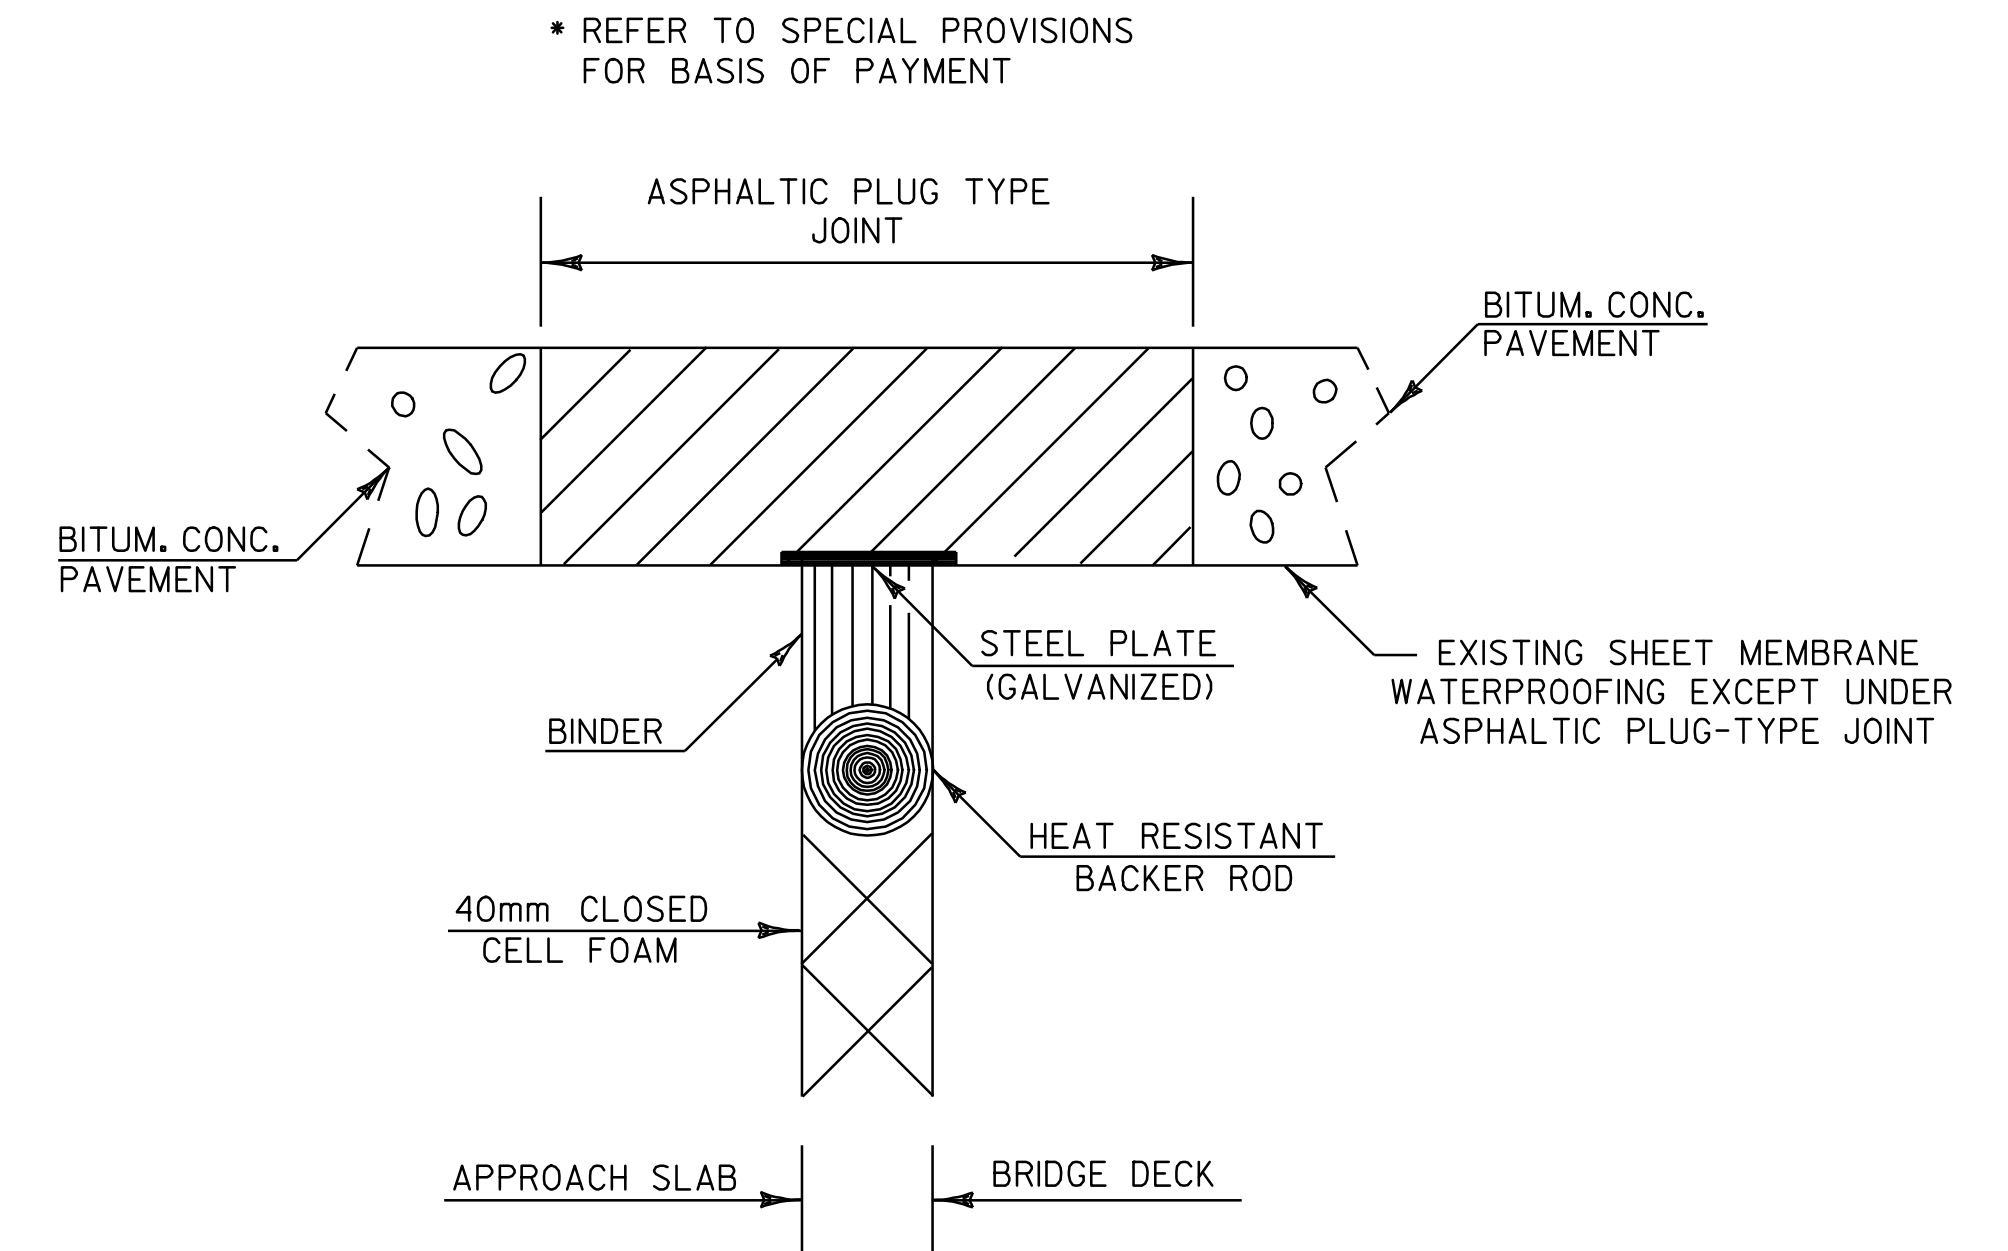

- ASPHALTIC PLUG TYPE JOINT DETAIL -

LOCATION: LUNENBURG
BRIDGE #16 (9m) - STA 7+197

**CONSERVATION SEED MIX
RURAL AREA - SEED MIXTURE**

% WT.	kg/HECTARE	NAME	PUR%	GERM%
38.0	25	CREeping RED FESCUE	98	85
38.0	25	TALL FESCUE	95	90
4.5	3	RED TOP	95	90
15.0	10	BIRDSFOOT TREFOIL	98	85
4.5	3	ANNUAL RYEGRASS	95	85
100.0	66			

SEED MIXTURE:
SHALL NOT HAVE A WEED CONTENT EXCEEDING 0.40% BY WEIGHT AND SHALL BE FREE OF ALL NOXIOUS SEED.

SEED:
TO BE APPLIED PER SEEDING FORMULAS OR AS DIRECTED BY THE ENGINEER.

FERTILIZER:
FORMULA 10-20-10, TO BE USED WITH SEED, APPLIED AT THE RATE OF 560 kg/HECTARE. (HYDRO SEEDERS MAY USE 19-19-19 FORMULA)

AGRICULTURAL LIMESTONE:
TO BE APPLIED AT THE RATE OF 4.5 TONS/HECTARE, OR AS DIRECTED BY THE ENGINEER.

HAY MULCH:
TO BE PLACED ON EARTH SLOPES AT THE RATE OF 4.5 TONS/HECTARE, OR AS DIRECTED BY THE ENGINEER.

TOPSOIL:
TO BE USED AS INDICATED ON THE PLANS, OR AS DIRECTED BY THE ENGINEER.

MARKER POSTS:
TO BE PLACED AS INDICATED OR AS DIRECTED BY THE ENGINEER.



PROJECT TYPICAL SHEET #2	DESIGNED BY	BCE/PJM	DATE	12-01
	DRAWN BY	C.E.A., INC.	DATE	12-01
	DESIGN FILE NO.	pave/01c150/pci50.dgn		
	PRF FILE	pci50ty2.i	DATE PLOTTED	10-AUG-2007 14
	PROJ. NAME	LUNENBURG		
PROJ. NO.	STP 2301(7)S			
SHEET	3	OF	20	SHEETS