

TEMPORARY AND 100mm YELLOW LINE
 STA 7+250 TO 8+750 SOLID LT&RT
 STA 7+763 DOUBLE SOLID LT
 (WITH CENTERLINE BREAKS FOR TOWN HIGHWAYS)


TEMPORARY AND 100mm WHITE LINE
 STA 7+250 TO 8+750 SOLID LT&RT
 (WITH EDGELINE BREAKS FOR TOWN HIGHWAYS)

REMOVING SIGNS 2
 YIELDING MARKER POSTS
 STA 7+372 RT

SEE ATTACHED SHEET FOR CHANGES TO INTERSECTION

TEMPORARY AND LETTER OR SYMBOL
 STA 7+770 LT "STOP"
 ADVANCE WARNING "STOP AHEAD"

TEMPORARY AND 600mm STOP BAR
 STA 7+763 LT LUNENBURG ROAD

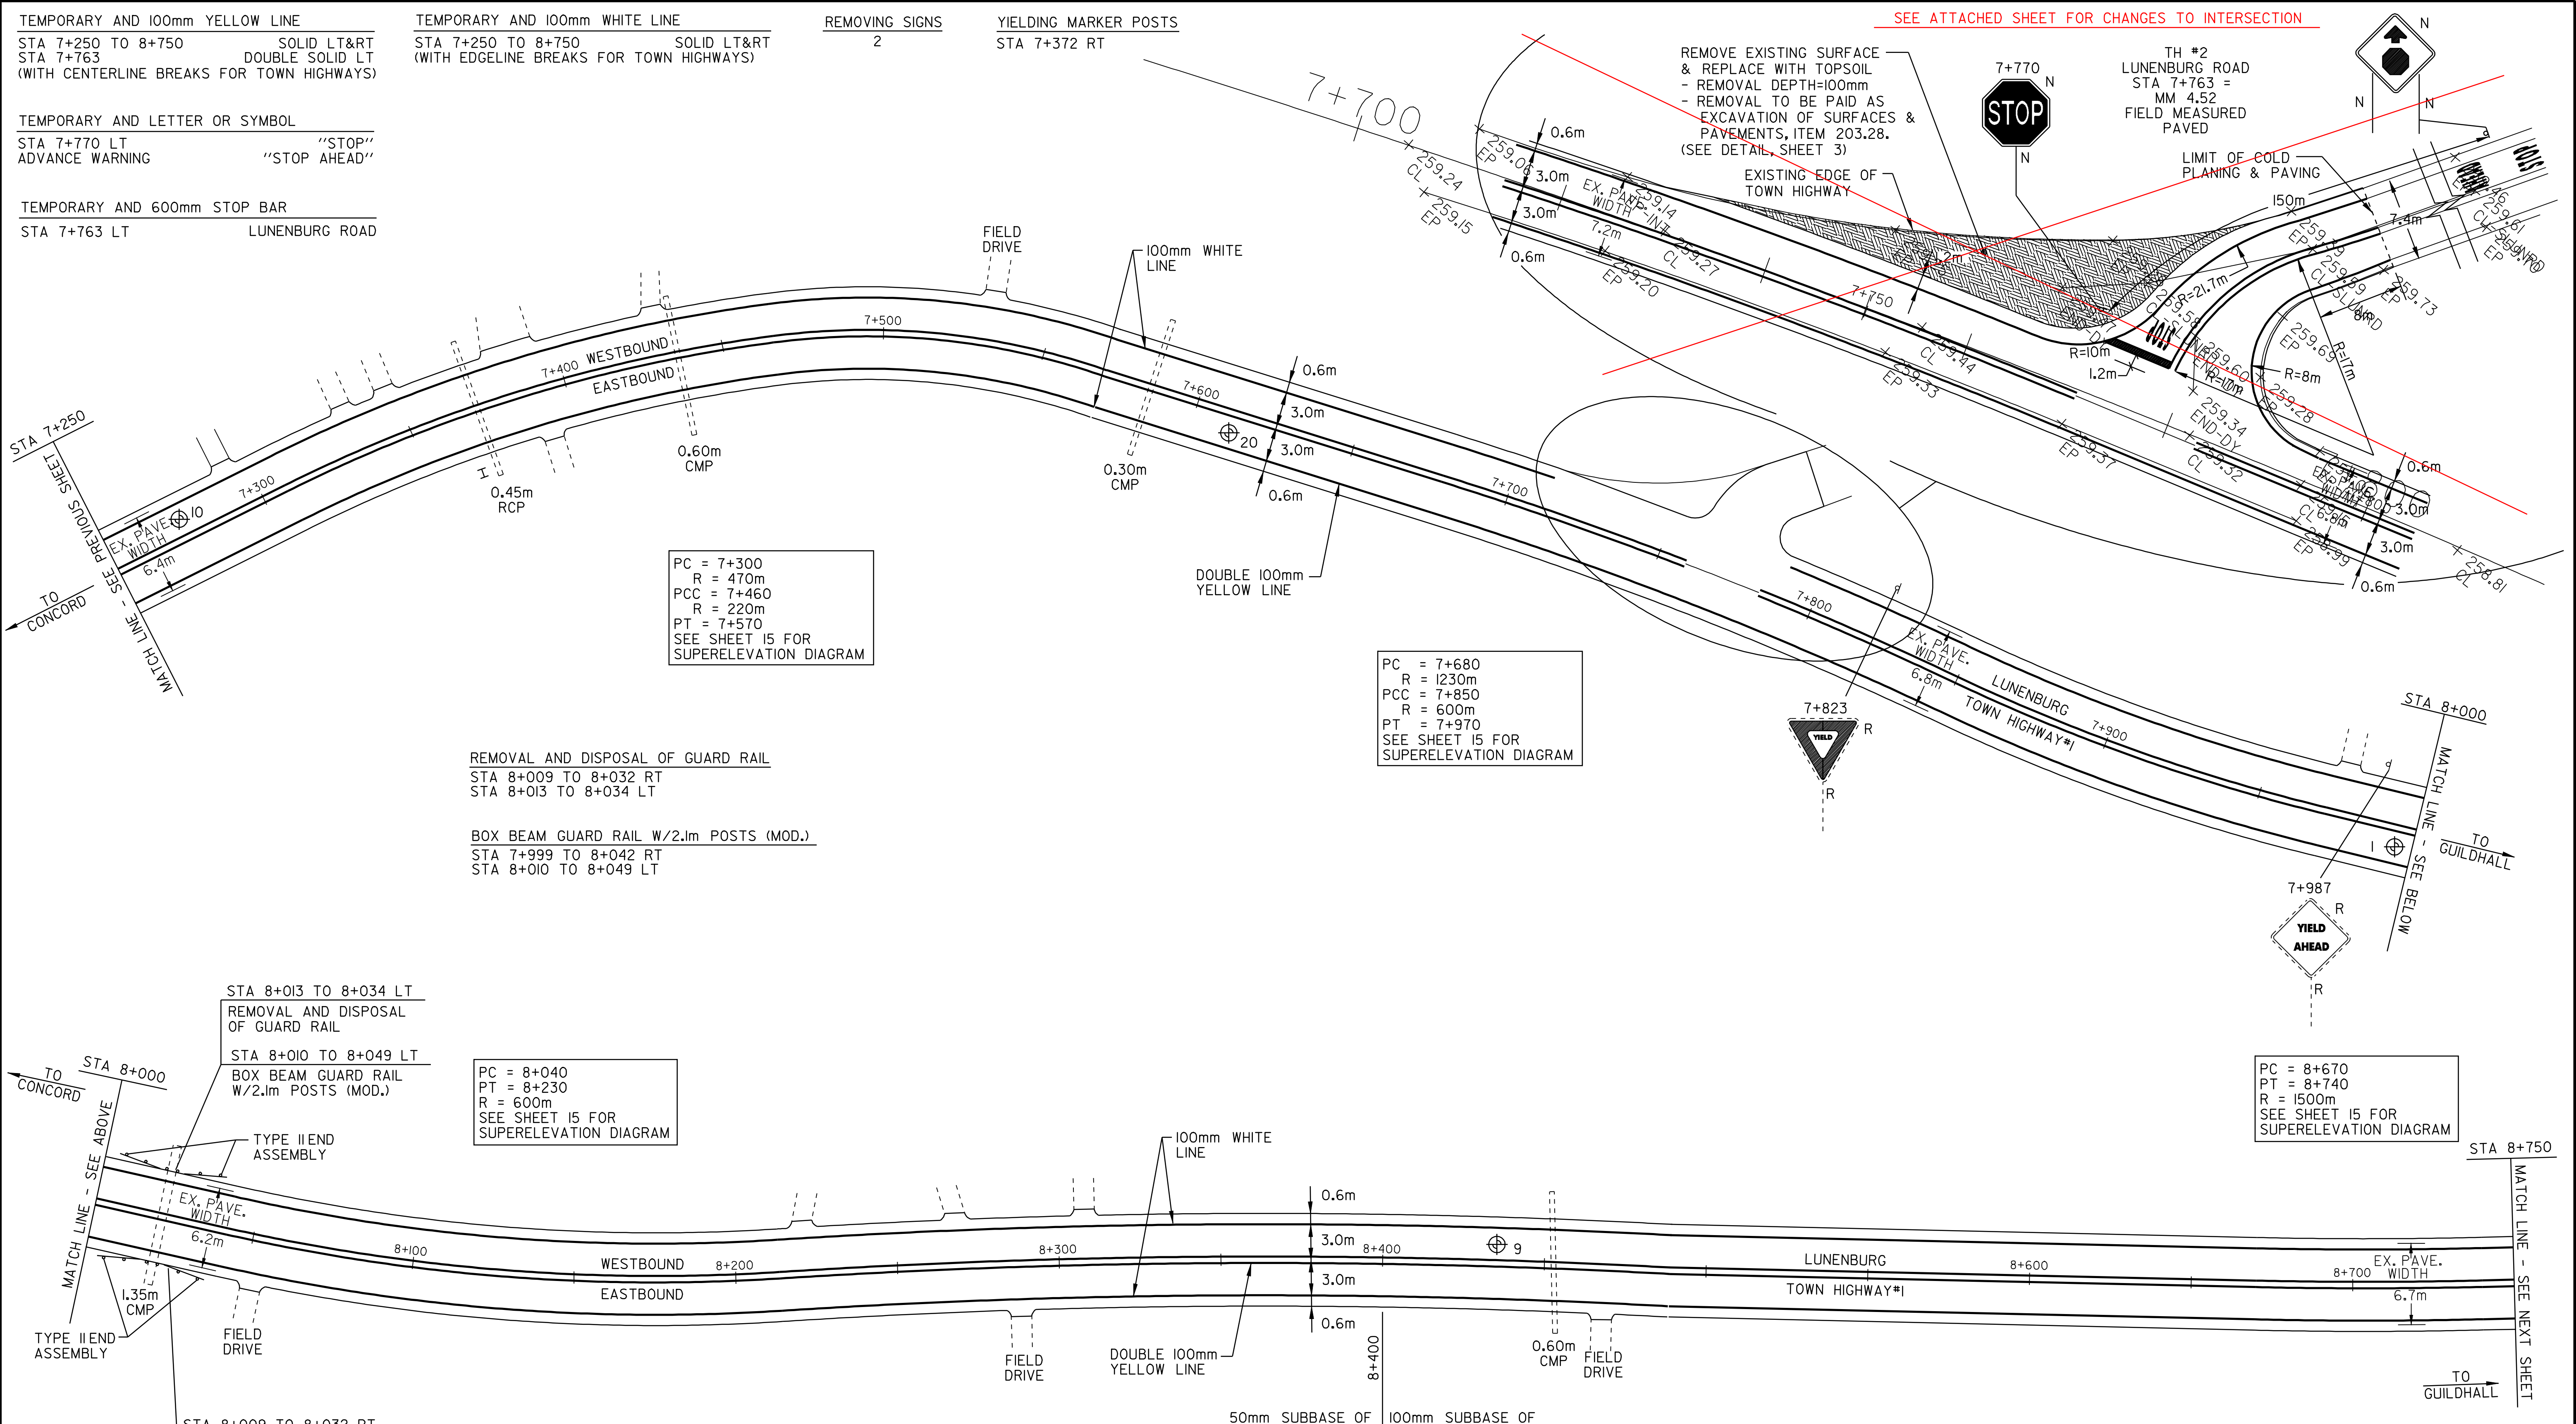

PC = 7+300
 R = 470m
 PCC = 7+460
 R = 220m
 PT = 7+570
 SEE SHEET 15 FOR
 SUPERELEVATION DIAGRAM

PC = 7+680
 R = 1230m
 PCC = 7+850
 R = 600m
 PT = 7+970
 SEE SHEET 15 FOR
 SUPERELEVATION DIAGRAM

REMOVAL AND DISPOSAL OF GUARD RAIL
 STA 8+009 TO 8+032 RT
 STA 8+013 TO 8+034 LT

BOX BEAM GUARD RAIL W/2.1m POSTS (MOD.)
 STA 7+999 TO 8+042 RT
 STA 8+010 TO 8+049 LT

PC = 8+040
 PT = 8+230
 R = 600m
 SEE SHEET 15 FOR
 SUPERELEVATION DIAGRAM

PC = 8+670
 PT = 8+740
 R = 1500m
 SEE SHEET 15 FOR
 SUPERELEVATION DIAGRAM

STA 8+013 TO 8+034 LT
 REMOVAL AND DISPOSAL
 OF GUARD RAIL
 STA 8+010 TO 8+049 LT
 BOX BEAM GUARD RAIL
 W/2.1m POSTS (MOD.)

STA 8+009 TO 8+032 RT
 REMOVAL AND DISPOSAL
 OF GUARD RAIL
 STA 7+999 TO 8+042 RT
 BOX BEAM GUARD RAIL
 W/2.1m POSTS (MOD.)

PAVEMENT CORES - ⊕

* TOTAL DEPTH (mm)	SOLID CORE	STRIPPED	COMMENTS
1	180	NO	BOTTOM OF CORE BROKEN UP
9	240	NO	YES 115mm SOLID
10	65	YES	NO
20	115	NO	1 LAYER 90mm SOLID

NOTE:
 - NO PCC UNDER ANY CORES
 - NO CORES OVER ASPHALTED
 - NO SHOULDER CORES
 - ALL CORES MARKED "NO DRAINABLE BASE"

- LEGEND
- N = NEW
 - R = REMOVE
 - R&S = REMOVE & SALVAGE
 - S = SALVAGE
 - RET = RETAIN
 - B-TO-B = BACK TO BACK
 - ⊕ ⊞ ⊠ CATCH BASIN/DI
 - ⊞ N.W. EXISTING THROAT DI
 - ⊞ CATCH BASIN/DI (NO WORK REQUIRED)
 - ⊙ SEWER MANHOLE
 - ⊙ MARKER POST
 - ⊙ UTILITY POLE
 - ⊙ UTIL. POLE W/UNDERGROUND UTIL.
 - ⊙ DRIVE



PAVING PROJECT LAYOUT # 4

DESIGNED BY	BCE/PJM	DATE	9-01
DRAWN BY	C.E.A., INC.	DATE	9-01
DESIGN FILE NO.	pave/01cl50/pcl50.dgn		
PRF FILE	pcl50p04.i	DATE PLOTTED	10-AUG-2007 14:
PROJ. NAME	LUNENBURG		
PROJ. NO.	STP 2301(7)S		
SHEET	11	OF	20 SHEETS