


TEMPORARY AND 100mm YELLOW LINE
 STA 10+200 TO 11+458 SOLID LT&RT
 STA 11+004 DOUBLE SOLID RT
 (WITH CENTERLINE BREAKS FOR TOWN HIGHWAYS)

TEMPORARY AND LETTER OR SYMBOL
 STA 11+004 RT "STOP"

TEMPORARY AND 600mm STOP BAR
 STA 11+004 RT COVERED BRIDGE ROAD

TEMPORARY AND 100mm WHITE LINE
 STA 10+200 TO 11+458 SOLID LT&RT
 (WITH EDGELINE BREAKS FOR TOWN HIGHWAYS)

REMOVING SIGNS

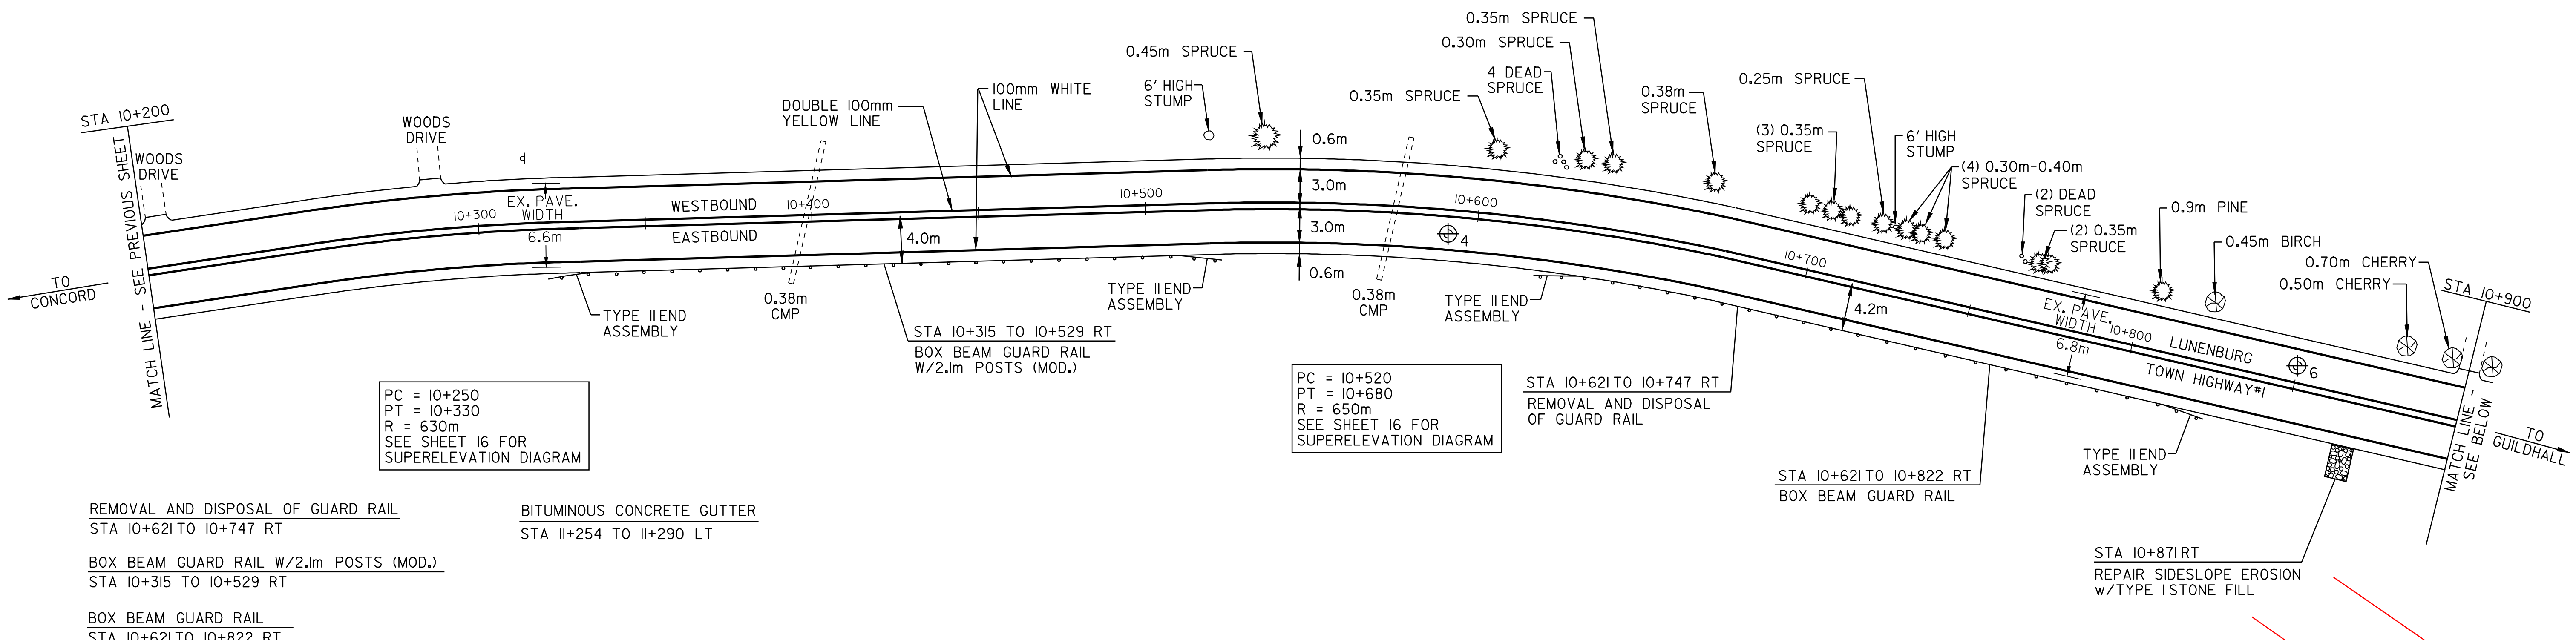

PC = 10+250
 PT = 10+330
 R = 630m
 SEE SHEET 16 FOR SUPERELEVATION DIAGRAM

PC = 10+520
 PT = 10+680
 R = 650m
 SEE SHEET 16 FOR SUPERELEVATION DIAGRAM

REMOVAL AND DISPOSAL OF GUARD RAIL
 STA 10+621 TO 10+747 RT

BOX BEAM GUARD RAIL W/2.1m POSTS (MOD.)
 STA 10+315 TO 10+529 RT

BOX BEAM GUARD RAIL
 STA 10+621 TO 10+822 RT


BITUMINOUS CONCRETE GUTTER
 STA 11+254 TO 11+290 LT

STA 10+621 TO 10+822 RT
 BOX BEAM GUARD RAIL

STA 10+871 RT
 REPAIR SIDESLOPE EROSION
 W/TYPE I STONE FILL


PC = 11+000
 PT = 11+060
 R = 140m
 SEE SHEET 16 FOR SUPERELEVATION DIAGRAM

PC = 11+120
 R = 330m
 PRC = 11+210
 R = 250m
 PT = 11+260
 SEE SHEET 16 FOR SUPERELEVATION DIAGRAM

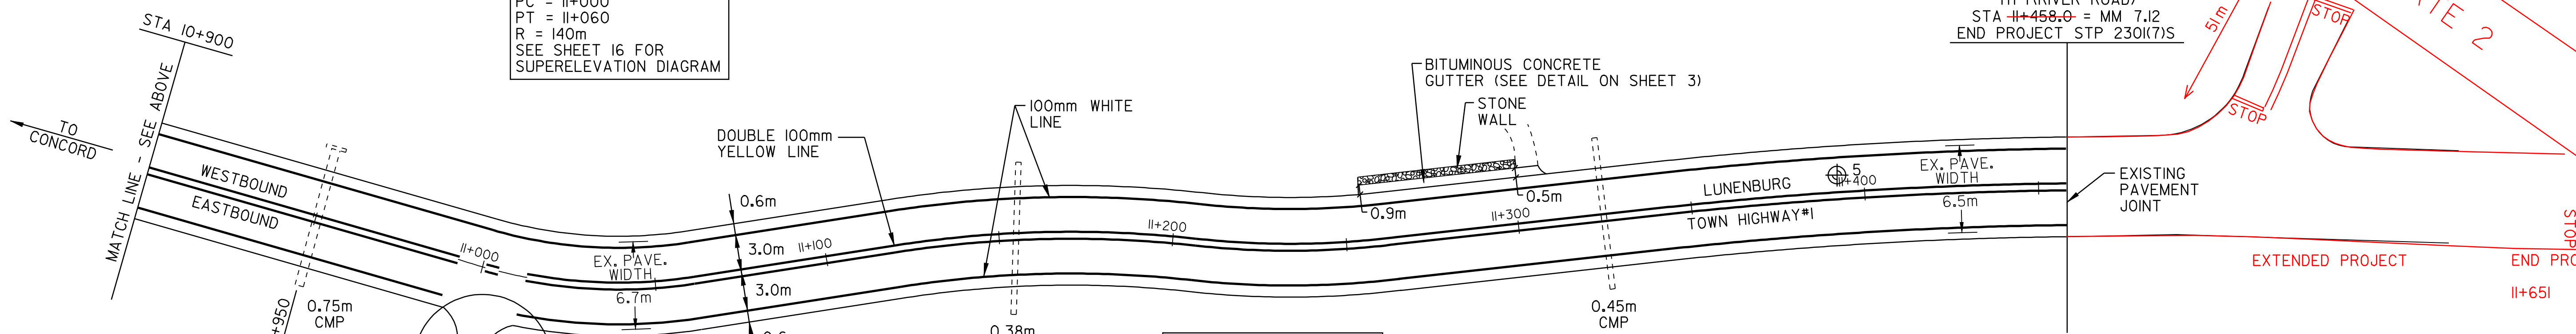

REMOVE EXISTING SURFACE & REPLACE WITH TOPSOIL
 - REMOVAL DEPTH=100mm
 - REMOVAL TO BE PAID AS EXCAVATION OF SURFACES & PAVEMENTS, ITEM 203.28. (SEE DETAIL, SHEET 3)

- LEGEND
- N = NEW
 - R = REMOVE
 - R&S = REMOVE & SALVAGE
 - S = SALVAGE
 - RET = RETAIN
 - B-TO-B = BACK TO BACK
 - ⊕ □ CATCH BASIN/DI
 - EXISTING THROAT DI
 - ⊕ N.W. CATCH BASIN/DI (NO WORK REQUIRED)
 - ⊙ SEWER MANHOLE
 - I MARKER POST
 - ⊗ UTILITY POLE
 - ⊗ UTIL. POLE W/UNDERGROUND UTIL.
 - ⊗ DRIVE

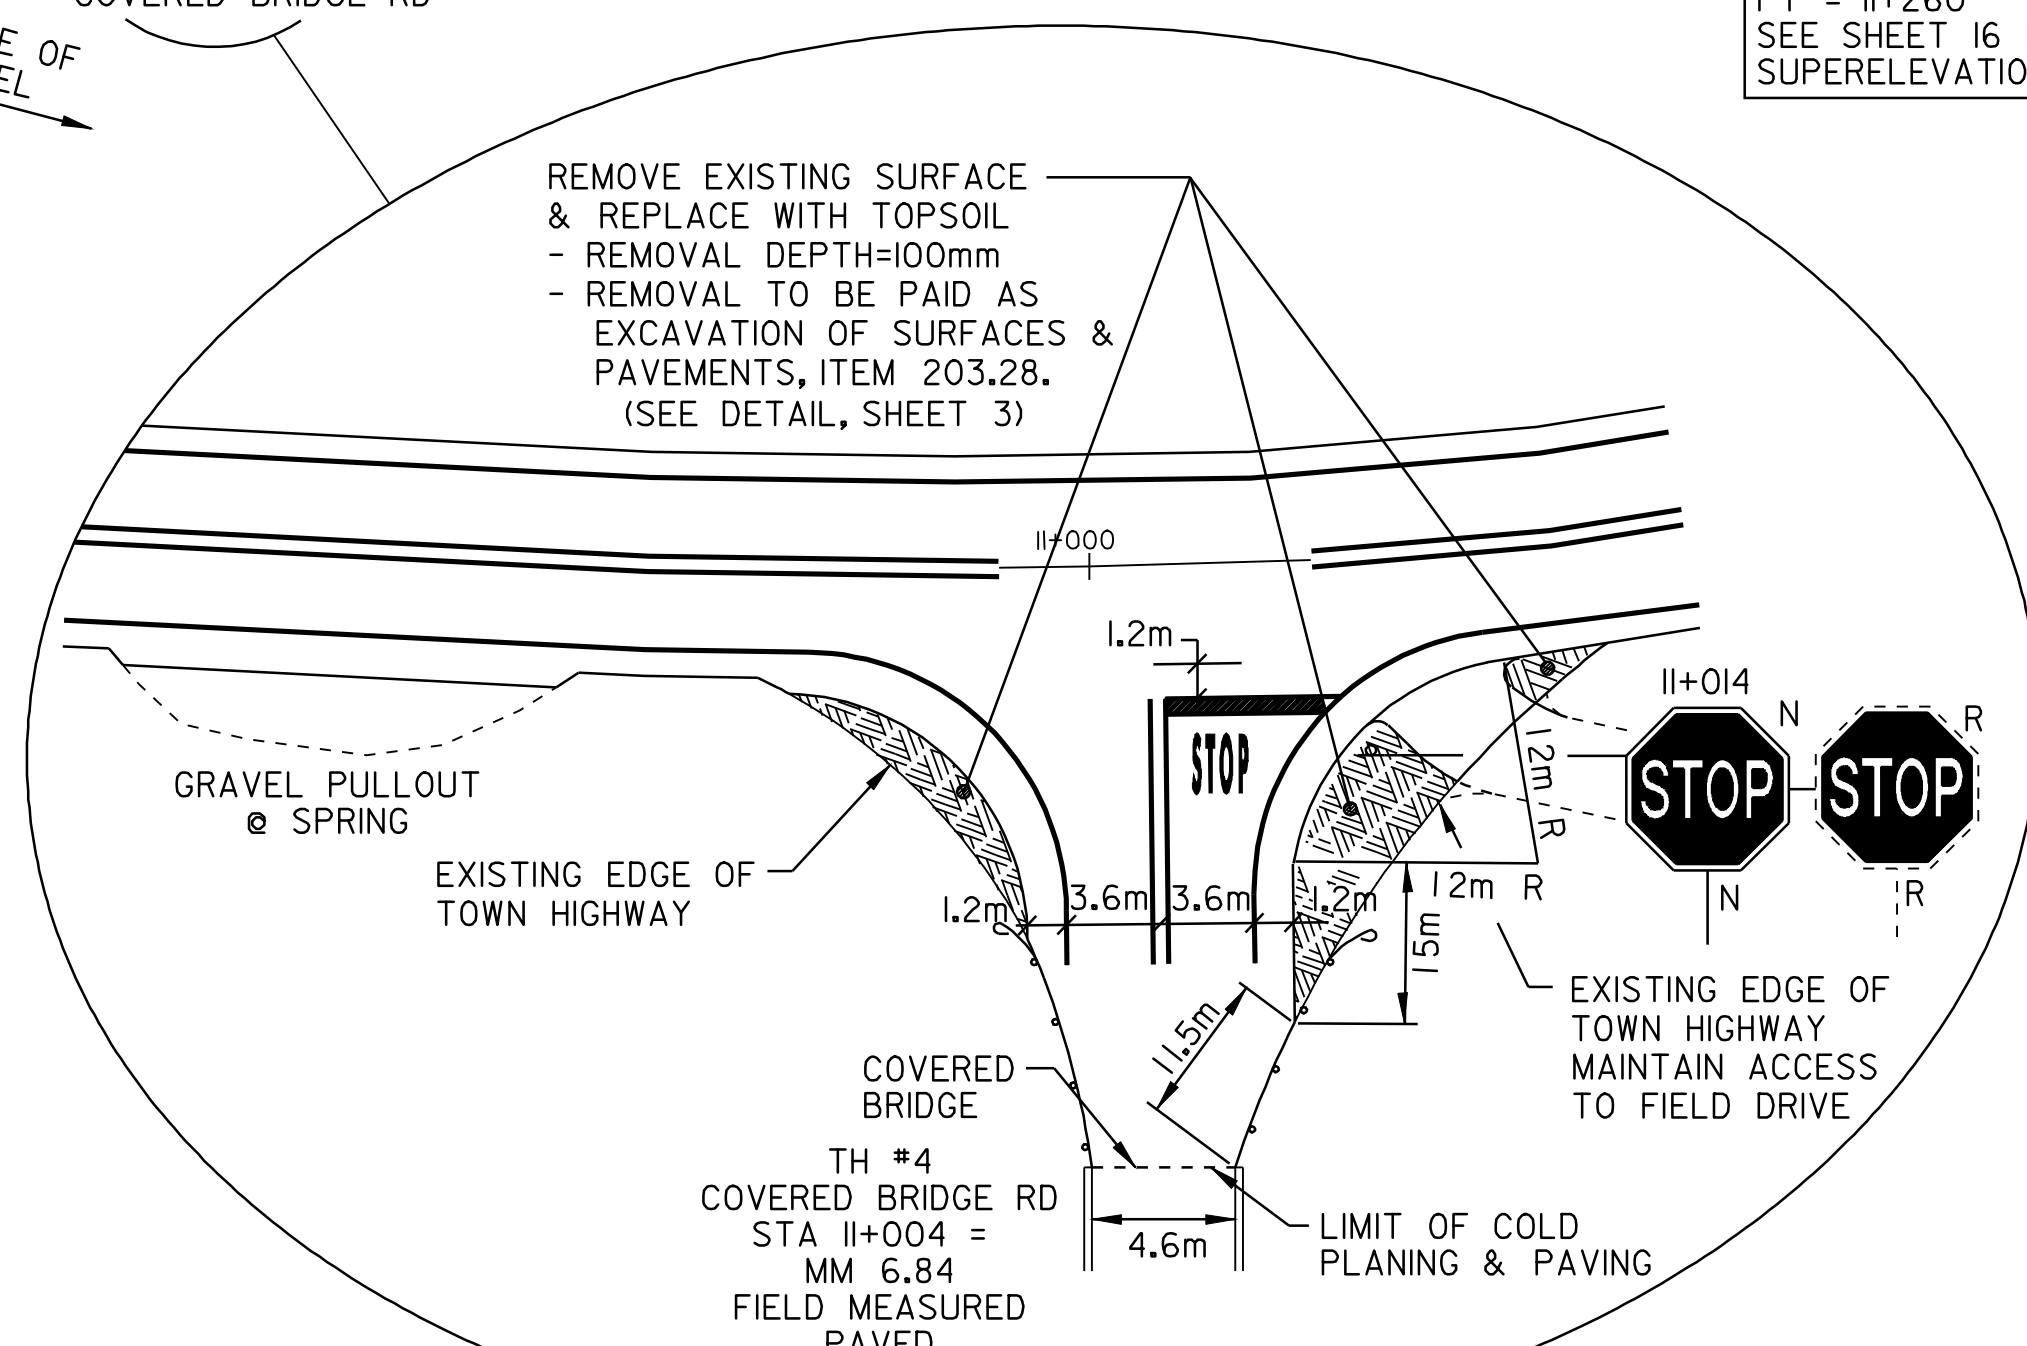

PAVEMENT CORES - ⊕

#	TOTAL DEPTH (mm)	SOLID CORE	STRIPPED	COMMENTS
4	180	NO	YES	125mm OF SOLID CORE
5	230	NO	YES	SOME STRIPPED, 165mm SOLID
6	140	NO	YES	115mm OF SOLID CORE

NOTE:
 - NO PCC UNDER ANY CORES
 - NO CORES OVER ASPHALTED
 - NO SHOULDER CORES
 - ALL CORES MARKED "NO DRAINABLE BASE"



PAVING PROJECT LAYOUT #6

DESIGNED BY BCE/PJM DATE 9-01
 DRAWN BY C.E.A., INC. DATE 9-01
 DESIGN FILE NO. pave/01cl50/pcl50.dgn
 PRF FILE pcl50p06.i DATE PLOTTED 10-AUG-2007 14:
 PROJ. NAME **LUNENBURG**
 PROJ. NO. **STP 2301(7)S**
 SHEET **13** OF **20** SHEETS