


STATE OF VERMONT AGENCY OF TRANSPORTATION



PROPOSED IMPROVEMENT STATEWIDE RAILROAD CROSSINGS (SOUTHERN) COUNTY OF BENNINGTON TOWNS OF NORTH BENNINGTON MANCHESTER SHAFTSBURY TH 3, CL.2 (17-URBAN COLLECTOR) TH 1, CL.1 (16-URBAN MINOR ARTERIAL) TH 4, CL.2 (9-LOCAL ROAD) TH 9, CL.2 (7-RURAL MAJOR COLLECTOR) TH 7, CL.2 (9-LOCAL ROAD)

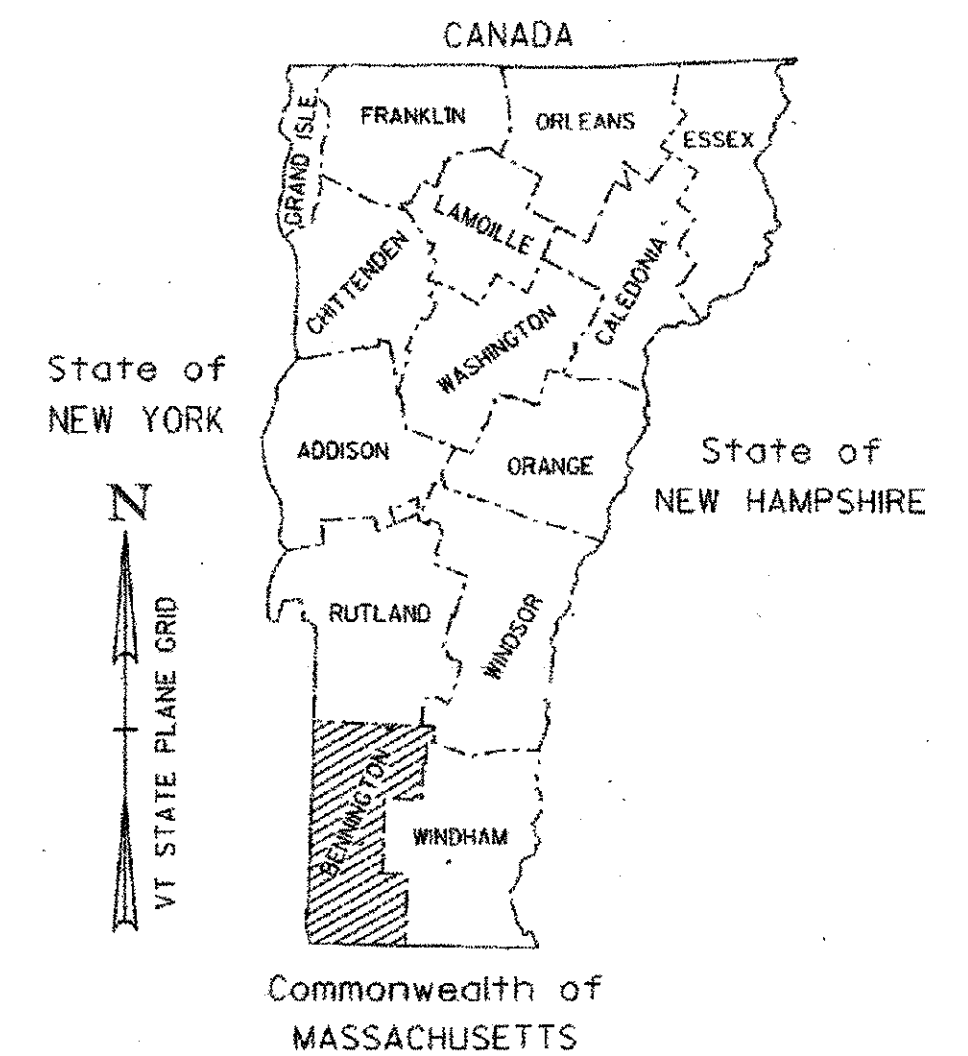

INDEX OF SHEETS

1 COMPOSITE TITLE SHEET
2 COMPOSITE QUANTITY SHEET
3-8 STP 2031 (10) & STP 1200 (4) - BENNINGTON CROSSINGS
9-14 STP 2031 (12) & STP 0170 (12) - MANCHESTER CROSSINGS
15-17 STP 2031 (11) - SHAFTSBURY CROSSING
18-21 CROSSING DETAILS


STANDARDS	DATE
C-1 CURBS, BITUMINOUS CONCRETE SIDEWALKS, ...	JAN. 03, 2000
C-2A PORTLAND CEMENT CONCRETE SIDEWALK DRIVE ...	OCT. 14, 2005
C-2B PORTLAND CEMENT CONCRETE SIDEWALK DRIVE ...	OCT. 14, 2005
C-3A SIDEWALK RAMPS	SEPT. 01, 2004
C-3B SIDEWALK RAMPS AND MEDIAN ISLANDS	SEPT. 01, 2004
D-2 C.R.M. HEADWALLS, UNDERDRAIN, C.R.M. HEADWALLS & ...	JUN. 01, 1994
D-4 FLUSHING BASINS, END SECTION, ELBOWS, ...	JUN. 01, 1994
E-100 CONSTRUCTION APPROACH SIGNS	JAN. 02, 2004
E-100A SIDE ROAD CONSTRUCTION - APPROACH SIGNS	JAN. 02, 2004
E-101 CONSTRUCTION SIGN DETAILS	MAY 30, 2003
E-102 CONSTRUCTION SIGN DETAILS	MAY 01, 2004
E-102A CONSTRUCTION SIGN DETAILS	MAY 01, 2004
E-106 TRAFFIC CONTROL - MISCELLANEOUS DETAILS	MAR. 01, 2004
E-107 DELINEATION, BARRICADES AND DETOURS FOR ...	JUN. 30, 2003
E-107A BREAKAWAY BARRICADE DETAILS	AUG. 08, 1995
E-110 MAJOR MAINTENANCE OPERATION LANE CLOSURE	AUG. 08, 1995
E-111 MINOR MAINTENANCE OPERATION	MAR. 11, 1997
E-121 STANDARD SIGN PLACEMENT - CONVENTIONAL ROAD	AUG. 08, 1995
E-123 GUIDE SIGN PLACEMENT-MISCELLANEOUS DETAILS	MAR. 16, 2004
E-132 GENERAL MOTORIST SERVICE SIGN DETAILS	AUG. 18, 1995
E-146 REGULATORY SIGN DETAILS	SEPT. 20, 1995
E-152 WARNING SIGN DETAILS	MAY 01, 2004
E-153 WARNING SIGN DETAILS	MAY 01, 2004
E-160 FLANGED CHANNEL STEEL SIGN POST	MAY 20, 1999
E-175 POWER DROP STANCHIONS	NOV. 17, 1993
E-190 RAILROAD CROSSING SIGNS AND PAVEMENT MARKINGS	JUN. 30, 2003
E-192 PAVEMENT MARKINGS DETAILS	OCT. 12, 2000
E-193 PAVEMENT MARKINGS DETAILS	AUG. 18, 1995

GENERAL NOTES

- ALL WORK IS TO BE PERFORMED WITHIN THE RAILROAD AND HIGHWAY RIGHT-OF-WAY

CONVENTIONAL SYMBOLS	
COUNTY LINE	
TOWN LINE	
LIMITS OF ACCESS	
POINT OF ACCESS	
FENCE LINE	
STONE WALL	
TRAVELED WAY	
GUARD RAIL	
RAILROAD	
SURVEY LINE	
CULVERT	
POWER POLE	
TELEPHONE POLE	
TREES	
CONTROL OF ACCESS	
PROPERTY LINE	
R.O.W. TAKING LINE	
SLOPE RIGHTS	
TOP OF CUT	
TOE OF SLOPE	

SURVEYED BY :	N/A
SURVEYED DATE :	N/A
DATUM	
VERTICAL	N/A
HORIZONTAL	N/A

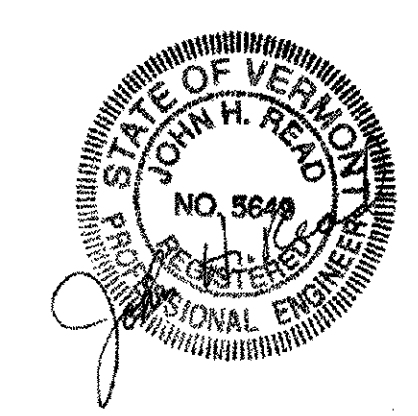

RECORD PLANS

CONTRACTOR: ECI RAIL CONSTRUCTORS, INC. - SO. BURLINGTON, VT

RESIDENT ENGINEER: MARK HAUGHWOUT

CONSTRUCTION BEGAN: JULY 16, 2007

CONSTRUCTION COMPLETE: JANUARY 8, 2008

RECORD PLANS BY: MARK HAUGHWOUT & N GARBACIK

I HEREBY CERTIFY THAT ALL THE CONSTRUCTION REQUIRED BY THIS SET OF DRAWINGS HAS BEEN ACCOMPLISHED AS INDICATED HEREIN.

BY *Mark W. Haughwout* RESIDENT ENGINEER

DATE *10/31/08*

NOTE: Any further information concerning final quantities, amounts or other details relative to this project may be found at Central Files in the electronic archives.

THESE PLANS ARE SUBJECT TO SUCH ENGINEERING CHANGES AS MAY BE REQUIRED BY THE FEDERAL HIGHWAY ADMINISTRATION OR THE DIRECTOR OF PROGRAM DEVELOPMENT.

CONSTRUCTION IS TO BE CARRIED ON IN ACCORDANCE WITH THESE PLANS AND THE STANDARD SPECIFICATIONS FOR CONSTRUCTION DATED 2001, AS APPROVED BY THE FEDERAL HIGHWAY ADMINISTRATION ON JANUARY 4, 2001 FOR USE ON THIS PROJECT, INCLUDING ALL SUBSEQUENT REVISIONS AND SUCH REVISED SPECIFICATIONS AND SPECIAL PROVISIONS AS ARE INCORPORATED IN THESE PLANS.

DIRECTOR OF PROGRAM DEVELOPMENT
APPROVED <i>Robert J. Filante</i> DATE <i>01/08/08</i>
PROJECT MANAGER: JENNIFER ROYER
PROJECT NAME: STATEWIDE RAIL CROSSINGS (SOUTHERN REGION) (RE-ADVERTISED)
SHEET 1 OF 21 SHEETS