

MAIN STREET DETOUR PLAN  
N.T.S.

CONSTRUCTION SIGNS  
TRAFFIC SIGN SUMMARY

IDENTIFI- CATION NUMBER	SIZE OF SIGN WIDTH (IN)	HEIGHT (IN)	TEXT	NUMBER OF SIGNS REQ'D	UNIT AREA SQUARE FEET	AREA IN SQUARE FEET	REMARKS
M1-5	24	24	(67)	49	4	76	
M4-5	24	18	TO	14	5	57	
M4-8	24	12	DETOUR	9	2	18	
M4-8a	24	18	END DETOUR	2	3	6	
M4-9L	30	24	DETOUR ←	3	5	15	
M4-9R	30	24	DETOUR →	6	5	30	
M6-5	24	24	↑	4	8	32	
M4-9SR	30	24	DETOUR ↗	2	5	10	
R11-2	48	30	ROAD CLOSED	2	10	20	MOUNT ON TYPE III MOD. BARRICADE
R11-3A	60	30	ROAD CLOSED X FT AHEAD LOCAL TRAFFIC ONLY	4	12.5	50	MOUNT ON TYPE III MOD. BARRICADE
W20-1	48	48	SIDE ROAD WORK 500 FT	3	16	48	
				TOTAL:		362 SF	

PORTABLE CHANGEABLE MESSAGE SIGN NOTES:  
PORTABLE CHANGEABLE MESSAGE SIGN SHOULD BE LOCATED AND OPERATING ON SITE ONE WEEK PRIOR TO CONSTRUCTION THEY SHOULD BE FIELD LOCATED WITH AT LEAST 0.5 MI OF SIGHT DISTANCE

MESSAGE PRIOR TO CONSTRUCTION (2 PHASES, 3 SEC. PER PHASE)  
FIRST PHASE  
FIRST LINE: VT67 (EW or WB as appropriated)  
SECOND LINE: CLOSED  
THIRD LINE: AT RR


SECOND PHASE  
FIRST LINE: DETOUR  
SECOND LINE: FROM (DATES)  
THIRD LINE: TO (DATES)

MESSAGE DURING CONSTRUCTION (2 PHASES, 3 SEC. PER PHASE)  
FIRST PHASE  
FIRST LINE: VT67 (EW or WB as appropriated)  
SECOND LINE: CLOSED  
THIRD LINE: AT RR

SECOND PHASE  
FIRST LINE: USE  
SECOND LINE: DETOUR  
THIRD LINE: AHEAD

NOTES:

- TEXT LETTER HEIGHT, VERTICAL SPACING, ARROWS, AND SIGN COLORS SHALL CONFORM TO LATEST REVISION OF MANUAL ON UNIFORM TRAFFIC CONTROL DEVICES FOR STREETS AND HIGHWAYS.
- MOUNTING POSTS SHALL BE SELECTED USING VTRANS STANDARD E-100.
- DURING THE CLOSURE, ALL DESTINATION BOARDS AND ROUTE MARKERS THAT ARE IN CONTRADICTION TO THE VT67 DETOUR PLAN MUST BE COVERED.

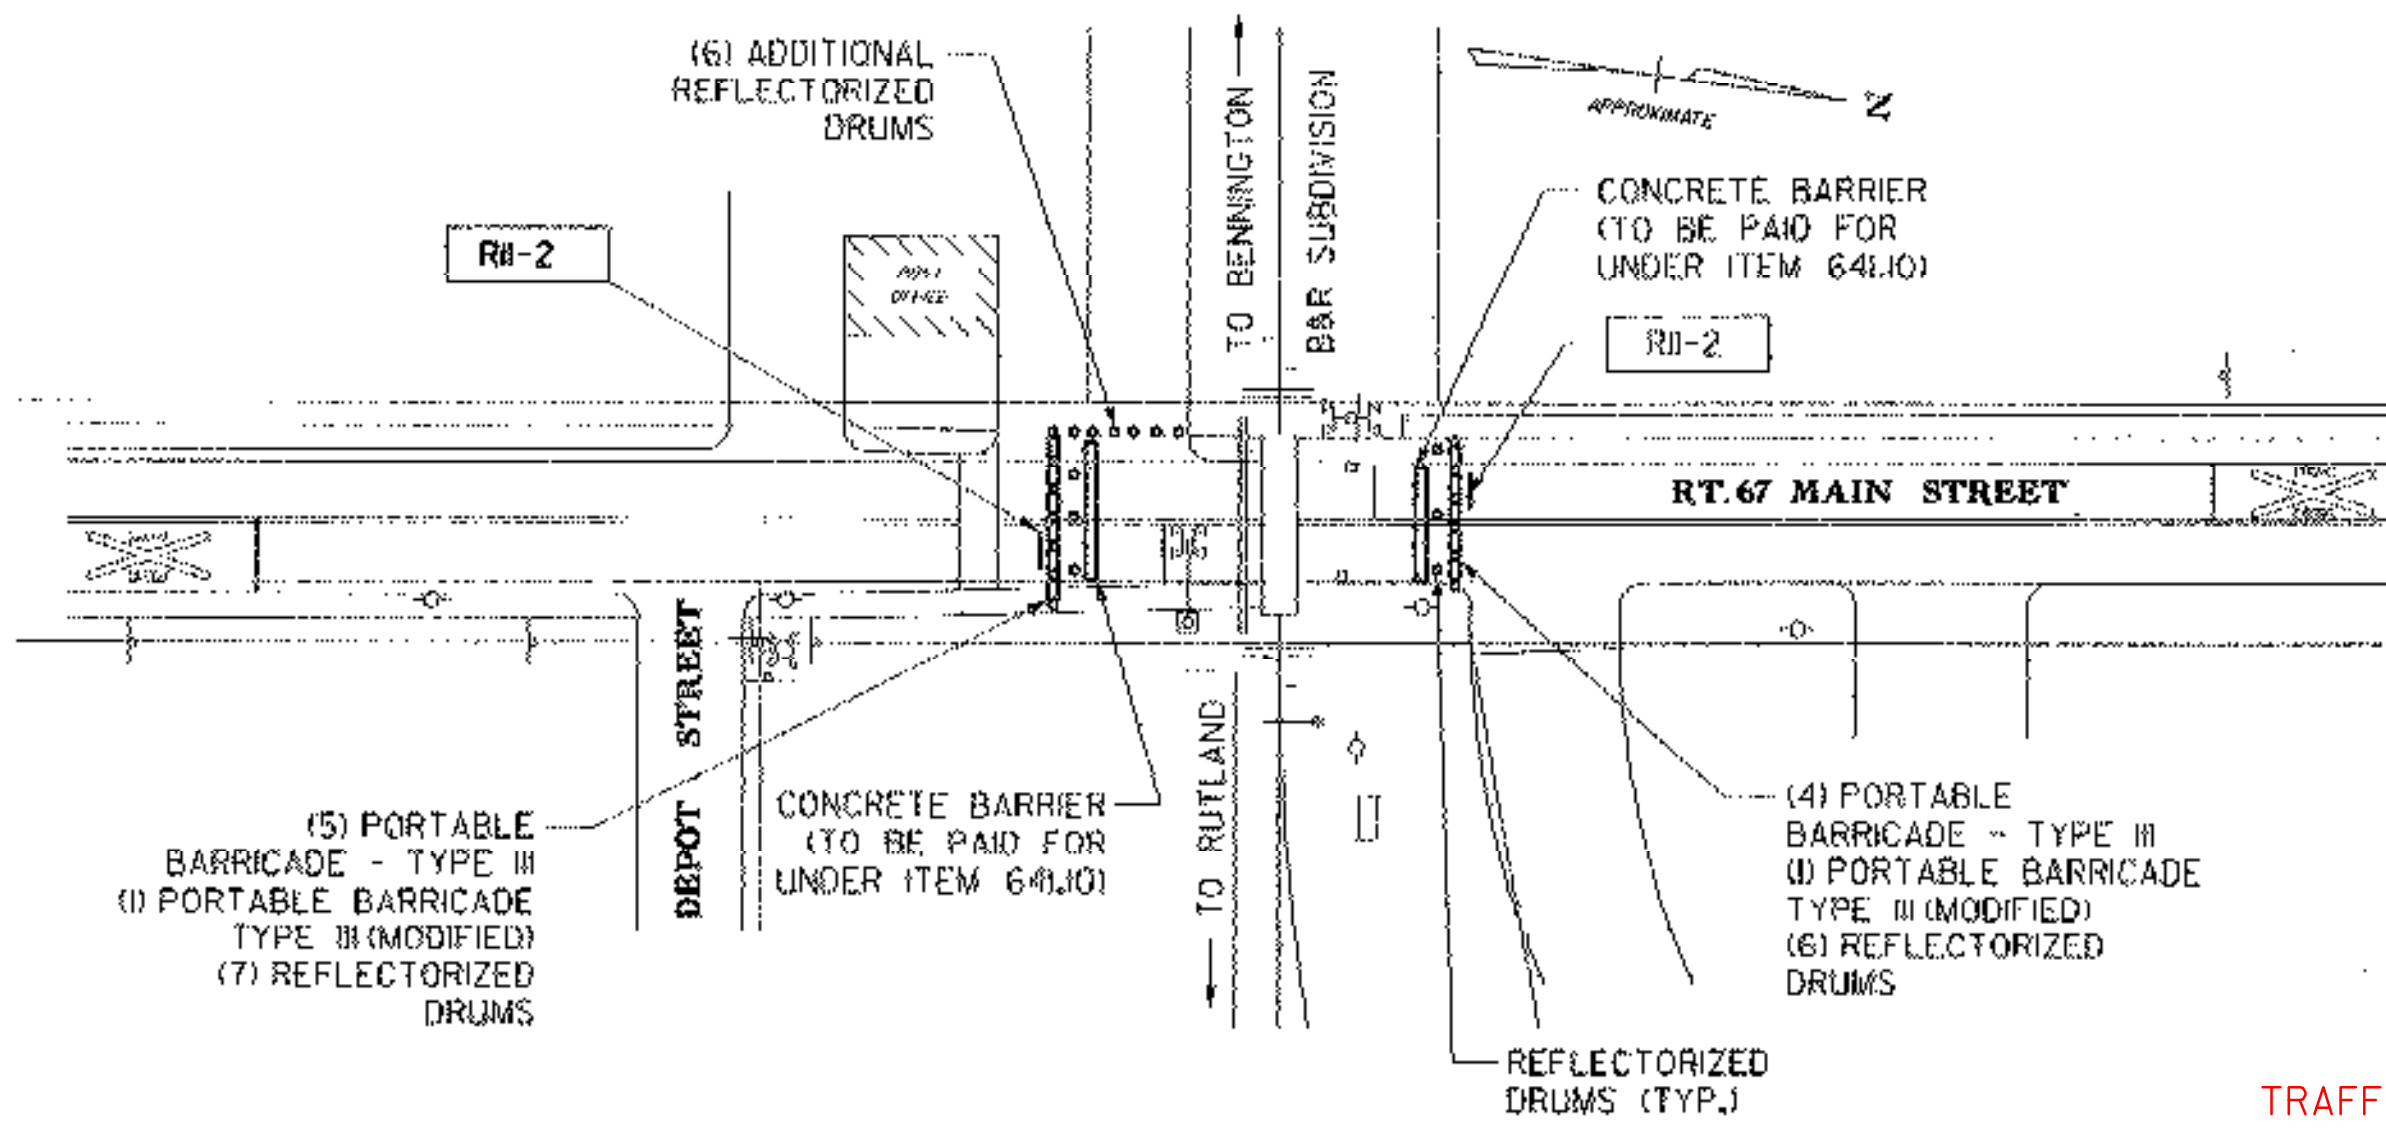

MAIN STREET CLOSURE PLAN  
N.T.S.

TRAFFIC DETOUR MODIFIED PER  
JOE KELLY- TRAFFIC AND SAFETY.

PROJECT NAME:	NORTH BENNINGTON
PROJECT NUMBER:	STP 2031(10); STP 1200(4)
FILE NAME:	Z01G18DETOUR.DGN
PROJECT LEADER:	D. BUA
DESIGNED BY:	ASL
PLOT DATE:	08-MAY 2006
DRAWN BY:	LB
CHECKED BY:	BUA
SHEET	8 OF 21