


**RICHVILLE ROAD DETOUR PLAN**  
 SCALE 0.5 0 0.5 1 MILE

**CONSTRUCTION SIGNS  
 TRAFFIC SIGN SUMMARY**

IDENTIFICATION NUMBER	SIZE OF SIGN WIDTH (IN)	HEIGHT (IN)	TEXT	NUMBER OF SIGNS REQUIRED	UNIT AREA SQUARE FEET	AREA IN SQUARE FEET	REMARKS	
M4-8a	24	18		2	3	6		
M4-9L	30	24		4	5	20		
M4-9R	30	24		5	5	25		
M4-9SL	30	24		1	5	5		
M4-9SR	30	24		1	5	5		
M4-9U	30	24		6	5	30		
R11-2	48	30		2	10	20	MOUNT ON TYPE III (MODIFIED) BARRICADE	
R11-3a	60	30		1	12.5	12.5		
W20-3	48	48		3	16	48		
W16-8	36	12		3	3	9		
SP-1	60	30		3	12.5	37.5		
<b>TOTAL:</b>							<b>288 SF</b>	

- NOTES:**
1. TEXT LETTER HEIGHT, VERTICAL SPACING, ARROWS, AND SIGN COLORS SHALL CONFORM TO LATEST REVISION OF MANUAL ON UNIFORM TRAFFIC CONTROL DEVICES FOR STREETS AND HIGHWAYS.
  2. MOUNTING POSIS SHALL BE SELECTED USING MTRANS STANDARD E-100.

TRAFFIC DETOUR MODIFIED PER  
 JOE KELLY, VAOT TRAFFIC AND SAFETY.

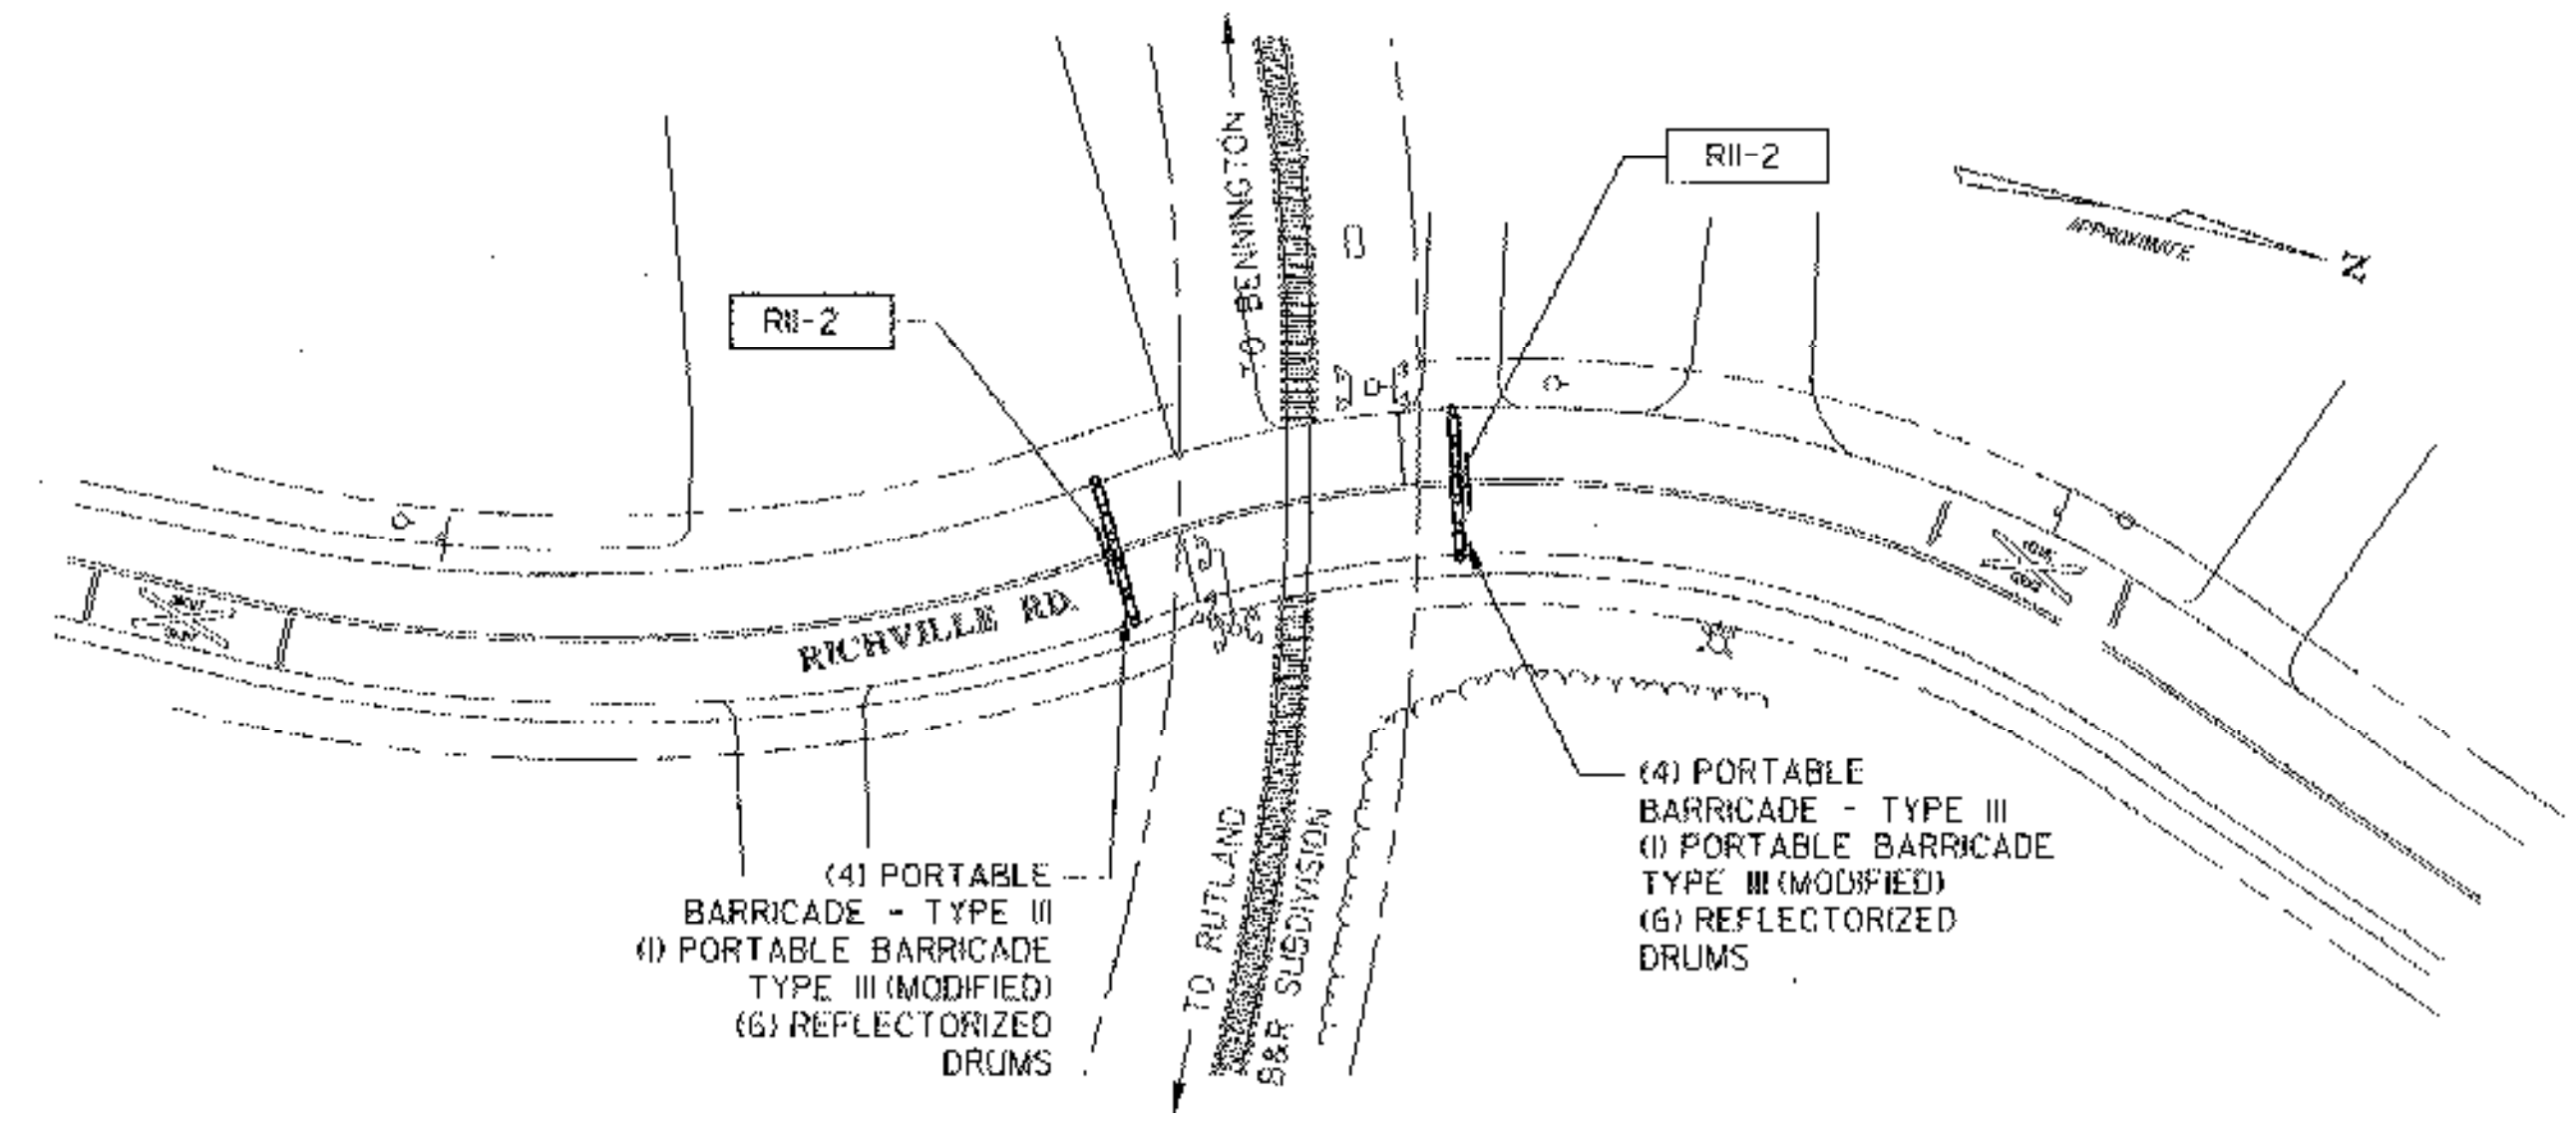

**RICHVILLE ROAD CLOSURE PLAN**  
 NTS

PROJECT NAME:	MANCHESTER	PLOT DATE:	08-MAY-2006
PROJECT NUMBER:	STP 017(12) TH #9	DRAWN BY:	LB
FILE NAME:	20IG86DETOUR.DGN	CHECKED BY:	BUA
PROJECT LEADER:	D. BUA	DESIGNED BY:	ASL
			SHEET 14 OF 21