



# STATE OF VERMONT AGENCY OF TRANSPORTATION

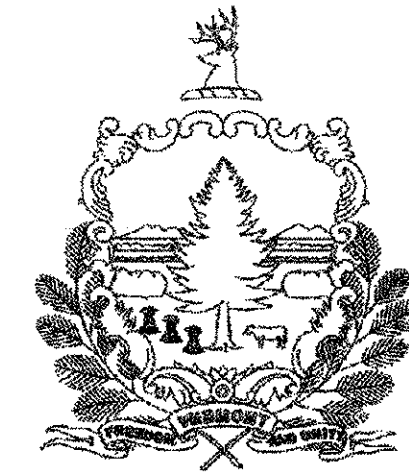

## PROPOSED IMPROVEMENT STATEWIDE RAILROAD CROSSINGS (SOUTHERN) COUNTY OF BENNINGTON TOWNS OF NORTH BENNINGTON MANCHESTER SHAFTSBURY TH 3, CL.2 (17-URBAN COLLECTOR) TH 1, CL.1 (16-URBAN MINOR ARTERIAL) TH 4, CL.2 (9-LOCAL ROAD) TH 9, CL.2 (7-RURAL MAJOR COLLECTOR) TH 7, CL.2 (9-LOCAL ROAD)

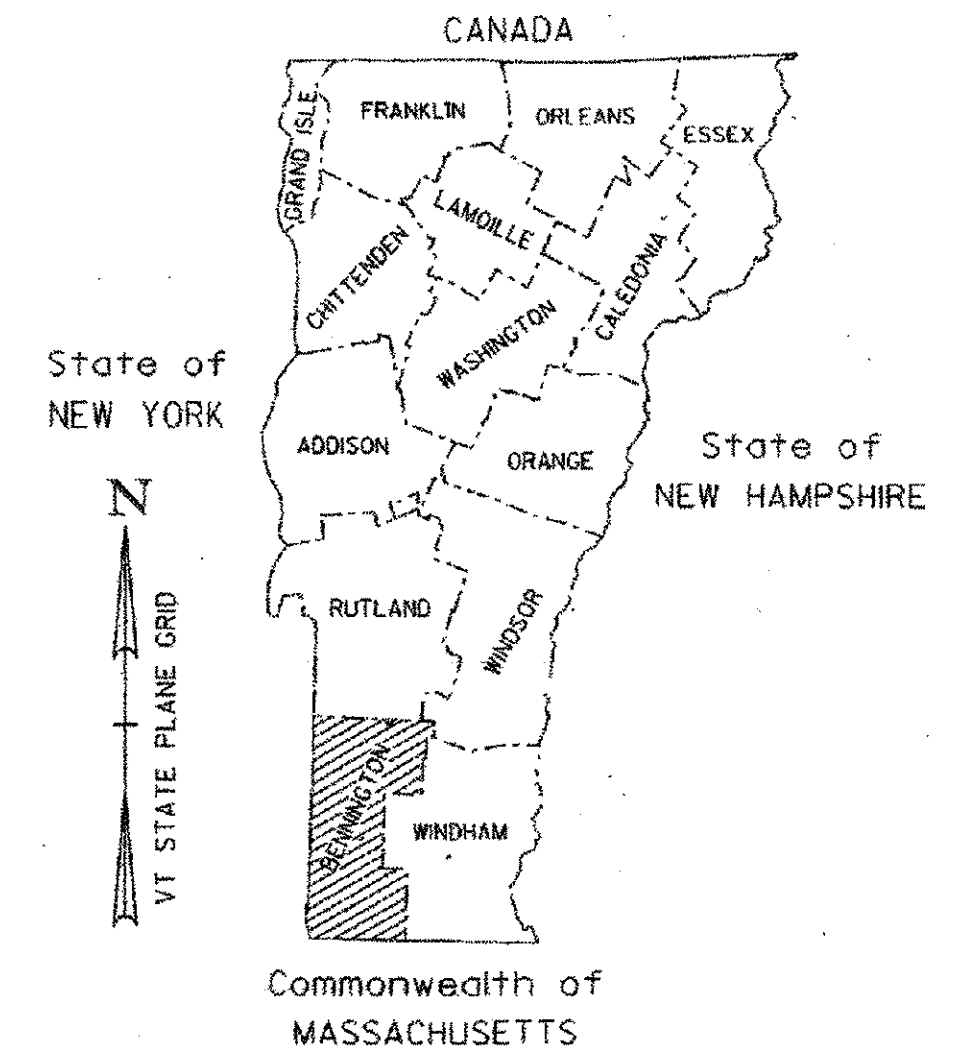

**INDEX OF SHEETS**

1	COMPOSITE TITLE SHEET
2	COMPOSITE QUANTITY SHEET
3-8	STP 2031 (10) & STP 1200 (4) - BENNINGTON CROSSINGS
9-14	STP 2031 (12) & STP 0170 (12) - MANCHESTER CROSSINGS
15-17	STP 2031 (11) - SHAFTSBURY CROSSING
18-21	CROSSING DETAILS

STANDARDS	DATE	
C-1	CURBS, BITUMINOUS CONCRETE SIDEWALKS, ...	JAN. 03, 2000
C-2A	PORTLAND CEMENT CONCRETE SIDEWALK DRIVE ...	OCT. 14, 2005
C-2B	PORTLAND CEMENT CONCRETE SIDEWALK DRIVE ...	OCT. 14, 2005
C-3A	SIDEWALK RAMPS	SEPT. 01, 2004
C-3B	SIDEWALK RAMPS AND MEDIAN ISLANDS	SEPT. 01, 2004
D-2	C.R.M. HEADWALLS, UNDERDRAIN, C.R.M. HEADWALLS & ...	JUN. 01, 1994
D-4	FLUSHING BASINS, END SECTION, ELBOWS, ...	JUN. 01, 1994
E-100	CONSTRUCTION APPROACH SIGNS	JAN. 02, 2004
E-100A	SIDE ROAD CONSTRUCTION - APPROACH SIGNS	JAN. 02, 2004
E-101	CONSTRUCTION SIGN DETAILS	MAY 30, 2003
E-102	CONSTRUCTION SIGN DETAILS	MAY 01, 2004
E-102A	CONSTRUCTION SIGN DETAILS	MAY 01, 2004
E-106	TRAFFIC CONTROL - MISCELLANEOUS DETAILS	MAR. 01, 2004
E-107	DELINEATION, BARRICADES AND DETOURS FOR ...	JUN. 30, 2003
E-107A	BREAKAWAY BARRICADE DETAILS	AUG. 08, 1995
E-110	MAJOR MAINTENANCE OPERATION LANE CLOSURE	AUG. 08, 1995
E-111	MINOR MAINTENANCE OPERATION	MAR. 11, 1997
E-121	STANDARD SIGN PLACEMENT - CONVENTIONAL ROAD	AUG. 08, 1995
E-123	GUIDE SIGN PLACEMENT-MISCELLANEOUS DETAILS	MAR. 16, 2004
E-132	GENERAL MOTORIST SERVICE SIGN DETAILS	AUG. 18, 1995
E-146	REGULATORY SIGN DETAILS	SEPT. 20, 1995
E-152	WARNING SIGN DETAILS	MAY 01, 2004
E-153	WARNING SIGN DETAILS	MAY 01, 2004
E-160	FLANGED CHANNEL STEEL SIGN POST	MAY 20, 1999
E-175	POWER DROP STANCHIONS	NOV. 17, 1993
E-190	RAILROAD CROSSING SIGNS AND PAVEMENT MARKINGS	JUN. 30, 2003
E-192	PAVEMENT MARKINGS DETAILS	OCT. 12, 2000
E-193	PAVEMENT MARKINGS DETAILS	AUG. 18, 1995

**GENERAL NOTES**

- ALL WORK IS TO BE PERFORMED WITHIN THE RAILROAD AND HIGHWAY RIGHT-OF-WAY

CONVENTIONAL SYMBOLS	
COUNTY LINE	
TOWN LINE	
LIMITS OF ACCESS	
POINT OF ACCESS	
FENCE LINE	
STONE WALL	
TRAVELED WAY	
GUARD RAIL	
RAILROAD	
SURVEY LINE	
CULVERT	
POWER POLE	
TELEPHONE POLE	
TREES	
CONTROL OF ACCESS	
PROPERTY LINE	
R.O.W. TAKING LINE	
SLOPE RIGHTS	
TOP OF CUT	
TOE OF SLOPE	


SURVEYED BY :	N/A
SURVEYED DATE :	N/A
DATUM	
VERTICAL	N/A
HORIZONTAL	N/A



RECORD PLANS	
CONTRACTOR:	ECI RAIL CONSTRUCTORS, INC. - SO. BURLINGTON, VT
RESIDENT ENGINEER:	MARK HAUGHWOUT
CONSTRUCTION BEGAN:	JULY 16, 2007
CONSTRUCTION COMPLETE:	JANUARY 8, 2008
RECORD PLANS BY:	MARK HAUGHWOUT & N GARBACIK
I HEREBY CERTIFY THAT ALL THE CONSTRUCTION REQUIRED BY THIS SET OF DRAWINGS HAS BEEN ACCOMPLISHED AS INDICATED HEREIN.	
BY:	<i>Mark W. Haughwout</i> RESIDENT ENGINEER
DATE:	10/31/08
NOTE: Any further information concerning final quantities, amounts or other details relative to this project may be found at Central Files in the electronic archives.	

THESE PLANS ARE SUBJECT TO SUCH ENGINEERING CHANGES AS MAY BE REQUIRED BY THE FEDERAL HIGHWAY ADMINISTRATION OR THE DIRECTOR OF PROGRAM DEVELOPMENT.

CONSTRUCTION IS TO BE CARRIED ON IN ACCORDANCE WITH THESE PLANS AND THE STANDARD SPECIFICATIONS FOR CONSTRUCTION DATED 2001, AS APPROVED BY THE FEDERAL HIGHWAY ADMINISTRATION ON JANUARY 4, 2001 FOR USE ON THIS PROJECT, INCLUDING ALL SUBSEQUENT REVISIONS AND SUCH REVISED SPECIFICATIONS AND SPECIAL PROVISIONS AS ARE INCORPORATED IN THESE PLANS.

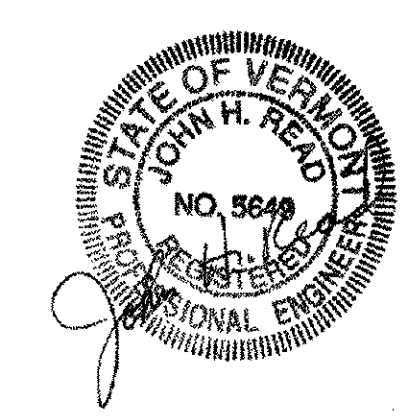

DIRECTOR OF PROGRAM DEVELOPMENT	APPROVED: <i>Richard J. Filante</i> DATE: <i>01/08/08</i>
PROJECT MANAGER:	JENNIFER ROYER
PROJECT NAME:	STATEWIDE RAIL XING SOUTHERN REGION (RE-ADVERTISED)
SHEET 1 OF 21 SHEETS	

# QUANTITY SHEET

SUMMARY OF ESTIMATED QUANTITIES													TOTALS			DESCRIPTIONS		DETAILED SUMMARY OF QUANTITIES			
													ROUND	GRAND TOTAL	FINAL	UNIT	ITEMS	ITEM NUMBER	QUANTITIES	UNIT	ITEMS
														40		HR	UNIFORMED TRAFFIC OFFICERS	630.10			
														40		HR	FLAGGERS	630.15			
														128		HR	FLAGGERS (MOD. - RAILROAD)	630.15			
														1		LS	FIELD OFFICE-ENGINEERS	631.10			
														1		LS	MOBILIZATION / DEMOBILIZATION	635.11			
														1		LS	TRAFFIC CONTROL (BANK STREET - AARDOT 851-164P)	641.10			
														1		LS	TRAFFIC CONTROL (MAIN STREET - AARDOT 851-165W)	641.10			
														1		LS	TRAFFIC CONTROL (UNION STREET - AARDOT 851-189R)	641.10			
														1		LS	TRAFFIC CONTROL (RICHVILLE ROAD - AARDOT 851-200H)	641.10			
														1		LS	TRAFFIC CONTROL (AIRPORT ROAD - 851-173N)	641.10			
														1		LS	PUBLIC RELATIONS OFFICER	641.12			
														3		EACH	PORTABLE CHANGEABLE MESSAGE SIGN	641.15			
														1235		LF	4" WHITE LINE	646.20			
														5150		LF	4" YELLOW LINE	646.21			
														104		LF	8" WHITE LINE	646.22			
														120		LF	24" STOP BAR	646.26			
														8		EACH	RAILROAD CROSSING SYMBOL	646.32			
														1470		SF	REMOVAL OF EXISTING PAVEMENT MARKINGS	646.85			
														120		SF	TRAFFIC SIGNS, TYPE A	675.20			
														274		LF	FLANGED CHANNEL SIGN POST	675.301			
														15		LF	SQUARE TUBE SIGN POSTS AND ANCHOR	675.341			
														13		EACH	REMOVING SIGNS	675.50			
														3		EACH	ERECTING SALVAGED SIGNS	675.80			
														50		EACH	REMOVAL AND REPLACEMENT OF CROSS TIES	901.10			
														1		LS	FLASHING LIGHT SIGNALS (BANK STREET - AARDOT 851-164P)	915.15			
														1		LS	FLASHING LIGHT SIGNALS (MAIN STREET - AARDOT 851-165W)	915.15			
														1		LS	FLASHING LIGHT SIGNALS (UNION STREET - AARDOT 851-189R)	915.15			
														1		LS	FLASHING LIGHT SIGNALS (RICHVILLE ROAD - AARDOT 851-200H)	915.15			
														1		LS	FLASHING LIGHT SIGNALS (AIRPORT ROAD - 851-173N)	915.15			
														1		LS	FLASHING LIGHT SIGNALS (MOD. - TEST TRAIN ALLOWANCE (NABI))	915.15			
														1		LS	RECONSTRUCT RAIL-HIGHWAY CROSSING (MAIN STREET - AARDOT 851-165W)	935.20			
														1		LS	RECONSTRUCT RAIL-HIGHWAY CROSSING (RICHVILLE ROAD - AARDOT 851-200H)	935.20			

**INDEX OF SHEETS**

3	TITLE SHEET
4	STP 2031 (10) - PLAN - BANK STREET
5	STP 2031 (10) - TRAFFIC SIGN SUMMARY SHEET
6	STP 1200 (4) - PLAN - MAIN STREET
7	STP 1200 (4) - TRAFFIC SIGN SUMMARY SHEET
8	STP 1200 (4) - MAIN STREET DETOUR PLAN

STANDARDS	DATE	
C-1	CURBS, BITUMINOUS CONCRETE SIDEWALKS, GRANITE ...	JAN. 03, 2000
C-2A	PORTLAND CEMENT CONCRETE SIDEWALK DRIVE ...	OCT. 14, 2005
C-2B	PORTLAND CEMENT CONCRETE SIDEWALK DRIVE ...	OCT. 14, 2005
C-3A	SIDEWALK RAMPS	SEPT. 01, 2004
C-3B	SIDEWALK RAMPS AND MEDIAN ISLANDS	SEPT. 01, 2004
D-2	CEMENT RUBBLE MASONRY HEADWALLS & RETAINING ...	JUN. 01, 1994
D-4	FLUSHING BASINS, END SECTION, ELBOWS, ...	JUN. 01, 1994
E-100	CONSTRUCTION APPROACH SIGNS	JAN. 02, 2004
E-100A	SIDE ROAD CONSTRUCTION - APPROACH SIGNS	JAN. 02, 2004
E-101	CONSTRUCTION SIGN DETAILS	MAY 30, 2003
E-102	CONSTRUCTION SIGN DETAILS	JUN. 30, 2003
E-102A	CONSTRUCTION SIGN DETAILS	MAY. 01, 2004
E-106	TRAFFIC CONTROL - MISCELLANEOUS DETAILS	MAR. 01, 2004
E-107	DELINEATION, BARRICADES AND DETOURS FOR U-TURNS ...	JUN. 30, 2003
E-107A	BREAKAWAY BARRICADE DETAILS	AUG. 08, 1995
E-110	MAJOR MAINTENANCE OPERATION LANE CLOSURE	AUG. 08, 1995
E-111	MINOR MAINTENANCE OPERATION	MAR. 11, 1997
E-121	STANDARD SIGN PLACEMENT - CONVENTIONAL ROAD	AUG. 08, 1995
E-123	GUIDE SIGN PLACEMENT - MISCELLANEOUS DETAILS	MAR. 16, 2004
E-132	GENERAL MOTORIST SERVICE SIGN DETAILS	AUG. 10, 1995
E-152	WARNING SIGN DETAILS	MAY 01, 2004
E-160	FLANGED CHANNEL STEEL SIGN POST	MAY 20, 1999
E-175	POWER DRUP STANCHIONS	NOV. 17, 1993
E-190	RAILROAD CROSSING SIGNS AND PAVEMENT MARKINGS	JUN. 30, 2003
E-192	PAVEMENT MARKINGS DETAILS	OCT. 12, 2000
E-193	PAVEMENT MARKINGS DETAILS	AUG. 10, 1995

**GENERAL NOTES**


- ALL WORK IS TO BE PERFORMED WITHIN THE RAILROAD AND HIGHWAY RIGHT-OF-WAY

**CONVENTIONAL SYMBOLS**

COUNTY LINE	— — — — —
TOWN LINE	— — — — —
LIMITS OF ACCESS	— — — — —
POINT OF ACCESS	X
FENCE LINE	X — — — — — X
STONE WALL	○ ○ ○ ○ ○
TRAVELLED WAY	— — — — —
GUARD RAIL	— — — — —
RAILROAD	— — — — —
SURVEY LINE	— — — — —
CULVERT	— — — — —
POWER POLE	⊕
TELEPHONE POLE	⊕
TREES	⊕
CONTROL OF ACCESS	— — — — —
PROPERTY LINE	— — — — —
R.O.W. TAKING LINE	— — — — —
SLOPE RIGHTS	— — — — —
TOP OF CUT	— — — — —
TOE OF SLOPE	— — — — —

SURVEYED BY : N/A  
 SURVEYED DATE : N/A  
 DATUM  
 VERTICAL : N/A  
 HORIZONTAL : N/A

**Transystems Corporation**  
 ONE CABOT ROAD, MEDFORD MA 02155 (811) 396-1775

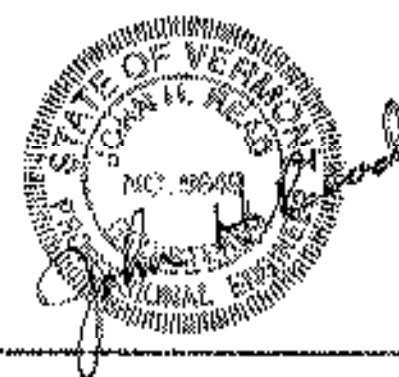

STATE OF VERMONT  
 AGENCY OF TRANSPORTATION





PROPOSED IMPROVEMENT  
 COUNTY OF BENNINGTON  
 TOWN OF NORTH BENNINGTON  
 TH 3, CL. 2 (17-URBAN COLLECTOR)

NORTH BENNINGTON; STP 2031 (10); PPMS 01G158  
 VERMONT RAILWAY CROSSING 851-164P - BANK STREET  
 WORK TO BE PERFORMED UNDER THIS PROJECT WILL INCLUDE THE RECONSTRUCTION OF RR CROSSING SIGNAL SYSTEM INCLUDING NEW SIGNALS, PAVEMENT MARKINGS, AND SIGNAGE.

TH 1, CL. 1 (16-URBAN MINOR ARTERIAL)

NORTH BENNINGTON; STP 1200 (4); PPMS 01G160  
 VERMONT RAILWAY CROSSING 851-165W - MAIN STREET  
 WORK TO BE PERFORMED UNDER THIS PROJECT WILL INCLUDE THE RECONSTRUCTION RR CROSSING SURFACE AND SIGNAL SYSTEM INCLUDING UNDERDRAINS, BALLAST, TRACK, CROSSING SURFACE, SIGNALS, PAVEMENT MARKINGS, AND SIGNAGE.

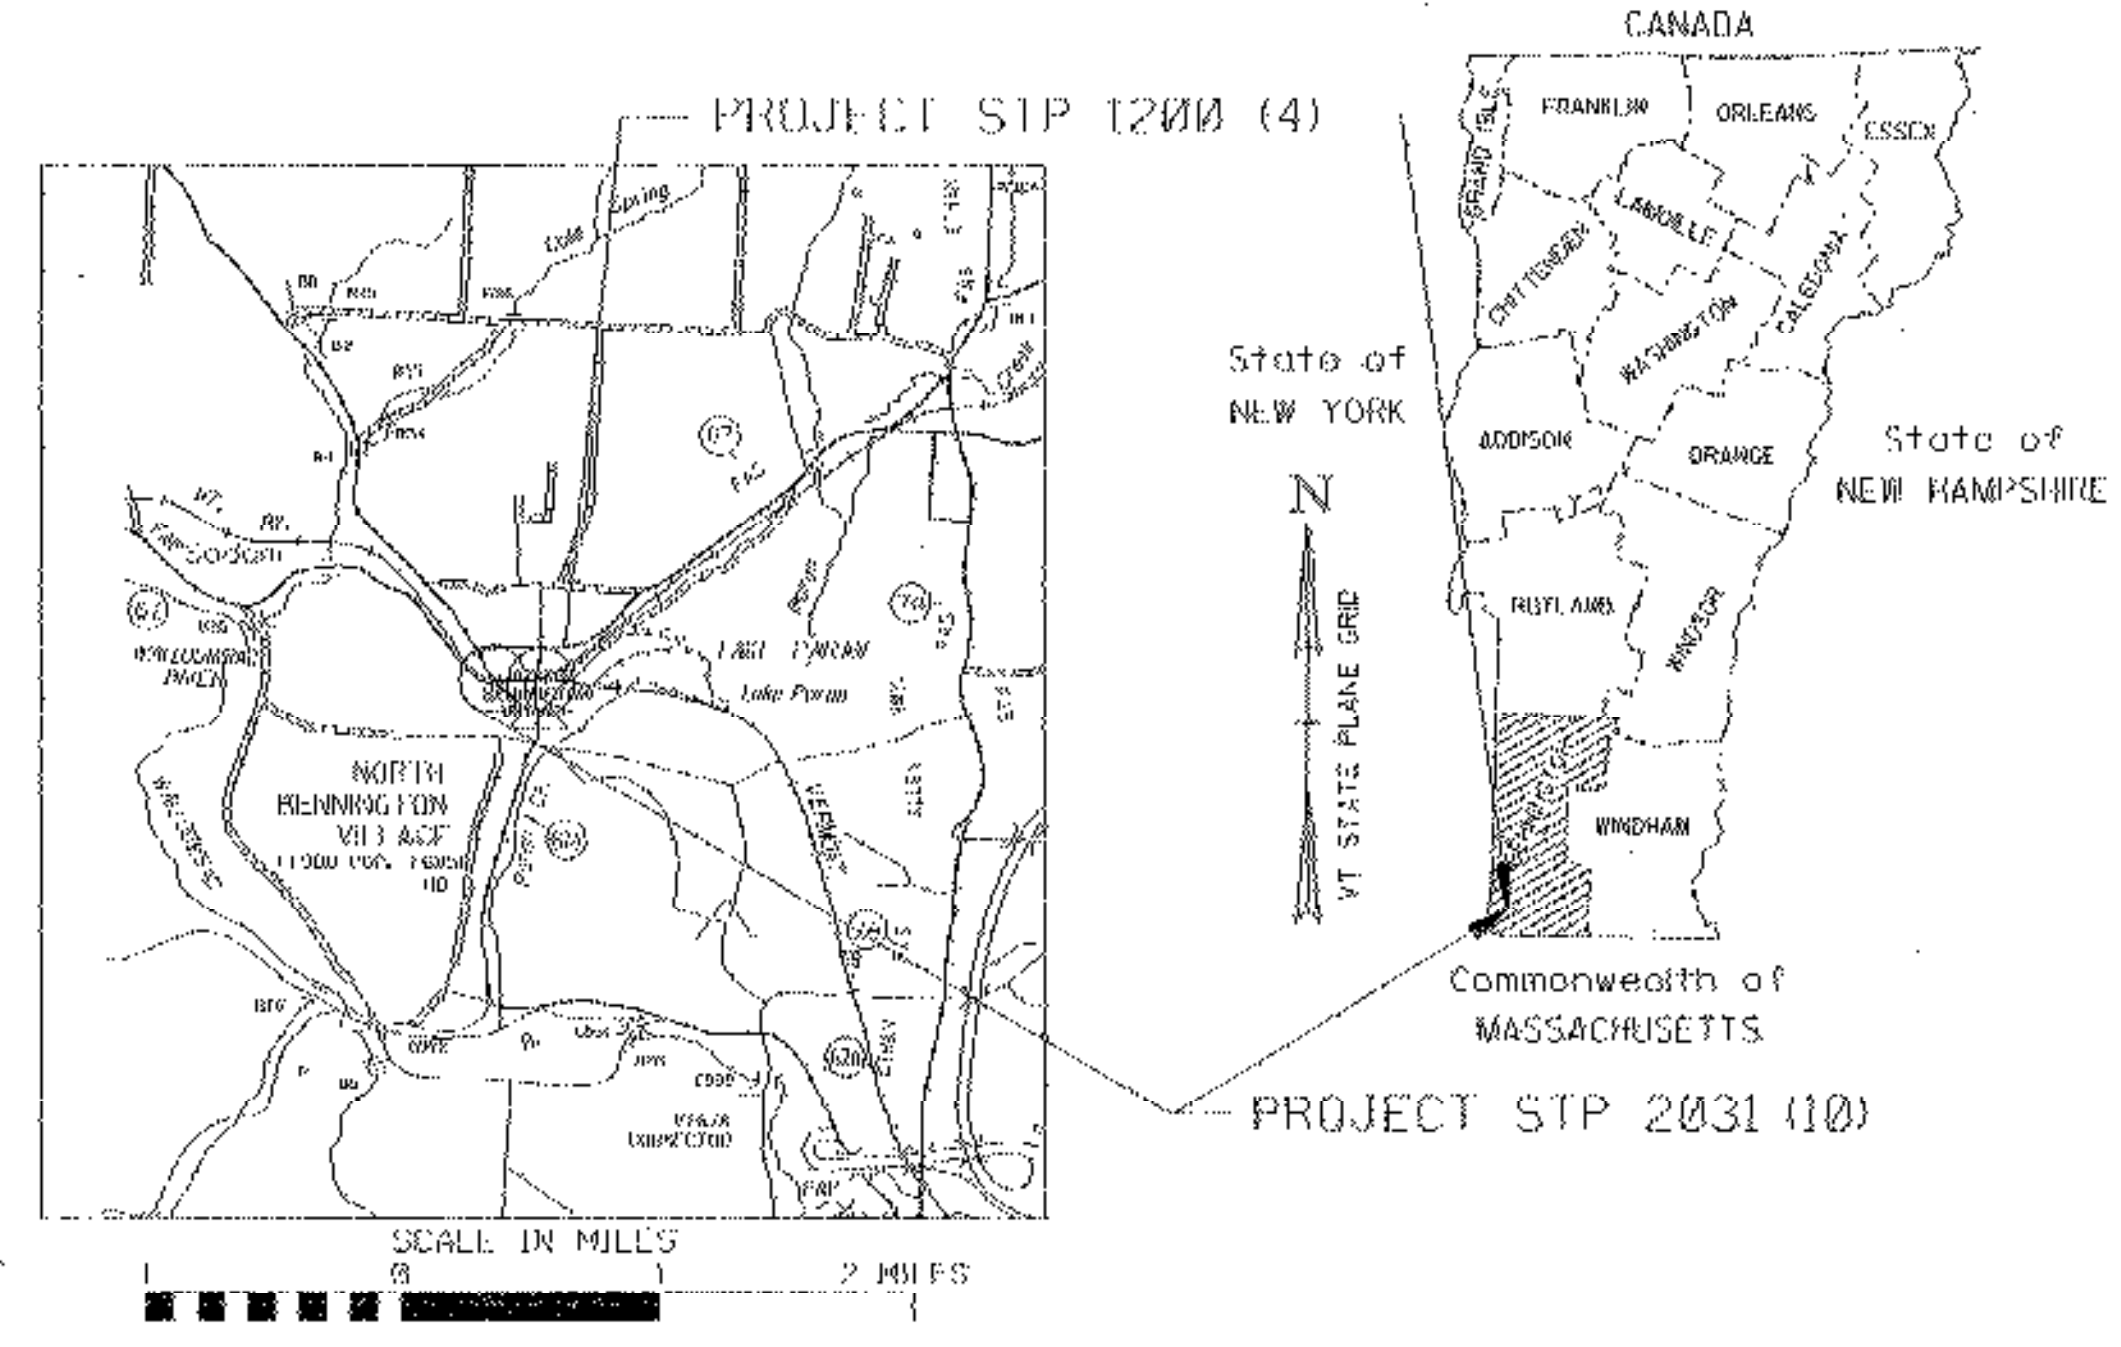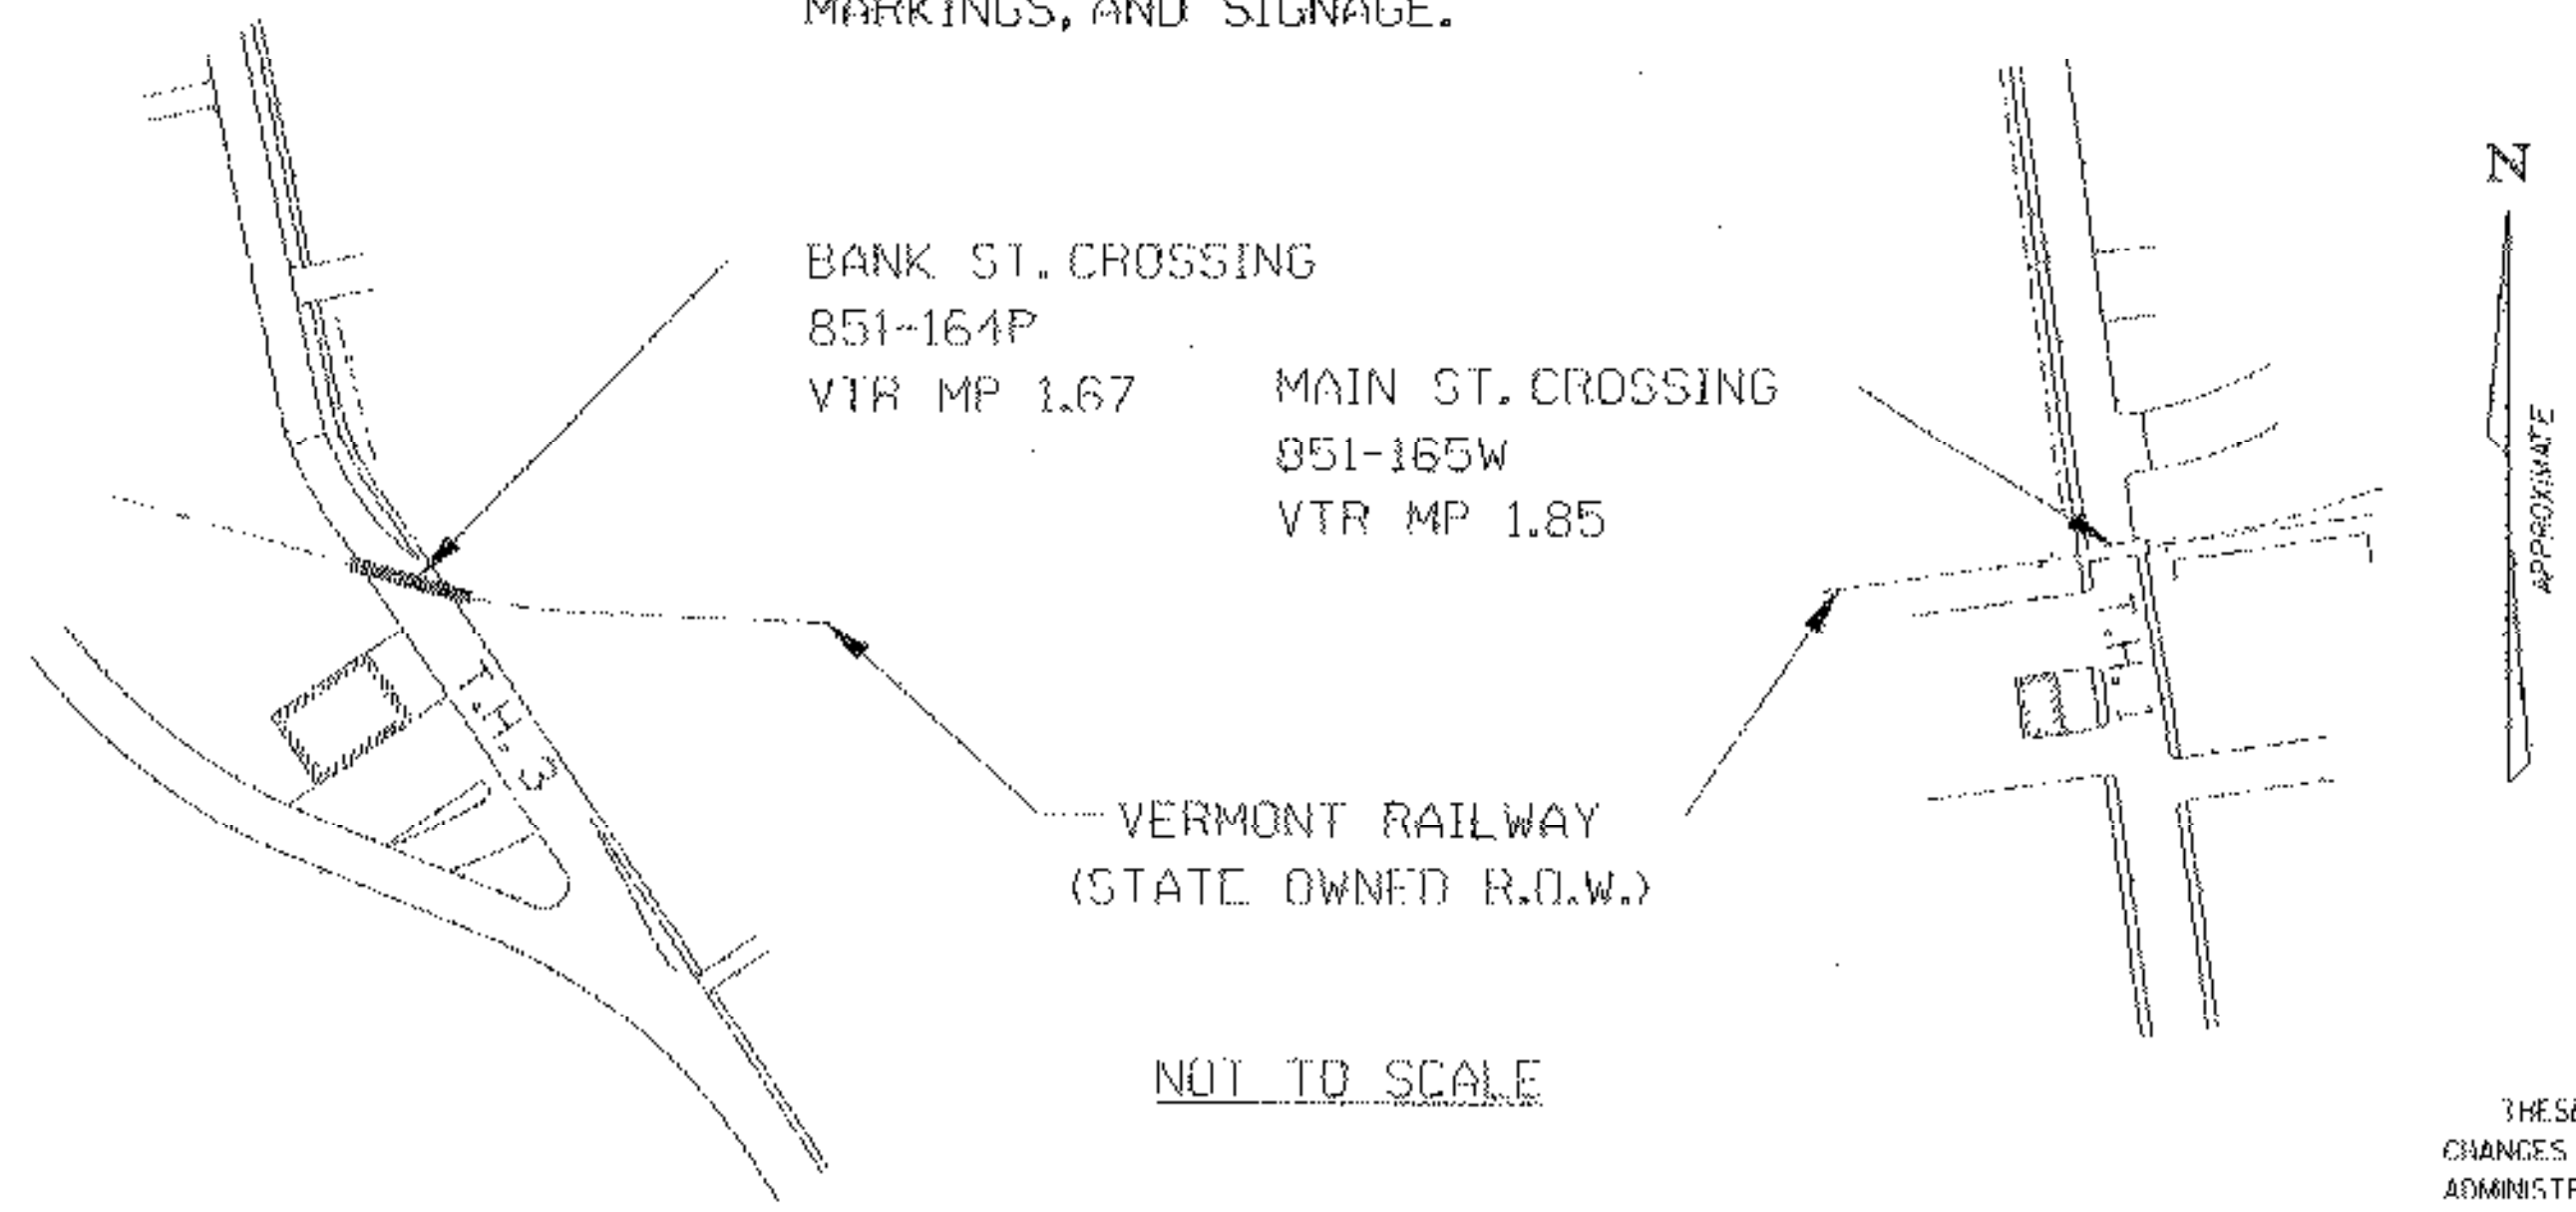

**DESIGN SPEED AND CURENT RR OPERATIONAL SPEED**

**TRAFFIC DATA (BANK STREET) TH # 3**

RAILROAD: V=10MPH (PASSENGER OPERATING SPEED)  
 V=10MPH (FREIGHT OPERATING SPEED)  
 V=40MPH (FREIGHT DESIGN SPEED)  
 V=59MPH (PASSENGER DESIGN SPEED)  
 (APRIL 2006)

HIGHWAY: V=30MPH  
 ADT=2500 (2004 ESTIMATED)

**TRAFFIC DATA (MAIN STREET) TH # 1**

RAILROAD: V=10MPH (PASSENGER OPERATING SPEED)  
 V=10MPH (FREIGHT OPERATING SPEED)  
 V=40MPH (FREIGHT DESIGN SPEED)  
 V=59MPH (PASSENGER DESIGN SPEED)  
 (APRIL 2006)


HIGHWAY: V=30MPH  
 ADT=3300 (2004 ESTIMATED)

THESE PLANS ARE SUBJECT TO SUCH ENGINEERING CHANGES AS MAY BE REQUIRED BY THE FEDERAL HIGHWAY ADMINISTRATION OR THE DIRECTOR OF PROGRAM DEVELOPMENT.  
 CONSTRUCTION IS TO BE CARRIED ON IN ACCORDANCE WITH THESE PLANS AND THE STANDARD SPECIFICATIONS FOR CONSTRUCTION DATED 2004, AS APPROVED BY THE FEDERAL HIGHWAY ADMINISTRATION ON JANUARY 4, 2005 FOR USE ON THIS PROJECT, INCLUDING ALL SUBSEQUENT REVISIONS AND SUCH REVISED SPECIFICATIONS AND SPECIAL PROVISIONS AS ARE INCORPORATED IN THESE PLANS.

PROJECT MANAGER : JENNIFER ROYER  
 PROJECT NAME : NORTH BENNINGTON  
 PROJECT NUMBER : STP 2031 (10) TH #3;  
 STP 1200 (4) TH #1  
 SHEET 3 OF 21 SHEETS

**SUMMARY OF WORK:**

1. REMOVE EXISTING SIGNAL LIGHTS, R15-1 SIGNS, AND W10-1 SIGNS AND STOCKPILE IN A LOCATION DESIGNATED BY THE ENGINEER.
2. REMOVE AND DISPOSE EXISTING WIRES, AND PAVEMENT MARKINGS INCLUDING STOP BARS.
3. REMOVE EXISTING SIGNAL CASE AND REPLACE WITH NEW 4'x6' SIGNAL CASE. DISPOSE REMOVED SIGNAL CASE.
4. INSTALL NEW METER AND CIRCUIT BREAKERS IN EXISTING POWER DROP. ESTABLISH ELECTRIC SERVICE.
5. IN THE SOUTHEAST QUADRANT USING THE EXISTING FOUNDATION, INSTALL NEW SIGNAL MAST, 12" LED LIGHTS, R15-1, MAST REFLECTORS, AND WIRES AS INDICATED ON THE PLANS, DETAILS, AND STANDARDS.
6. IN THE NORTHWEST QUADRANT USING THE EXISTING CANTILEVER MAST AND ARM; INSTALL NEW 12" LED LIGHTS, R15-1, MAST REFLECTORS, WIRES, AND BELL AS INDICATED ON THE PLANS, DETAILS, AND STANDARDS.
7. INSTALL NEW DOUBLE YELLOW CENTER LINES, EDGE LINES, DIAGONAL LINES, AND RAILROAD CROSSING PAVEMENT MARKINGS, AND W10-1 SIGNS AS INDICATED ON THE PLANS, DETAILS, AND STANDARDS.
8. LADDER ADDED PER C.O.D./S.A. #4, SEE BELOW

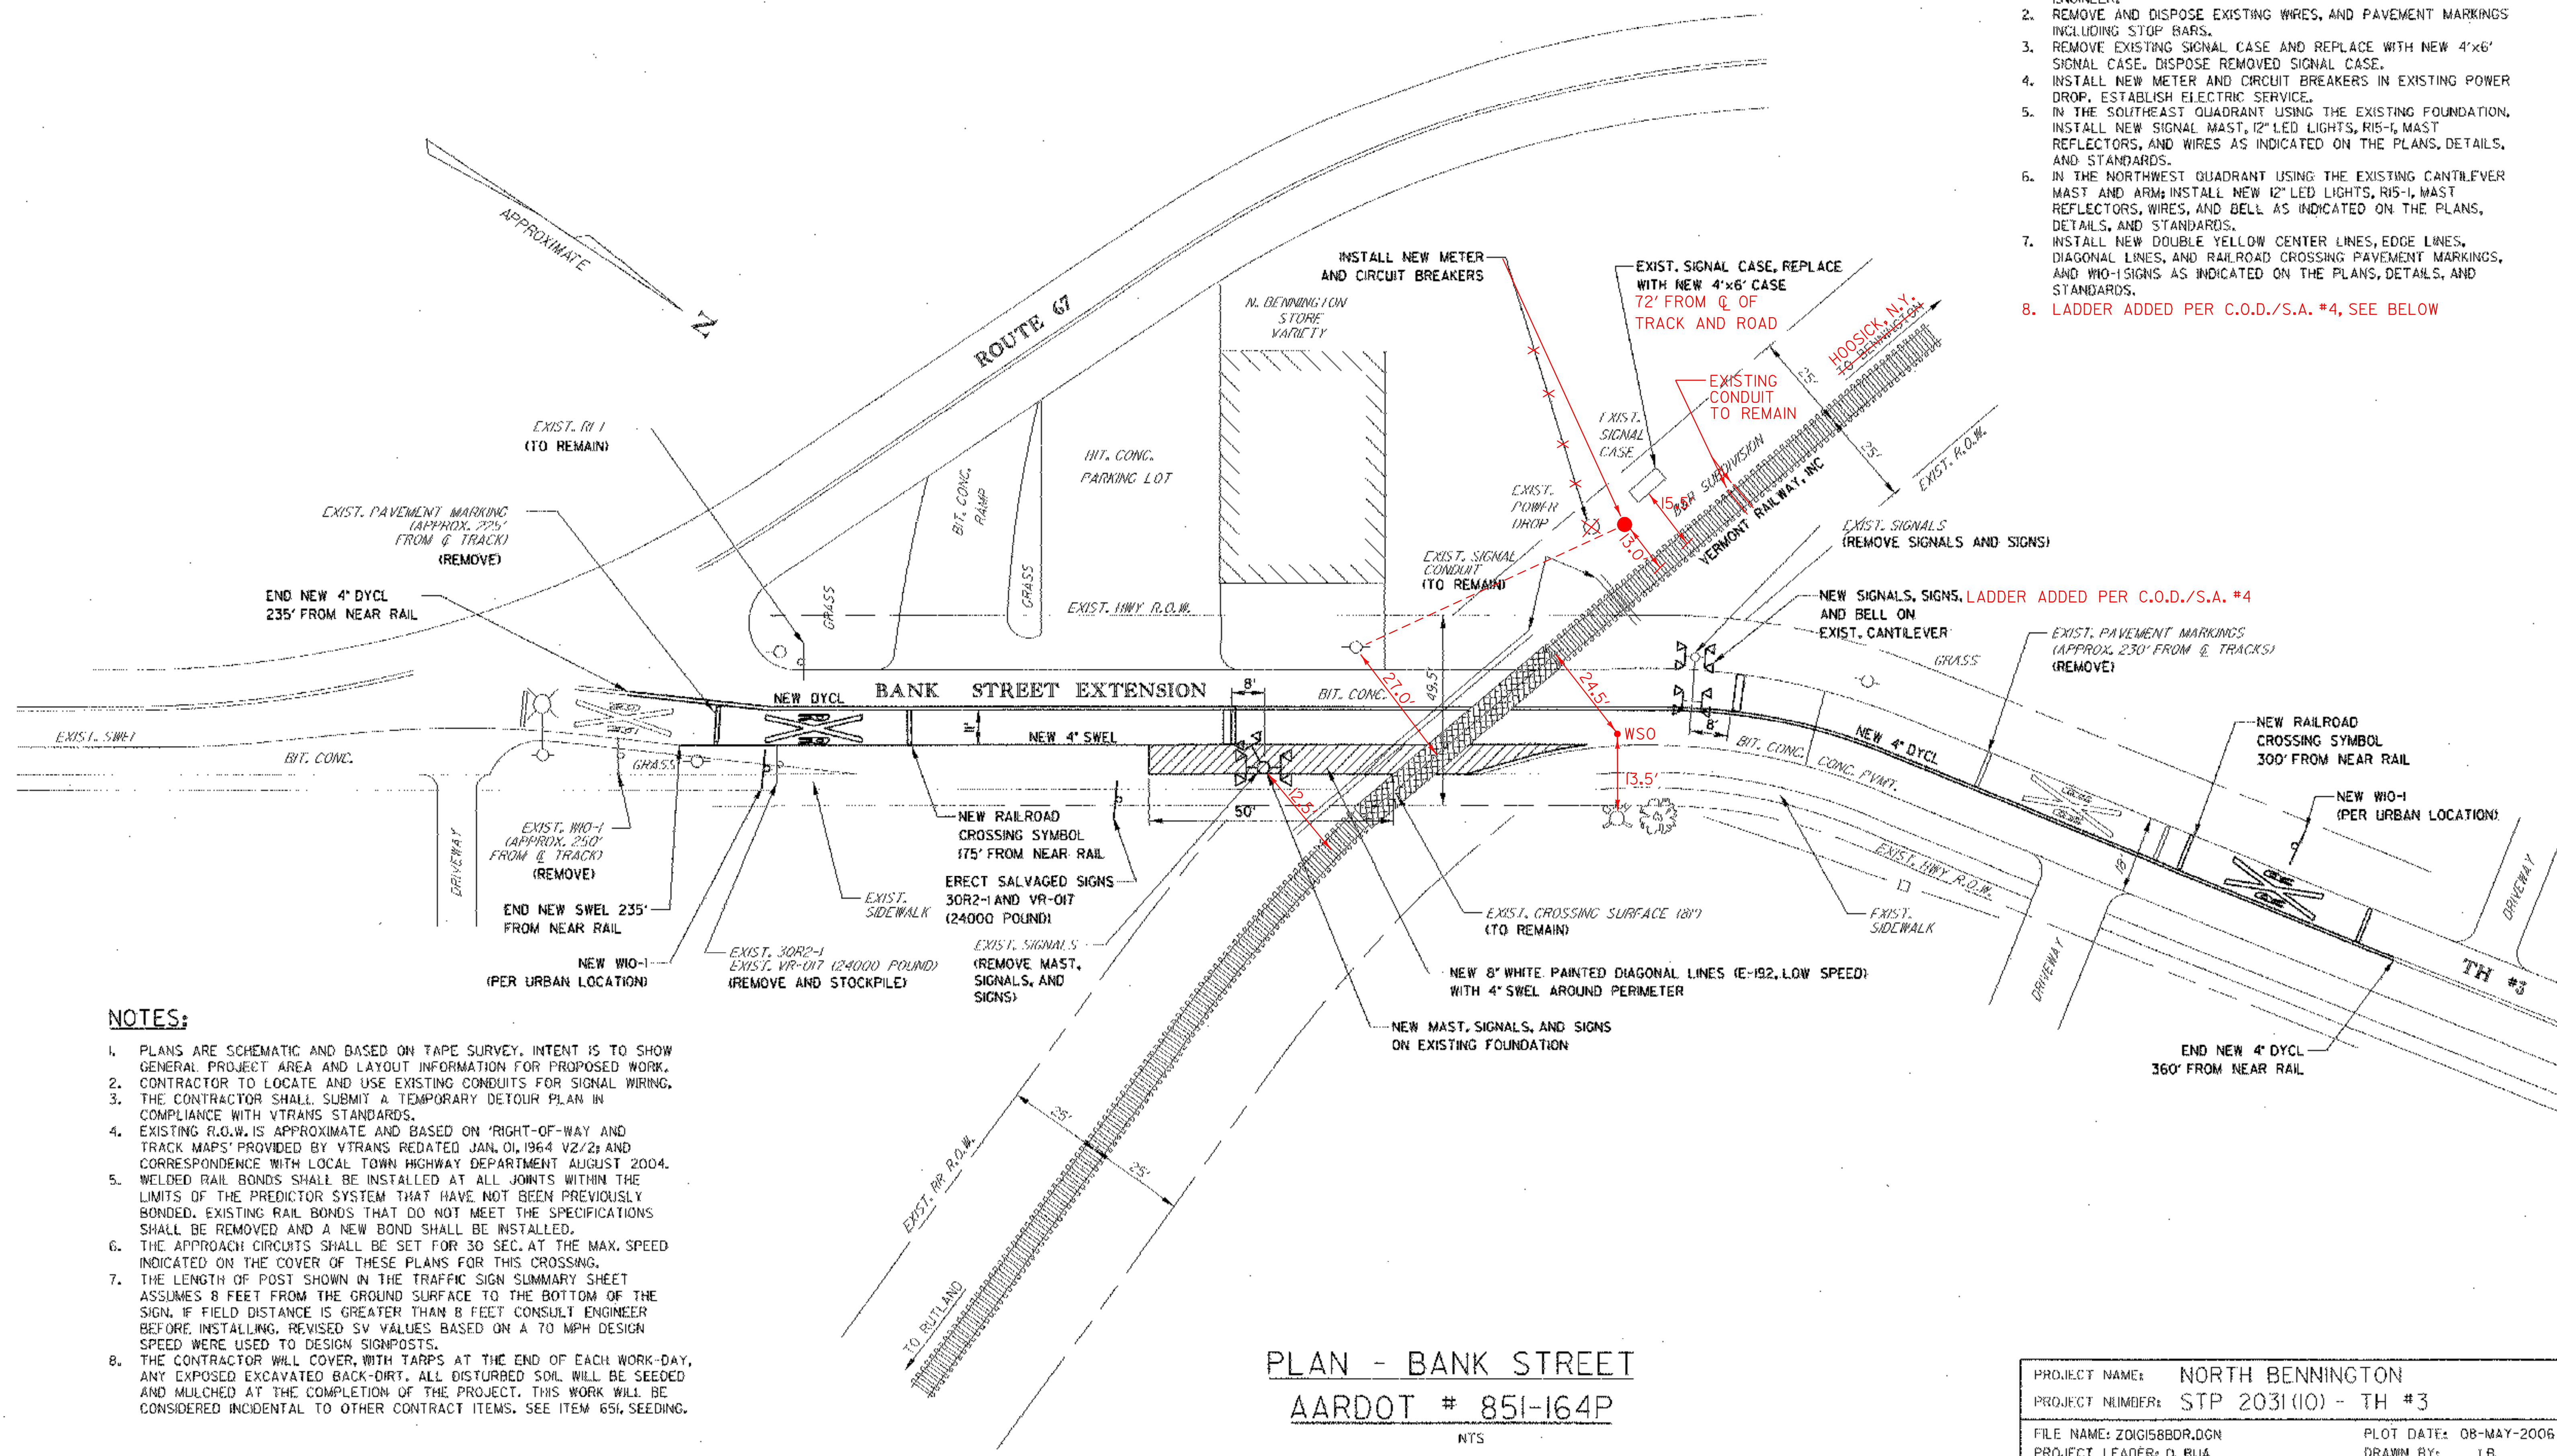

**NOTES:**

1. PLANS ARE SCHEMATIC AND BASED ON TAPE SURVEY. INTENT IS TO SHOW GENERAL PROJECT AREA AND LAYOUT INFORMATION FOR PROPOSED WORK.
2. CONTRACTOR TO LOCATE AND USE EXISTING CONDUITS FOR SIGNAL WIRING.
3. THE CONTRACTOR SHALL SUBMIT A TEMPORARY DETOUR PLAN IN COMPLIANCE WITH VTRANS STANDARDS.
4. EXISTING R.O.W. IS APPROXIMATE AND BASED ON 'RIGHT-OF-WAY AND TRACK MAPS' PROVIDED BY VTRANS REDATED JAN. 01, 1964 V2/2; AND CORRESPONDENCE WITH LOCAL TOWN HIGHWAY DEPARTMENT AUGUST 2004.
5. WELDED RAIL BONDS SHALL BE INSTALLED AT ALL JOINTS WITHIN THE LIMITS OF THE PREDICTOR SYSTEM THAT HAVE NOT BEEN PREVIOUSLY BONDED. EXISTING RAIL BONDS THAT DO NOT MEET THE SPECIFICATIONS SHALL BE REMOVED AND A NEW BOND SHALL BE INSTALLED.
6. THE APPROACH CIRCUITS SHALL BE SET FOR 30 SEC. AT THE MAX. SPEED INDICATED ON THE COVER OF THESE PLANS FOR THIS CROSSING.
7. THE LENGTH OF POST SHOWN IN THE TRAFFIC SIGN SUMMARY SHEET ASSUMES 8 FEET FROM THE GROUND SURFACE TO THE BOTTOM OF THE SIGN. IF FIELD DISTANCE IS GREATER THAN 8 FEET CONSULT ENGINEER BEFORE INSTALLING. REVISED SV VALUES BASED ON A 70 MPH DESIGN SPEED WERE USED TO DESIGN SIGNPOSTS.
8. THE CONTRACTOR WILL COVER, WITH TARPS AT THE END OF EACH WORK-DAY, ANY EXPOSED EXCAVATED BACK-DIRT. ALL DISTURBED SOIL WILL BE SEEDING AND MULCHED AT THE COMPLETION OF THE PROJECT. THIS WORK WILL BE CONSIDERED INCIDENTAL TO OTHER CONTRACT ITEMS. SEE ITEM 651, SEEDING.

**PLAN - BANK STREET**  
**AARDOT # 851-164P**

NTS


PROJECT NAME:	NORTH BENNINGTON
PROJECT NUMBER:	STP 2031(10) - TH #3
FILE NAME:	Z0IG58BDR.DGN
PROJECT LEADER:	D. BUA
DESIGNED BY:	ASL, LB
PLOT DATE:	08-MAY-2006
DRAWN BY:	LB
CHECKED BY:	BUA
SHEET	4 OF 21

PT03030064



**SUMMARY OF WORK:**

1. REMOVE EXISTING FOUNDATIONS, MAST, CANTILEVER, LIGHTS, RIS-1, AND WIO-1 SIGNS; STOCKPILE SIGNS AND SIGNALS IN A LOCATION DESIGNATED BY THE ENGINEER.
2. REMOVE AND DISPOSE EXISTING WIRES AND PAVEMENT MARKINGS INCLUDING STOP BARS.
3. REMOVE EXISTING SIGNAL CASE AND REPLACE WITH NEW 4'x6' SIGNAL CASE. DISPOSE REMOVED SIGNAL CASE.
4. REMOVE EXISTING CROSSING SURFACE INCLUDING ASPHALT PAVEMENT 15-FT BOTH SIDES OF THE CENTERLINE OF THE TRACK. REMOVE EXISTING TRACK, TIES, AND BALLAST. DISPOSE REMOVED TRACK MATERIAL. DISPOSAL OF THE REMOVED ASPHALT, BALLAST, AND TIES SHALL BE THE RESPONSIBILITY OF THE CONTRACTOR.
5. COMPACT AND PREPARE TRACK ROADBED SURFACE. INSTALL UNDERDRAINS, UNDERDRAIN FLUSHING BASINS, BALLAST, TIES, AND CWR RAIL AS INDICATED IN THE PLANS, DETAILS, AND STANDARDS. FIELD WELD NEW CWR RAIL TO EXISTING RAIL.
6. INSTALL RAIL SEAL AND ASPHALT PAVEMENT AS INDICATED IN THE PLANS, DETAILS, AND STANDARDS. MATCH EXISTING PAVEMENT.
7. INSTALL NEW GRANITE CURB AND PORTLAND CEMENT CONCRETE SIDEWALK WITH DETECTABLE WARNING STRIPS.
8. INSTALL NEW FOUNDATIONS, MAST, CANTILEVER, LIGHTS, RIS-1, MAST REFLECTORS, WIRES, AND BELL AS INDICATED ON THE PLANS, DETAILS, AND STANDARDS.
9. INSTALL NEW DOUBLE YELLOW CENTER LINES, SINGLE WHITE EDGE LINES, RAILROAD CROSSING PAVEMENT MARKINGS, AND WIO-1 SIGNS AS INDICATED ON THE PLANS, DETAILS, AND STANDARDS.

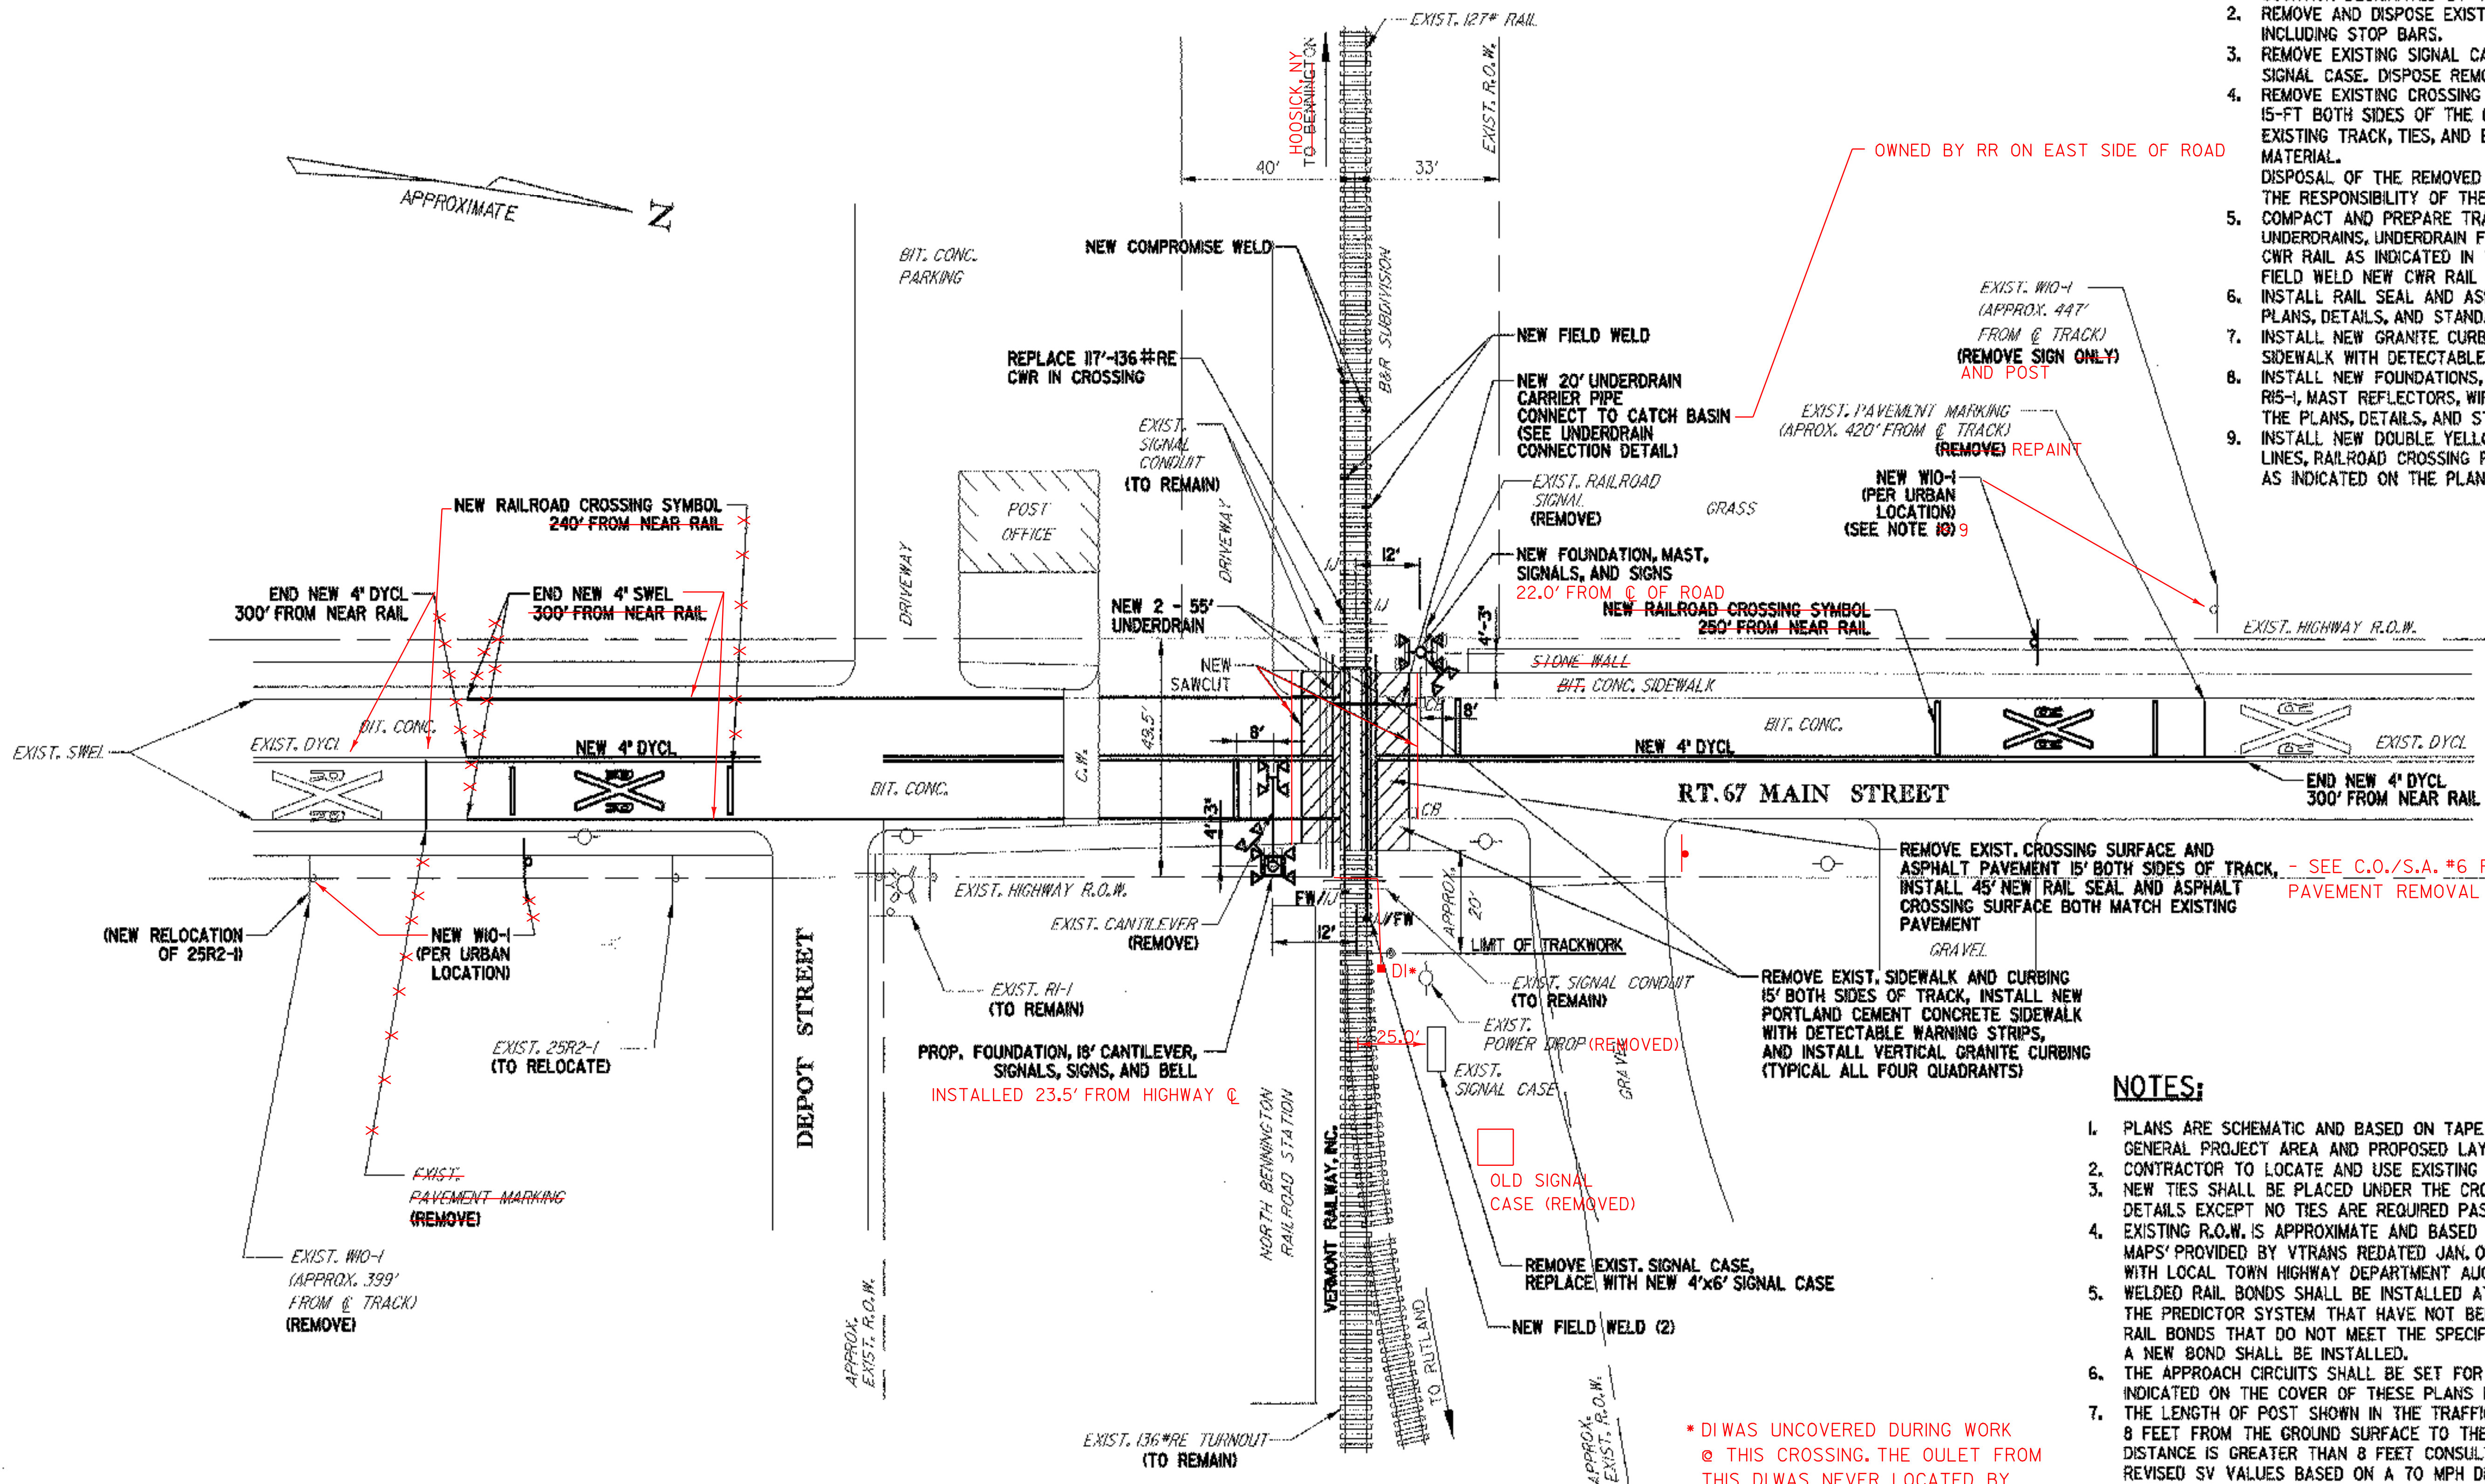

**NOTES:**

1. PLANS ARE SCHEMATIC AND BASED ON TAPE SURVEY. INTENT IS TO SHOW GENERAL PROJECT AREA AND PROPOSED LAYOUT INFORMATION FOR PROPOSED WORK.
2. CONTRACTOR TO LOCATE AND USE EXISTING CONDUITS FOR NEW SIGNAL WIRING.
3. NEW TIES SHALL BE PLACED UNDER THE CROSSING AS SHOWN IN THE CROSSING DETAILS EXCEPT NO TIES ARE REQUIRED PAST THE PS OF THE TURNOUT.
4. EXISTING R.O.W. IS APPROXIMATE AND BASED ON 'RIGHT-OF-WAY AND TRACK MAPS' PROVIDED BY VTRANS REDATED JAN. 01, 1964 V2/21 AND CORRESPONDENCE WITH LOCAL TOWN HIGHWAY DEPARTMENT AUGUST 2004.
5. WELDED RAIL BONDS SHALL BE INSTALLED AT ALL JOINTS WITHIN THE LIMITS OF THE PREDICTOR SYSTEM THAT HAVE NOT BEEN PREVIOUSLY BONDED. EXISTING RAIL BONDS THAT DO NOT MEET THE SPECIFICATIONS SHALL BE REMOVED AND A NEW BOND SHALL BE INSTALLED.
6. THE APPROACH CIRCUITS SHALL BE SET FOR 30 SEC. AT THE MAX. SPEED INDICATED ON THE COVER OF THESE PLANS FOR THIS CROSSING.
7. THE LENGTH OF POST SHOWN IN THE TRAFFIC SIGN SUMMARY SHEET ASSUMES 8 FEET FROM THE GROUND SURFACE TO THE BOTTOM OF THE SIGN. IF FIELD DISTANCE IS GREATER THAN 8 FEET CONSULT ENGINEER BEFORE INSTALLING. REVISED SV VALUES BASED ON A 70 MPH DESIGN SPEED WERE USED TO DESIGN SIGNPOSTS.
8. THE CONTRACTOR WILL COVER, WITH TARPS AT THE END OF EACH WORK-DAY, ANY EXPOSED EXCAVATED BACK-DIRT. ALL DISTURBED SOIL WILL BE SEED AND MULCHED AT THE COMPLETION OF THE PROJECT. THIS WORK WILL BE CONSIDERED INCIDENTAL TO OTHER CONTRACT ITEMS. SEE ITEM 651, SEEDING.
9. THE CONTRACTOR SHALL PROVIDE HORIZONTAL AND VERTICAL CONTROL IN ORDER TO LOCATE EXISTING TRACK ALIGNMENT AND PROFILE. THE CONTRACTOR SHALL CONSTRUCT PROPOSED TRACK AND ROADWAY LIKE EXISTING GEOMETRY UNLESS DIRECTED OTHERWISE BY THE ENGINEER.

\* DI WAS UNCOVERED DURING WORK @ THIS CROSSING. THE OULET FROM THIS DI WAS NEVER LOCATED BY DIST. #1, CONST. OR RR PERSONEL. THE OLD UNDERDRAIN SYSTEM WAS REMOVED & FULLY PLUGGED. THE NEW UNDERDRAIN SYSTEM WAS INSTALLED TO OUTLET AT THIS DI.  
 DI IS 7.0' FROM RR C.  
 DI IS 38.0' FROM HIGHWAY C.

**PLAN - MAIN STREET**  
**AARDOT # 851-165W**

NTS

PROJECT NAME:	NORTH BENNINGTON
PROJECT NUMBER:	STP 1200 (4) TH #1
FILE NAME:	Z01G60BDR.DGN
PROJECT LEADER:	D. BUA
DESIGNED BY:	ASL, LB
PLOT DATE:	08-MAY-2006
DRAWN BY:	LB
CHECKED BY:	BUA
SHEET	6 OF 21

P70030006







**SUMMARY OF WORK:**


1. REMOVE EXISTING R15-1 SIGNS, AND W10 SIGNS; STOCKPILE IN A LOCATION DESIGNATED BY THE ENGINEER.
2. REMOVE AND DISPOSE EXISTING PAVEMENT MARKINGS INCLUDING STOP BARS.
3. INSTALL NEW POWER DROP, METER, AND CIRCUIT BREAKERS. ESTABLISH ELECTRIC SERVICE.
4. INSTALL NEW 4'x6' SIGNAL CASE ON PROPOSED GRAVEL MOUND. \*\*
5. INSTALL NEW SIGNAL MASTS, 12" LED SIGNAL LIGHTS, R15-1, MAST REFLECTORS, WIRES AND BELL AS INDICATED ON THE PLANS, DETAILS, AND STANDARDS.
6. INSTALL NEW DOUBLE YELLOW CENTER LINES, RAILROAD CROSSING PAVEMENT MARKINGS, AND W10 SIGNS AS INDICATED ON THE PLANS, DETAILS, AND STANDARDS. THE NEW DOUBLE YELLOW CENTER LINES SHALL BE PLACED ON UNION STREET FROM CROSSING TO JUST BEYOND THE RAILROAD MARKINGS. APPLIED BY STATE

\*\* (IN S.E. CORNER)

**NOTES:**

1. PLANS ARE SCHEMATIC AND BASED ON TAPE SURVEY. INTENT IS TO SHOW GENERAL PROJECT AREA AND PROPOSED LAYOUT INFORMATION FOR PROPOSED WORK.
2. CONTRACTOR TO LOCATE AND USE EXISTING CONDUITS FOR NEW SIGNAL WIRING.
3. W10-3 SIGN NORTH OF INTERSECTION IS PLACED 700' FROM UNION STREET DUE TO LIMITED CLEARANCE BETWEEN RICHVILLE ROAD AND THE RAILROAD TRACKS.
4. EXISTING R.O.W. IS APPROXIMATE AND BASED ON 'RIGHT-OF-WAY AND TRACK MAPS' PROVIDED BY VTTRANS REDATED JAN. 01, 1964 V2/23; AND CORRESPONDENCE WITH LOCAL TOWN HIGHWAY DEPARTMENT AUGUST 2004.
5. WELDED RAIL BONDS SHALL BE INSTALLED AT ALL JOINTS WITHIN THE LIMITS OF THE PREDICTOR SYSTEM THAT HAVE NOT BEEN PREVIOUSLY BONDED. EXISTING RAIL BONDS THAT DO NOT MEET THE SPECIFICATIONS SHALL BE REMOVED AND A NEW BOND SHALL BE INSTALLED.
6. THE APPROACH CIRCUITS SHALL BE SET FOR 30 SEC. AT THE MAX. SPEED INDICATED ON THE COVER OF THESE PLANS FOR THIS CROSSING.
7. THE LENGTH OF POST SHOWN IN THE TRAFFIC SIGN SUMMARY SHEET ASSUMES 8 FEET FROM THE GROUND SURFACE TO THE BOTTOM OF THE SIGN. IF FIELD DISTANCE IS GREATER THAN 8 FEET CONSULT ENGINEER BEFORE INSTALLING. REVISED SV VALUES BASED ON A 70 MPH DESIGN SPEED WERE USED TO DESIGN SIGNPOSTS.
8. THE CONTRACTOR WILL COVER WITH TARPS AT THE END OF EACH WORK-DAY. ANY EXPOSED EXCAVATED BACK-DIRT. ALL DISTURBED SOIL WILL BE SEEDED AND MULCHED AT THE COMPLETION OF THE PROJECT. THIS WORK WILL BE CONSIDERED INCIDENTAL TO OTHER CONTRACT ITEMS. SEE ITEM 651 SEEDING.

- \* HYDRANT IS 22' FROM NEAR CORNER (N.E.) OF NEW SIGNAL CASE. IS 12.5' FROM NEAR EDGE OF PAVEMENT.
- WSO #1 IS 17.5' FROM NEAR CORNER (N.E.) OF NEW SIGNAL CASE. 4.5' FROM HYDRANT.
- WSO #2 IS 20.5' FROM NEAR CORNER (N.E.) OF NEW SIGNAL CASE. 2.0' FROM HYDRANT.
- WSO #3 IS 31.0' FROM NEAR CORNER (N.E.) OF NEW SIGNAL CASE. 9.5' FROM NEAR EDGE OF PAVEMENT

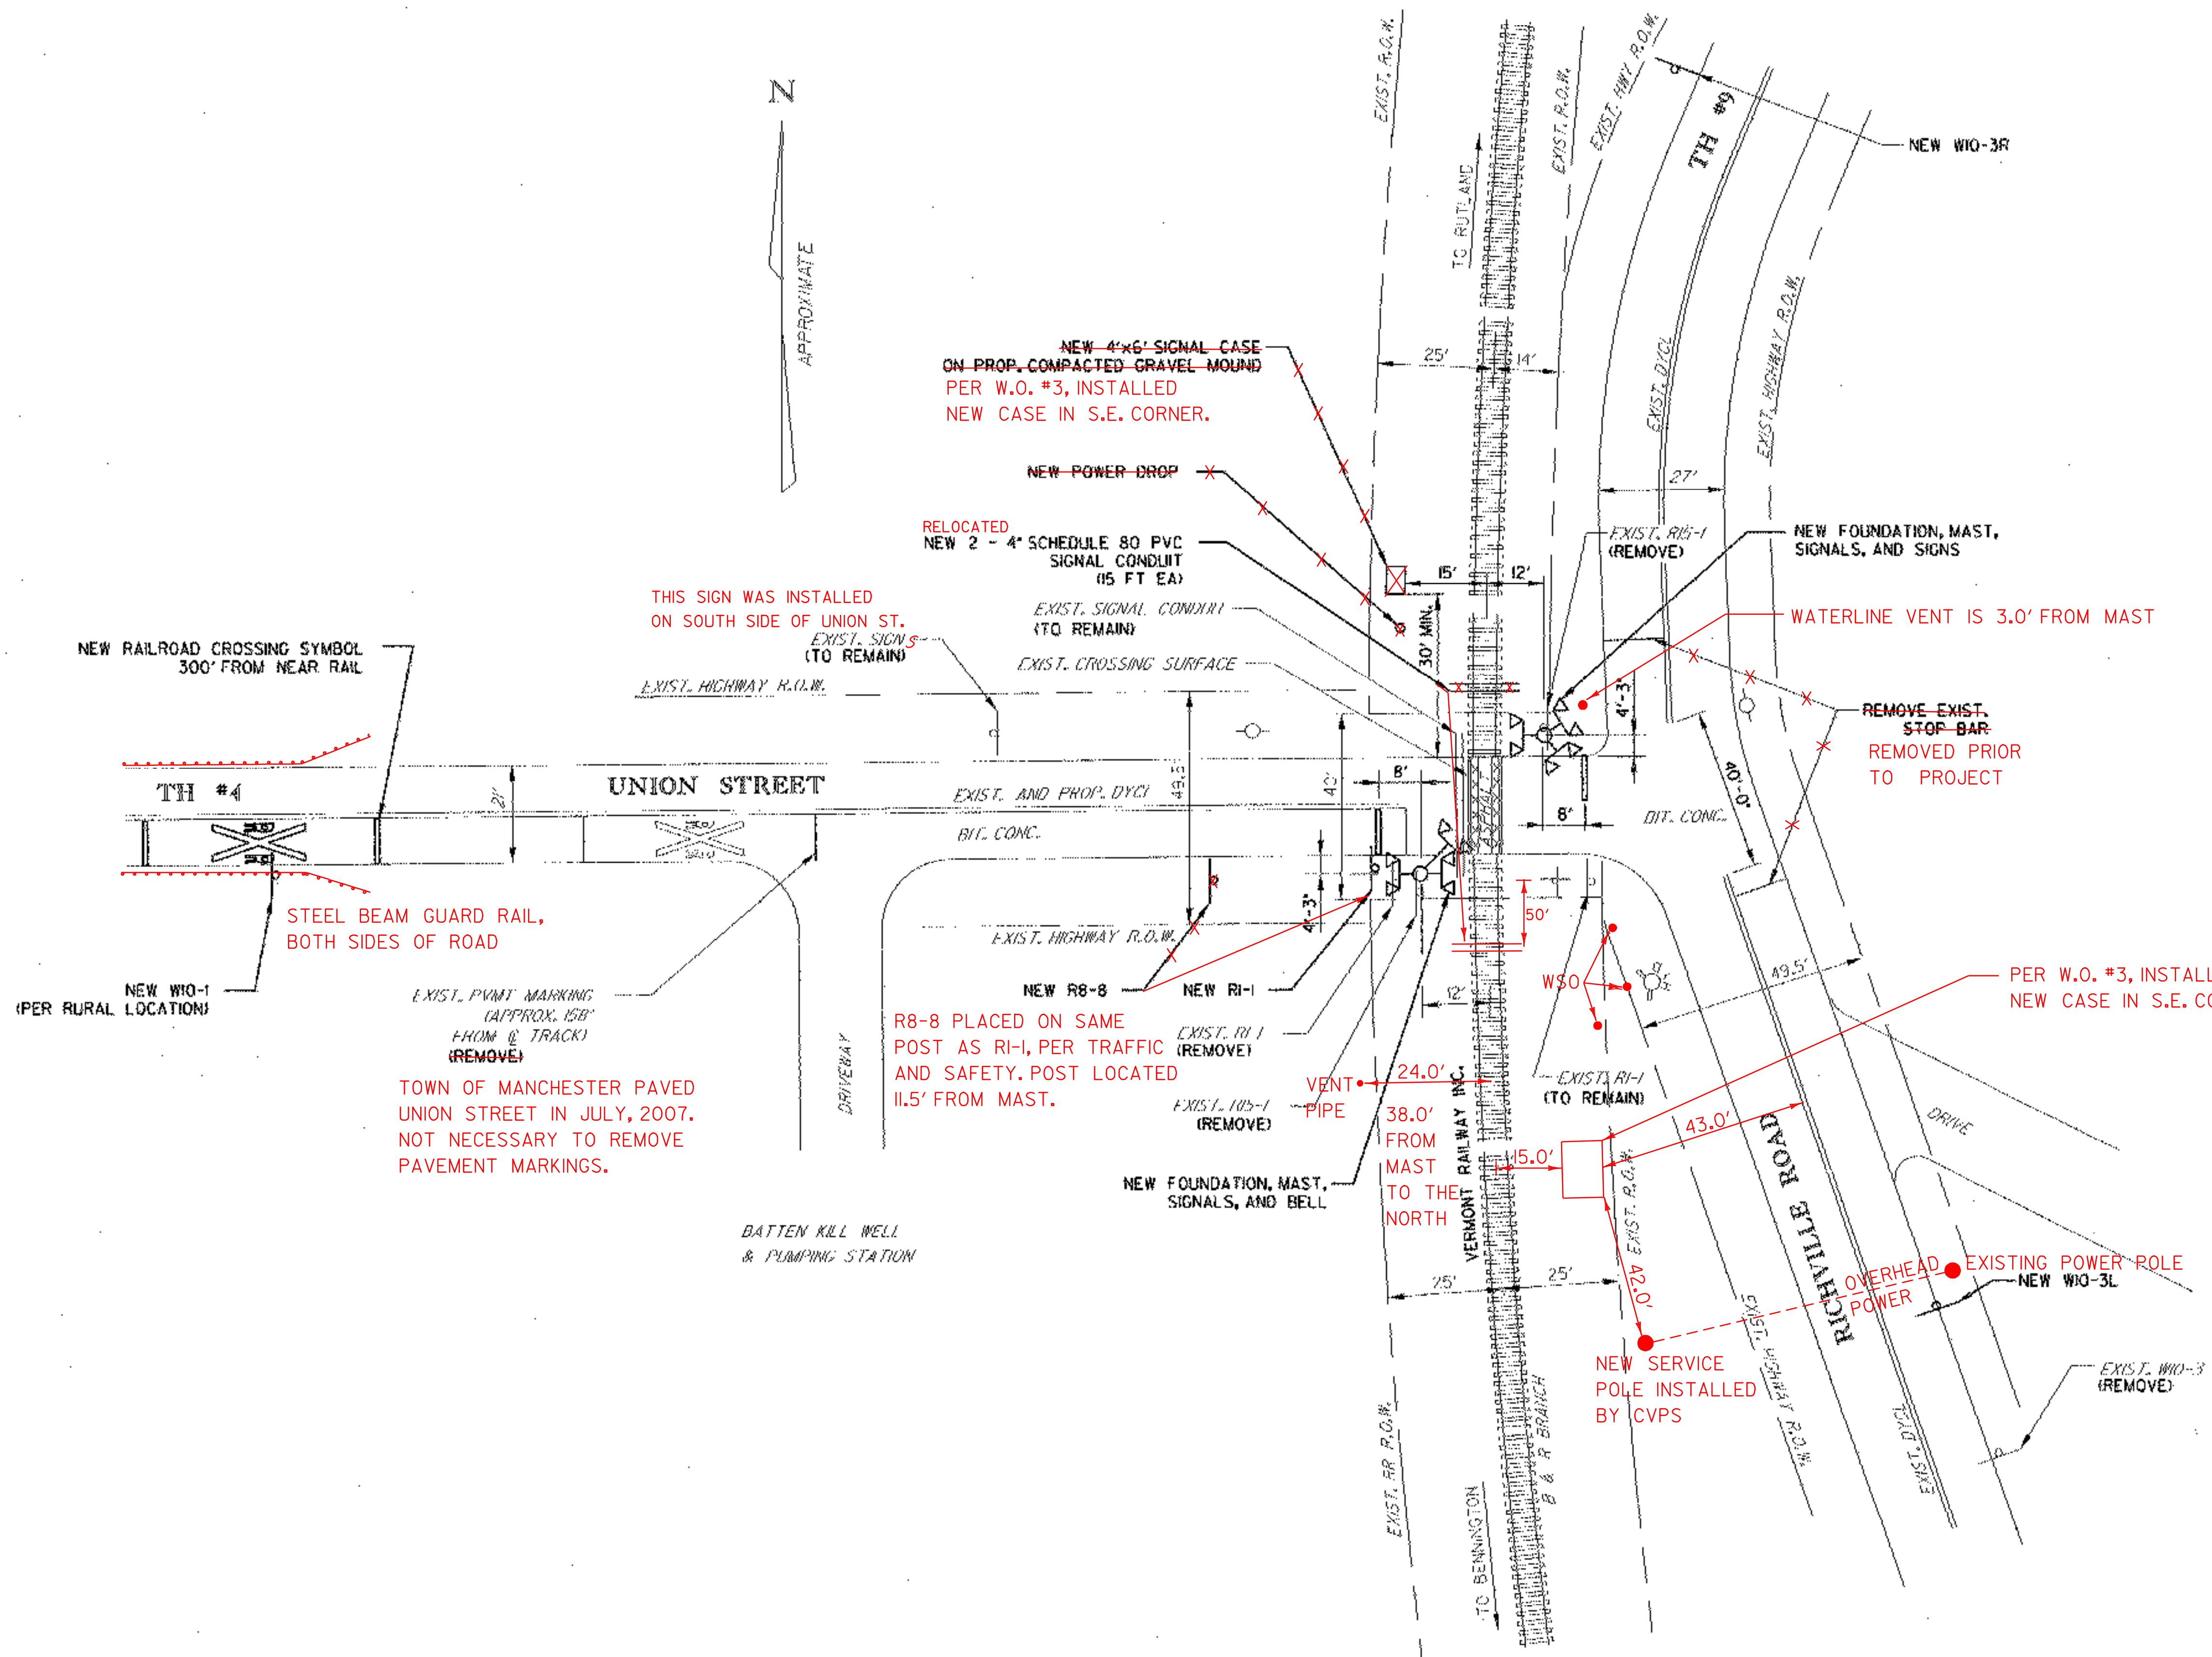

**PLAN - UNION STREET**  
**AARDOT # 851-199R**

NTS


PROJECT NAME:	MANCHESTER
PROJECT NUMBER:	STP 2031(12) TH #4
FILE NAME:	Z01G164BDR.DGN
PROJECT LEADER:	D. BUA
DESIGNED BY:	ASL
PLOT DATE:	08-MAY-2006
DRAWN BY:	LB
CHECKED BY:	BUA
SHEET	10 OF 21

PT003007



**SUMMARY OF WORK:**

1. REMOVE EXISTING SIGNAL LIGHTS, RIS-1, AND WIO-1 SIGNS; STOCKPILE IN A LOCATION DESIGNATED BY THE ENGINEER.
2. REMOVE AND DISPOSE WIRES AND PAVEMENT MARKINGS INCLUDING STOP BARS.
3. REMOVE EXISTING CROSSING SURFACE INCLUDING ASPHALT PAVEMENT 15-FT BOTH SIDES OF THE CENTERLINE OF THE TRACK.
4. REMOVE EXISTING TRACK, TIES AND BALLAST. STOCKPILE REMOVED TRACK MATERIAL IN A LOCATION DESIGNATED BY THE ENGINEER. DISPOSAL OF REMOVED ASPHALT, BALLAST, AND TIES SHALL BE THE RESPONSIBILITY OF THE CONTRACTOR.
5. COMPACT AND PREPARE ROADBED SURFACE, INSTALL UNDERDRAINS, BALLAST, TIES, CWR, AND COMPROMISE JOINTS AS INDICATED IN THE PLANS, DETAILS, AND STANDARDS.
6. INSTALL RAIL SEAL AND ASPHALT PAVEMENT AS INDICATED IN THE PLANS, DETAILS, AND STANDARDS. MATCH EXISTING PAVEMENT.
7. REMOVE EXISTING SIDEWALK AND CURBING 15 FT BOTH SIDES OF TRACK, INSTALL NEW PORTLAND CEMENT CONCRETE SIDEWALK WITH DETECTABLE WARNING STRIPS, AND INSTALL VERTICAL GRANITE CURBING.
8. USING EXISTING SIGNAL CASE, MAST AND CANTILEVER ASSEMBLIES, INSTALL NEW 12" LED LIGHTS, RIS-1, MAST REFLECTORS, WIRES, AND BELL AS INDICATED ON THE PLANS, DETAILS, AND STANDARDS.
9. INSTALL NEW DOUBLE YELLOW CENTER LINES, SINGLE WHITE EDGE LINES, RAILROAD CROSSING PAVEMENT MARKINGS, AND WIO-1 SIGNS AS INDICATED ON THE PLANS, DETAILS, AND STANDARDS.
10. PER C.O.D./S.A. #2 WORK AT THE CROSSING AT VT RTE II & 30 WAS ADDED TO THE PROJECT.

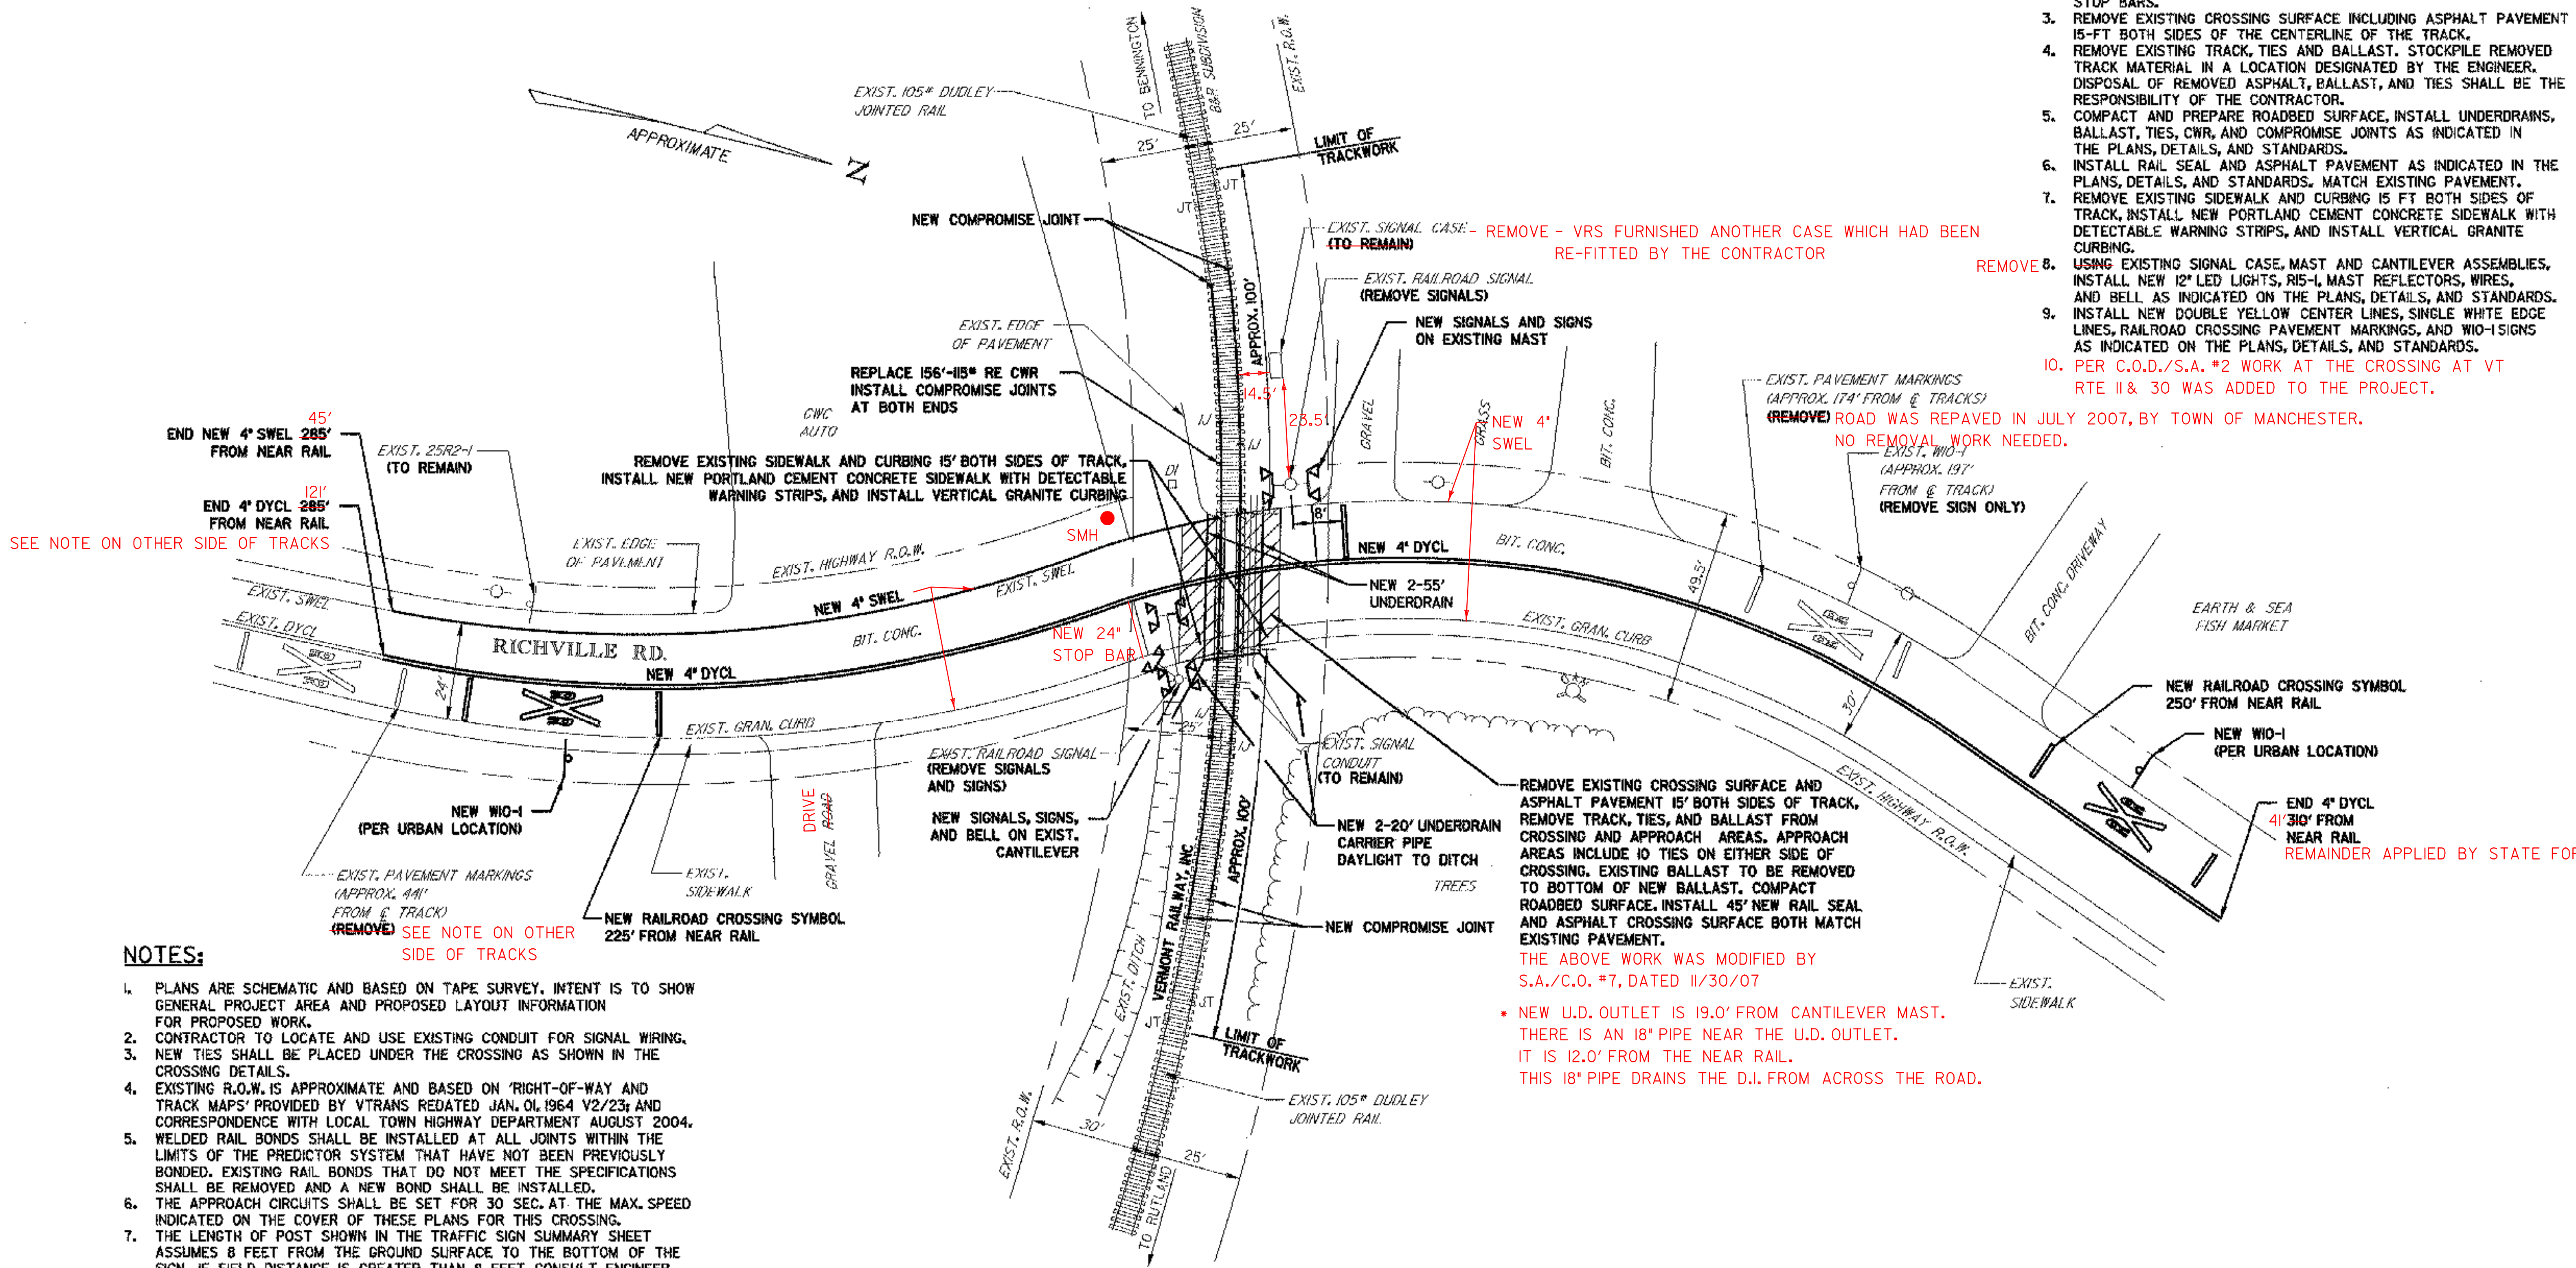

SEE NOTE ON OTHER SIDE OF TRACKS

NO REMOVAL WORK NEEDED.

REMAINDER APPLIED BY STATE FORCES

**NOTES:**

1. PLANS ARE SCHEMATIC AND BASED ON TAPE SURVEY. INTENT IS TO SHOW GENERAL PROJECT AREA AND PROPOSED LAYOUT INFORMATION FOR PROPOSED WORK.
2. CONTRACTOR TO LOCATE AND USE EXISTING CONDUIT FOR SIGNAL WIRING.
3. NEW TIES SHALL BE PLACED UNDER THE CROSSING AS SHOWN IN THE CROSSING DETAILS.
4. EXISTING R.O.W. IS APPROXIMATE AND BASED ON 'RIGHT-OF-WAY AND TRACK MAPS' PROVIDED BY VTRANS REDATED JAN. 01, 1964 V2/23; AND CORRESPONDENCE WITH LOCAL TOWN HIGHWAY DEPARTMENT AUGUST 2004.
5. WELDED RAIL BONDS SHALL BE INSTALLED AT ALL JOINTS WITHIN THE LIMITS OF THE PREDICTOR SYSTEM THAT HAVE NOT BEEN PREVIOUSLY BONDED. EXISTING RAIL BONDS THAT DO NOT MEET THE SPECIFICATIONS SHALL BE REMOVED AND A NEW BOND SHALL BE INSTALLED.
6. THE APPROACH CIRCUITS SHALL BE SET FOR 30 SEC. AT THE MAX. SPEED INDICATED ON THE COVER OF THESE PLANS FOR THIS CROSSING.
7. THE LENGTH OF POST SHOWN IN THE TRAFFIC SIGN SUMMARY SHEET ASSUMES 8 FEET FROM THE GROUND SURFACE TO THE BOTTOM OF THE SIGN. IF FIELD DISTANCE IS GREATER THAN 8 FEET CONSULT ENGINEER BEFORE INSTALLING, REVISED SV VALUES BASED ON A 70 MPH DESIGN SPEED WERE USED TO DESIGN SIGNPOSTS.
8. THE CONTRACTOR WILL COVER, WITH TARPS AT THE END OF EACH WORK-DAY, ANY EXPOSED EXCAVATED BACK-DIRT. ALL DISTURBED SOIL WILL BE SEEDED AND MULCHED AT THE COMPLETION OF THE PROJECT. THIS WORK WILL BE CONSIDERED INCIDENTAL TO OTHER CONTRACT ITEMS. SEE ITEM 65/SEEEDING.
9. THE CONTRACTOR SHALL PROVIDE HORIZONTAL AND VERTICAL CONTROL IN ORDER TO LOCATE EXISTING TRACK ALIGNMENT AND PROFILE. THE CONTRACTOR SHALL CONSTRUCT PROPOSED TRACK AND ROADWAY LIKE EXISTING GEOMETRY UNLESS DIRECTED OTHERWISE BY THE ENGINEER.

REMOVE EXISTING CROSSING SURFACE AND ASPHALT PAVEMENT 15' BOTH SIDES OF TRACK, REMOVE TRACK, TIES, AND BALLAST FROM CROSSING AND APPROACH AREAS. APPROACH AREAS INCLUDE 10 TIES ON EITHER SIDE OF CROSSING. EXISTING BALLAST TO BE REMOVED TO BOTTOM OF NEW BALLAST. COMPACT ROADBED SURFACE. INSTALL 45' NEW RAIL SEAL AND ASPHALT CROSSING SURFACE BOTH MATCH EXISTING PAVEMENT.  
 THE ABOVE WORK WAS MODIFIED BY S.A./C.O. #7, DATED 11/30/07  
 \* NEW U.D. OUTLET IS 19.0' FROM CANTILEVER MAST. THERE IS AN 18" PIPE NEAR THE U.D. OUTLET. IT IS 12.0' FROM THE NEAR RAIL. THIS 18" PIPE DRAINS THE D.I. FROM ACROSS THE ROAD.

**PLAN - RICHVILLE ROAD**  
**AARDOT # 851-200H**

NTS

PROJECT NAME:	MANCHESTER
PROJECT NUMBER:	STP 0171(12) TH #9
FILE NAME:	Z01G66BDR.DGN
PROJECT LEADER:	D. BUA
DESIGNED BY:	ASL
PLOT DATE:	08-MAY-2006
DRAWN BY:	LB
CHECKED BY:	BUA
SHEET	12 OF 21





INDEX OF SHEETS

- 15 TITLE SHEET
- 16 STP 2031 (11) - PLAN - AIRPORT ROAD
- 17 STP 2031 (11) - TRAFFIC SIGN SUMMARY SHEET

STANDARDS


STANDARDS	DATE
E-100 CONSTRUCTION APPROACH SIGNS	JAN. 02, 2004
E-101 CONSTRUCTION SIGN DETAILS	MAY 30, 2003
E-102 CONSTRUCTION SIGN DETAILS	JUN. 30, 2003
E-102A CONSTRUCTION SIGN DETAILS	MAY 01, 2004
E-106 TRAFFIC CONTROL - MISCELLANEOUS DETAILS	MAR. 01, 2004
E-107 DELINEATION, BARRICADES AND DETOURS FOR U-TURNS ON HIGHWAY	JUN. 30, 2003
E-107A BREAKAWAY BARRICADE DETAILS	AUG. 08, 1995
E-110 MAJOR MAINTENANCE OPERATION LANE CLOSURE	AUG. 08, 1995
E-111 MINOR MAINTENANCE OPERATION	MAR. 11, 1997
E-121 STANDARD SIGN PLACEMENT - CONVENTIONAL ROAD	AUG. 08, 1995
E-132 GENERAL MOTORIST SERVICE SIGN DETAILS	AUG. 18, 1995
E-152 WARNING SIGNS DETAILS	MAY 01, 2004
E-160 FLANGED CHANNEL STEEL SIGN POST	MAY 20, 1999
E-175 POWER DROP STANCHIONS	NOV. 17, 1993
E-190 RAILROAD CROSSING SIGNS AND PAVEMENT MARKINGS	JUN. 30, 2003

# STATE OF VERMONT AGENCY OF TRANSPORTATION



## PROPOSED IMPROVEMENT COUNTY OF BENNINGTON TOWN OF SHAFTSBURY TH 7, CL. 2 (9-LOCAL ROAD)

SHAFTSBURY; STP 2031 (11); PPMS 01G162  
VERMONT RAILWAY CROSSING 851-173N - AIRPORT ROAD  
WORK TO BE PERFORMED UNDER THIS PROJECT WILL INCLUDE THE  
CONSTRUCTION OF A NEW RR CROSSING SIGNAL SYSTEM INCLUDING NEW  
ELECTRICAL SERVICE, SIGNALS, PAVEMENT MARKINGS, AND SIGNAGE.

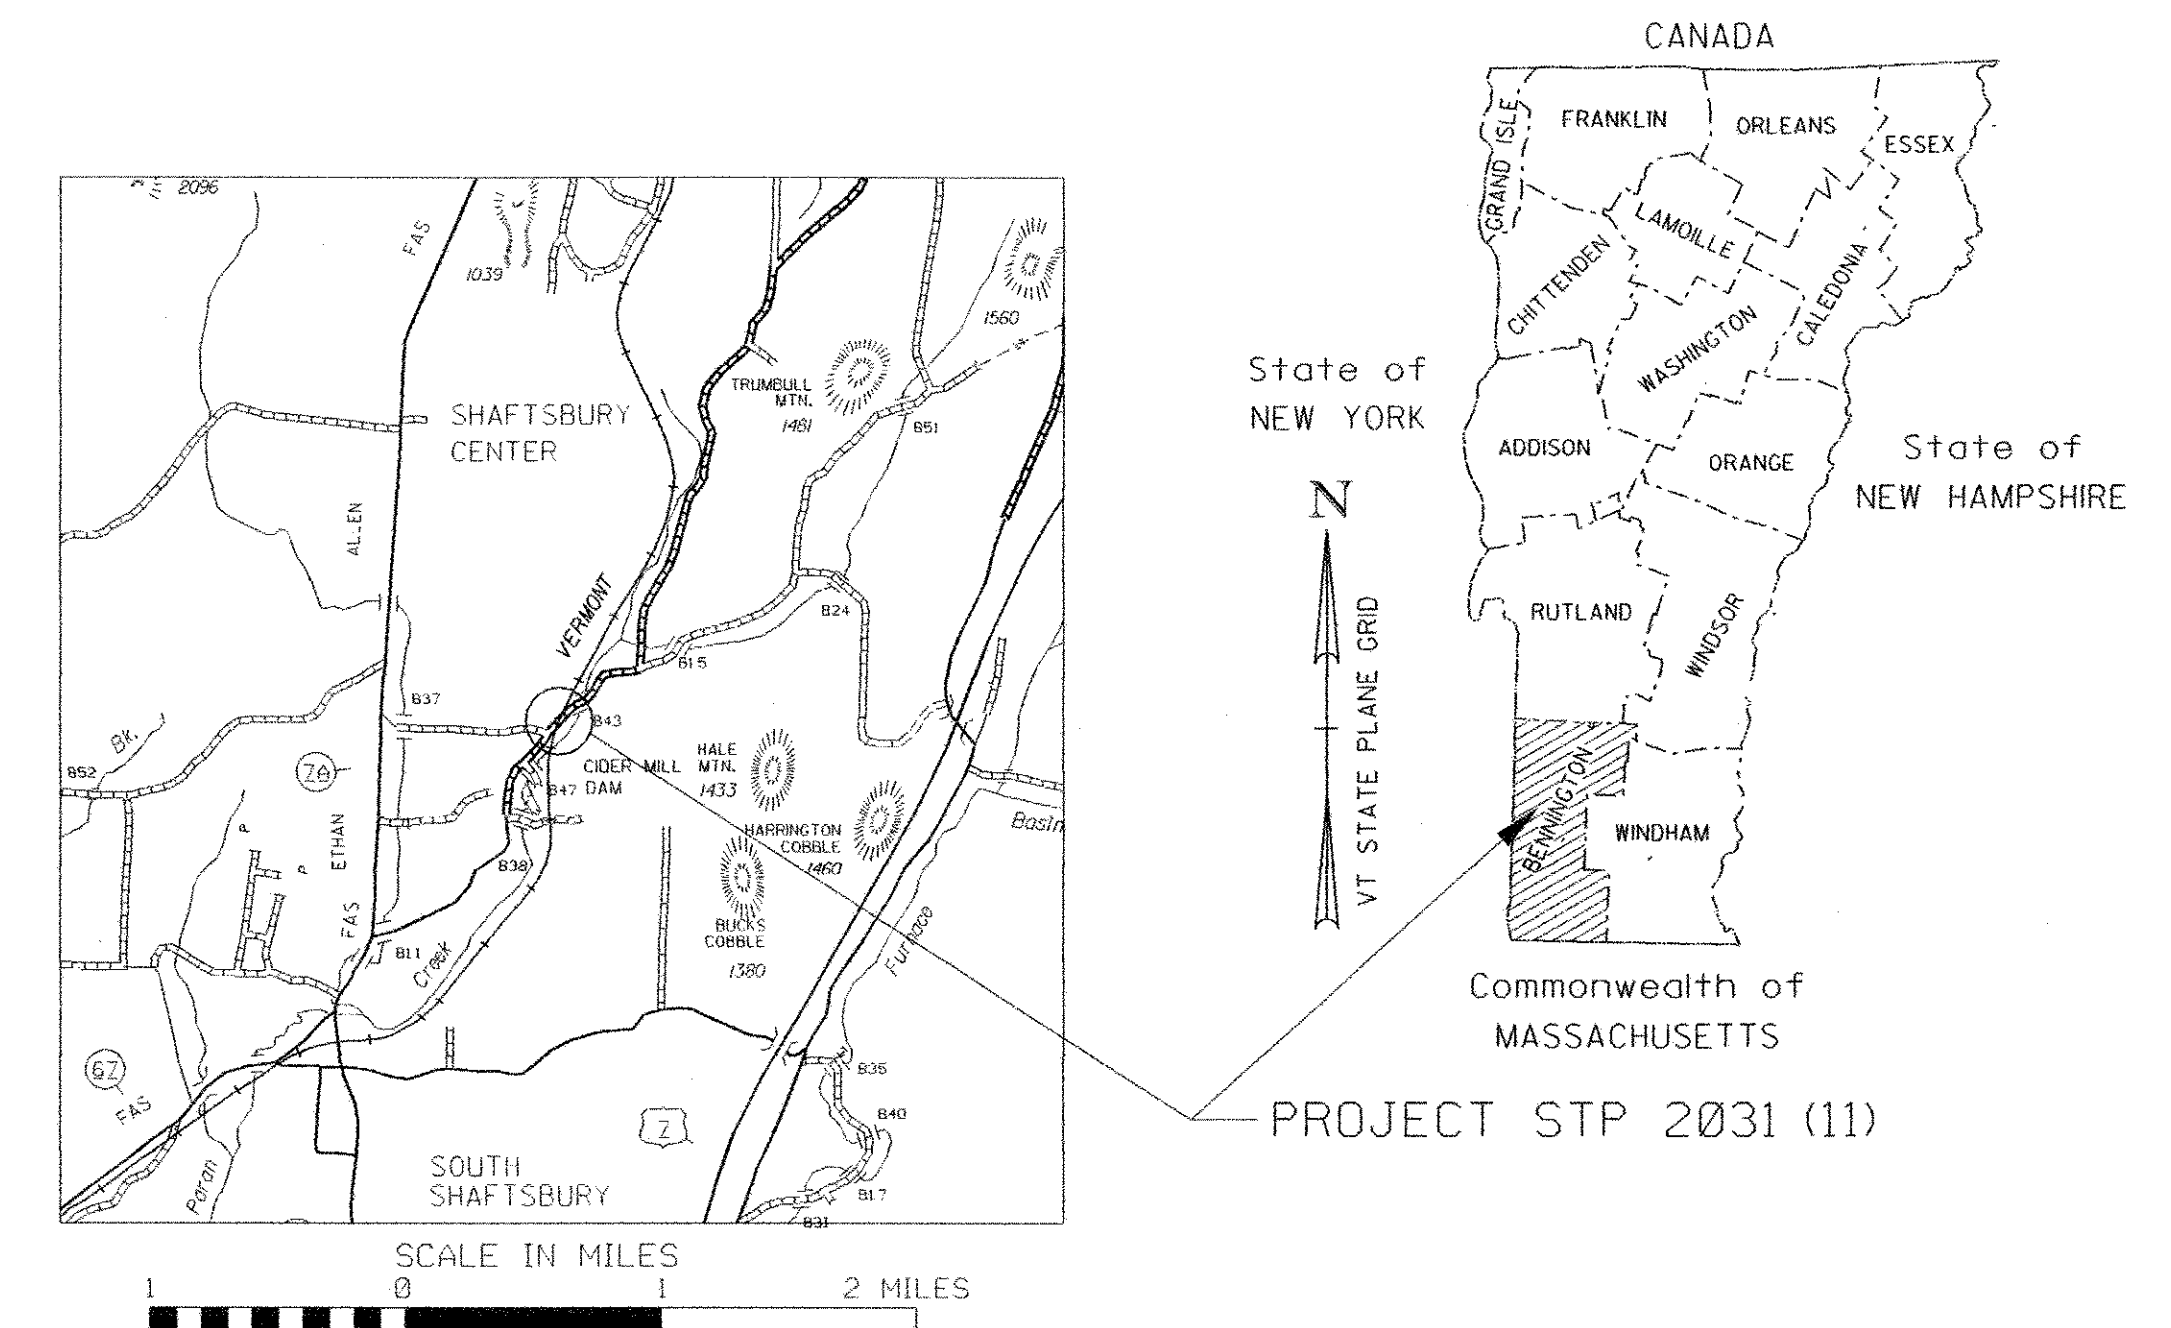


TRAFFIC DATA

- RAILROAD: V=25MPH (PASSENGER OPERATING SPEED)
- V=30MPH (FREIGHT OPERATING SPEED)
- V=59MPH (PASSENGER DESIGN SPEED)
- V=40MPH (FREIGHT DESIGN SPEED)
- APRIL 2006
- HIGHWAY: V=35MPH
- ADT=350 (1999 ESTIMATED)

GENERAL NOTES

- ALL WORK IS TO BE PERFORMED WITHIN THE RAILROAD AND HIGHWAY RIGHT-OF-WAY

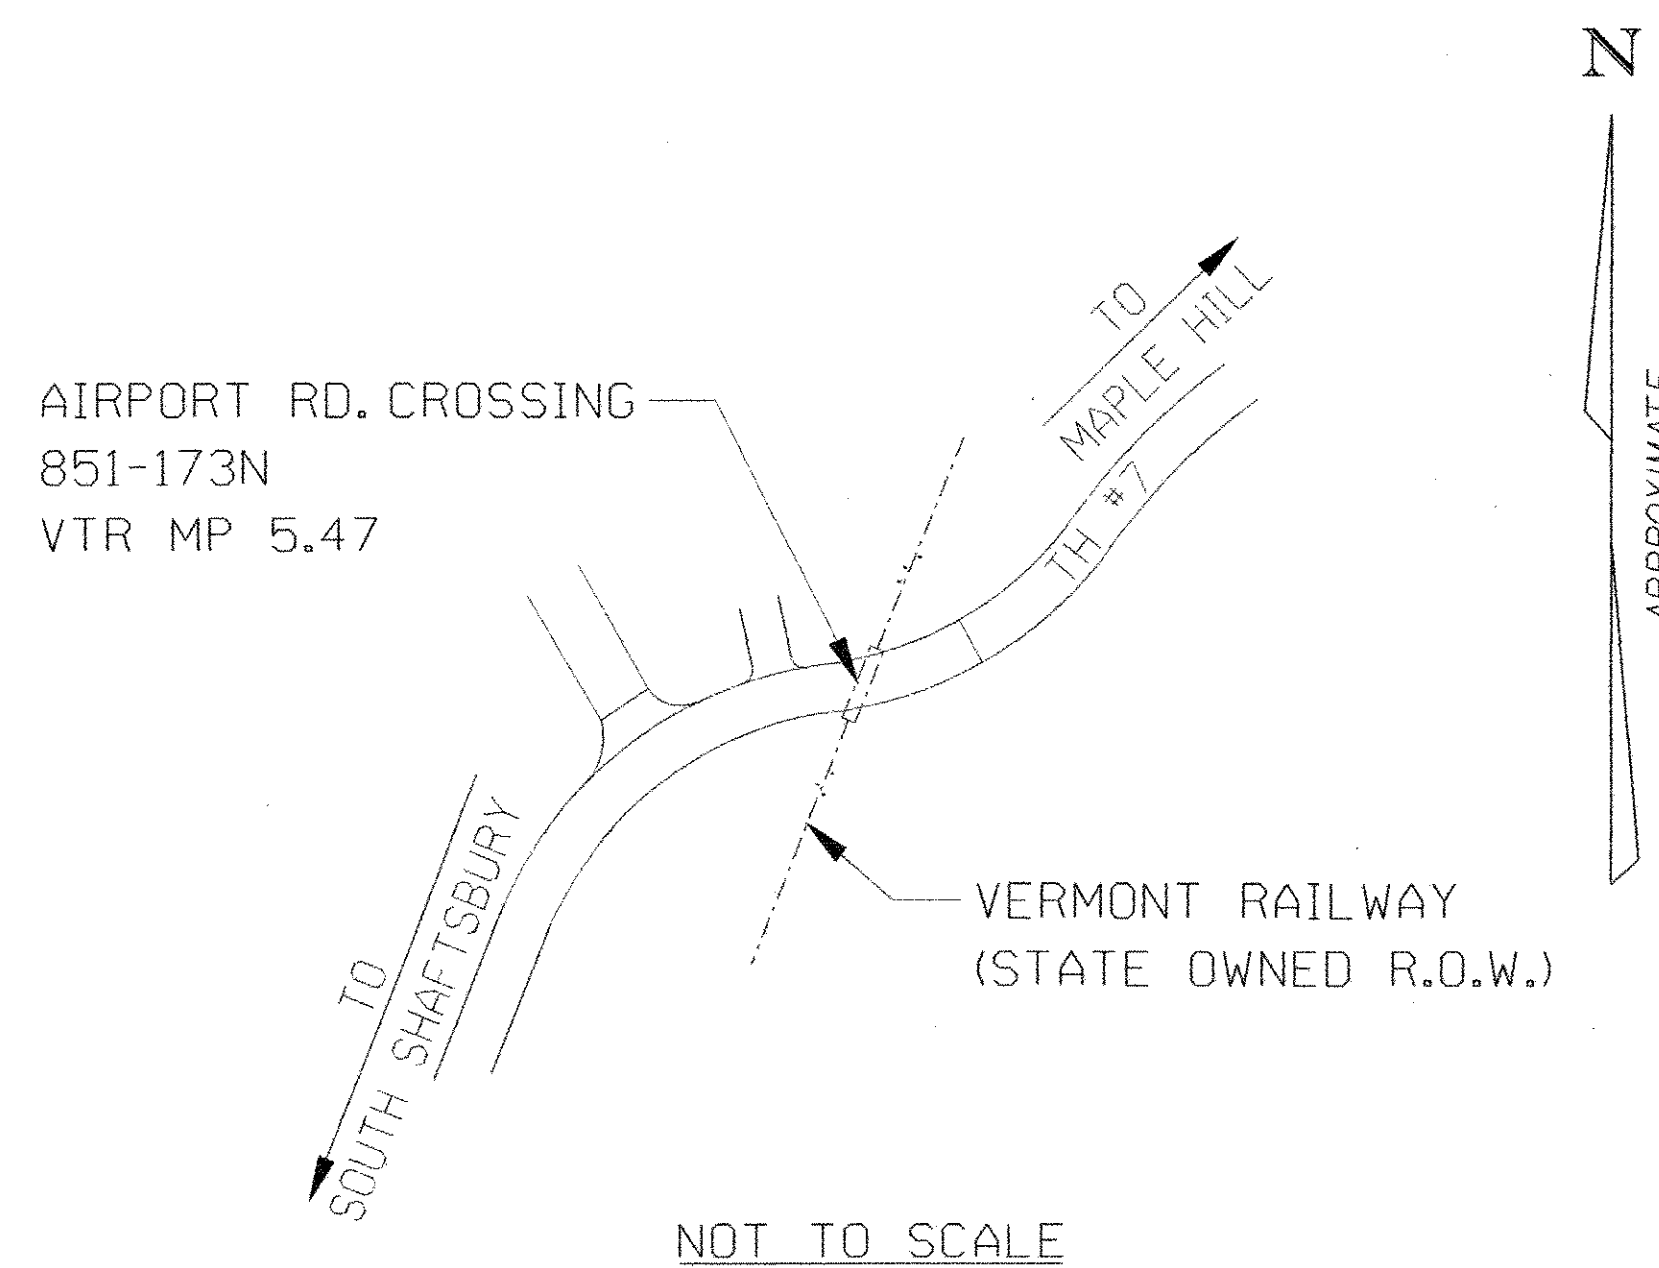


**CONVENTIONAL SYMBOLS**

COUNTY LINE	
TOWN LINE	
LIMITS OF ACCESS	
POINT OF ACCESS	
FENCE LINE	
STONE WALL	
TRAVELED WAY	
GUARD RAIL	
RAILROAD	
SURVEY LINE	
CULVERT	
POWER POLE	
TELEPHONE POLE	
TREES	
CONTROL OF ACCESS	
PROPERTY LINE	
R.O.W. TAKING LINE	
SLOPE RIGHTS	
TOP OF CUT	
TOE OF SLOPE	

SURVEYED BY : N/A  
SURVEYED DATE : N/A

DATUM  
VERTICAL N/A  
HORIZONTAL N/A

**TransSystems Corporation**  
ONE CABOT ROAD, MEDFORD MA 02155 (781) 396-7775

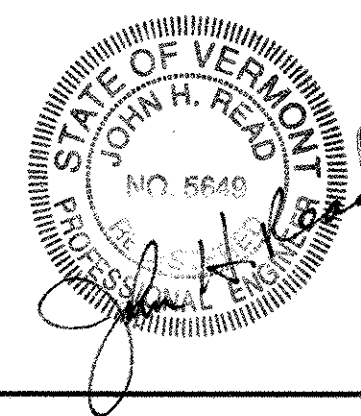

THESE PLANS ARE SUBJECT TO SUCH ENGINEERING CHANGES AS MAY BE REQUIRED BY THE FEDERAL HIGHWAY ADMINISTRATION OR THE DIRECTOR OF PROGRAM DEVELOPMENT.

CONSTRUCTION IS TO BE CARRIED ON IN ACCORDANCE WITH THESE PLANS AND THE STANDARD SPECIFICATIONS FOR CONSTRUCTION DATED 2001, AS APPROVED BY THE FEDERAL HIGHWAY ADMINISTRATION ON JANUARY 4, 2001 FOR USE ON THIS PROJECT, INCLUDING ALL SUBSEQUENT REVISIONS AND SUCH REVISED SPECIFICATIONS AND SPECIAL PROVISIONS AS ARE INCORPORATED IN THESE PLANS.

PROJECT MANAGER : JENNIFER ROYER


PROJECT NAME : SHAFTSBURY  
PROJECT NUMBER : STP 2031 (11) TH #7

SHEET 15 OF 21 SHEETS

DEET'S CROSSING

SUMMARY OF WORK:

1. REMOVE EXISTING R15-1 SIGNS, AND W10-1 SIGNS; STOCKPILE IN A LOCATION DESIGNATED BY THE ENGINEER.
2. INSTALL NEW POWER DROP POLES, METER, AND CIRCUIT BREAKERS. ESTABLISH ELECTRIC SERVICE.
3. INSTALL NEW 4'x6" SIGNAL CASE ON PROPOSED GRAVEL MOUND.
4. INSTALL NEW CANTILEVER, SIGNAL MASTS, 12" LED LIGHTS, R15-1 CROSSBUCKS, MAST REFLECTORS, WIRES AND BELL AS INDICATED ON THE PLANS, DETAILS, AND STANDARDS.
5. INSTALL NEW DOUBLE YELLOW CENTER LINES, RAILROAD CROSSING PAVEMENT MARKINGS, AND W10 SIGNS AS INDICATED ON THE PLANS, DETAILS, AND STANDARDS.

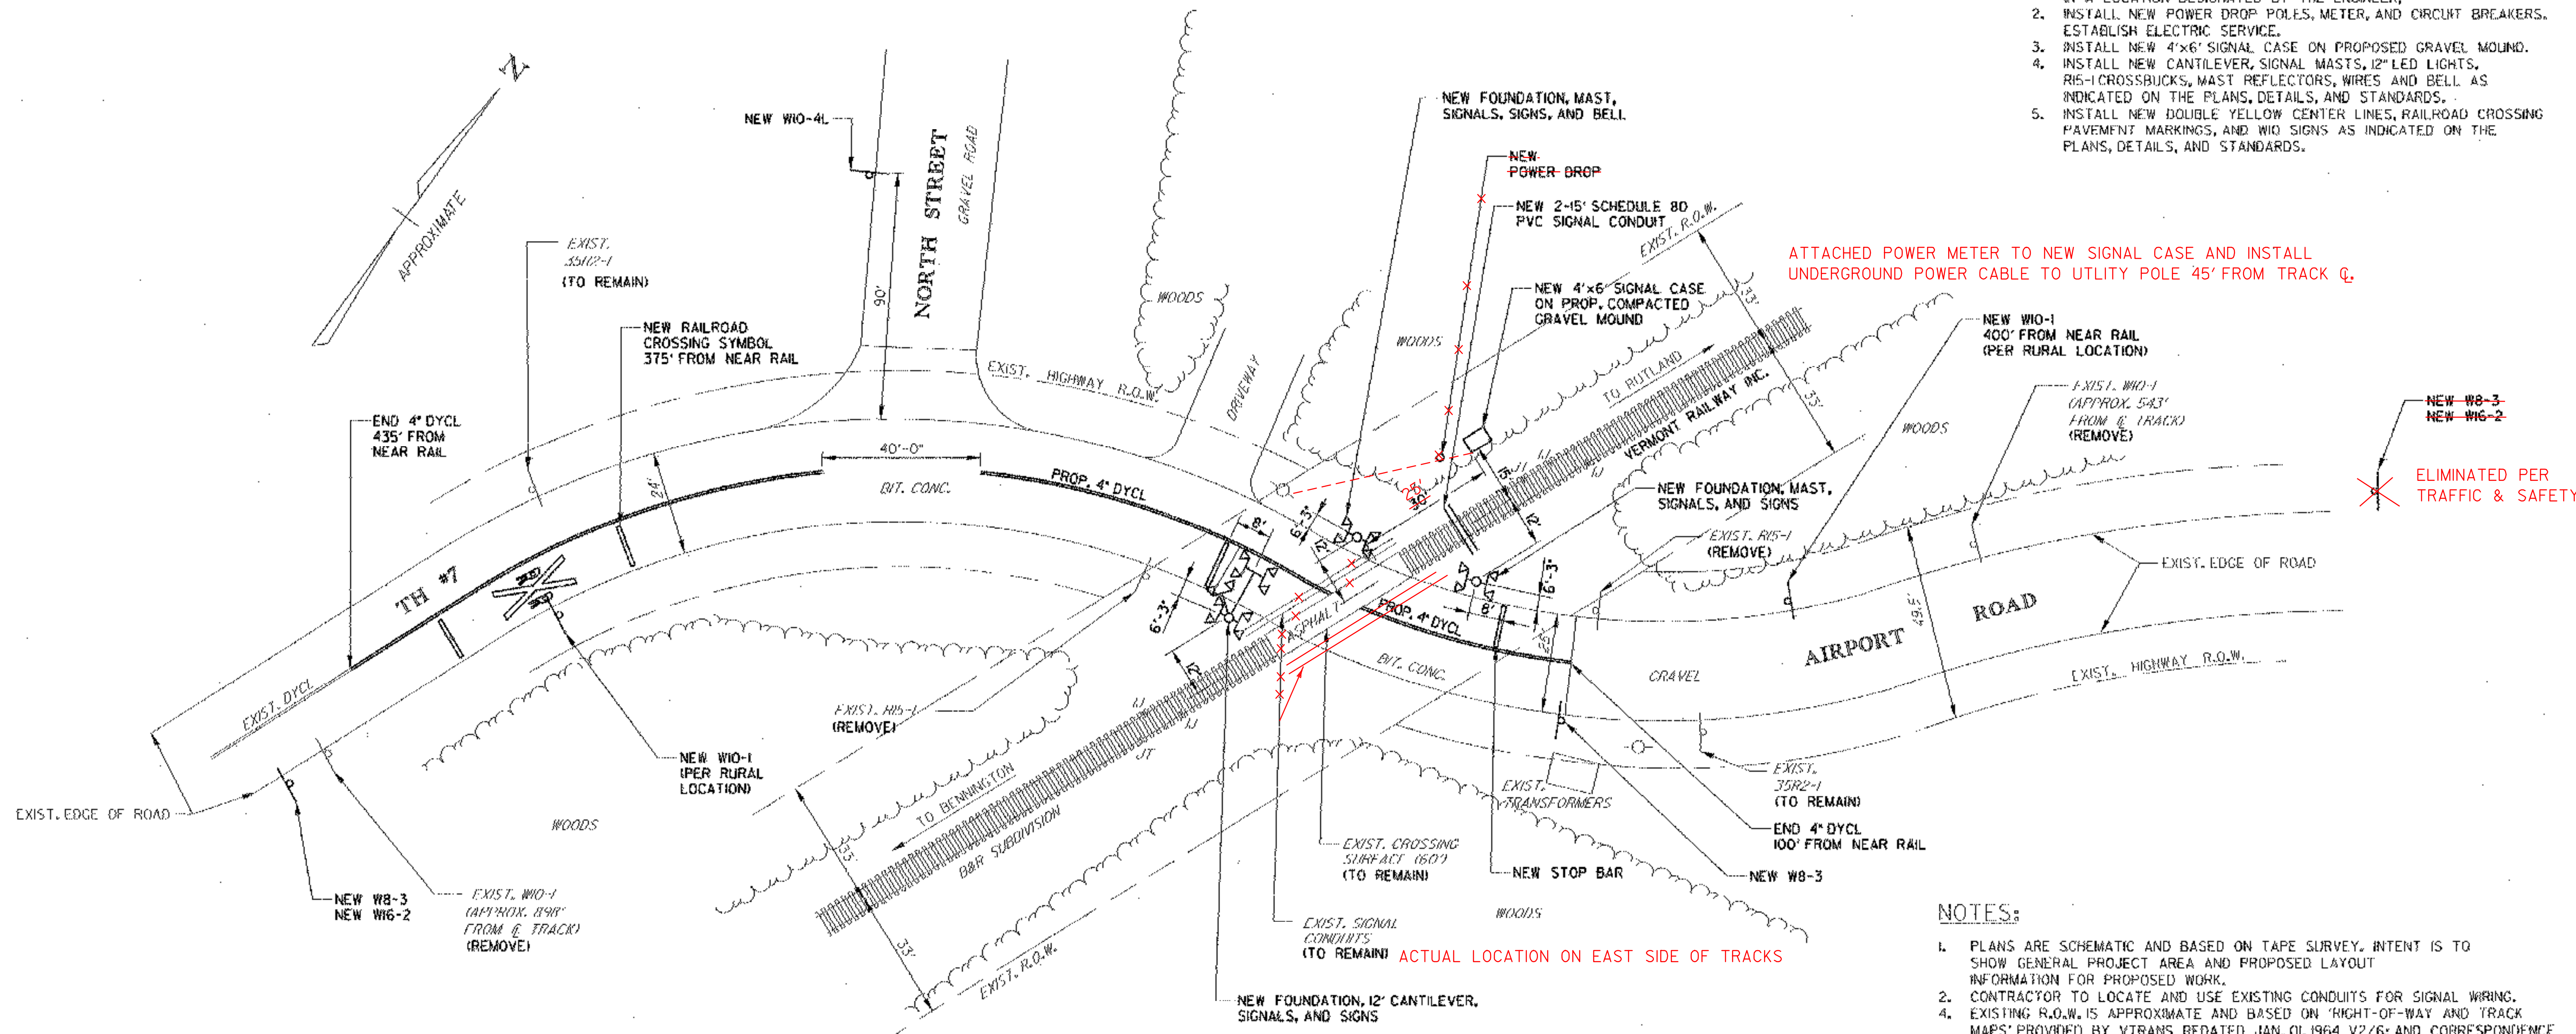

ATTACHED POWER METER TO NEW SIGNAL CASE AND INSTALL UNDERGROUND POWER CABLE TO UTILITY POLE 45' FROM TRACK Q.

ELIMINATED PER TRAFFIC & SAFETY

NOTES:


1. PLANS ARE SCHEMATIC AND BASED ON TAPE SURVEY. INTENT IS TO SHOW GENERAL PROJECT AREA AND PROPOSED LAYOUT INFORMATION FOR PROPOSED WORK.
2. CONTRACTOR TO LOCATE AND USE EXISTING CONDUITS FOR SIGNAL WIRING.
3. EXISTING R.O.W. IS APPROXIMATE AND BASED ON 'RIGHT-OF-WAY AND TRACK MAPS' PROVIDED BY VTTRANS REDATED JAN. 01, 1964 V2/G; AND CORRESPONDENCE WITH LOCAL TOWN HIGHWAY DEPARTMENT AUGUST 2004.
4. WELDED RAIL BONDS SHALL BE INSTALLED AT ALL JOINTS WITHIN THE LIMITS OF THE PREDICTOR SYSTEM THAT HAVE NOT BEEN PREVIOUSLY BONDED. EXISTING RAIL BONDS THAT DO NOT MEET THE SPECIFICATIONS SHALL BE REMOVED AND A NEW BOND SHALL BE INSTALLED.
5. THE APPROACH CIRCUITS SHALL BE SET FOR 30 SEC. AT THE MAX. SPEED INDICATED ON THE COVER OF THESE PLANS FOR THIS CROSSING.
6. THE LENGTH OF POST SHOWN IN THE TRAFFIC SIGN SUMMARY SHEET ASSUMES 8 FEET FROM THE GROUND SURFACE TO THE BOTTOM OF THE SIGN. IF FIELD DISTANCE IS GREATER THAN 8 FEET CONSULT ENGINEER BEFORE INSTALLING. REVISED SV VALUES BASED ON A 70 MPH DESIGN SPEED WERE USED TO DESIGN SIGNPOSTS.
7. THE CONTRACTOR WILL COVER, WITH TARPS AT THE END OF EACH WORK-DAY, ANY EXPOSED EXCAVATED BACK-DIRT. ALL DISTURBED SOIL WILL BE SEED AND MULCHED AT THE COMPLETION OF THE PROJECT. THIS WORK WILL BE CONSIDERED INCIDENTAL TO OTHER CONTRACT ITEMS. SEE ITEM 654, SEEDING.

PLAN - AIRPORT ROAD  
AARDOT # 851-173N


NTS

PROJECT NAME:	SHAFTSBURY	FILE NAME:	Z01G162BDR.DGN	PLOT DATE:	08-MAY-2006
PROJECT NUMBER:	STP 2031(II) TH #7	PROJECT LEADER:	D. BUA	DRAWN BY:	LB
		DESIGNED BY:	ASL	CHECKED BY:	BUA
				SHEET	16 OF 21



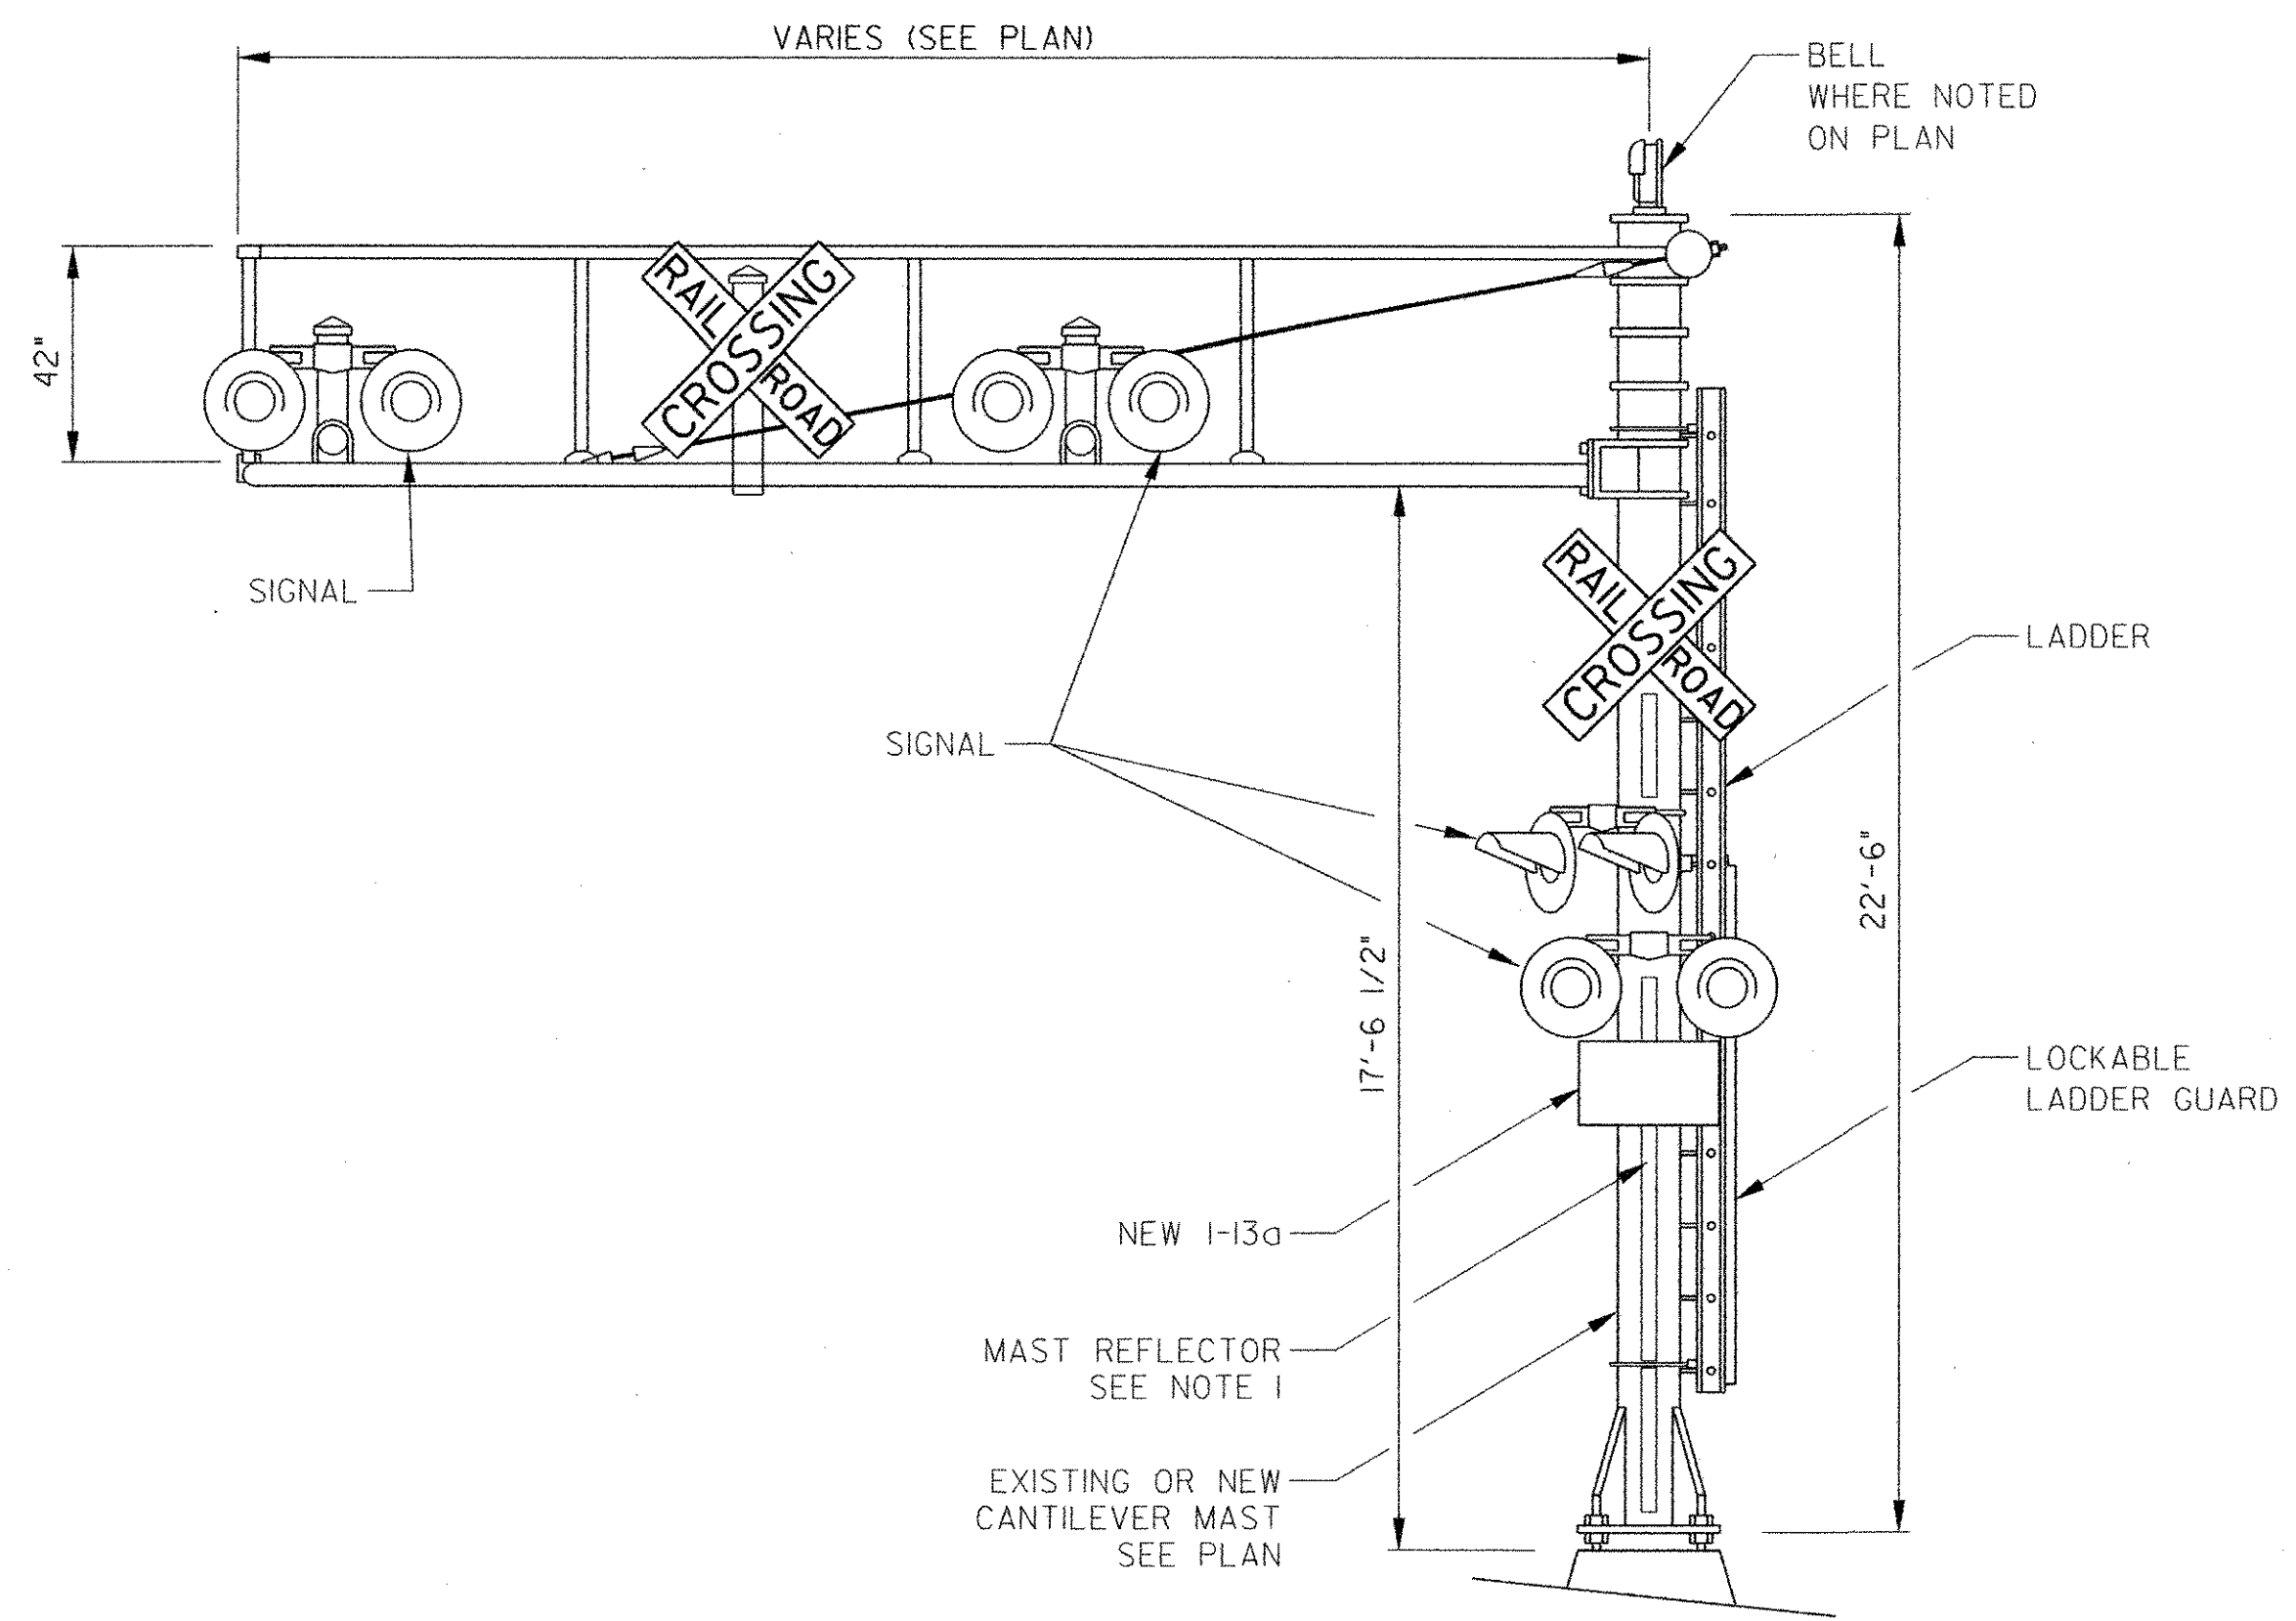


**TYPICAL RAILROAD CANTILEVER SIGNAL DETAIL**  
NTS

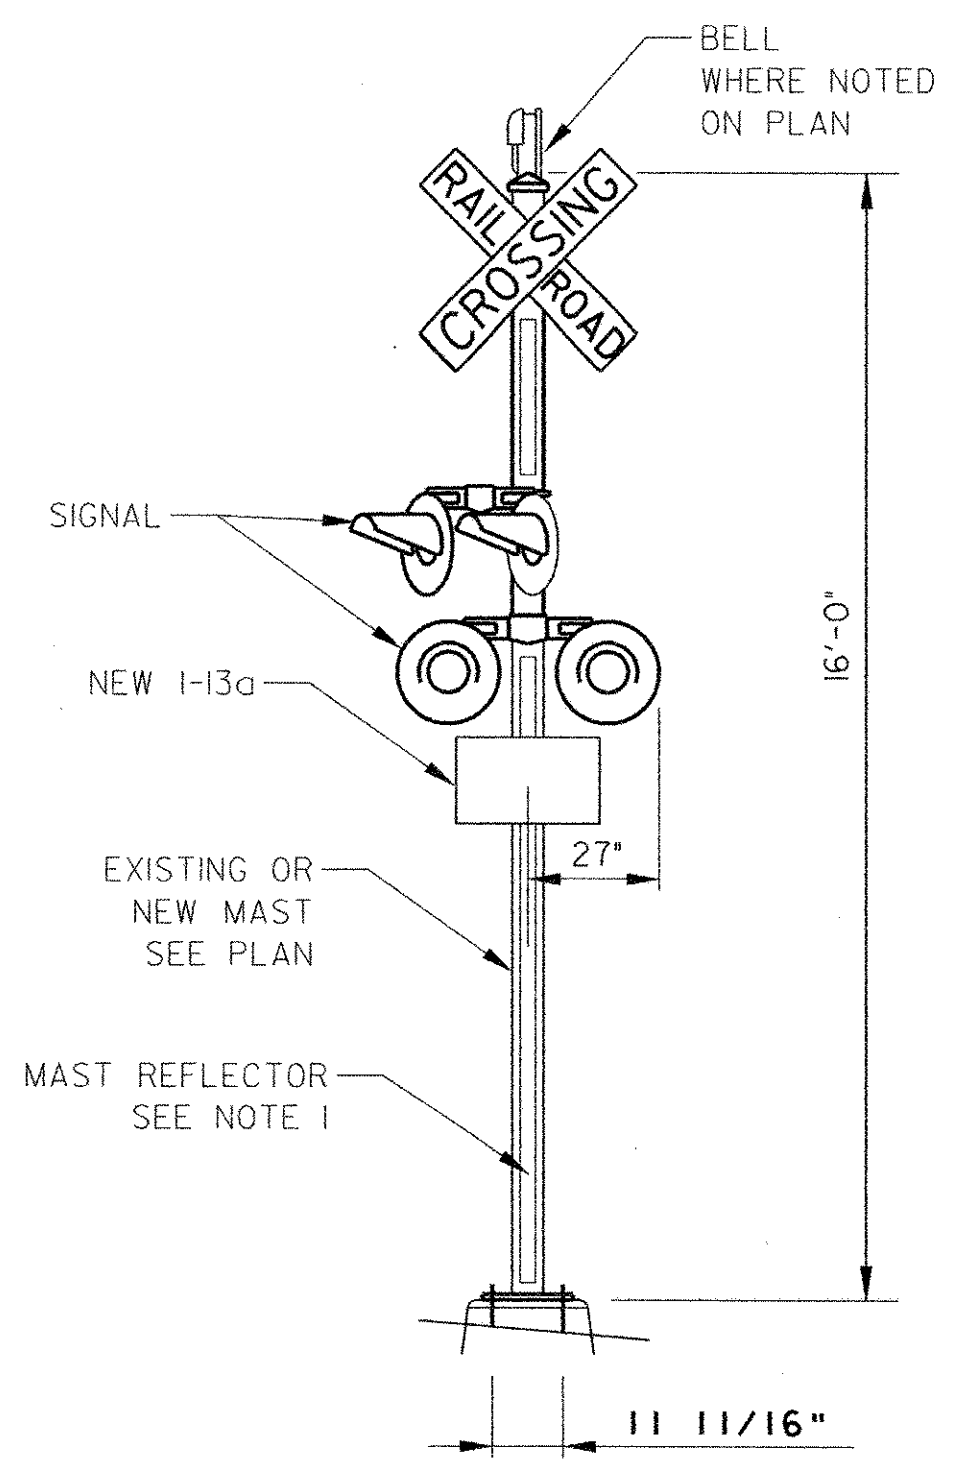


**TYPICAL RAILROAD SIGNAL DETAIL**  
NTS

**NOTES:**


1. A STRIP OF ASTM TYPE III OR TYPE V RETROREFLECTIVE WHITE MATERIAL NOT LESS THAN 2 INCHES IN WIDTH, SHALL BE USED ON EACH SUPPORT AT HIGHWAY-RAIL GRADE CROSSING FOR THE FULL LENGTH OF THE FRONT AND BACK OF THE SUPPORT FROM THE CROSSBUCK SIGN OR NUMBER OF TRACKS SIGN TO NEAR GROUND LEVEL.
2. PLACE A MINIMUM OF (3) I-13a SIGNS AT EACH CROSSING. ONE ON EACH SIDE OF THE CROSSING ON SIGNAL MASTS AND ONE ON THE SIGNAL CASE OR HOUSE.
3. FLASHING LIGHT SIGNAL EQUIPMENT SHALL BE 12" LED FLASHING LIGHT UNITS.

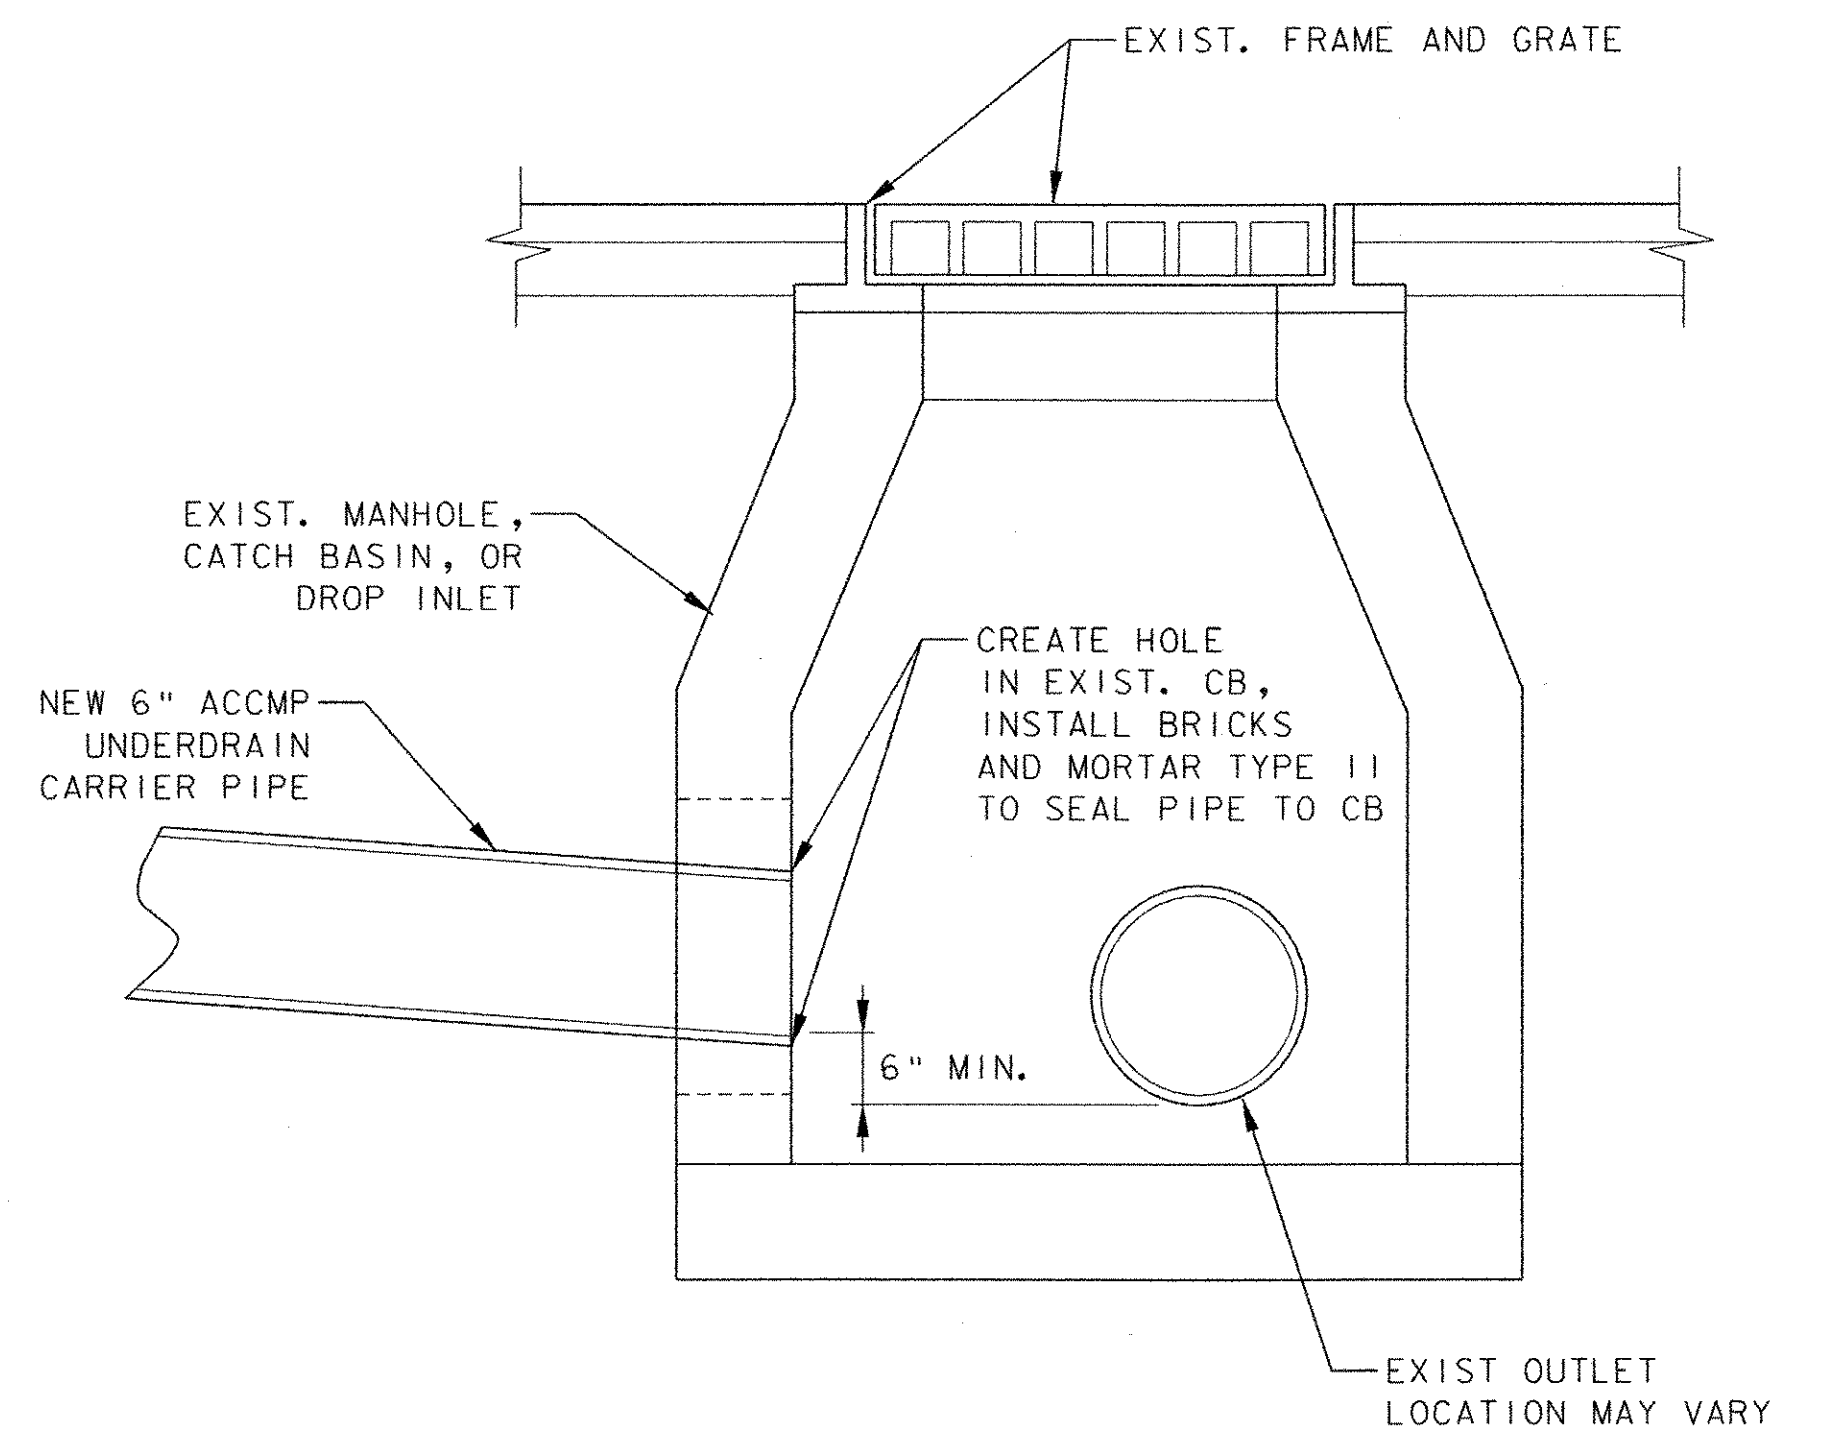

**UNDERDRAIN CONNECTION DETAIL**  
NTS

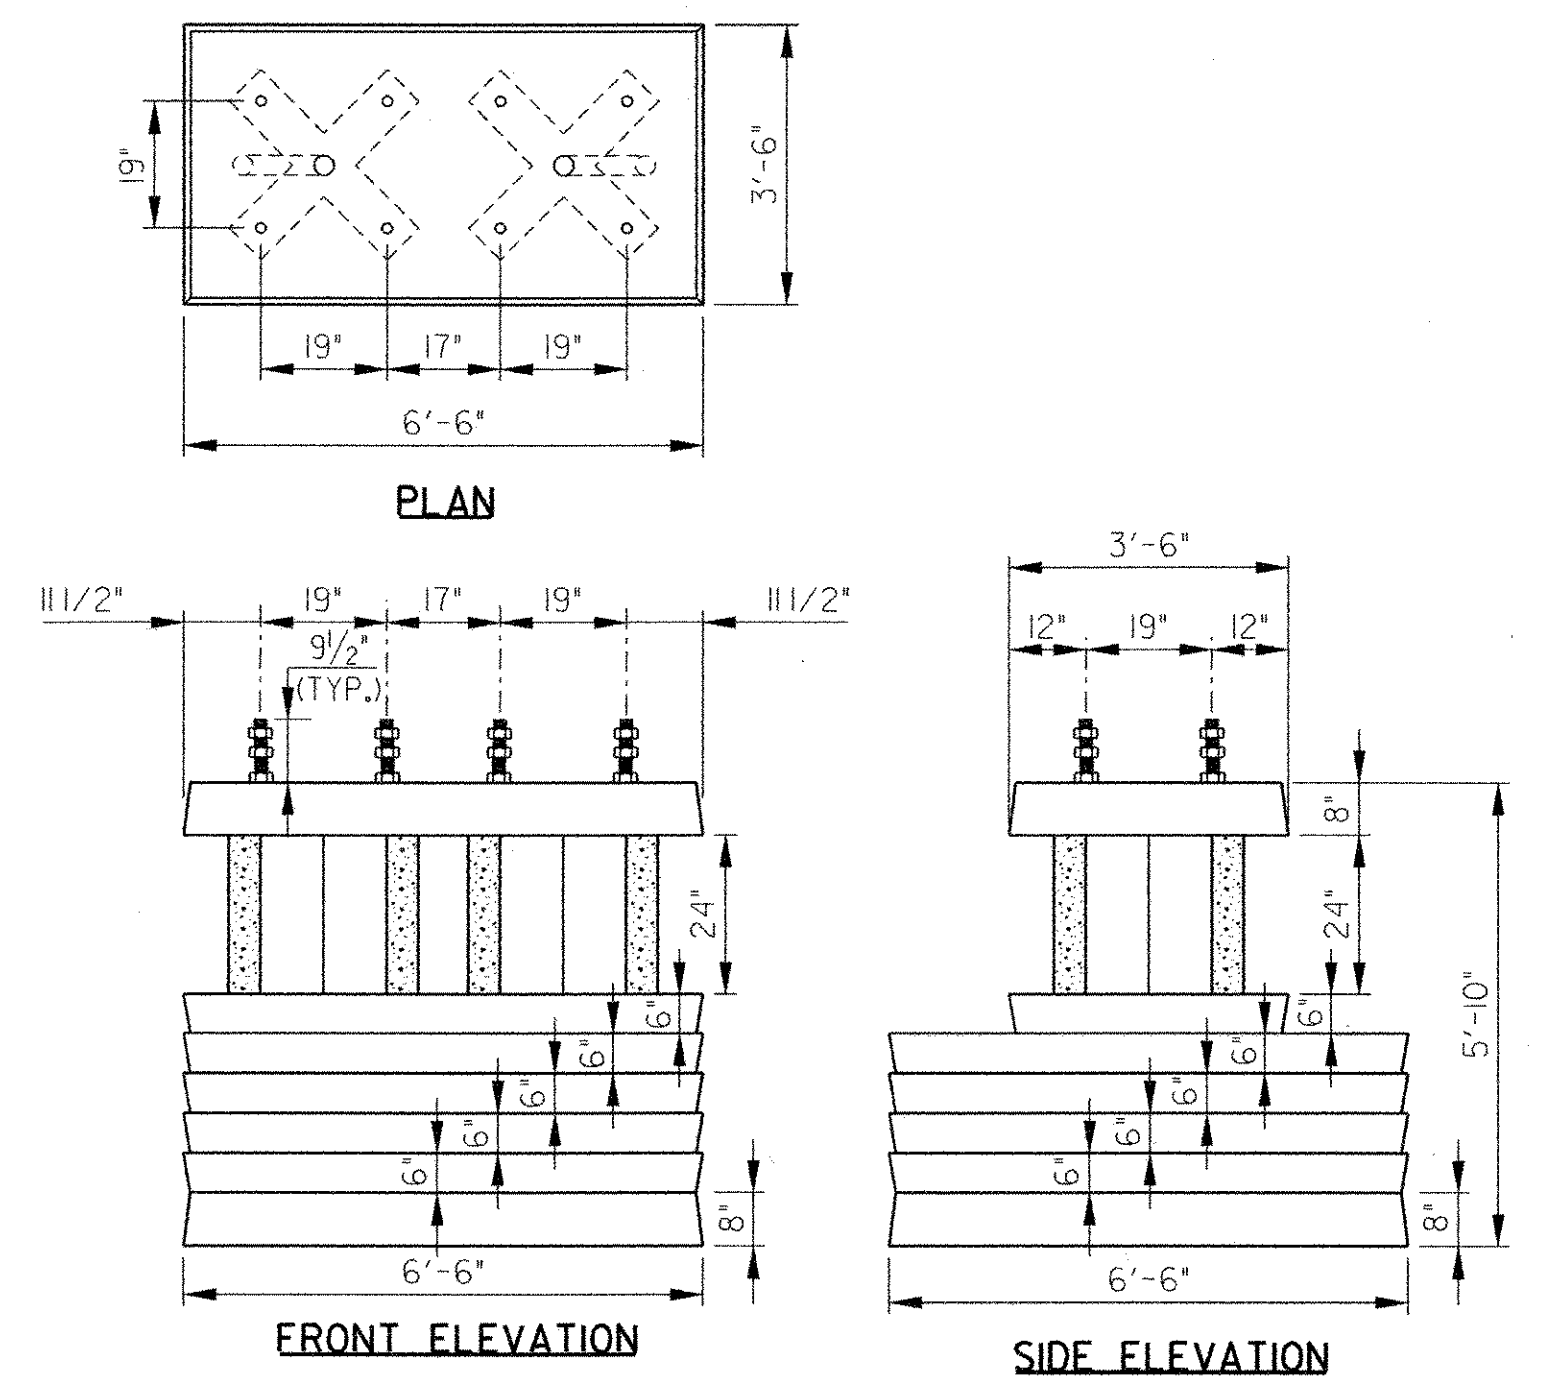


**TYPICAL DOUBLE MAST FOUNDATION DETAIL**  
NTS

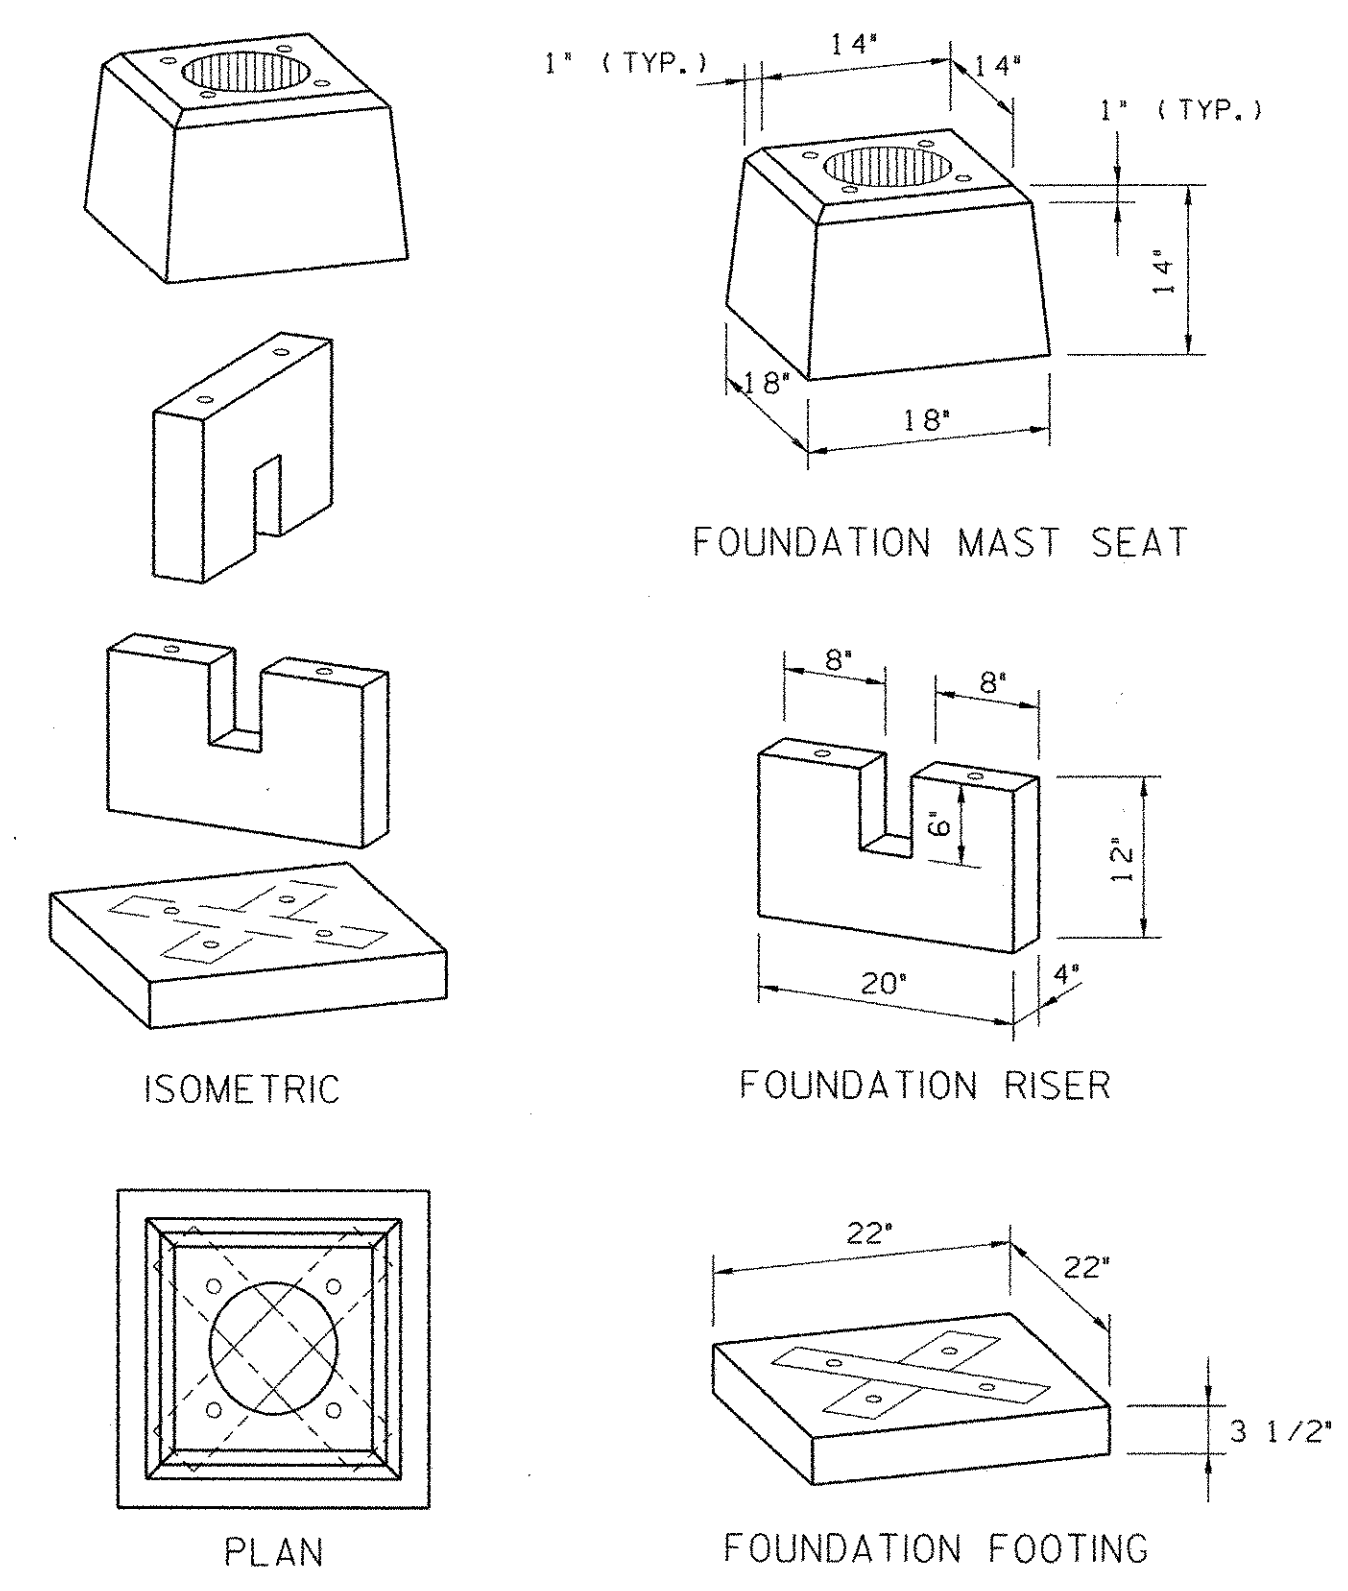

**TYPICAL FOUNDATION DETAIL**  
NTS

PROJECT NAME:	STATEWIDE RAILROAD X-ING - SOUTHERN		
PROJECT NUMBER:	STP 2031(10) TH#3; STP 1200(4) TH#1	STP 2031(12) TH#4; STP 0170(12) TH#9	STP 2031(11) TH#7
FILE NAME:	20IG58RRDETAILS.dgn		
PROJECT LEADER:	D. BUA	DRAWN BY:	TSC
DESIGNED BY:	ASL	CHECKED BY:	BUA
		SHEET	18 OF 21

P701030064

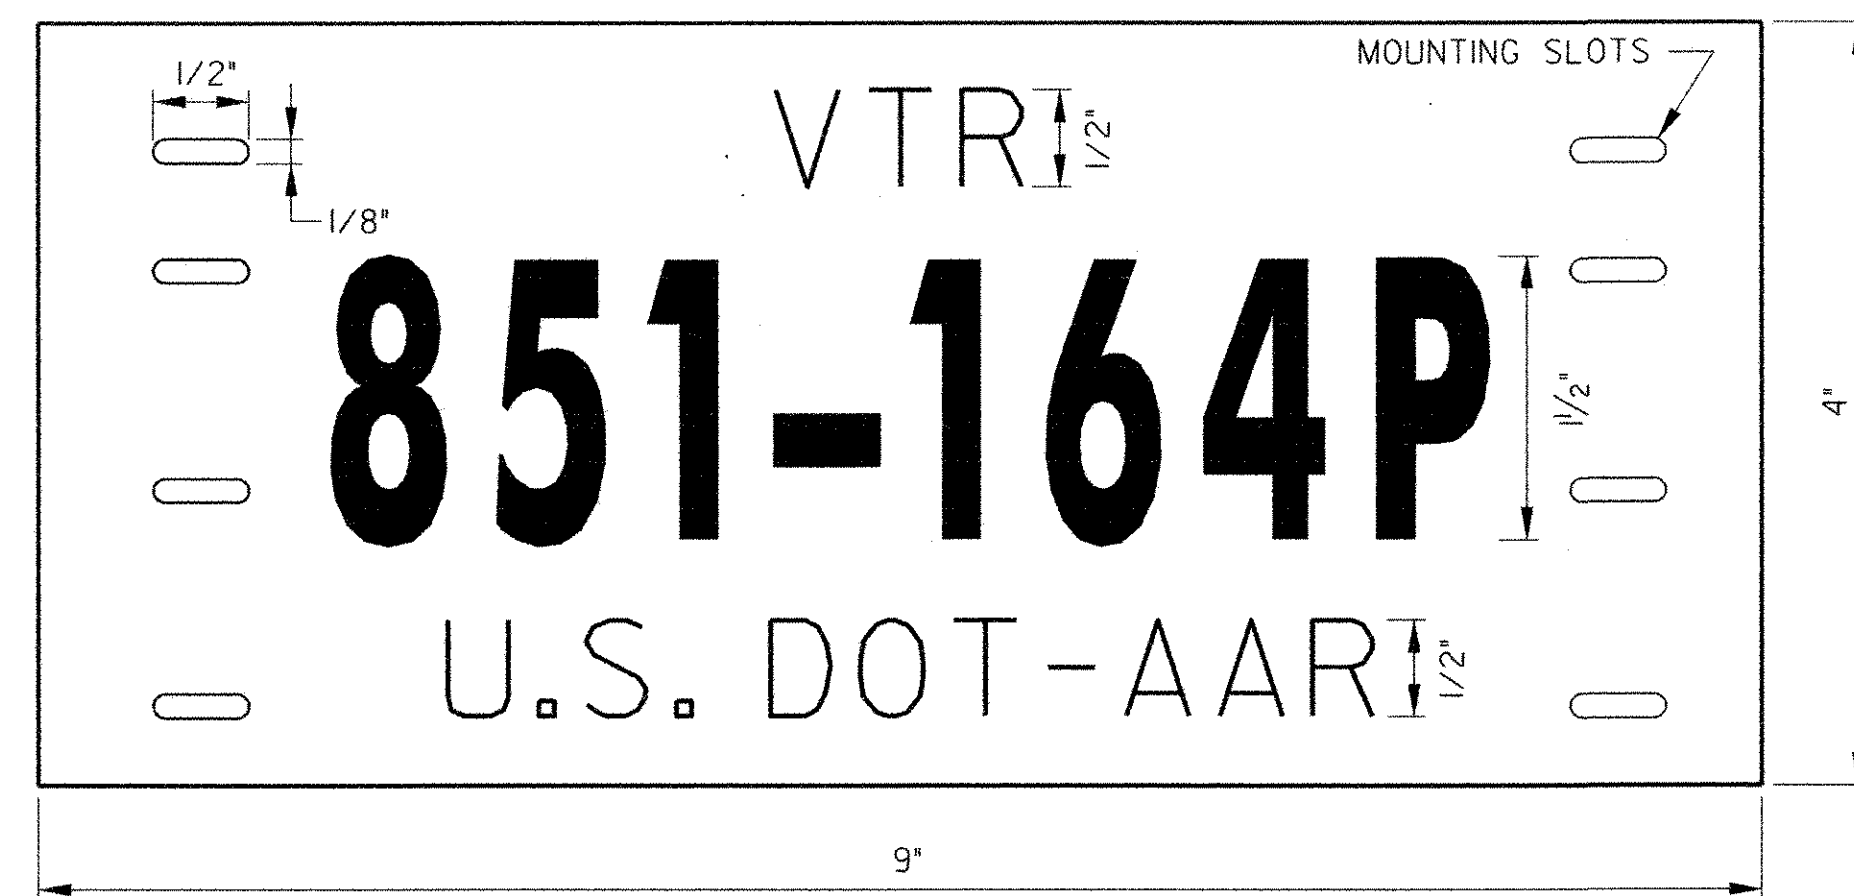

PERMANENT NUMBER SIGN


NTS

PERMANENT NUMBER SIGN NOTES:


- PERMANENT NUMBER SIGN PLATES SHALL BE MADE UP OF 0.032 GAGE ALUMINUM WITH RAISED NUMBERS AND LETTERS. SEE SPECIFICATIONS.
- SEE AARDOT TABLE FOR CROSSING NUMBERS.

AARDOT TABLE


BANK STREET	-	851-164P
MAIN STREET	-	851-165W
UNION STREET	-	851-199R
RICHVILLE ROAD	-	851-200H
AIRPORT ROAD	-	851-173N

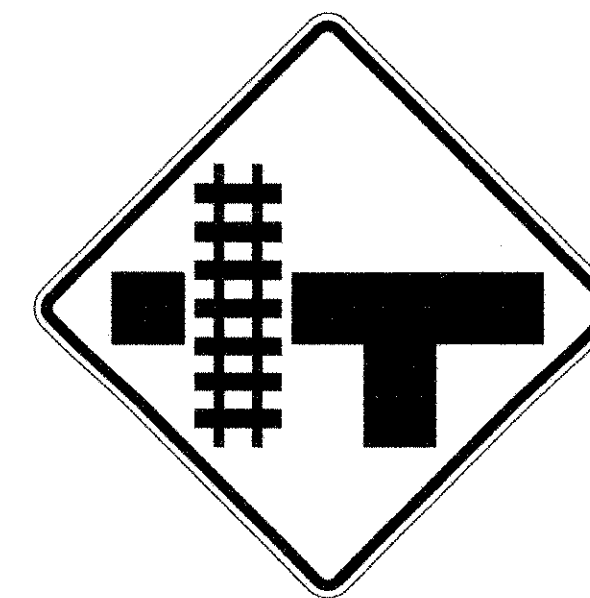


W10-4L SIGN

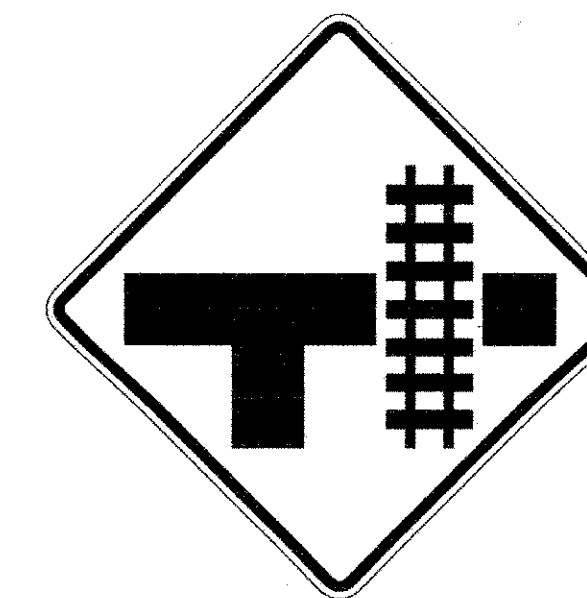

W10-4R SIGN

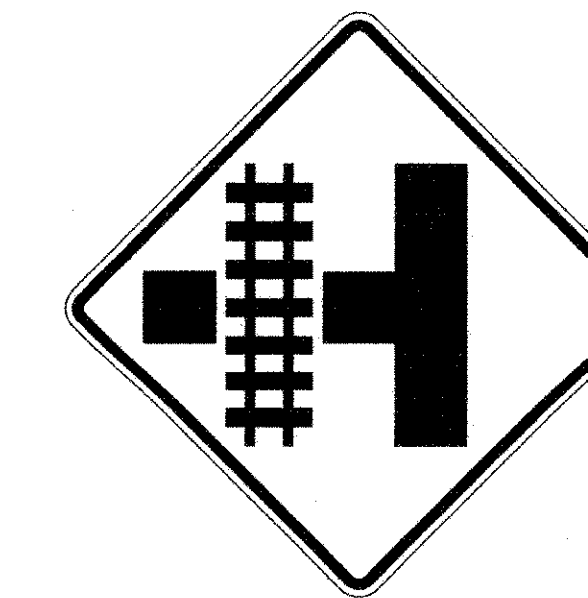


W10-3L SIGN

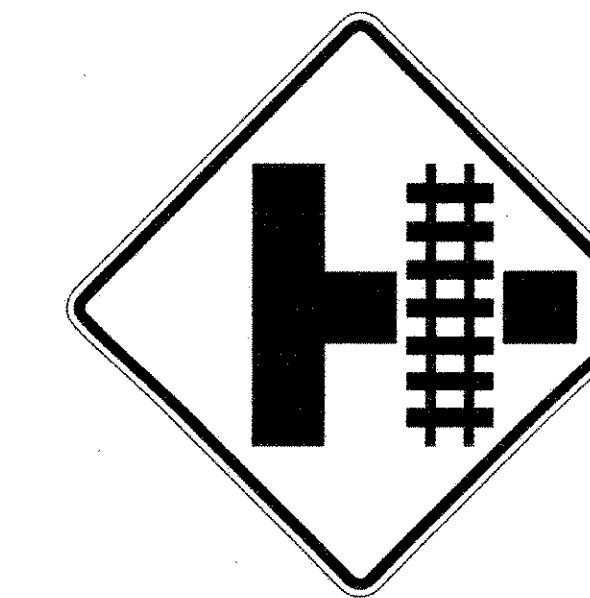

W10-3R SIGN

WARNING SIGN NOTES:

- THE COLORS, MATERIALS, LETTERING, DESIGN, AND SPECIFICATIONS SHALL CONFORM TO THE NOTES SHOWN ON VERMONT STANDARD E-152.

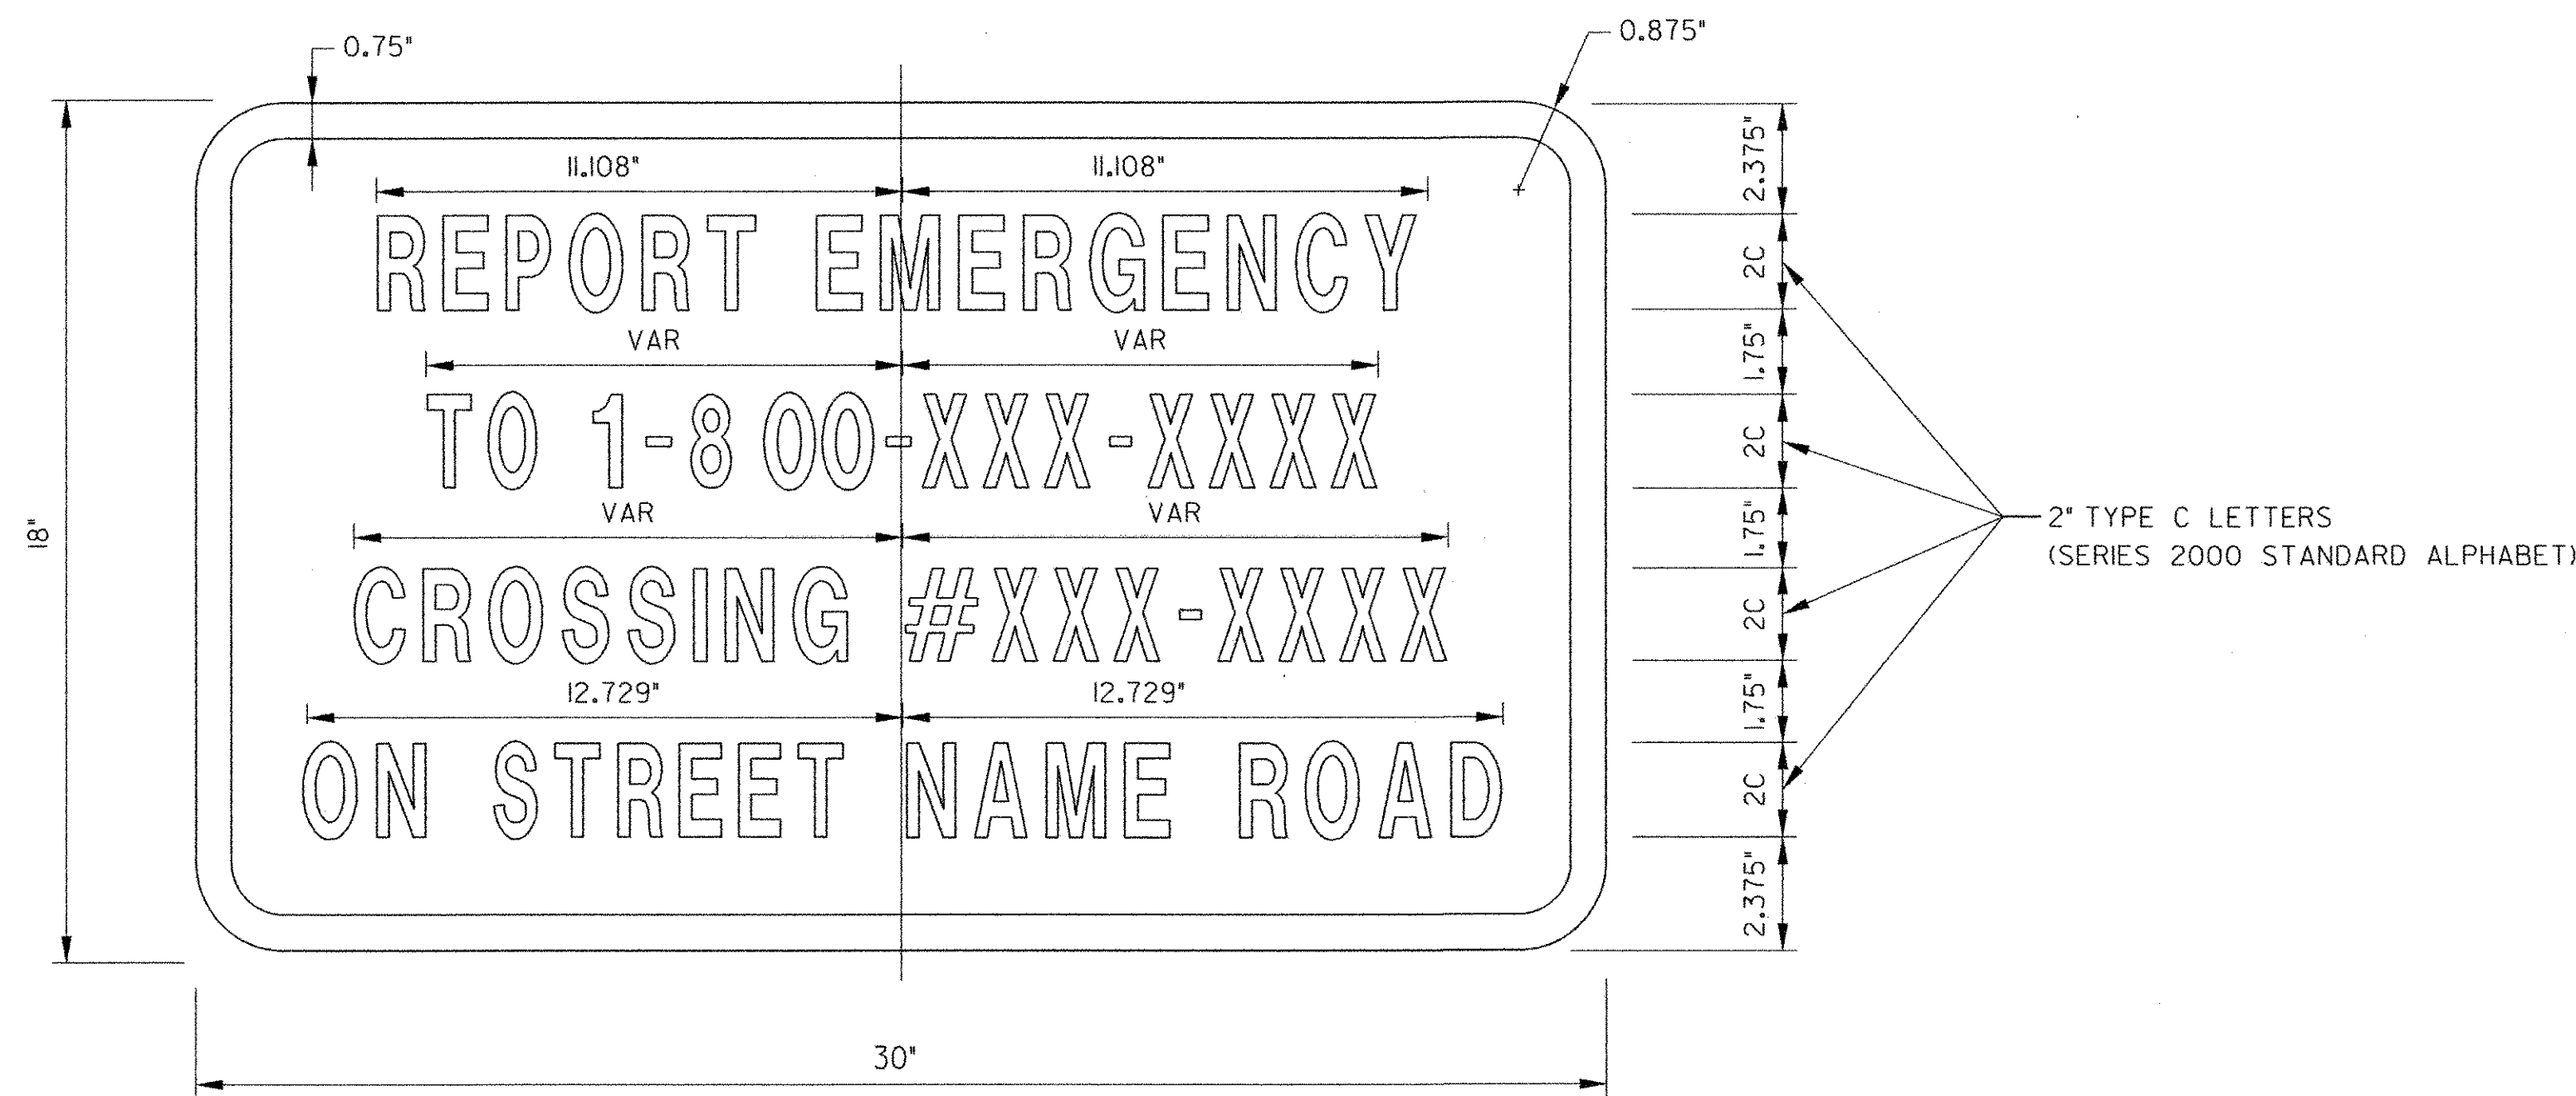

I-13a SIGN

COLORS: LEGEND BACKGROUND WHITE (RETROREFLECTIVE) BLUE (RETROREFLECTIVE)

GENERAL MOTORIST SERVICE SIGN NOTES:


- THE COLORS, MATERIALS, LETTERING, DESIGN, AND SPECIFICATION SHALL CONFORM TO THE NOTES SHOWN ON VERMONT STANDARD E-132.
- THE EMERGENCY CONTACT TELEPHONE NUMBER IS 1-888-265-2735
- PLACE A MINIMUM OF (3) I-13a SIGNS AT EACH CROSSING. ONE ON EACH SIDE OF THE CROSSING ON SIGNAL MASTS AND ONE ON THE SIGNAL CASE OR HOUSE.
- SEE AARDOT TABLE FOR CROSSING NUMBERS AND STREET NAMES.

PROJECT NAME: STATEWIDE RAILROAD X-ING - SOUTHERN


PROJECT NUMBER: STP 203(I) TH#3; STP 1200(4) TH#1  
STP 203(II) TH#4; STP 0170(12) TH#9  
STP 203(III) TH#7

FILE NAME: ZOIG58RRDETAILS.dgn  
PROJECT LEADER: D. BUA  
DESIGNED BY: ASL


PLOT DATE: 08-MAY-2006  
DRAWN BY: TSC  
CHECKED BY: BUA  
SHEET 19 OF 21

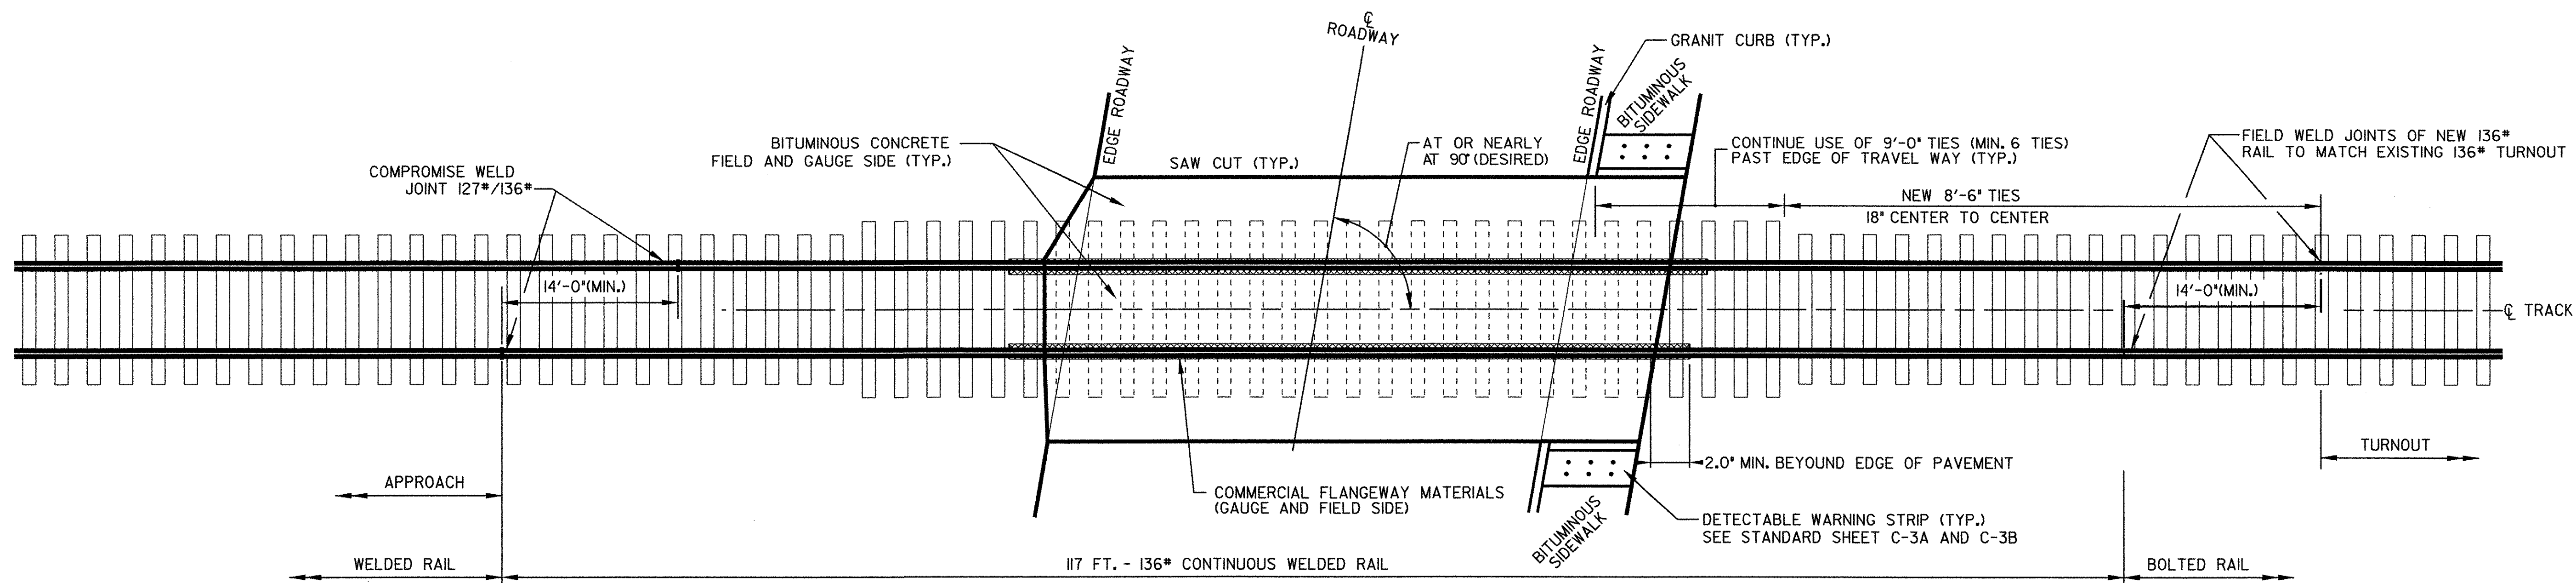


TYPICAL PLAN VIEW  
MAIN STREET CROSSING

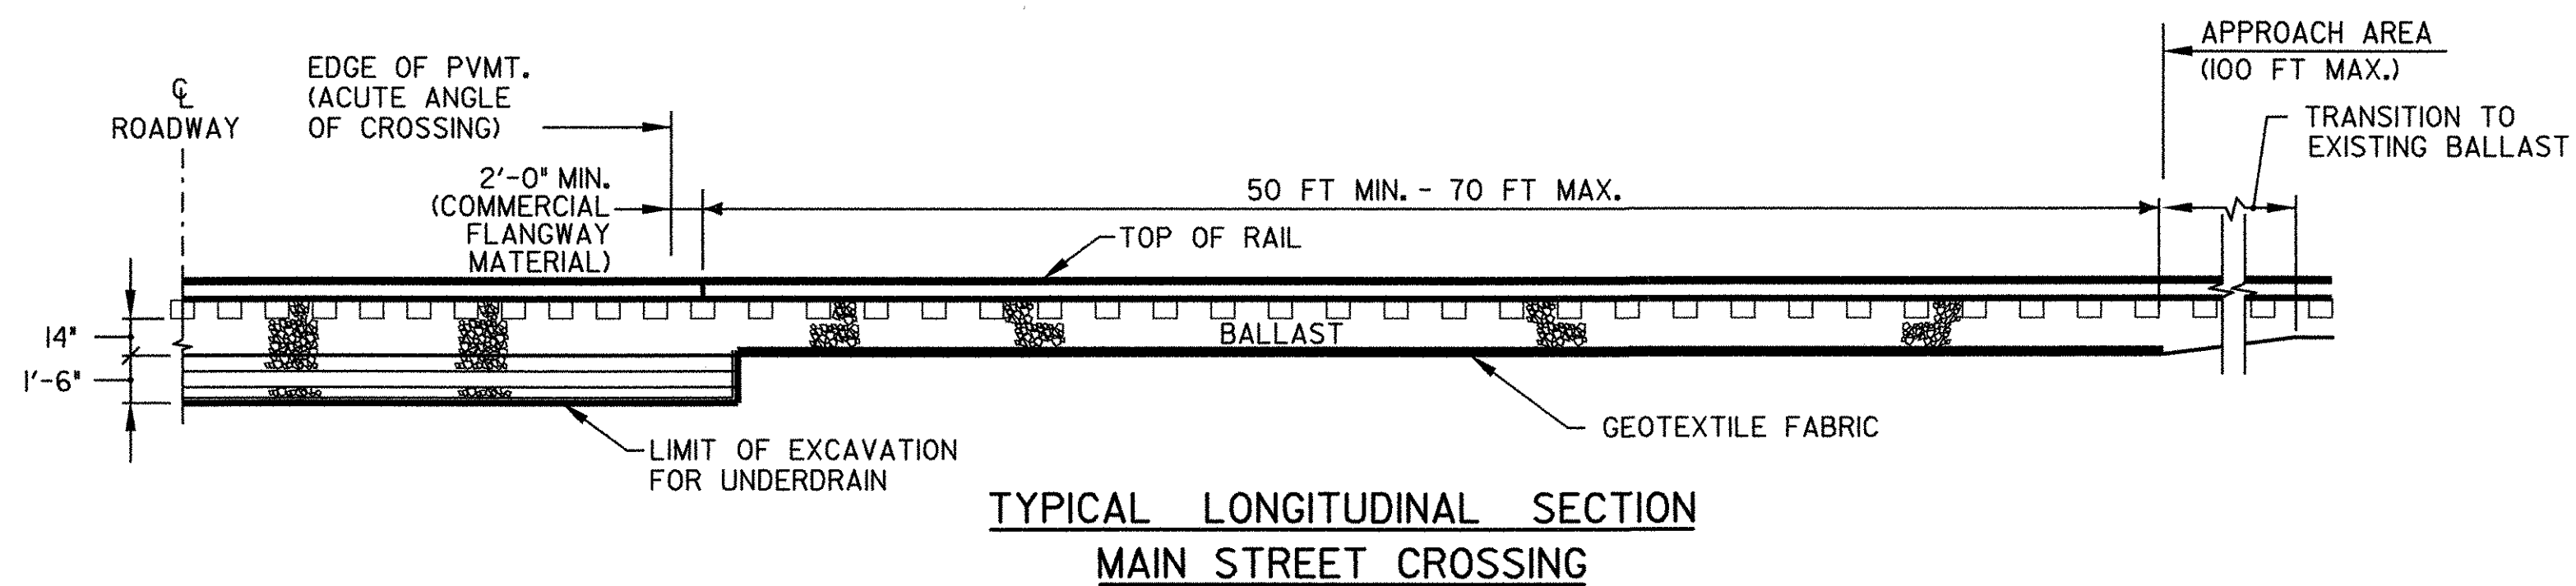

TYPICAL LONGITUDINAL SECTION  
MAIN STREET CROSSING

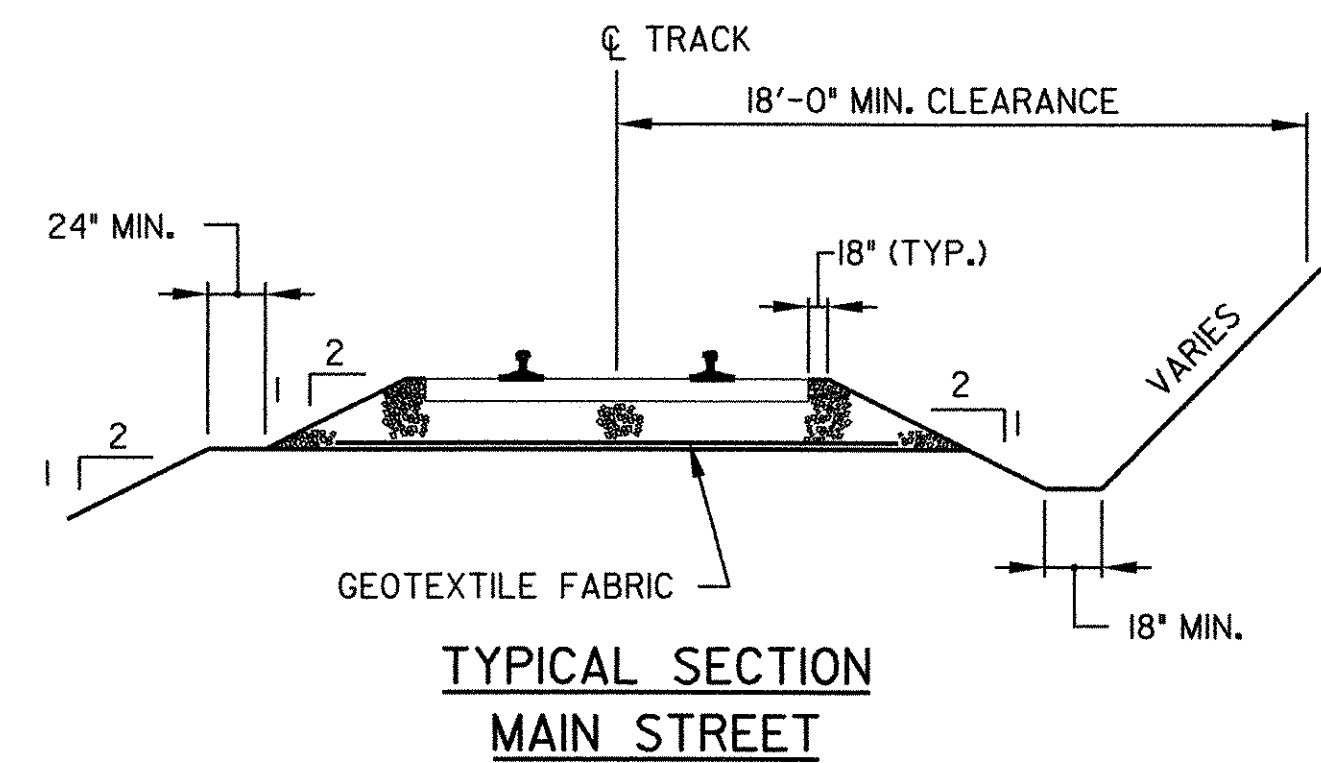

TYPICAL SECTION  
MAIN STREET

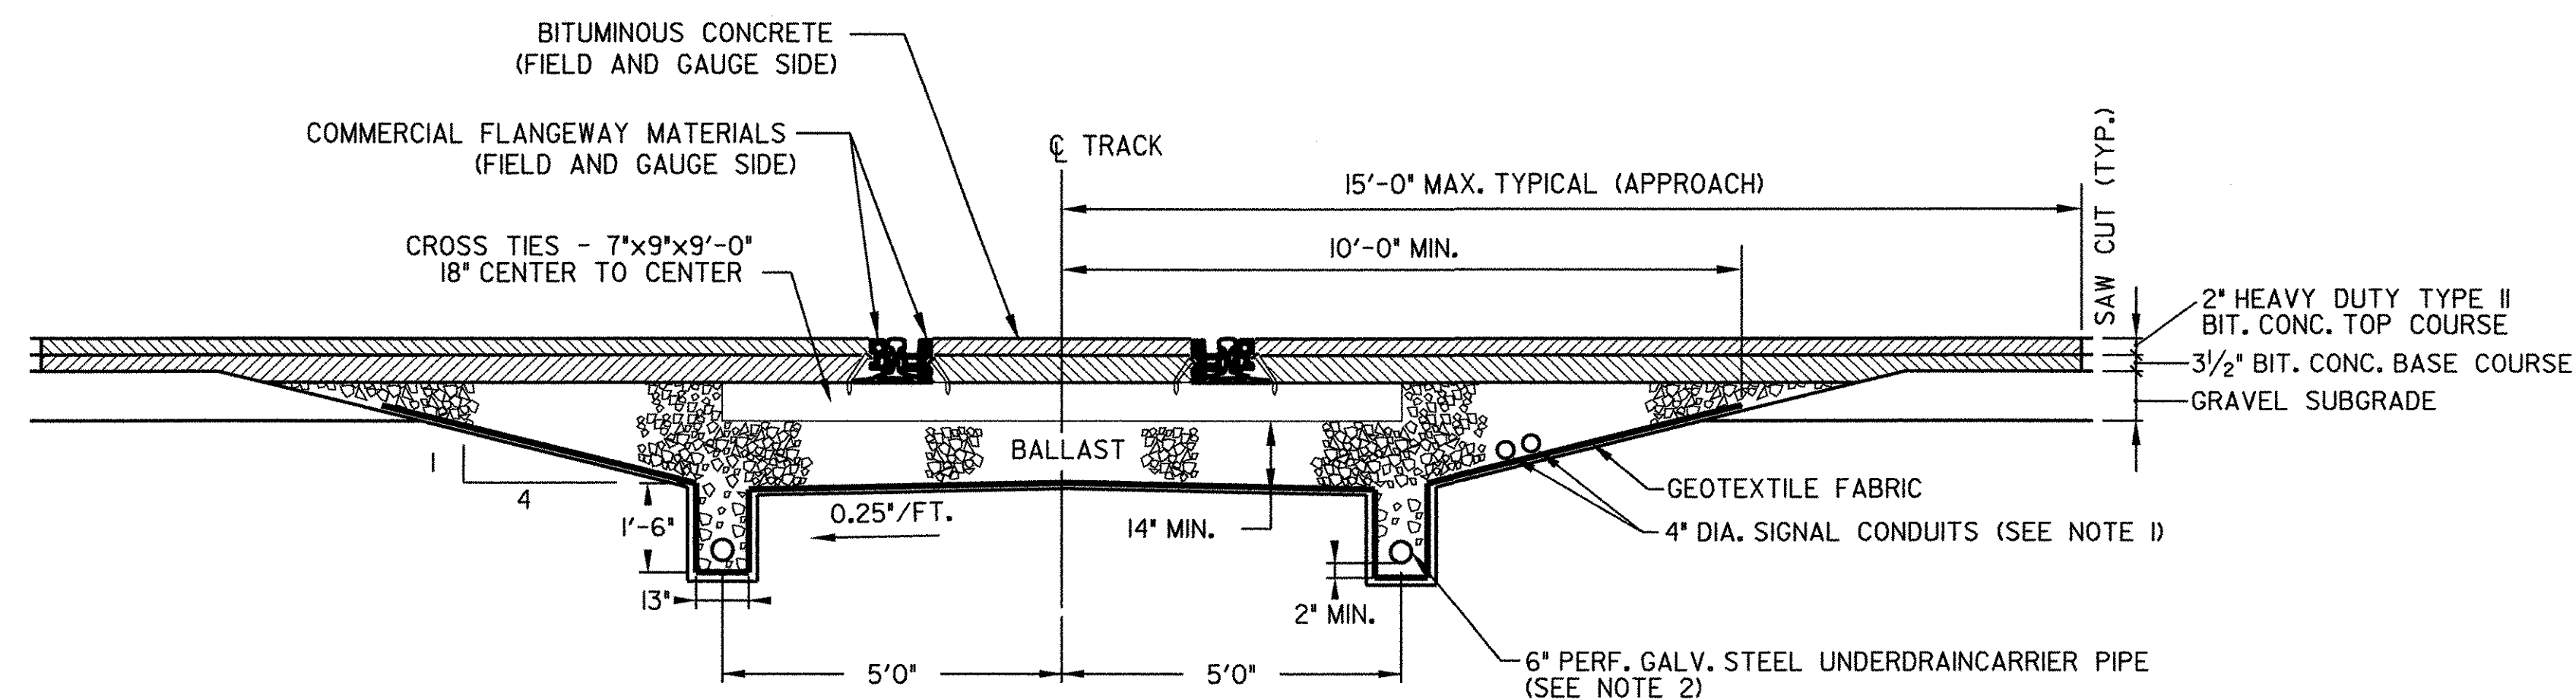

TYPICAL TRANSVERSE SECTION  
MAIN STREET CROSSING


**GENERAL NOTES**

- ON RICHVILLE ROAD THE EXISTING SIGNAL CONDUIT IS TO REMAIN AND THE CONTRACTOR SHALL BE CAREFUL DURING HIS EXCAVATION. IF THE CONTRACTOR DAMAGES THE SIGNAL CONDUIT HE SHALL REPLACE IT AT NO ADDITIONAL COST TO THE PROJECT. CONTRACTOR TO VERIFY LOCATION OF SIGNAL CONDUIT.
- NEW UNDERDRAIN CARRIER PIPE SHALL CONNECT TO EXISTING CATCH BASIN. PERFORATIONS TO BE PLACED NEAR FLOW LINE OF PIPE.
- ALL RAIL JOINTS WITHIN THE CROSSING AREA AND 50'-0" BEYOND WILL BE CROPPED AND WELDED IN ACCORDANCE WITH THE LATEST REVISION OF A.R.E.M.A. SPECIFICATIONS AT AN OFF-SITE ELECTRIC WELDING PLANT. WELDING CAN BE DONE IN FIELD UTILIZING THERMITE WELDING WITH ADVANCE APPROVAL FROM THE AGENCY. WELDED JOINTS SHALL BE GROUND TO CONFORM TO THE SHAPE OF THE RAIL ON GAUGE AND FIELD SIDES.
- TIE SPACING UNDER CWR AREA SHALL BE 18 INCHES ON CENTER OR AS REQUIRED IN CROSSING PANEL AREA BY MANUFACTURER.
- NEW 7"x9"x9'-0" AND 7"x9"x8'-6" TIES SHALL BE USED IN CROSSING AREA AS SHOWN. TIES IN APPROACH AREAS SHALL BE REPLACED AS RECOMMENDED BY THE RAILROAD AND APPROVED BY THE ENGINEER.
- TIE PLATES SHALL BE NEW 14 INCH PLATES, MANUFACTURED FOR THE RAIL SIZE USED. PLATES SHALL BE INSPECTED AND APPROVED BY THE RAILROAD AND THE ENGINEER. RAIL FASTENERS SHALL BE CUT TRACK SPIKES.
- BALLAST SHALL EXTEND 18" BEYOND END OF TIES AND SLOPED 1:2 TO THE ROADBED. (SEE DETAIL)
- TYPE AND DESIGN OF COMMERCIAL FLANGEWAY MATERIALS SHALL RECEIVE APPROVAL FROM THE ENGINEER.
- MANUFACTURERS SPECIFICATIONS SHALL BE FOLLOWED FOR THE INSTALLATION OF COMMERCIAL FLANGEWAY MATERIALS.
- INSTALLATION OF INSULATED JOINTS: THE MAXIMUM STAGGER BETWEEN RAIL JOINTS SHALL BE 4'-6", MINIMUM SHALL BE 3'-6".
- APPROACH ASPHALT ROADWAY PAVING SHALL FOLLOW LATEST EDITION OF THE AGENCY'S STANDARD SPECIFICATION FOR CONSTRUCTION AND SHALL BE INSTALLED WITH PAVING MACHINE WITH MINIMUM 3" LIFTS (UNLESS OTHERWISE DIRECTED BY THE ENGINEER) AND SHALL BE LAID PARALLEL TO CROSSING TO MINIMIZE APPROACH SETTLEMENT.
- EXISTING TRACK IS CONTINUOUS WELDED RAIL, JOINT SHALL BE FIELD WELDED OR BOLTED AS SHOWN ON THE PLANS. TRANSITION RAIL SHALL BE NEW AND MATCH RAIL SECTION THROUGH CROSSING, IF REQUIRED.
- CONTRACTOR SHALL ADD BALLAST, LINE, TAMP, AND SURFACE TRACK IN APPROACH AREAS TO OBTAIN A SMOOTH TRANSITION BETWEEN EXISTING AND PROPOSED TRACK TO THE SATISFACTION OF THE ENGINEER AND RAILROAD. THIS WORK IS INCIDENTAL TO THE RAIL-HIGHWAY CROSSING ITEM.
- JOINTS SHOULD BE A MINIMUM OF 50'-0" AND A MAXIMUM OF 70'-0" FROM EDGE OF TRAVELED WAY.


NOT TO SCALE

PROJECT NAME:	NORTH BENNINGTON
PROJECT NUMBER:	STP 203(10) TH#3; STP 1200(4) TH#1
FILE NAME:	Z0IG58RRDETAILS2.DGN
PROJECT LEADER:	D. BUA
DESIGNED BY:	ASL
PLOT DATE:	08-MAY-2006
DRAWN BY:	LB
CHECKED BY:	BUA
SHEET	20 OF 21


P701030064

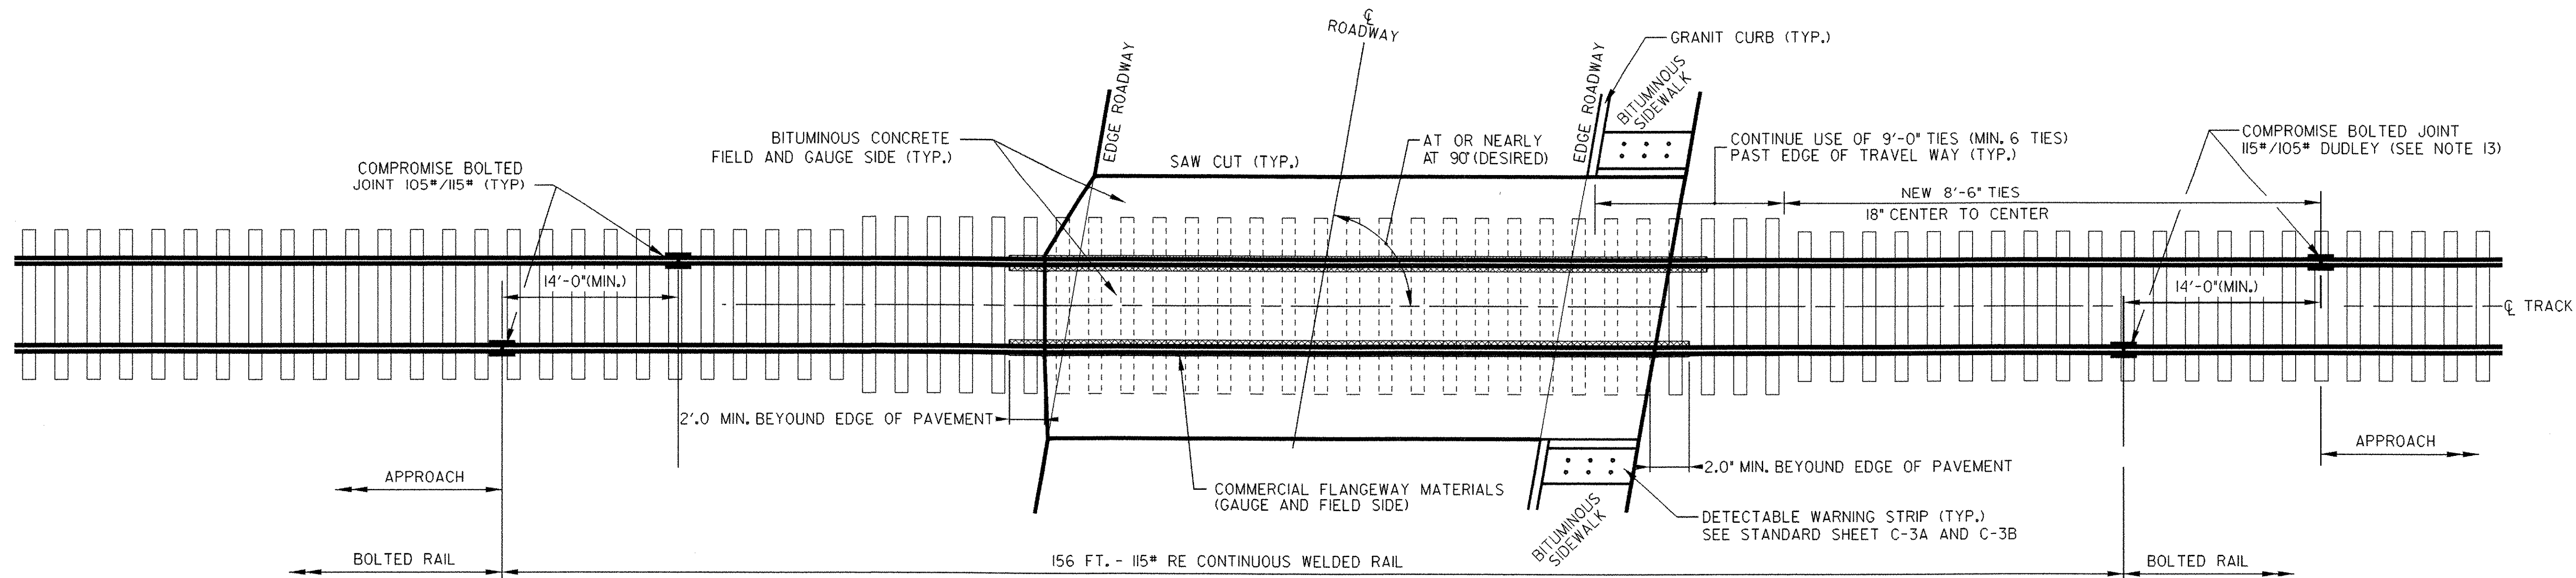


TYPICAL PLAN VIEW  
RICHVILLE ROAD CROSSING

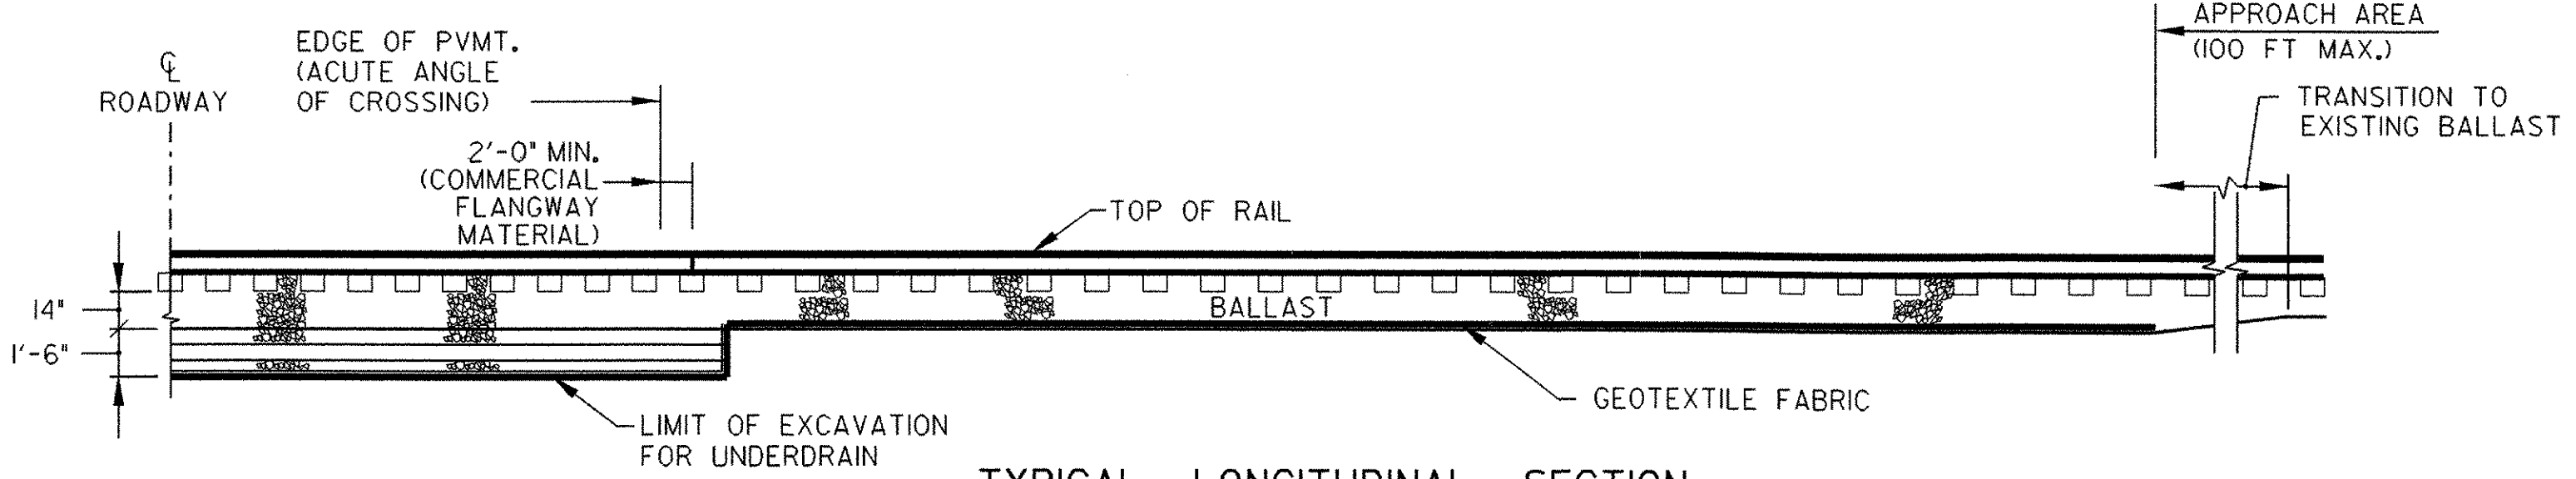

TYPICAL LONGITUDINAL SECTION  
RICHVILLE ROAD CROSSING

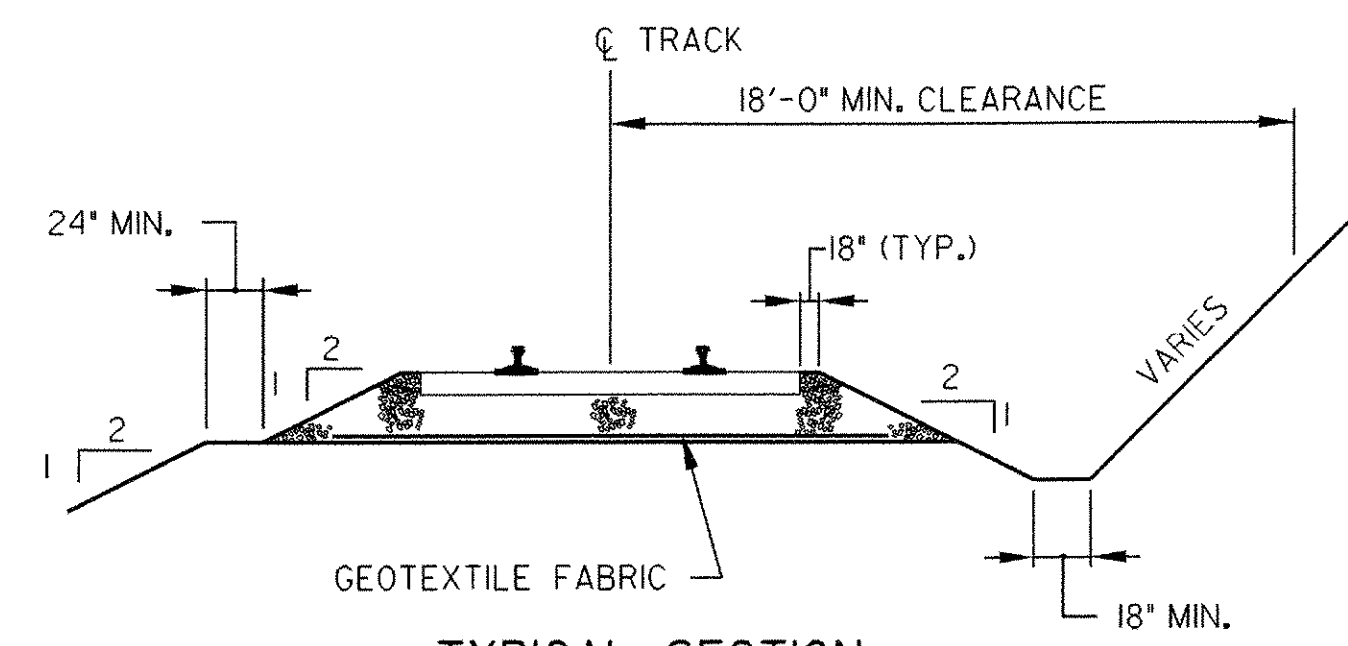

TYPICAL SECTION  
RICHVILLE ROAD CROSSING

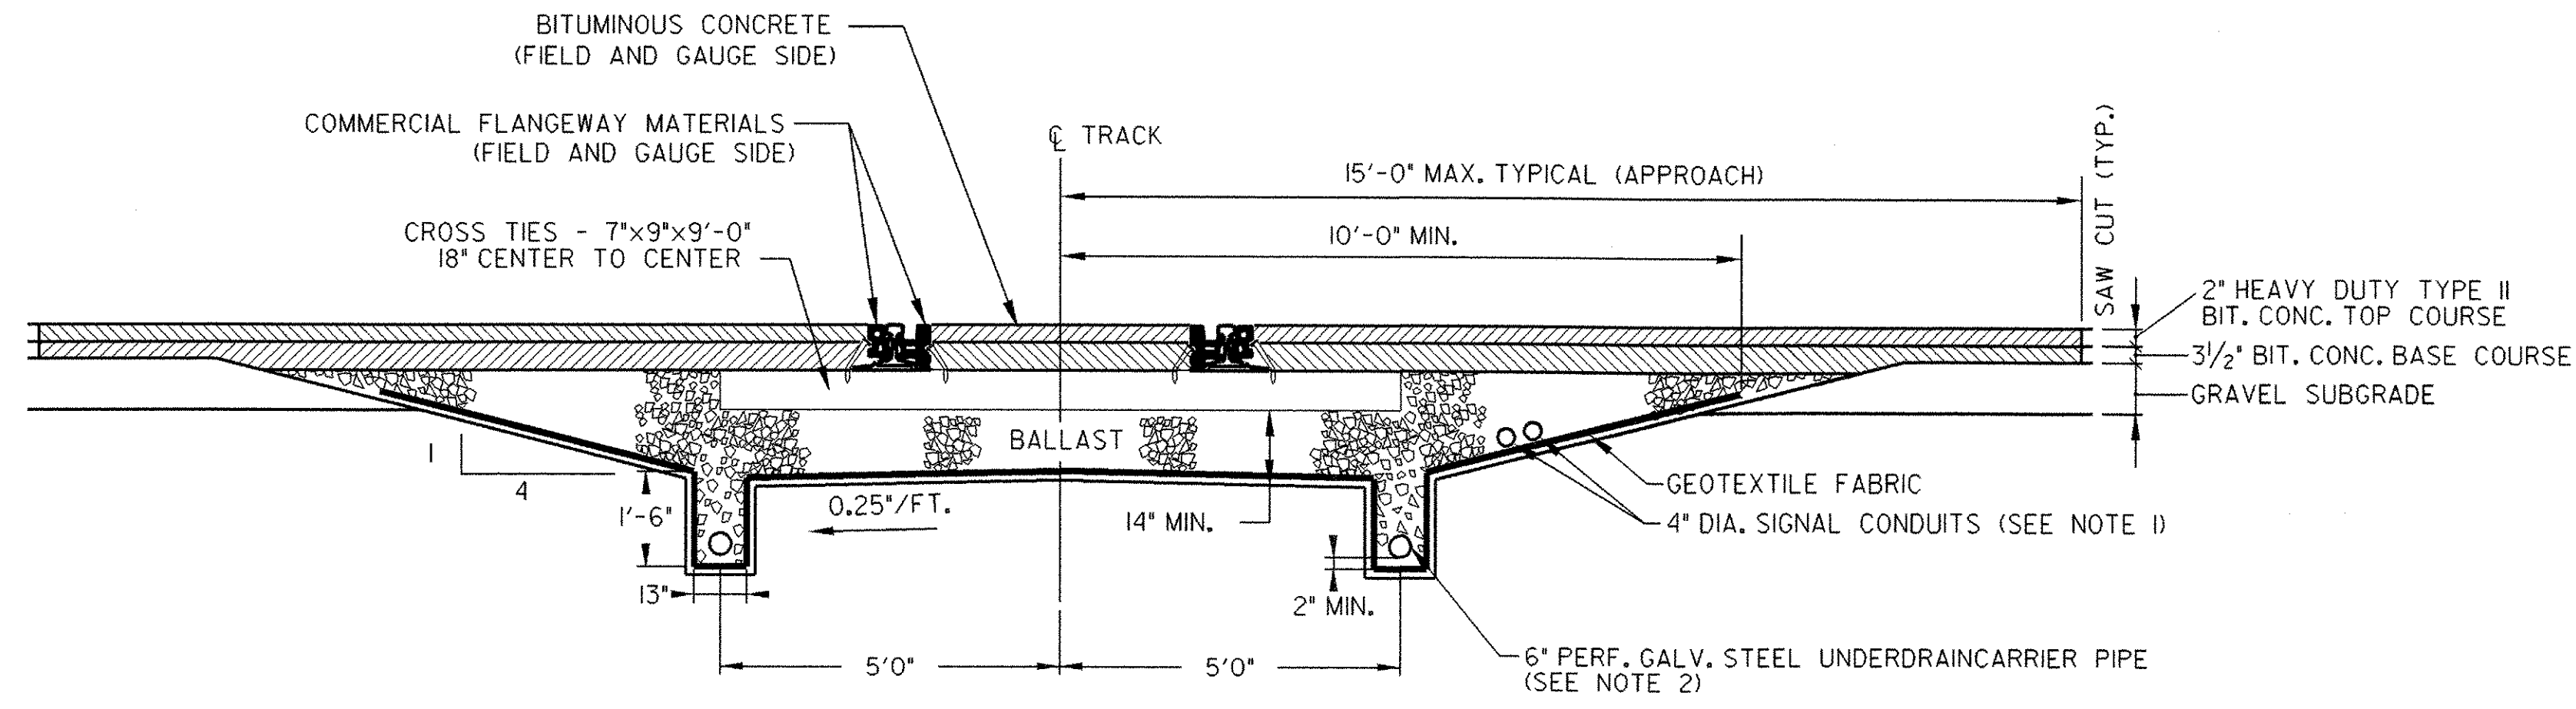

TYPICAL TRANSVERSE SECTION  
RICHVILLE ROAD CROSSING

GENERAL NOTES

- ON RICHVILLE ROAD THE EXISTING SIGNAL CONDUIT IS TO REMAIN AND THE CONTRACTOR SHALL BE CAREFUL DURING HIS EXCAVATION. IF THE CONTRACTOR DAMAGES THE SIGNAL CONDUIT HE SHALL REPLACE IT AT NO ADDITIONAL COST TO THE PROJECT. CONTRACTOR TO VERIFY LOCATION OF SIGNAL CONDUIT.
- NEW UNDERDRAIN CARRIER PIPE SHALL DAYLIGHT TO EXISTING DITCH. PERFORATIONS TO BE PLACED NEAR FLOW LINE OF PIPE.
- ALL RAIL JOINTS WITHIN THE CROSSING AREA AND 50'-0" BEYOND WILL BE CROPPED AND WELDED IN ACCORDANCE WITH THE LATEST REVISION OF A.R.E.M.A. SPECIFICATIONS AT AN OFF-SITE ELECTRIC WELDING PLANT. WELDING CAN BE DONE IN FIELD UTILIZING THERMITE WELDING WITH ADVANCE APPROVAL FROM THE AGENCY. WELDED JOINTS SHALL BE GROUND TO CONFORM TO THE SHAPE OF THE RAIL ON GAUGE AND FIELD SIDES.
- TIE SPACING UNDER CWR AREA SHALL BE 18 INCHES ON CENTER OR AS REQUIRED IN CROSSING PANEL AREA BY MANUFACTURER.
- NEW 7"x9"x9'-0" AND 7"x9"x8'-6" TIES SHALL BE USED IN CROSSING AREA AS SHOWN. TIES IN APPROACH AREAS SHALL BE REPLACED AS RECOMMENDED BY THE RAILROAD AND APPROVED BY THE ENGINEER.
- TIE PLATES SHALL BE NEW 14 INCH PLATES, MANUFACTURED FOR THE RAIL SIZE USED. PLATES SHALL BE INSPECTED AND APPROVED BY THE RAILROAD AND THE ENGINEER. RAIL FASTENERS SHALL BE CUT TRACK SPIKES.
- BALLAST SHALL EXTEND 18" BEYOND END OF TIES AND SLOPED 1:2 TO THE ROADBED. (SEE DETAIL)
- TYPE AND DESIGN OF COMMERCIAL FLANGEWAY MATERIALS SHALL RECEIVE APPROVAL FROM THE ENGINEER.
- MANUFACTURERS SPECIFICATIONS SHALL BE FOLLOWED FOR THE INSTALLATION OF COMMERCIAL FLANGEWAY MATERIALS.
- INSTALLATION OF INSULATED JOINTS: THE MAXIMUM STAGGER BETWEEN RAIL JOINTS SHALL BE 4'-6", MINIMUM SHALL BE 3'-6".
- APPROACH ASPHALT ROADWAY PAVING SHALL FOLLOW LATEST EDITION OF THE AGENCY'S STANDARD SPECIFICATION FOR CONSTRUCTION AND SHALL BE INSTALLED WITH PAVING MACHINE WITH MINIMUM 3" LIFTS (UNLESS OTHERWISE DIRECTED BY THE ENGINEER) AND SHALL BE LAID PARALLEL TO CROSSING TO MINIMIZE APPROACH SETTLEMENT.
- EXISTING TRACK IS CONTINUOUS WELDED RAIL. JOINT SHALL BE FIELD WELDED OR BOLTED AS SHOWN ON THE PLANS. TRANSITION RAIL SHALL BE NEW AND MATCH RAIL SECTION THROUGH CROSSING, IF REQUIRED.
- CONTRACTOR SHALL ADD BALLAST, LINE, TAMP, AND SURFACE TRACK IN APPROACH AREAS TO OBTAIN A SMOOTH TRANSITION BETWEEN EXISTING AND PROPOSED TRACK TO THE SATISFACTION OF THE ENGINEER AND RAILROAD. THIS WORK IS INCIDENTAL TO THE RAIL-HIGHWAY CROSSING ITEM.
- JOINTS SHOULD BE A MINIMUM OF 50'-0" AND A MAXIMUM OF 70'-0" FROM EDGE OF TRAVELED WAY.

NOT TO SCALE

PROJECT NAME:	MANCHESTER	PLOT DATE:	03-MAY-2006
PROJECT NUMBER:	STP 2031(12) TH#4; STP 017(12) TH#9	DRAWN BY:	LB
FILE NAME:	Z0IG64RRDETAILS2.DGN	CHECKED BY:	BUA
PROJECT LEADER:	D.BUA	SHEET	21 OF 21
DESIGNED BY:	ASL		

P701030107