



PLEASE SEE SHEET 2 FOR INDEX OF SHEETS AND LIST OF STANDARDS

# STATE OF VERMONT AGENCY OF TRANSPORTATION



## PROPOSED IMPROVEMENT TOWN OF BARTON, VILLAGE OF ORLEANS COUNTY OF ORLEANS

RECORD PLANS	
CONTRACTOR	J A MCDONALD INC - LYNDON CENTER, VT
RESIDENT ENGINEER	CHRIS CRAIG
CONSTRUCTION BEGAN	MAY 12, 2008
CONSTRUCTION COMPLETE	
RECORD PLANS BY	CHRIS CRAIG & CRAIG PEIRCE
I HEREBY CERTIFY THAT ALL THE CONSTRUCTION REQUIRED BY THIS SET OF DRAWINGS HAS BEEN ACCOMPLISHED AS INDICATED HEREIN	
BY	<i>Chris Craig</i> RESIDENT ENGINEER
DATE	Nov. 4, 2010
NOTE Any further information concerning final quantities, amounts or other details relative to this project may be found at Central Files in the electronic archives	

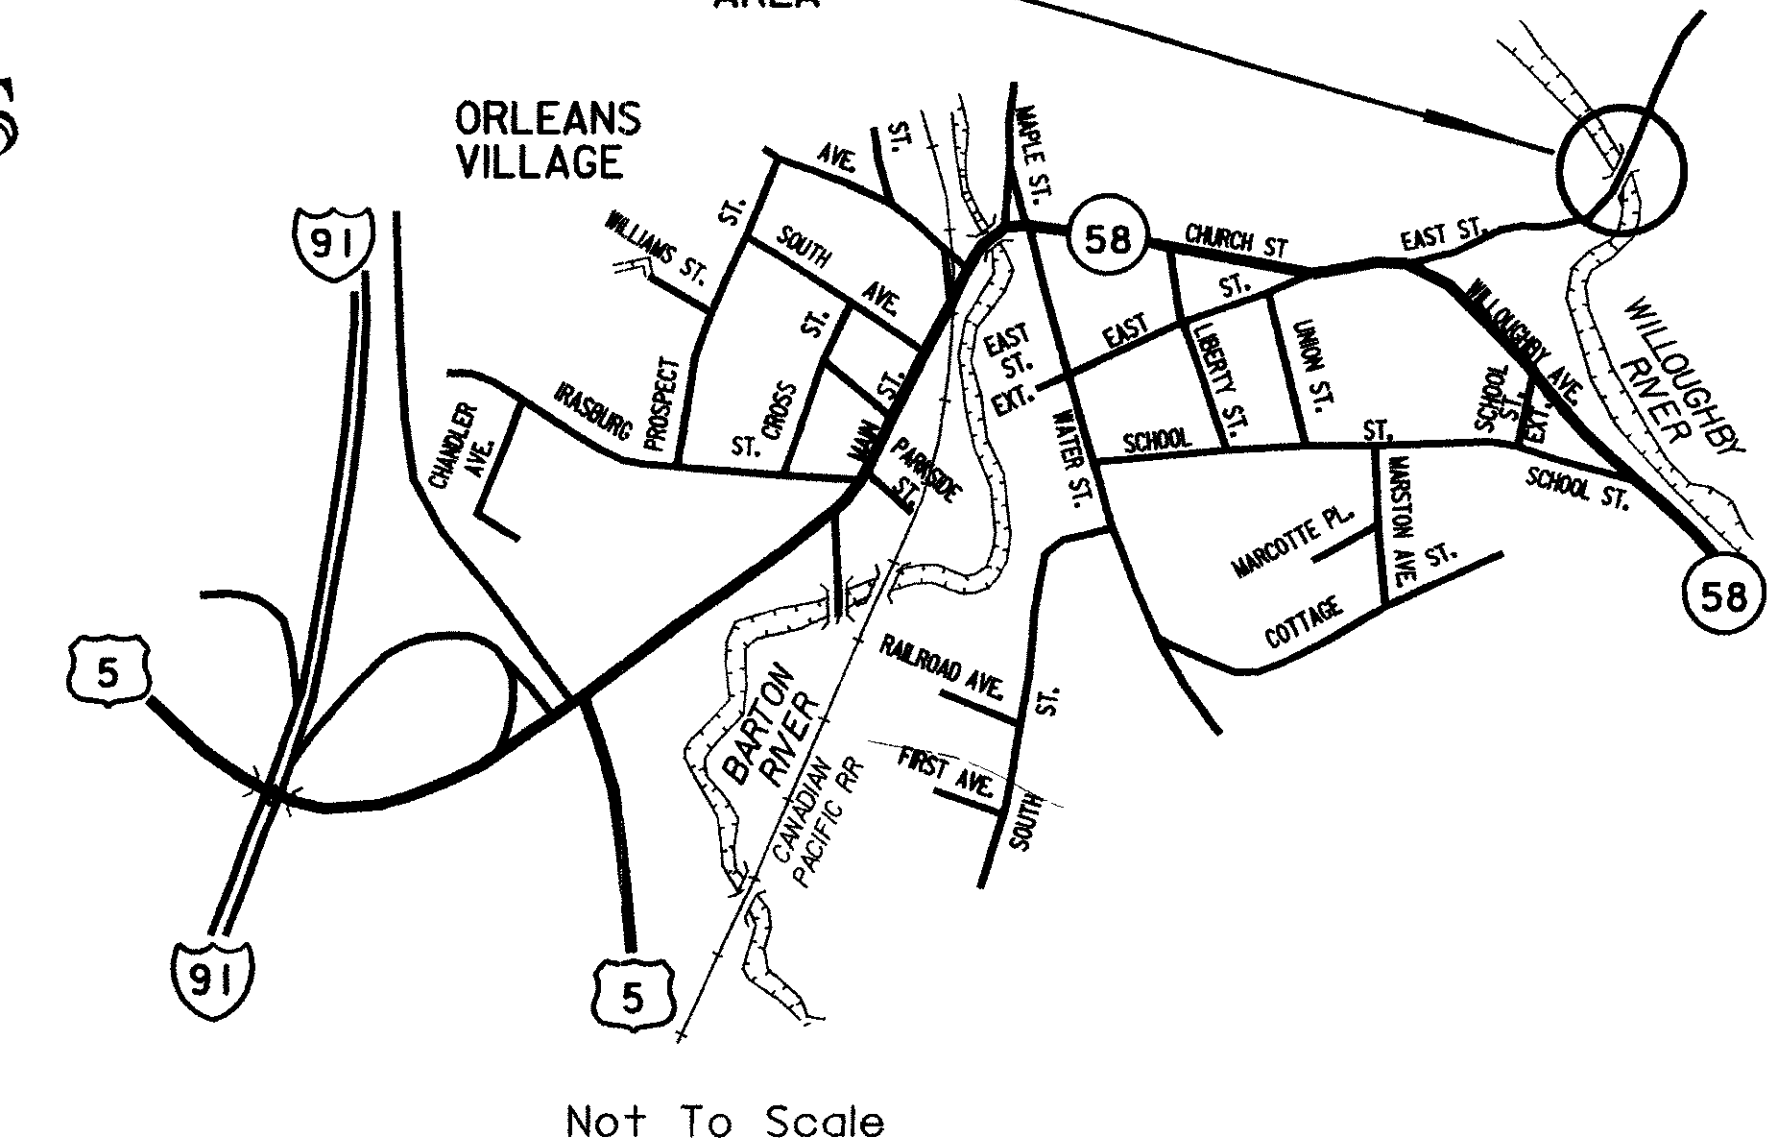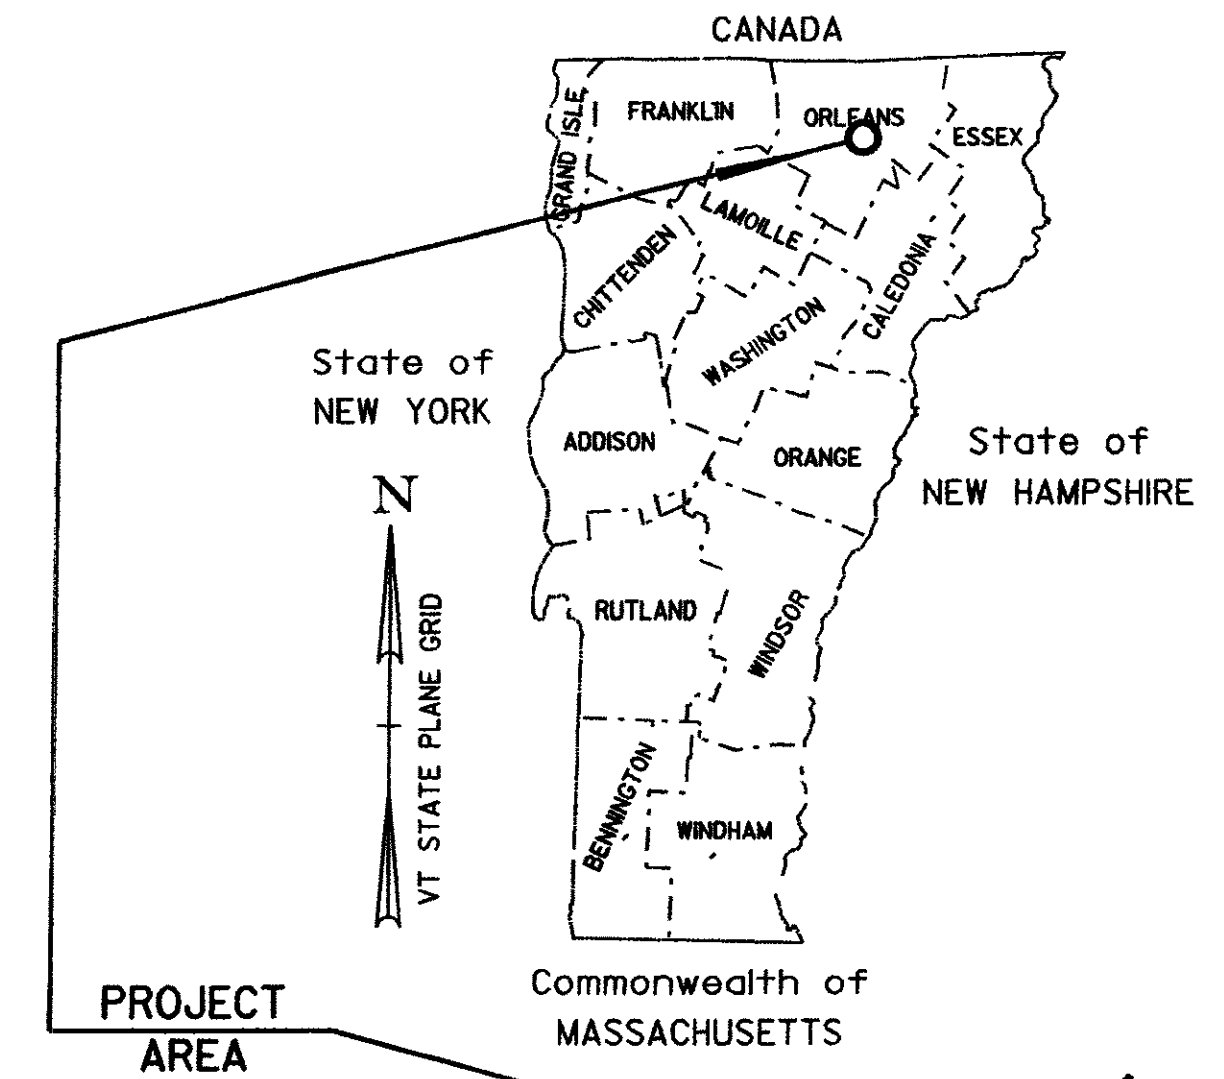


ROUTE NO : TH #3, CL 3      BRIDGE NO : #61

**PROJECT LOCATION :** LOCATED IN THE COUNTY OF ORLEANS, VILLAGE OF ORLEANS, ON TOWN HIGHWAY #3 (EAST STREET), BRIDGE #61 OVER THE WILLOUGHBY RIVER, APPROXIMATELY 0.2 MILE EAST OF THE JUNCTION OF TOWN HIGHWAY #1.

**PROJECT DESCRIPTION :**  
REPLACEMENT OF THE EXISTING BRIDGE INCLUDING RELATED APPROACH ROADWAY AND CHANNEL WORK.

LENGTH OF STRUCTURE : 114.25 FEET.  
LENGTH OF ROADWAY : 85.75 FEET.  
LENGTH OF PROJECT : 200.00 FEET.

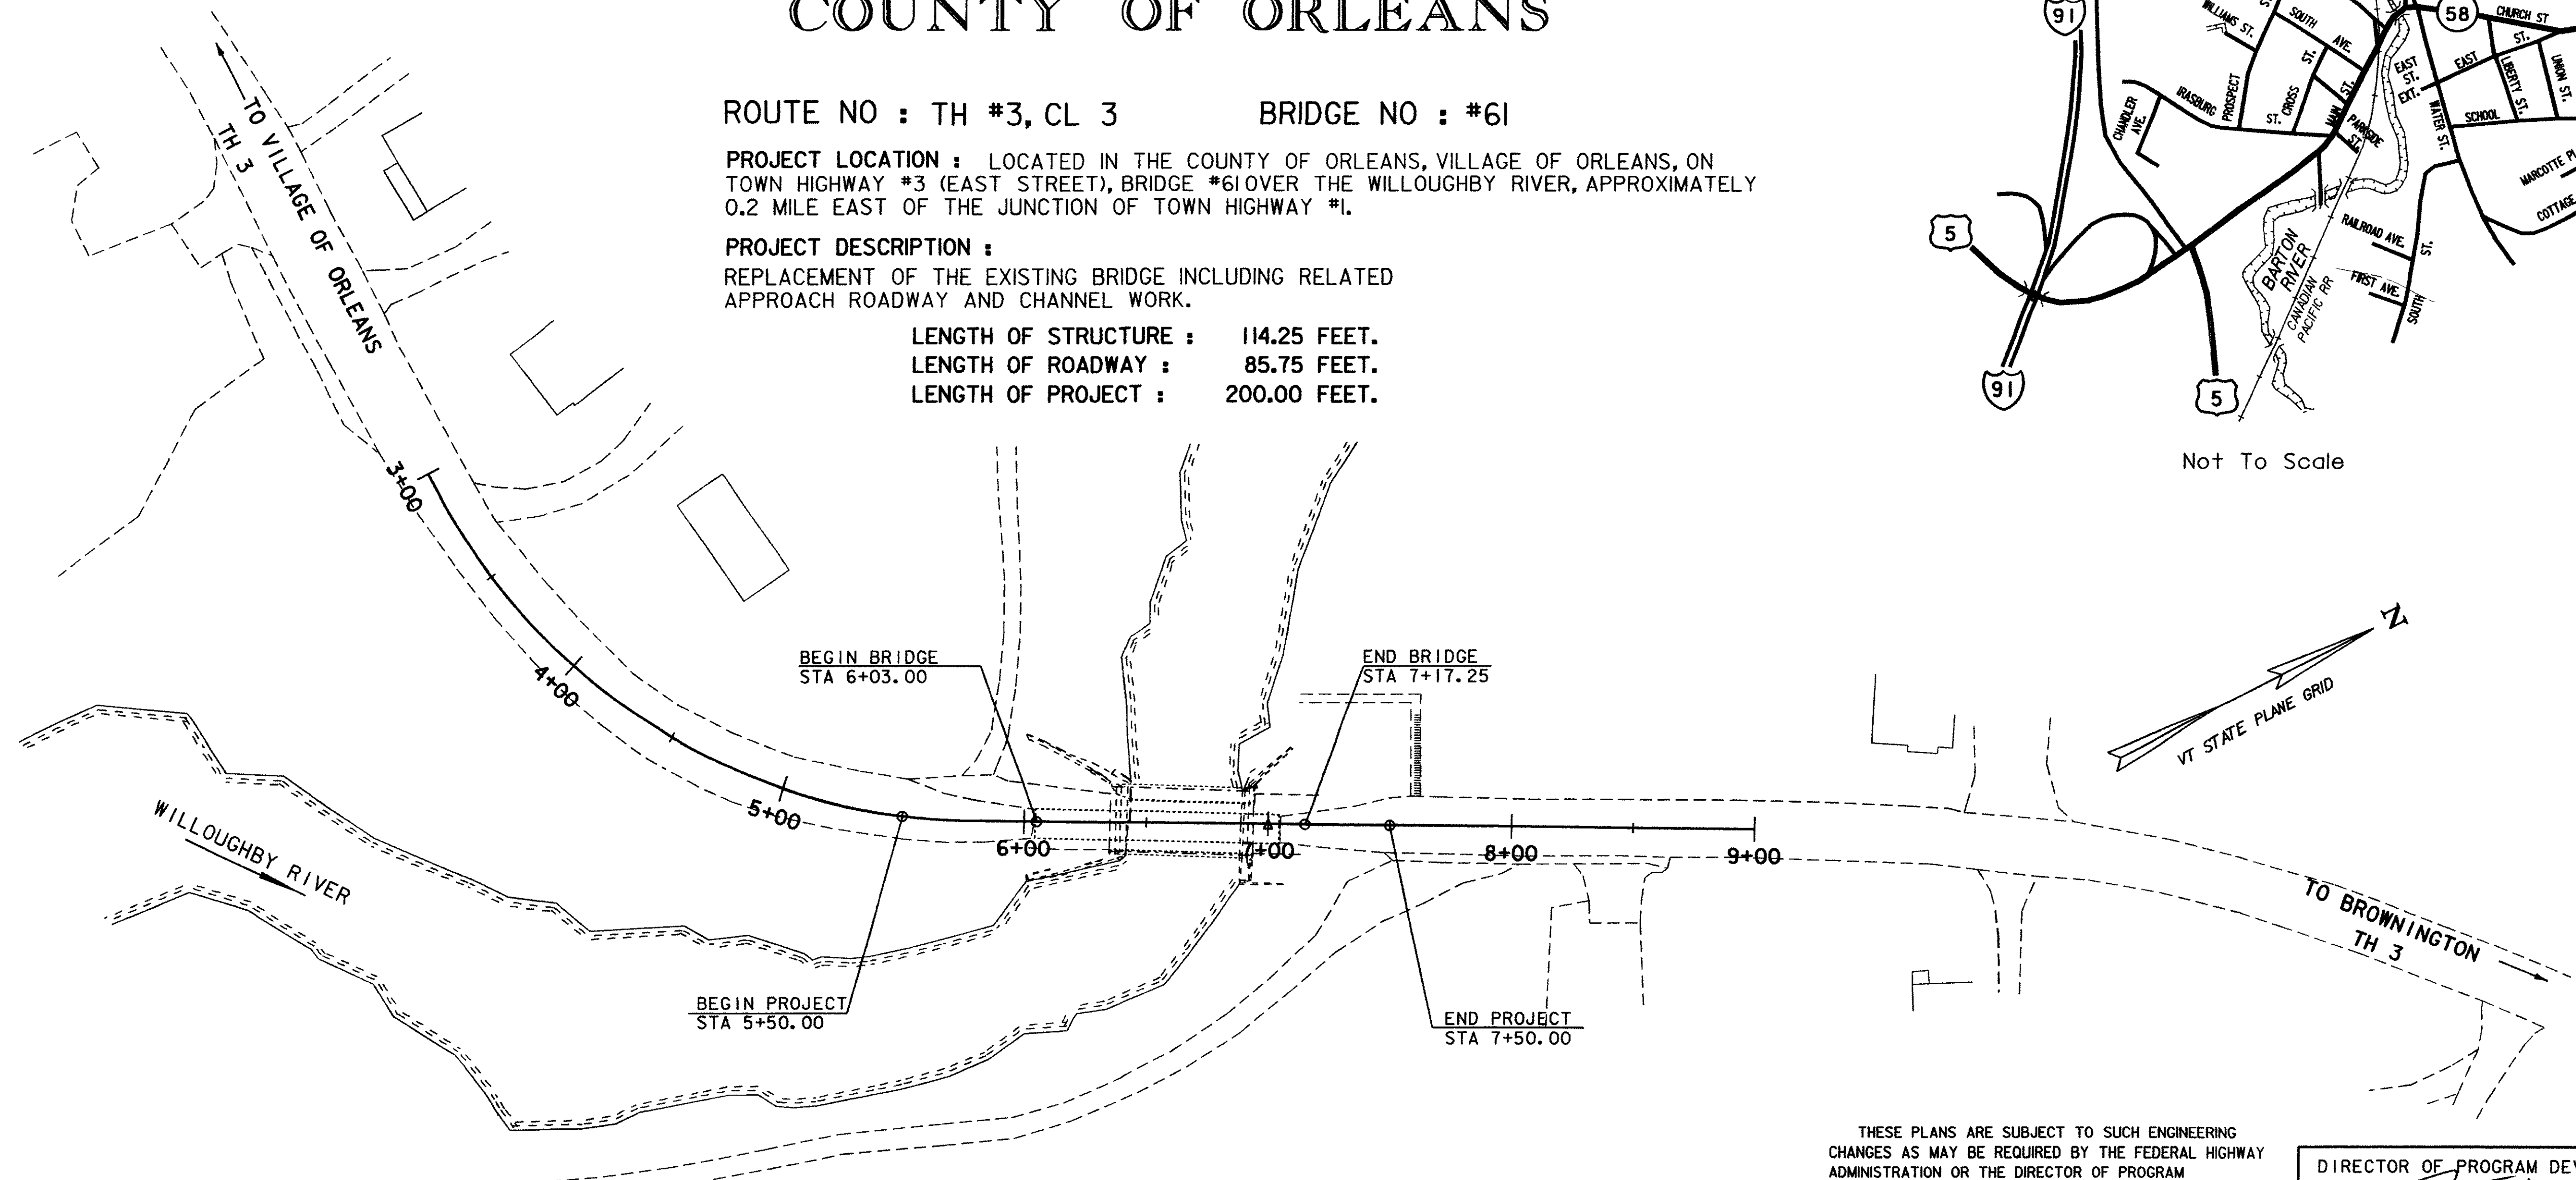

### CONVENTIONAL SYMBOLS

COUNTY LINE	
TOWN LINE	
LIMITS OF ACCESS	
POINT OF ACCESS	
FENCE LINE	
STONE WALL	
TRAVELED WAY	
GUARD RAIL	
RAILROAD	
SURVEY LINE	
CULVERT	
POWER POLE	
TELEPHONE POLE	
TREES	
CONTROL OF ACCESS	
PROPERTY LINE	
R.O.W. TAKING LINE	
SLOPE OF CUT	
TOP OF CUT	
TOE OF SLOPE	

SURVEYED BY : R. GILMAN  
SURVEYED DATE : 10/2001

DATUM  
VERTICAL NAVD 88  
HORIZONTAL NAD 83 (96)

THESE PLANS ARE SUBJECT TO SUCH ENGINEERING CHANGES AS MAY BE REQUIRED BY THE FEDERAL HIGHWAY ADMINISTRATION OR THE DIRECTOR OF PROGRAM DEVELOPMENT.

CONSTRUCTION IS TO BE CARRIED ON IN ACCORDANCE WITH THESE PLANS AND THE STANDARD SPECIFICATIONS FOR CONSTRUCTION DATED 2006, AS APPROVED BY THE FEDERAL HIGHWAY ADMINISTRATION ON JUNE 15, 2006 FOR USE ON THIS PROJECT, INCLUDING ALL SUBSEQUENT REVISIONS AND SUCH REVISED SPECIFICATIONS AND SPECIAL PROVISIONS AS ARE INCORPORATED IN THESE PLANS.

DIRECTOR OF PROGRAM DEVELOPMENT  
APPROVED *Richard Johnson* DATE 3/8/07

PROJECT MANAGER : W. B. SYMONDS

PROJECT NAME : BARTON  
PROJECT NUMBER : BRO 1449 (29)

SHEET 1 OF 84 SHEETS

