


RIGHT - OF - WAY DETAIL SHEET

TABLE OF PROPERTY ACQUISITION

PARCEL NO.	PROPERTY OWNER	SHEET NO.	BEGINNING STATION	ENDING STATION	TAKE AREA±	REMAINDER AREA±	RIGHT			RECORDING DATA				REMARKS
							TYPE	(T)(P)	AREA ±	TITLE	DATE	TOWN / CITY	BOOK	
1	SMITH, DAVID V. & DEBORAH J.	13	5+51.65 LT.	5+74.95 LT.			CONST.	(T)	61 SF			BARTON		INCLUDES PDF
2	STATE OF VERMONT- AGENCY OF NATURAL RESOURCES DEPARTMENT OF FISH & WLDLIFE	13	4+46.1 RT. 5+25.00 RT. 5+48.74 RT. 5+33.71 RT.	6+00.00 RT. 8+82.47 RT.			CONST. UTILITY INSTALL	(T) (P) (P)	731 SF 0.14 A			BARTON		INCLUDES PDF & EC GUYWIRE DO NOT DISTURB GRANITE MONUMENT INCLUDES PDF & EC
			6+84.51 RT. 6+86.26 RT.	7+20.11 RT. 7+29.00 RT.			CONST. CHANNEL	(T) (P)	298 SF 279 SF					
			6+86.26 RT. 7+12.17 RT. 7+21.74 RT. 7+60.00 RT. 8+00.00 RT.	7+12.17 RT. 7+60.07 RT. 8+08.55 RT.			DRAINAGE CULVERT CONST. DRIVE INSTALL	(P) (P) (T) (T) (P)						INCLUDES DROP INLET INCLUDES PDF 11' GRAVEL IN COMMON/TARBOX GUYWIRE
3A	BLODGETT, DAVID & NAULT, MILDRED	13	7+11.20 LT.	8+02.46 LT.	2345 SF							BARTON		TO BE TRANSFERRED TO FISH & WILDLIFE, DO NOT DISTURB - FENCE
3B		13	7+09.14 LT.	7+50.00 LT.	242 SF									
3C		13	7+09.14 CL.	8+02.46 LT.	2282 SF		ALL R.T. & I.							HWY. EASE. TH 3
4A	BLODGETT, DAVID & NAULT, MILDRED & STATE OF VERMONT- AGENCY OF NATURAL RESOURCES DEPARTMENT OF FISH & WLDLIFE	13	6+71.18 LT.	7+18.31 LT.	1071 SF							BARTON		(DISPUTED PARCEL) TO BE TRANSFER TO FISH & WILDLIFE
4B		13	6+70.56 LT.	7+11.20 LT.	292 SF									
4C		13	6+70.56 CL.	7+09.14 LT.	893 SF		ALL R.T. & I.							HWY. EASE. TH 3
5	VILLAGE OF ORLEANS, INC. & STATE OF VERMONT- AGENCY OF NATURAL RESOURCES DEPARTMENT OF FISH & WLDLIFE	13	6+24.13 LT. 6+24.13 LT. 6+26.14 LT.	6+42.42 LT. 6+42.42 LT. 6+31.41 LT.			CONST. DRAINAGE CHANNEL	(T) (P) (P)	176 SF 4 SF			BARTON		INCLUDES PDF (DISPUTED PARCEL)
6	VILLAGE OF ORLEANS, INC. (WATER & SEWER & ELECTRIC)													UTILITY
7	VERISON NEW ENGLAND, INC.													UTILITY
8	ADELPHIA TELECOMMUNICATIONS, INC.													UTILITY

TABLE OF REVISIONS

REVISION NO.	SHEET NO.	DESCRIPTION	DATE
1	12	PARCEL NO. 2 STATE OF VERMONT - AGENCY OF NATURAL RESOURCES DEPARTMENT OF FISH & WILDLIFE. CHANGE BEGINNING STA. OF CONST. (T) AT STA. 6+81.51 RT TO STA. 6+84.51 RT. CHANGE ENDING STA. OF CHANNEL (P) FROM STA. 7+39.00 RT. TO STA. 7+29.00 RT. PER C.O. 9446. MADE BY: MR APPROVED BY: RD	11/21/05
2	12	PARCEL NO. 3. BLODGETT. CHANGE AREA OF TAKING FOR PARCEL 3B FROM 150 SF± TO 242 SF±. PER C.O. 9447 MADE BY: MR APPROVED BY: RD	11/21/05

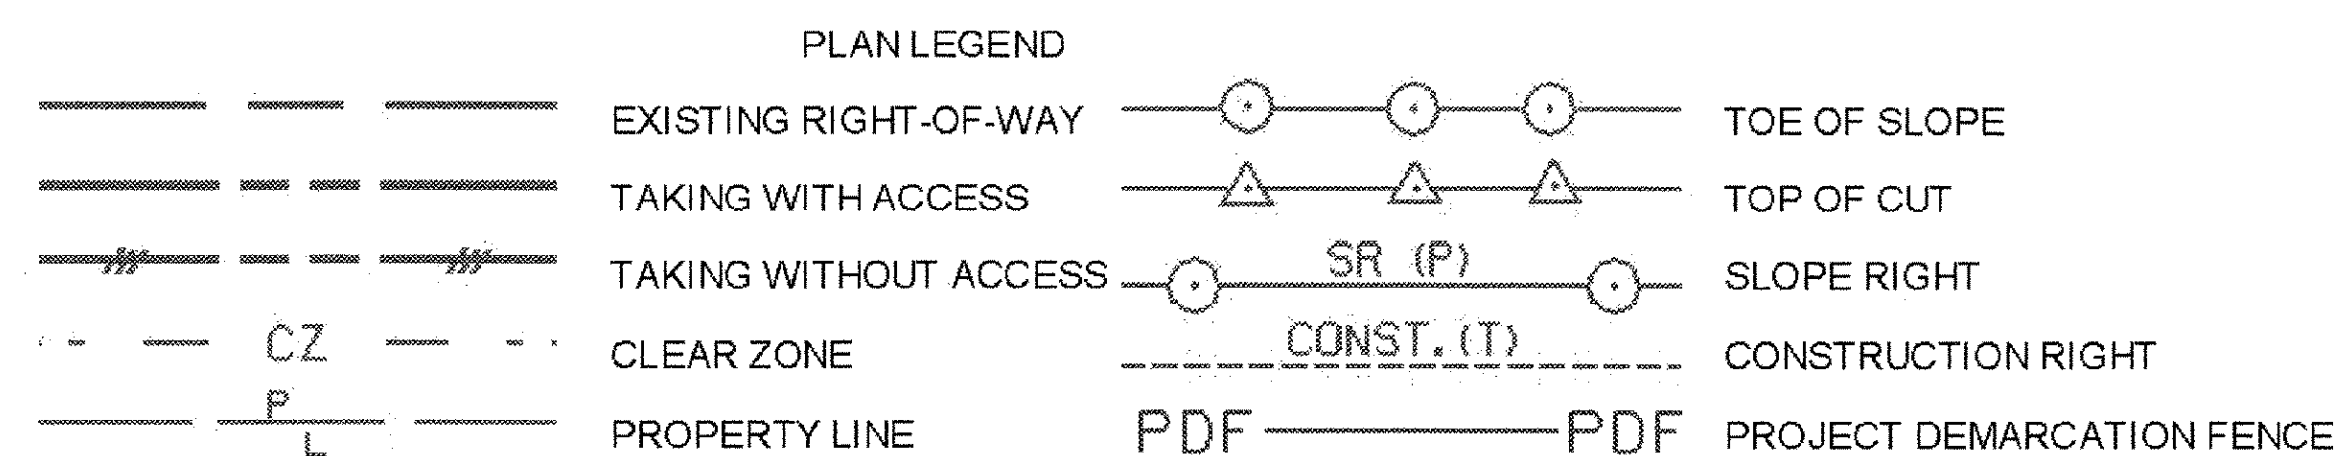

- EC - EROSION CONTROL
- (P) - PERMANENT
- (T) - TEMPORARY
- DR. - DRAINAGE RIGHT
- DIT. - DITCHING RIGHT
- CH. - CHANNEL RIGHT
- DRIVE - DRIVE RIGHT
- CUL. - CULVERT RIGHT
- C&T - CLEARING & TRIMMING RIGHT
- SR - SLOPE RIGHT
- UE - UTILITY EASEMENT

APPROVED: ROGER P. DUMAS DATE: 05-02-05
CHIEF, PLANS & TITLES

PLOT DATE 03/28/07

PROJECT NAME: BARTON
PROJECT NUMBER: BRO 1449(29)
FILE NAME: 01j168det.xls
PROJECT LEADER: C. S. KELLER
DESIGNED BY: J. Reed
R.O.W. SHEET 12 OF 13
PLOT DATE:
DRAWN BY: W. B. SYMONDS
CHECKED BY: 0
SHEET 8 OF 84