



# PROFILE TH 3

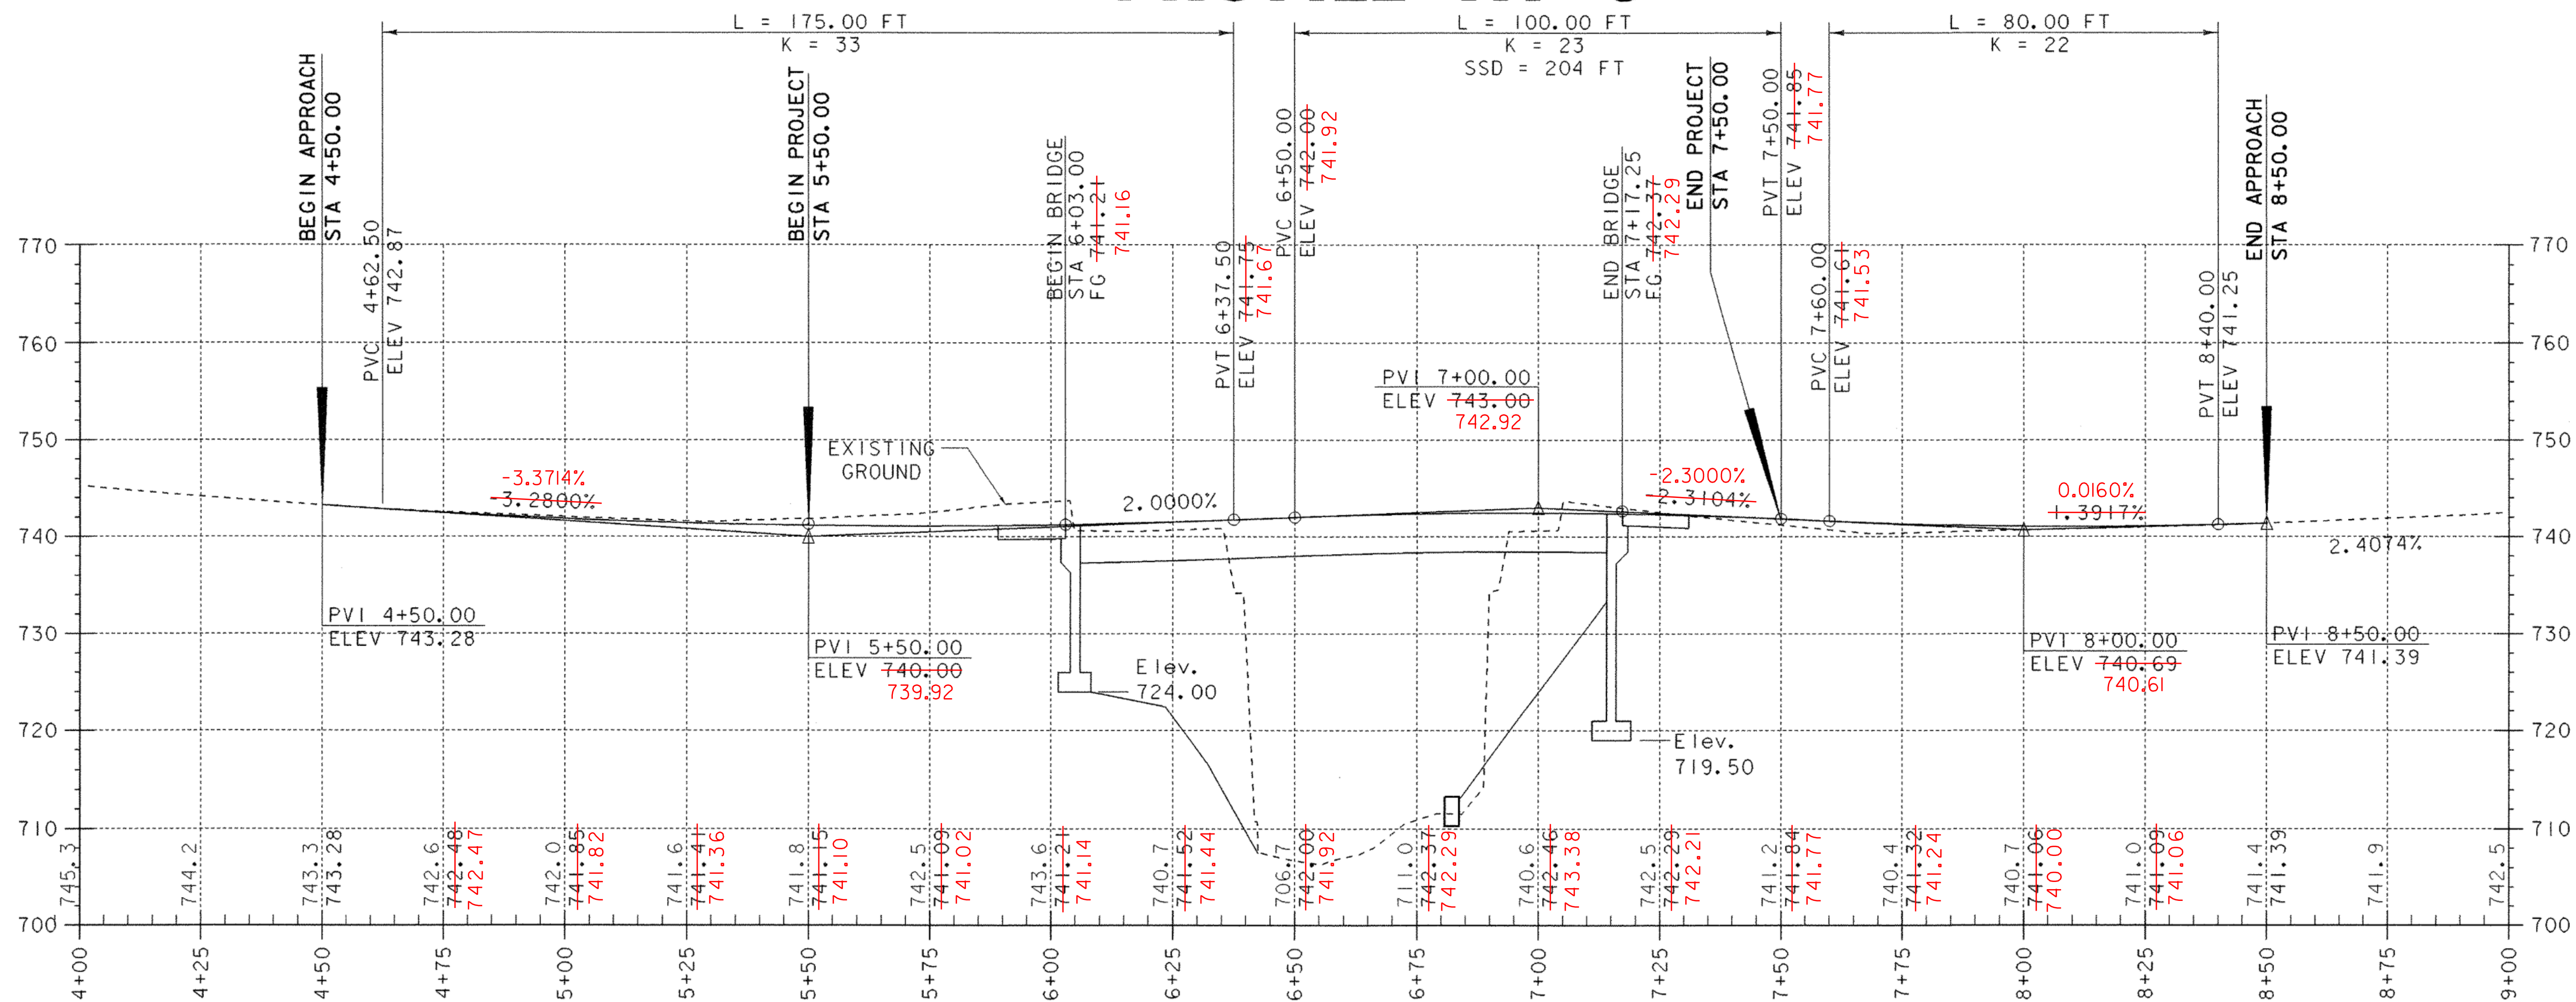

NOTE: EXISTING CENTERLINE ELEVATIONS ARE SHOWN TO THE TENTH.  
 PROPOSED CENTERLINE ELEVATIONS ARE SHOWN TO THE HUNDREDTH.

NOTE - FINISHED GRADE REVISED TO MINIMIZE THE HAUNCH DEPTHS AFTER GIRDER PROFILES WERE TAKEN.

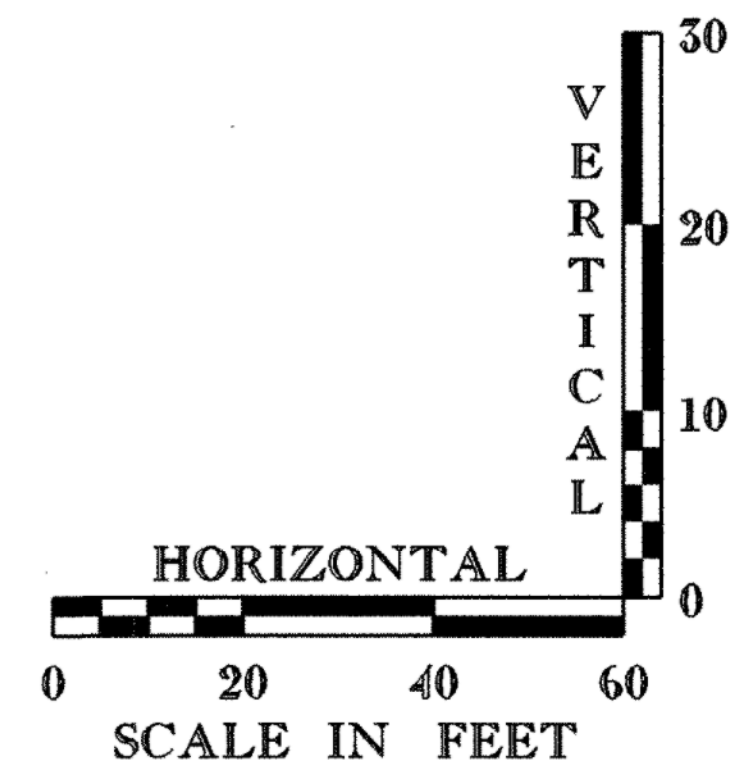

## PROFILE SHEET

PROJECT NAME: BARTON	PLOT DATE: 02-APR-2007
PROJECT NUMBER: BRO 1449 (29)	DRAWN BY: J. REED
FILE NAME: /str5/01j168/sj186xs.dgn	CHECKED BY: T. SUMNER
PROJECT LEADER: W. SYMONDS	SHEET 16 OF 84
DESIGNED BY: J. REED	
sj168pro.i	