

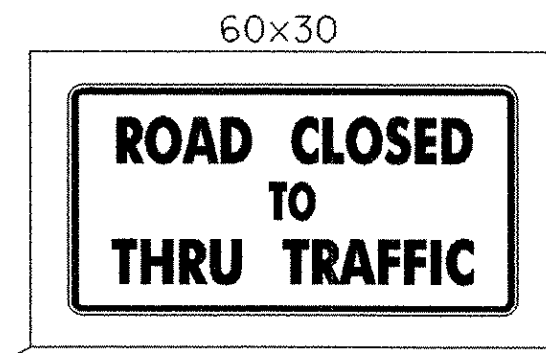
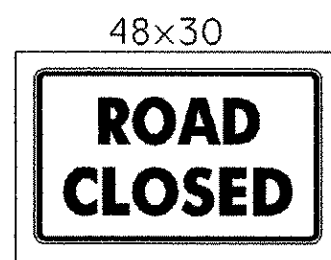
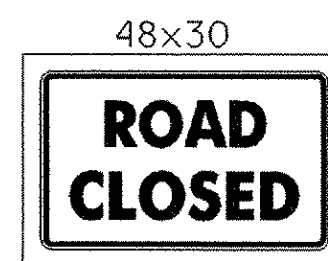
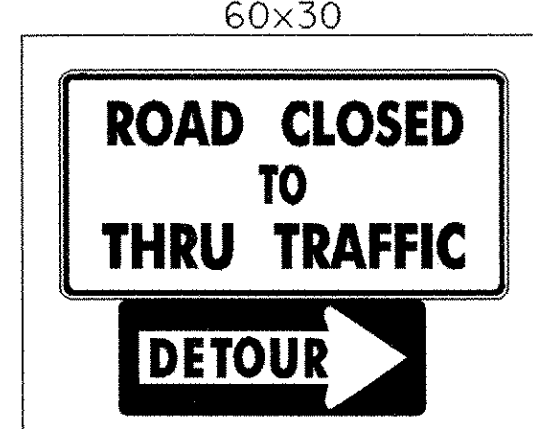
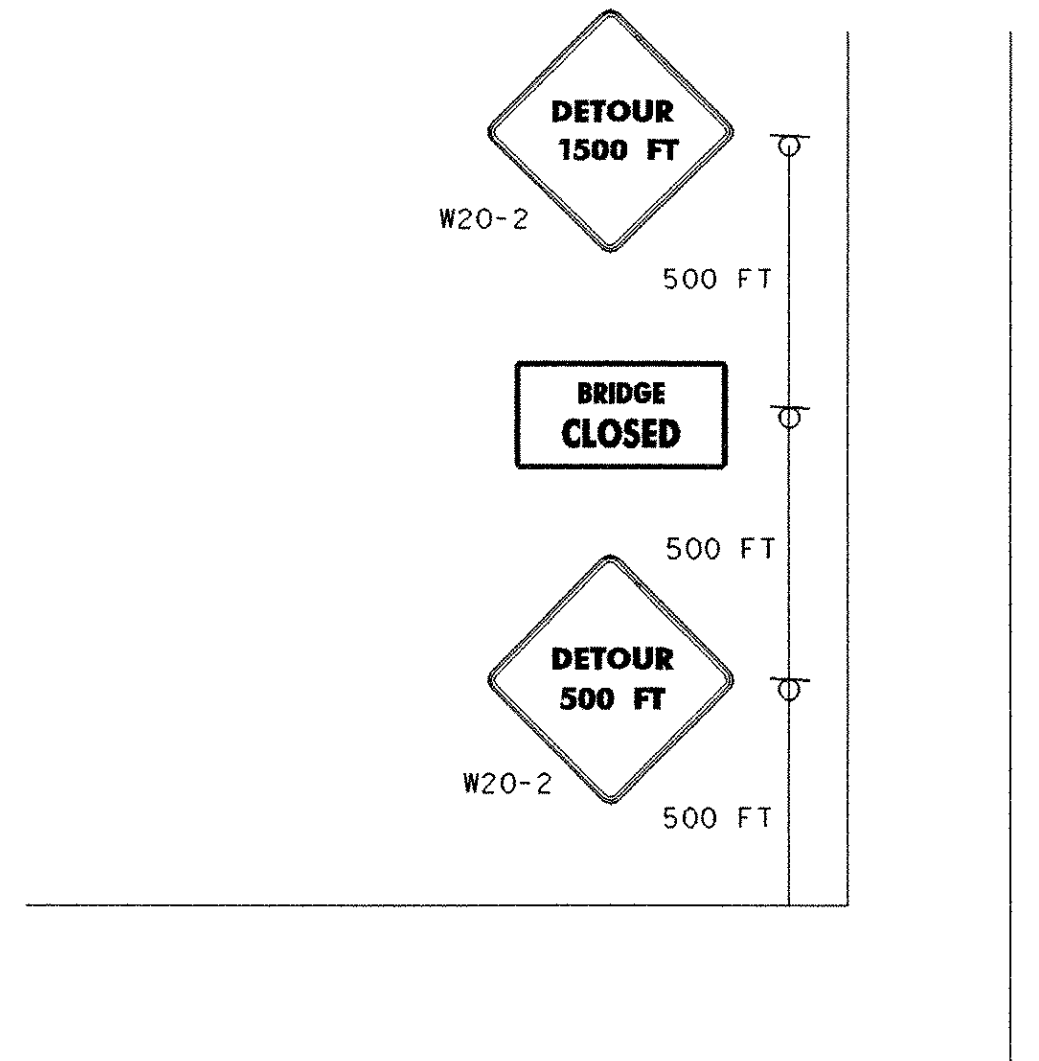
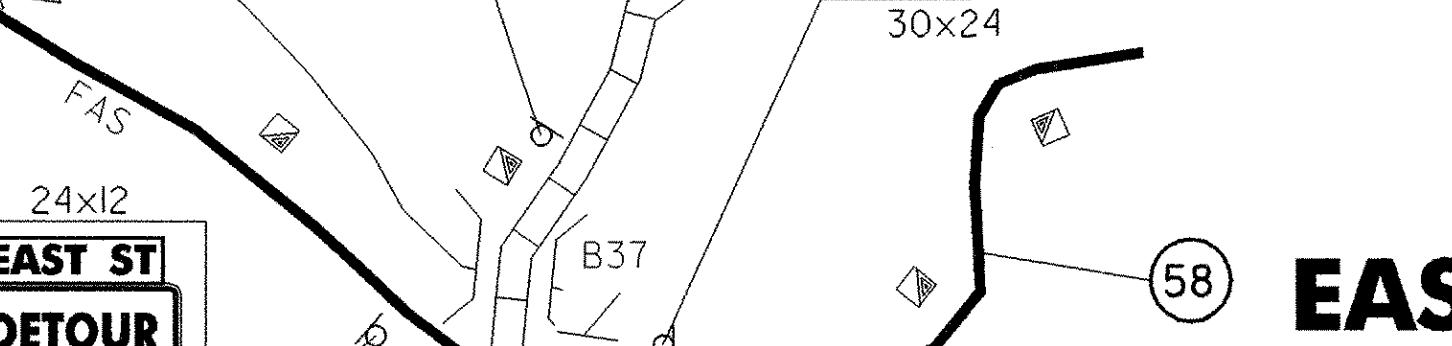
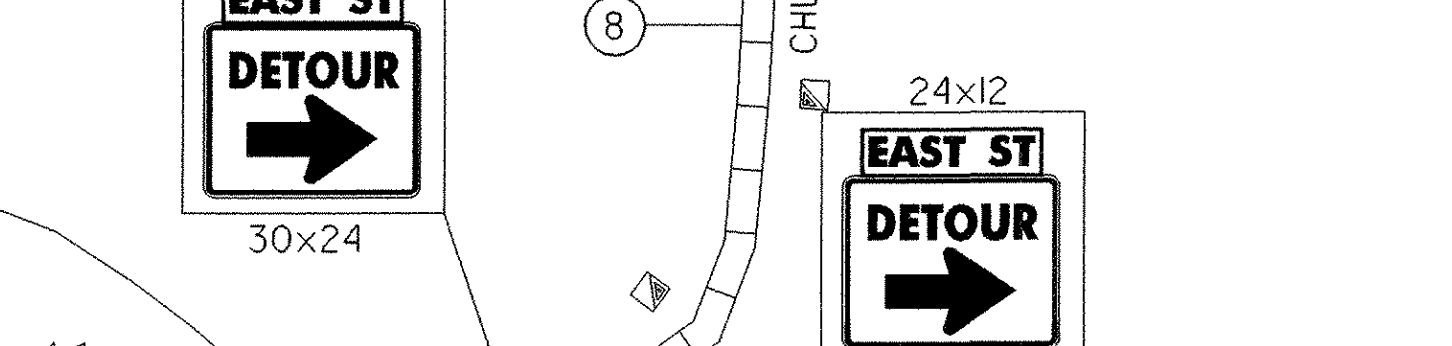
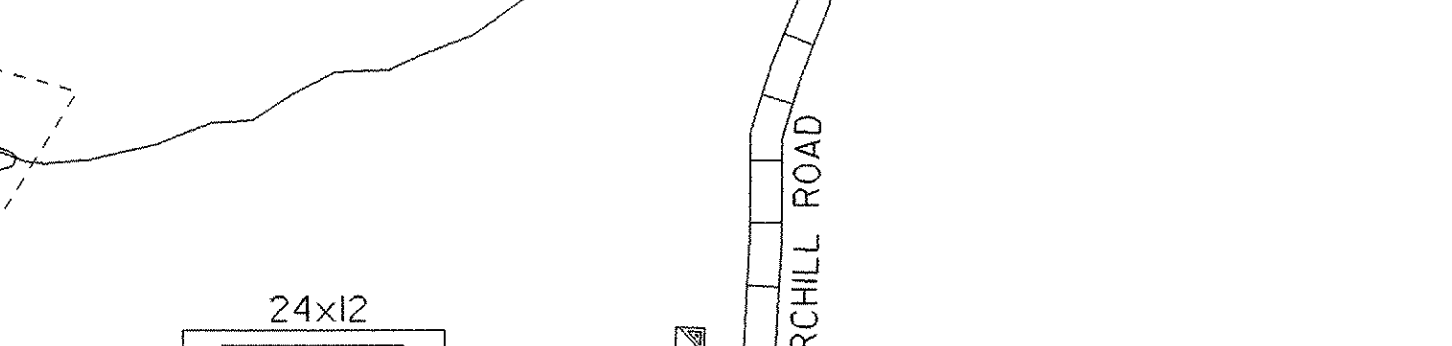
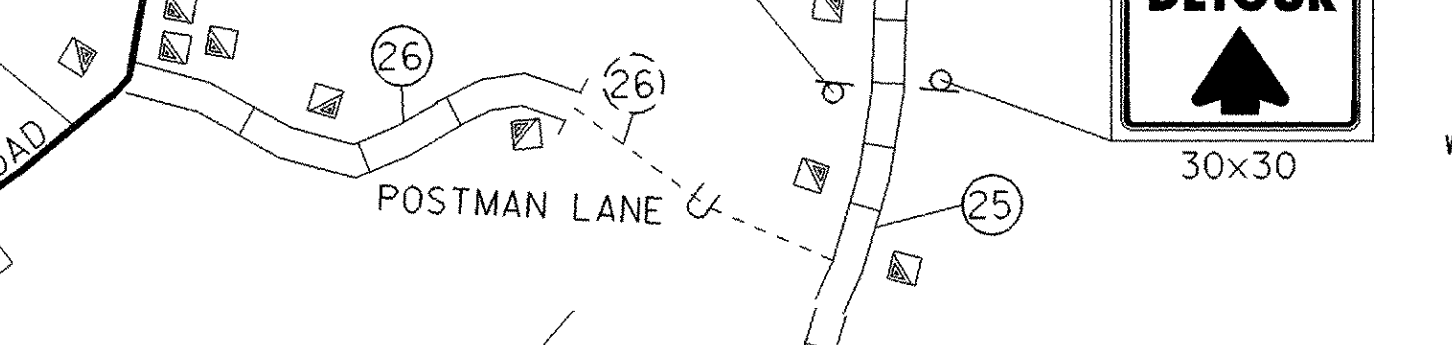
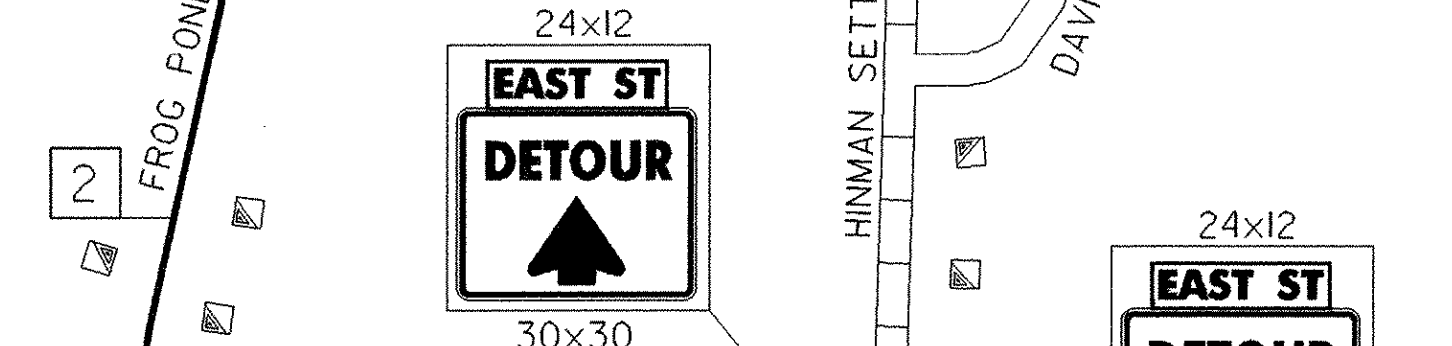
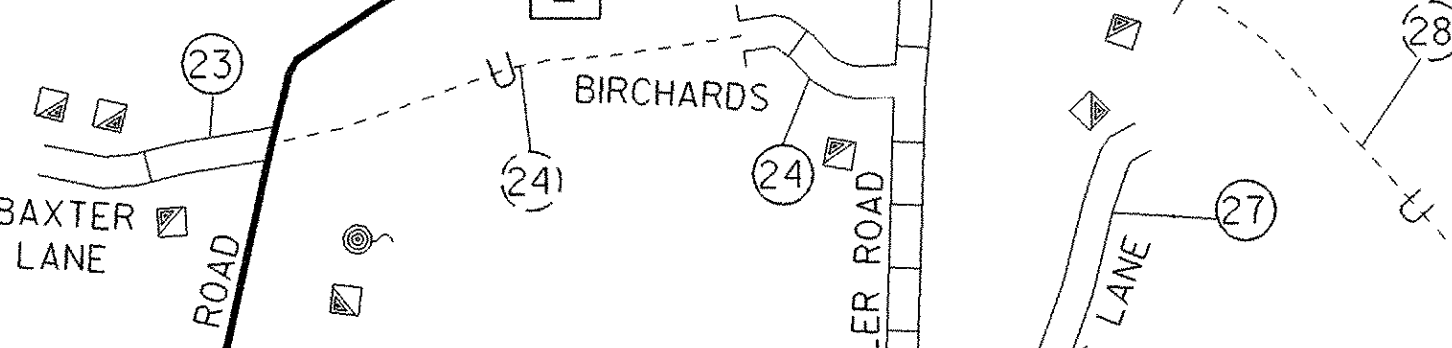
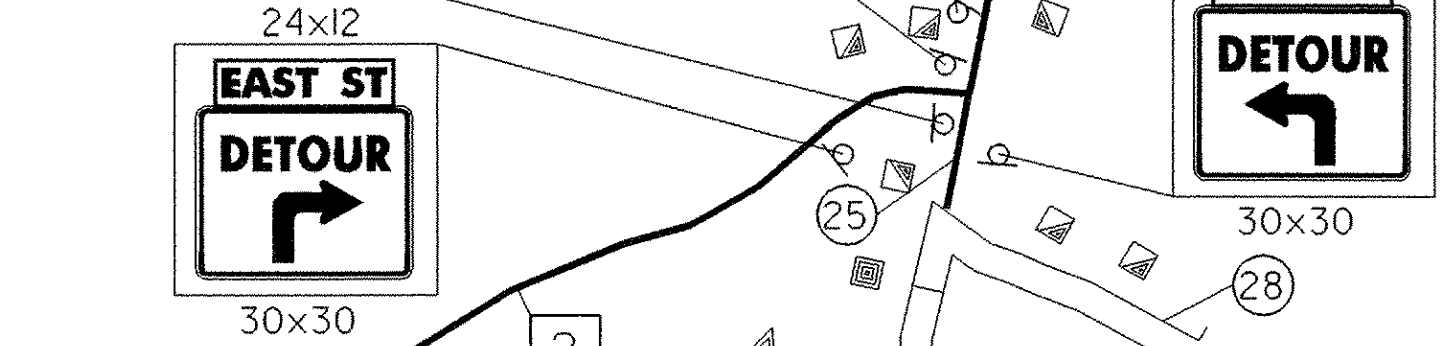
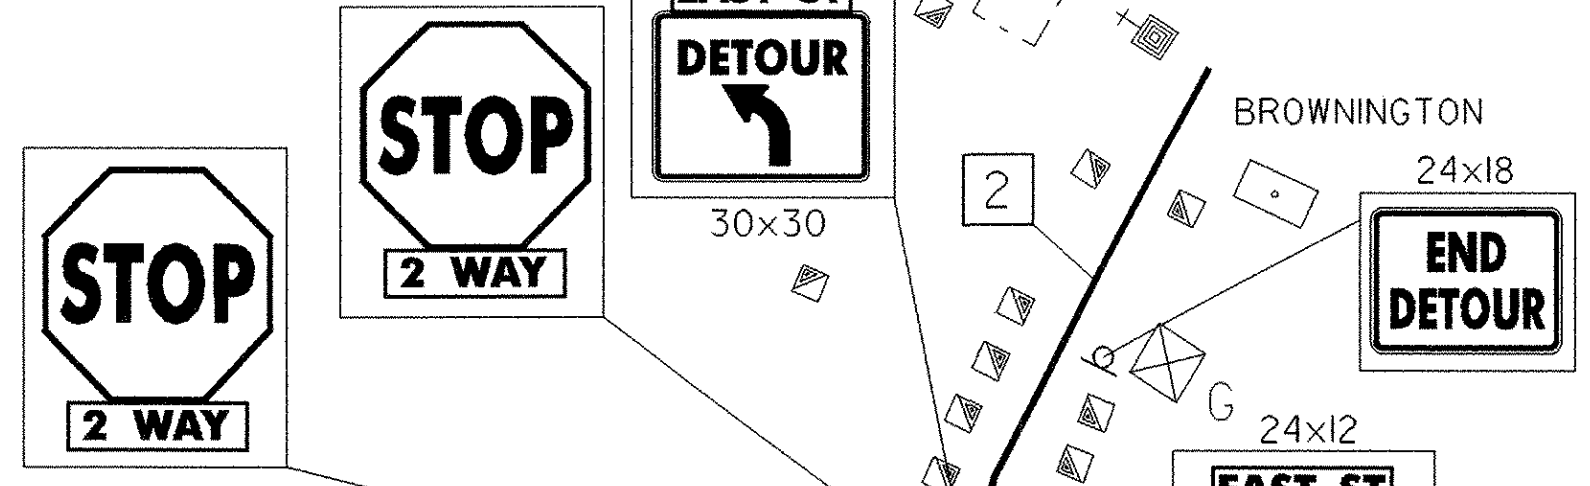
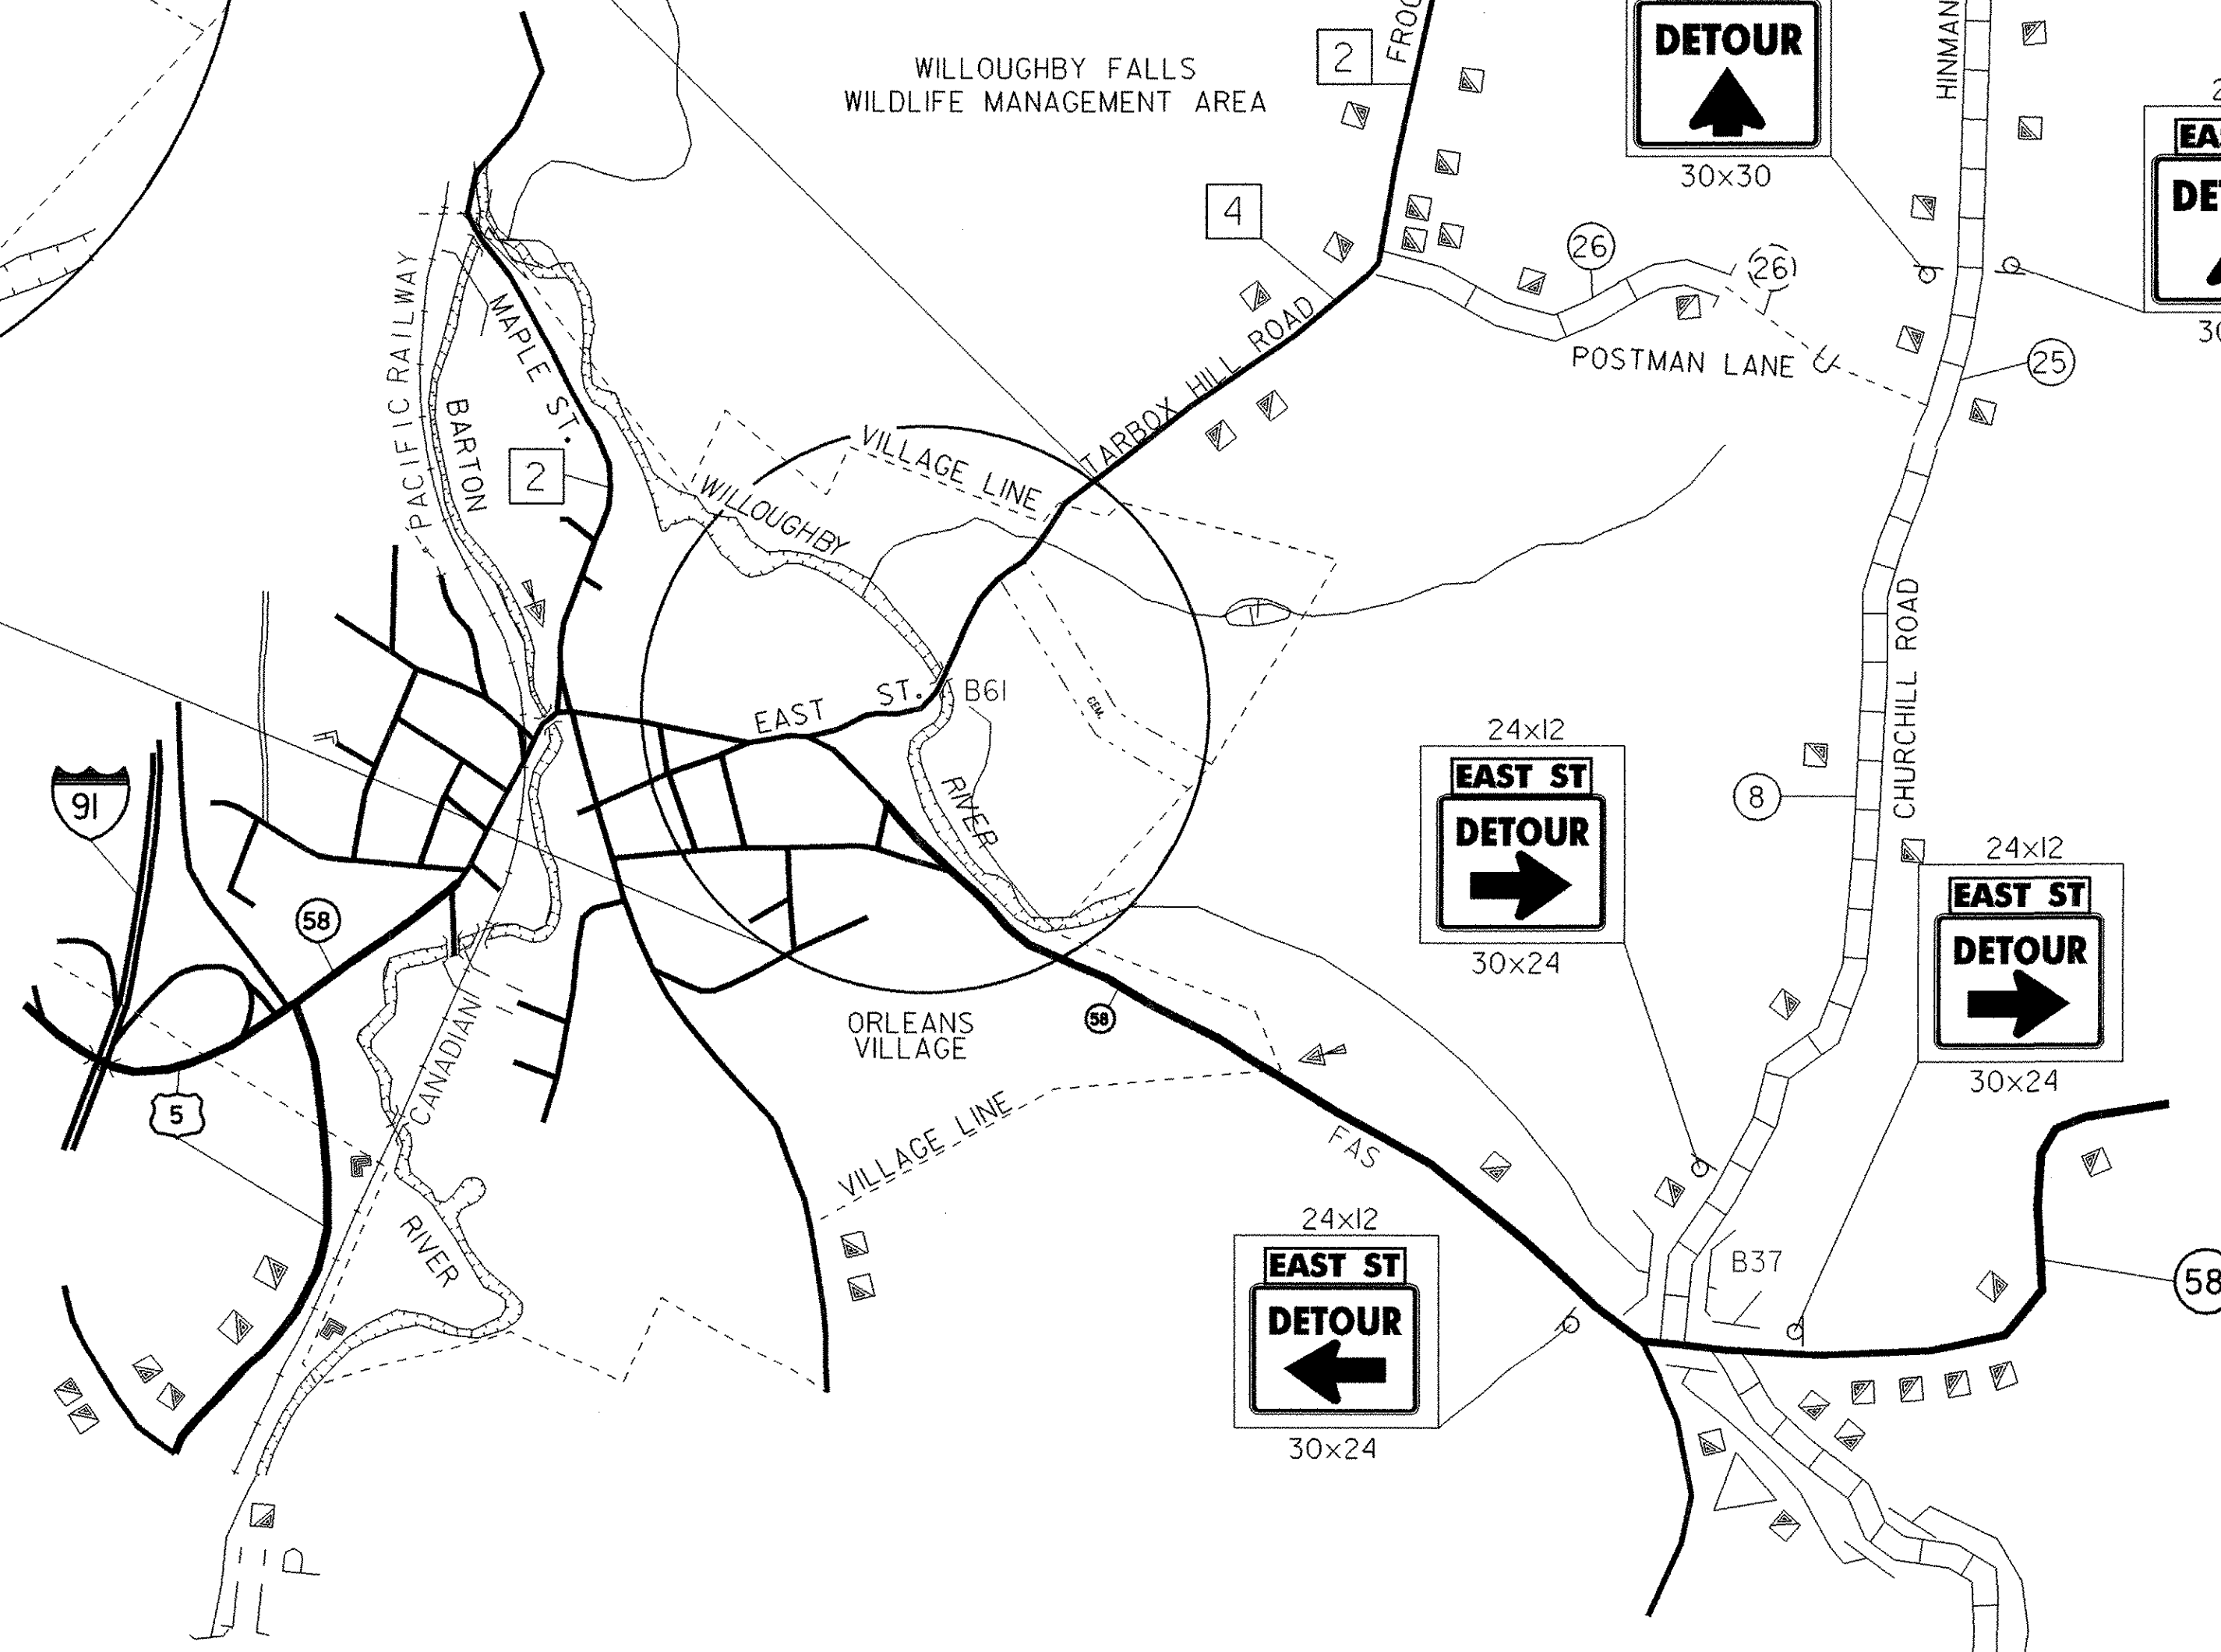
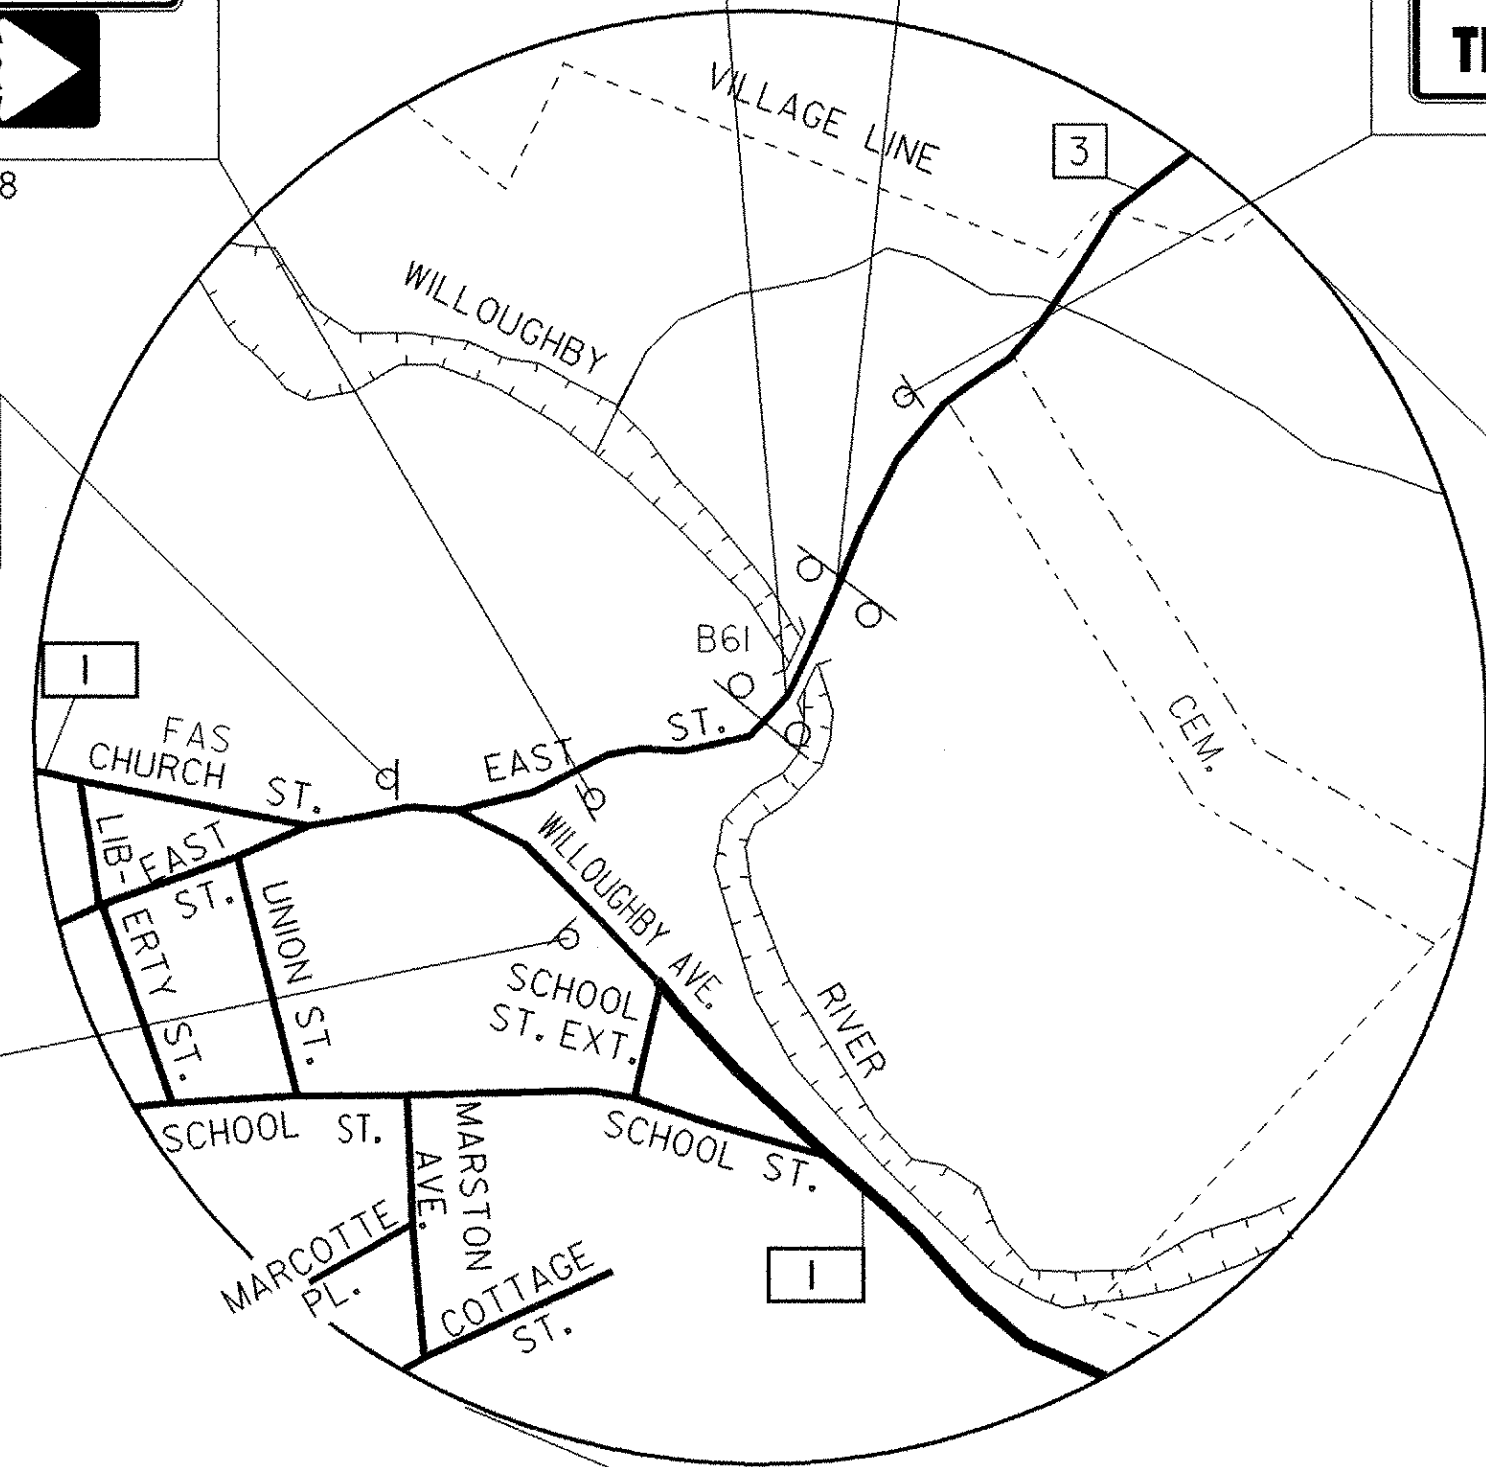



TO BE PLACED ON TYPE III BARRICADES PER TYPICAL APPLICATION #20

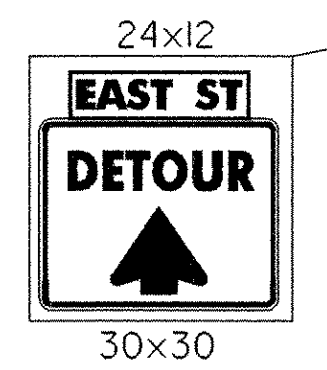

TO BE PLACED ON TYPE III BARRICADES PER TYPICAL APPLICATION #20

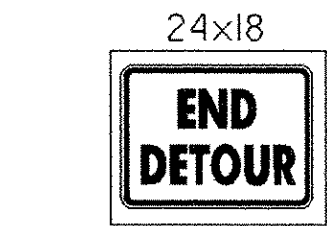

STANDARD LAYOUT FOR SINGLE INTERSECTIONS: FROG POND RD/HINMAN SETTLER RD WILLOGHBY AVE/EAST ST

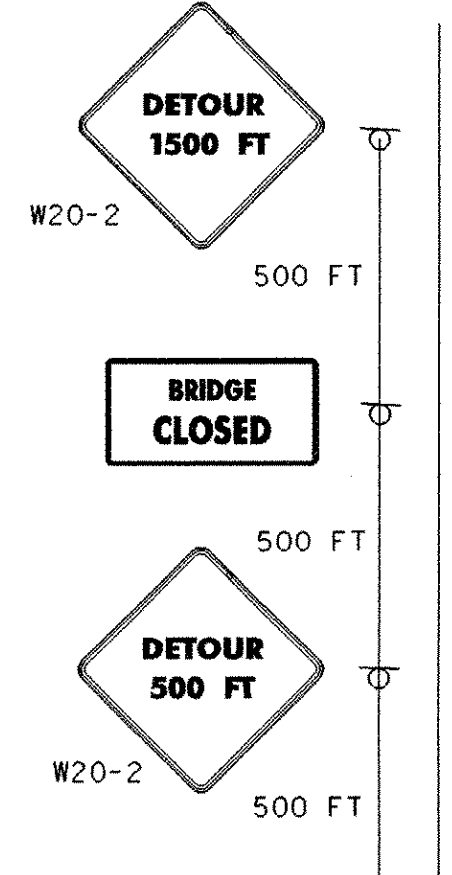

STANDARD LAYOUT FOR MULTIPLE INTERSECTIONS: EAST ST/CHURCH ST

EAST STREET DETOUR LAYOUT

PROJECT NAME:	BARTON
PROJECT NUMBER:	BRO 1449 (29)
FILE NAME: /s/tr5/01j168/sj168trf.dgn	PLOT DATE: 02-APR-2007
PROJECT LEADER: W. SYMONDS	DRAWN BY: J. GILMORE
DESIGNED BY: J. REED	CHECKED BY: J. REED
sj168esd.i	SHEET 29 OF 84