


PLAN
SCALE 1" = 10'-0"

SEE RAIL LAYOUT SHEET FOR GUARD RAIL LAYOUTS (SHEET 60).
FOR BRIDGE TO GUARDRAIL TRANSITIONS,
SEE CONCRETE BRIDGE RAILING DETAILS (SHEETS 61 & 62).

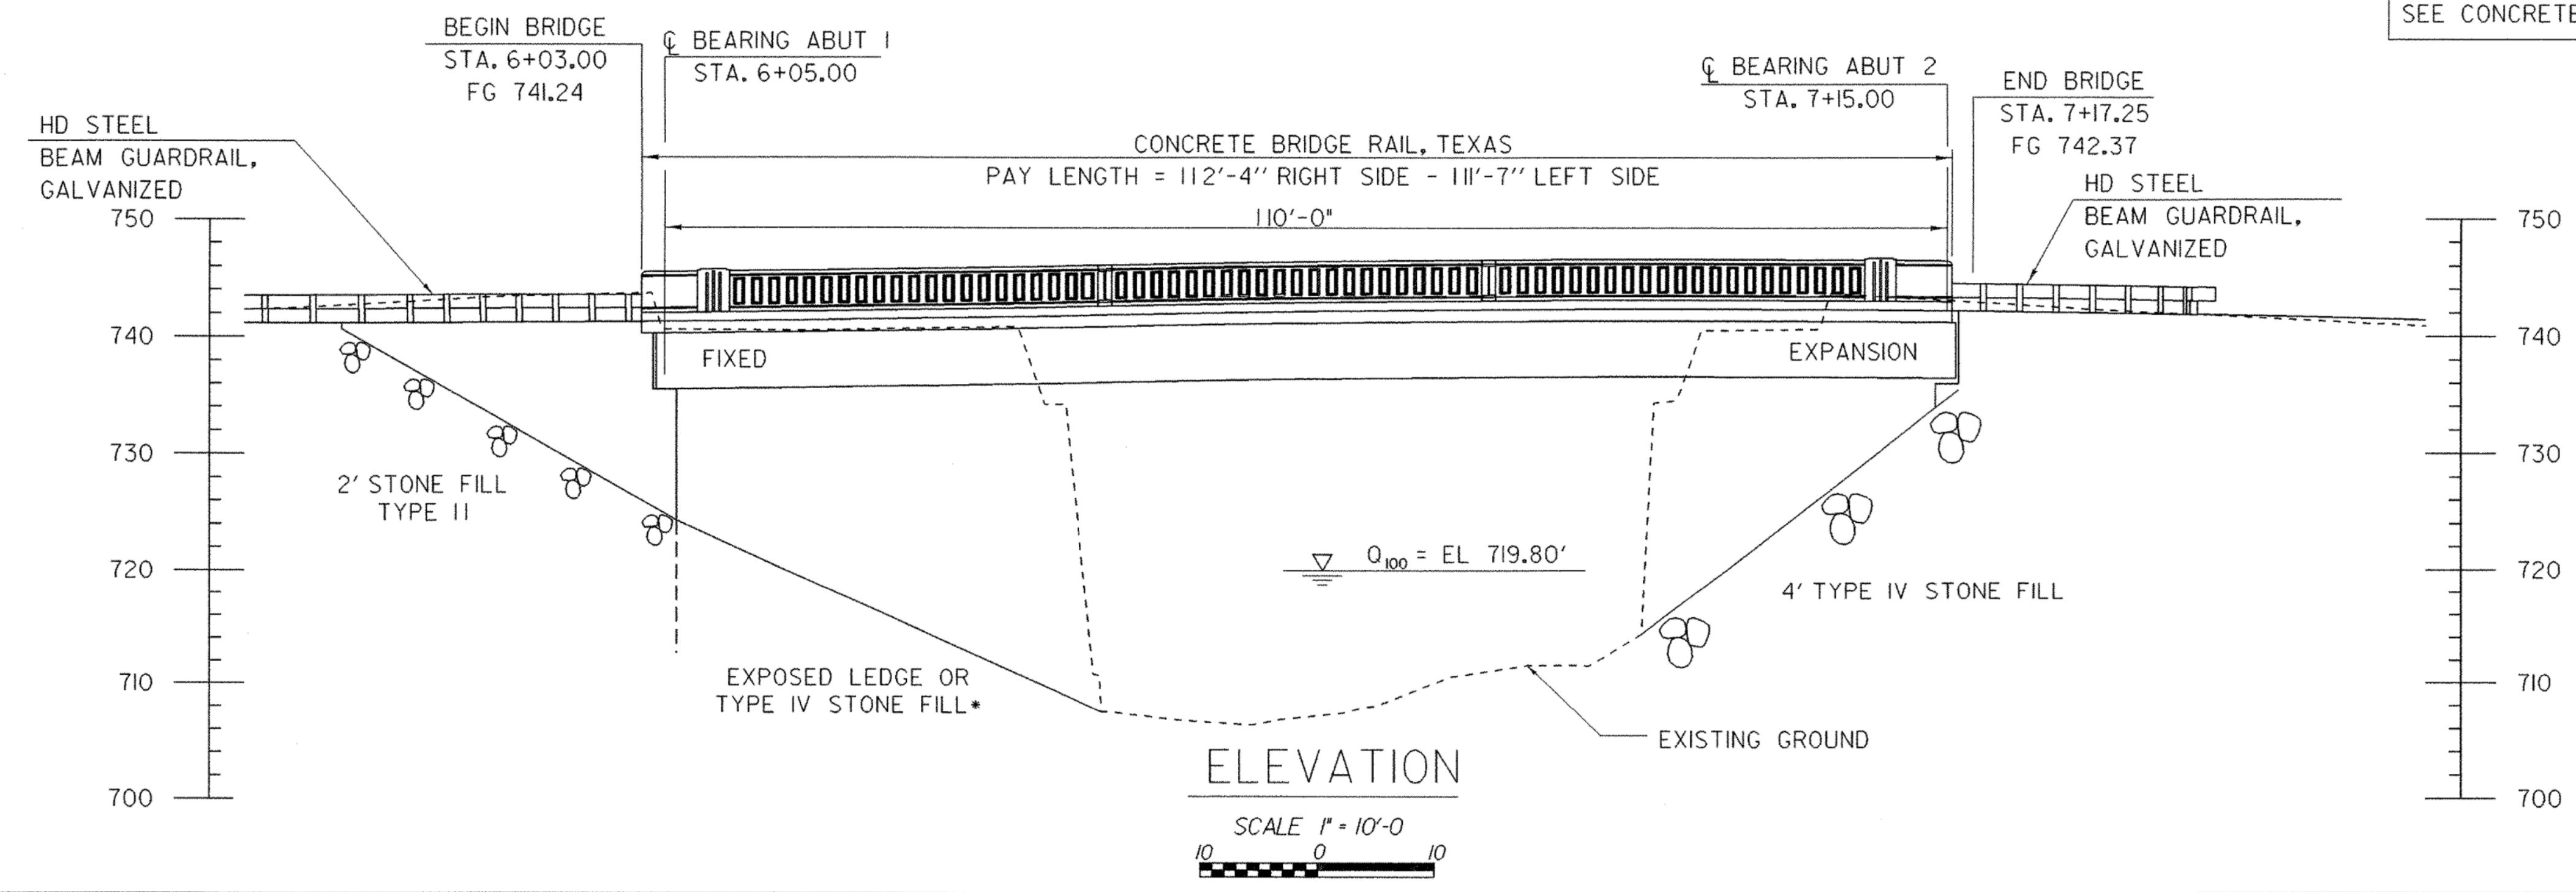

ELEVATION
SCALE 1" = 10'-0"

PLAN & ELEVATION

PROJECT NAME: BARTON	PLOT DATE: 02-APR-2007
PROJECT NUMBER: BRO 1449 (29)	DRAWN BY: J. REED
FILE NAME: /str5/01j68/sj168pe.dgn	CHECKED BY: T. SUMNER
PROJECT LEADER: W. SYMONDS	SHEET 35 OF 84
DESIGNED BY: J. REED	
sj168pe.1	