


ABUTMENT #1 ELEVATION

SCALE 3/8" = 1'-0"
 1 0 1 2 3 4

ftg - revised 6/29/07

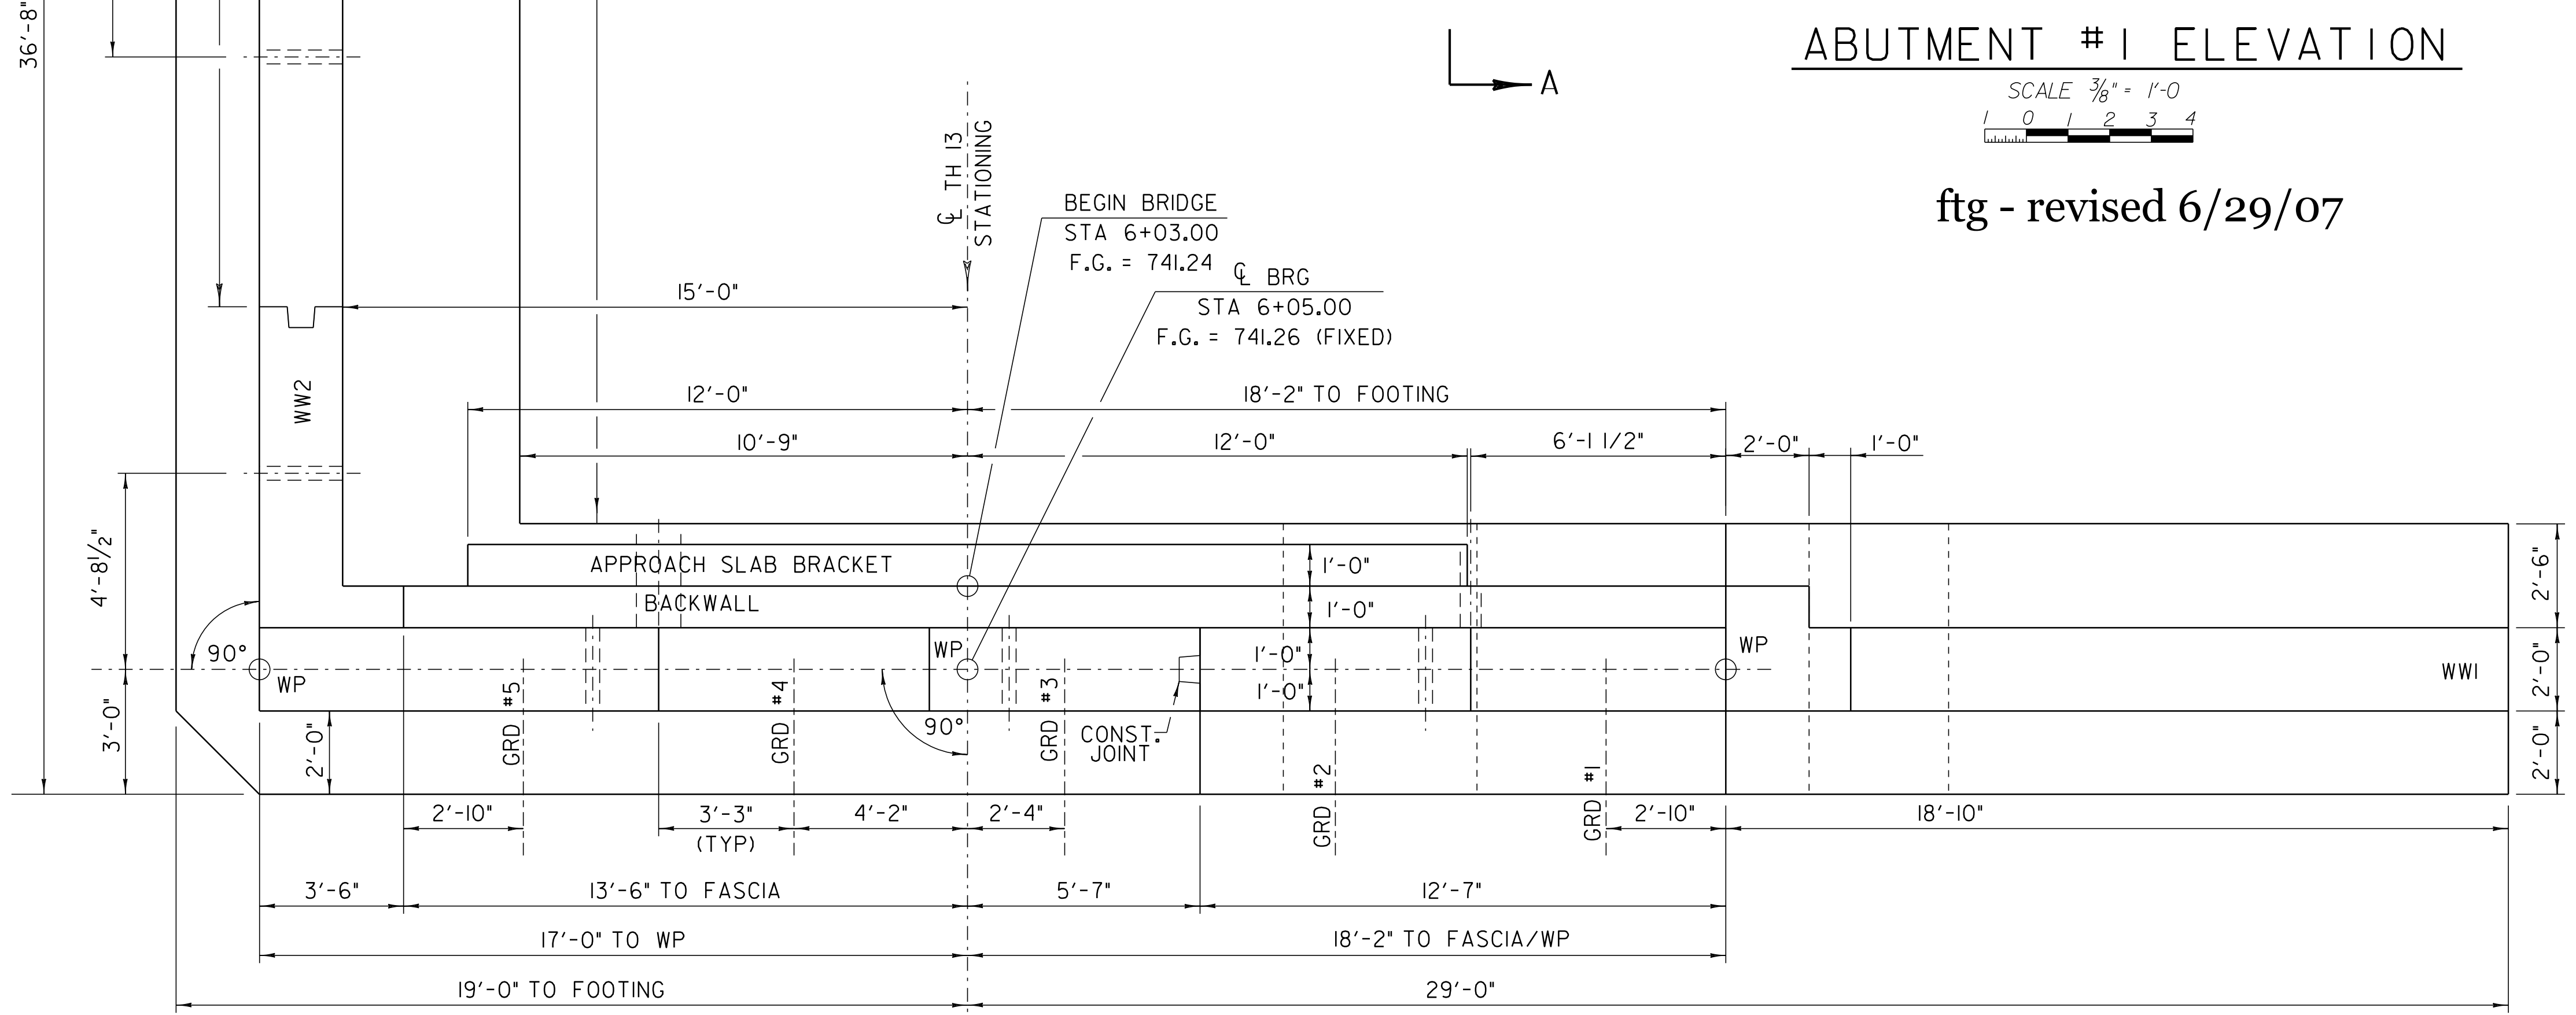

ABUTMENT #1 PLAN

SCALE 3/8" = 1'-0"
 1 0 1 2 3 4

ftg - revised 6/29/07

NOTE:
 SECTION B ABUTMENT STEM WALL CAN BE POURED WITH WW1 FOOTING.
 NF = NEAR FACE
 FF = FAR FACE
 EF = EACH FACE
 ▲ = CUT TO FIT IN FIELD
 3" CLEAR UNLESS OTHERWISE SPECIFIED ON THE PLANS
 2'-2" BAR LAP UNLESS OTHERWISE SPECIFIED ON THE PLANS

ABUTMENT #1 DETAILS

PROJECT NAME:	BARTON	FILE NAME:	/str5/01j168/sj168sub.dgn	PLOT DATE:	12-SEP-2011
PROJECT NUMBER:	BRO 1449 (29)	PROJECT LEADER:	W. SYMONDS	DRAWN BY:	J. GILMORE
		DESIGNED BY:	J. REED	CHECKED BY:	J. REED
		sj168abl.i		SHEET	53 OF 84