


CORNER DETAIL WW1
ABOVE BRIDGE SEAT


SCALE 1/2" = 1'-0"
1 0 1 2

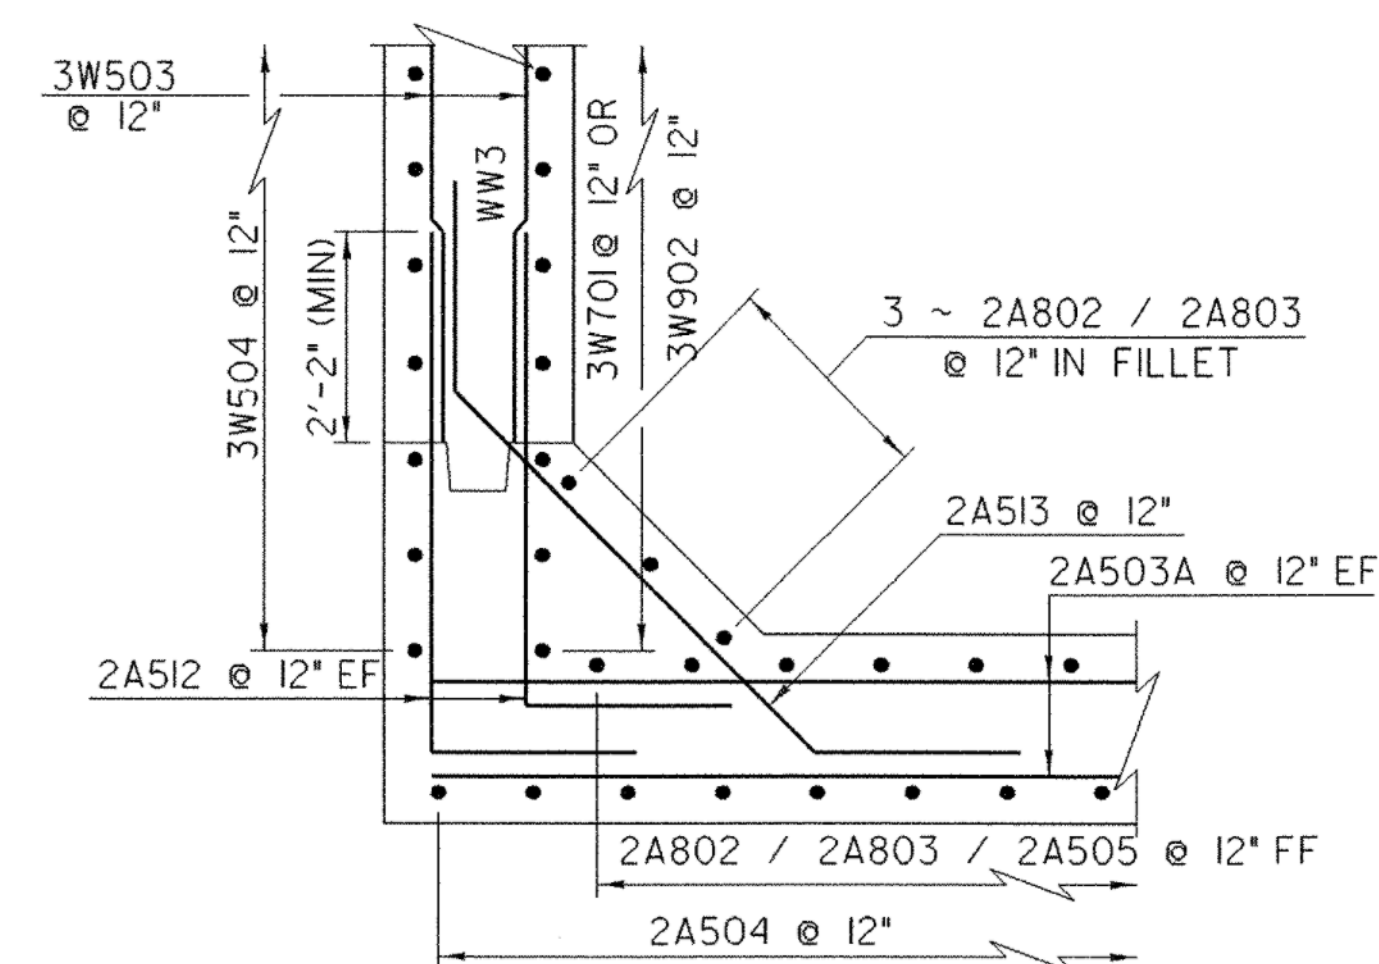

CORNER DETAIL WW3
BELOW BRIDGE SEAT


SCALE 1/2" = 1'-0"
1 0 1 2

NOTE:
STIRRUP BARS HAVE
BEEN OMITTED FOR
CLARITY.

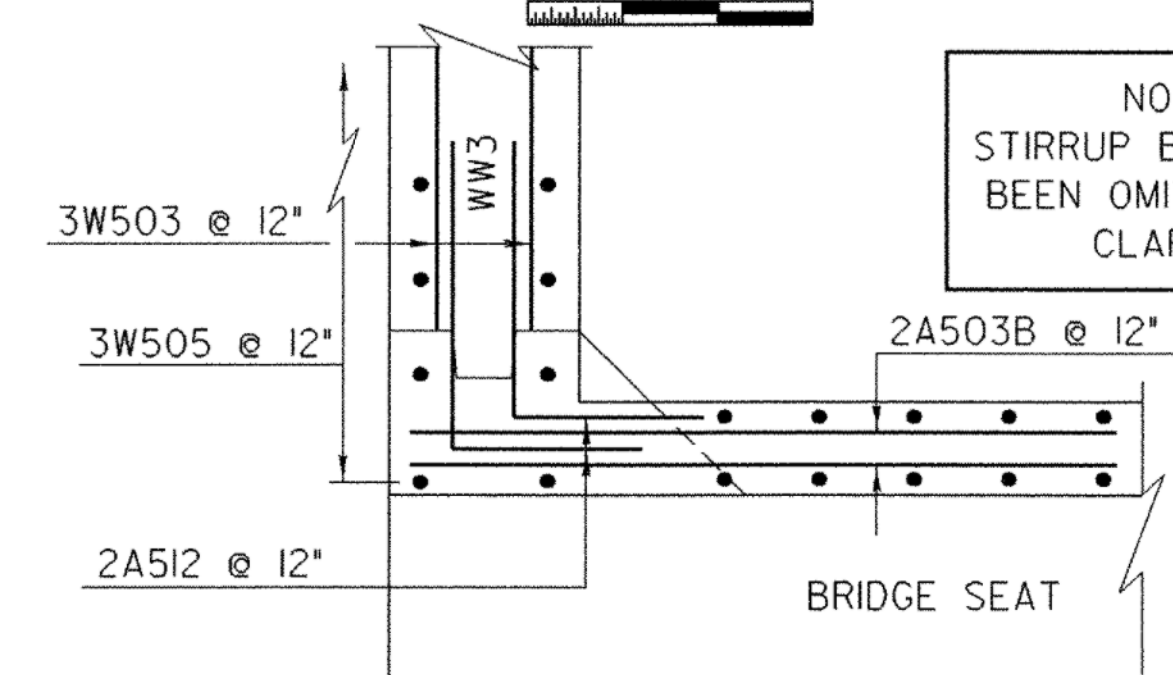

CORNER DETAIL WW3
ABOVE BRIDGE SEAT


SCALE 1/2" = 1'-0"
1 0 1 2

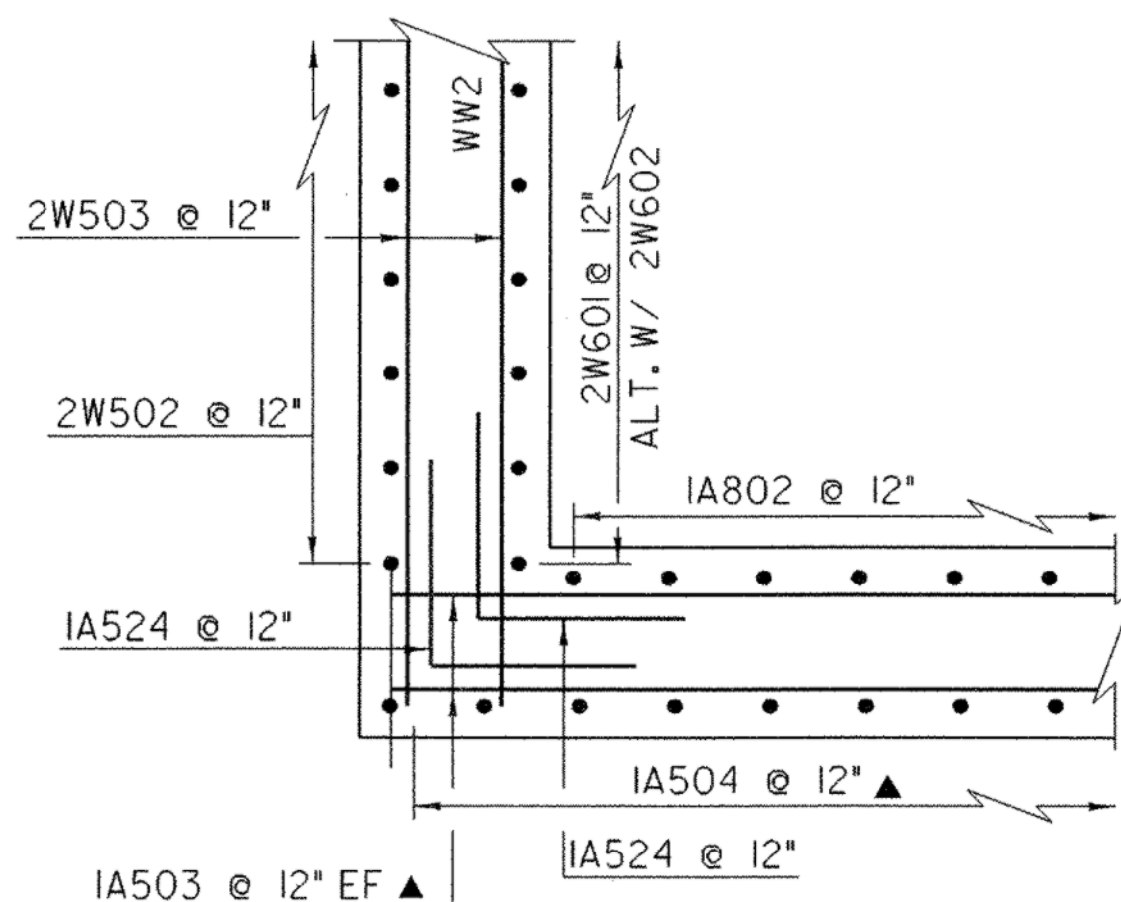

CORNER DETAIL WW2
BELOW BRIDGE SEAT


SCALE 1/4" = 1'-0"
1 0 2 4 6

NOTE:
STIRRUP BARS HAVE
BEEN OMITTED FOR
CLARITY.

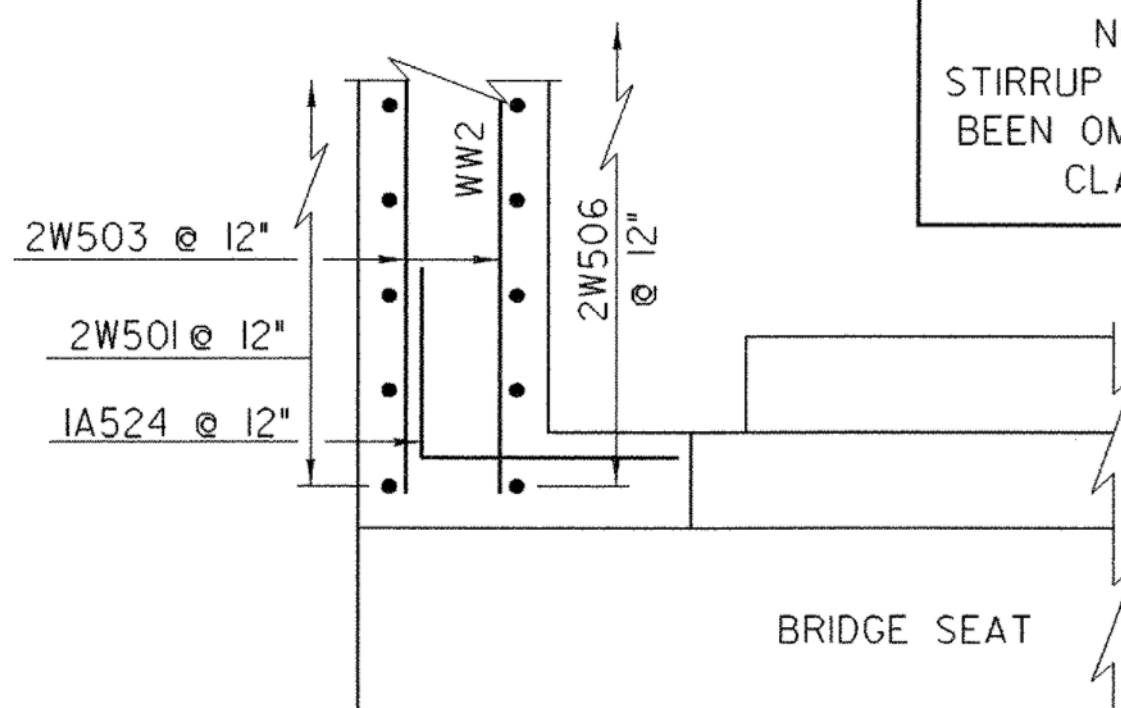

CORNER DETAIL WW2
ABOVE BRIDGE SEAT

SCALE 1/4" = 1'-0"
1 0 2 4 6

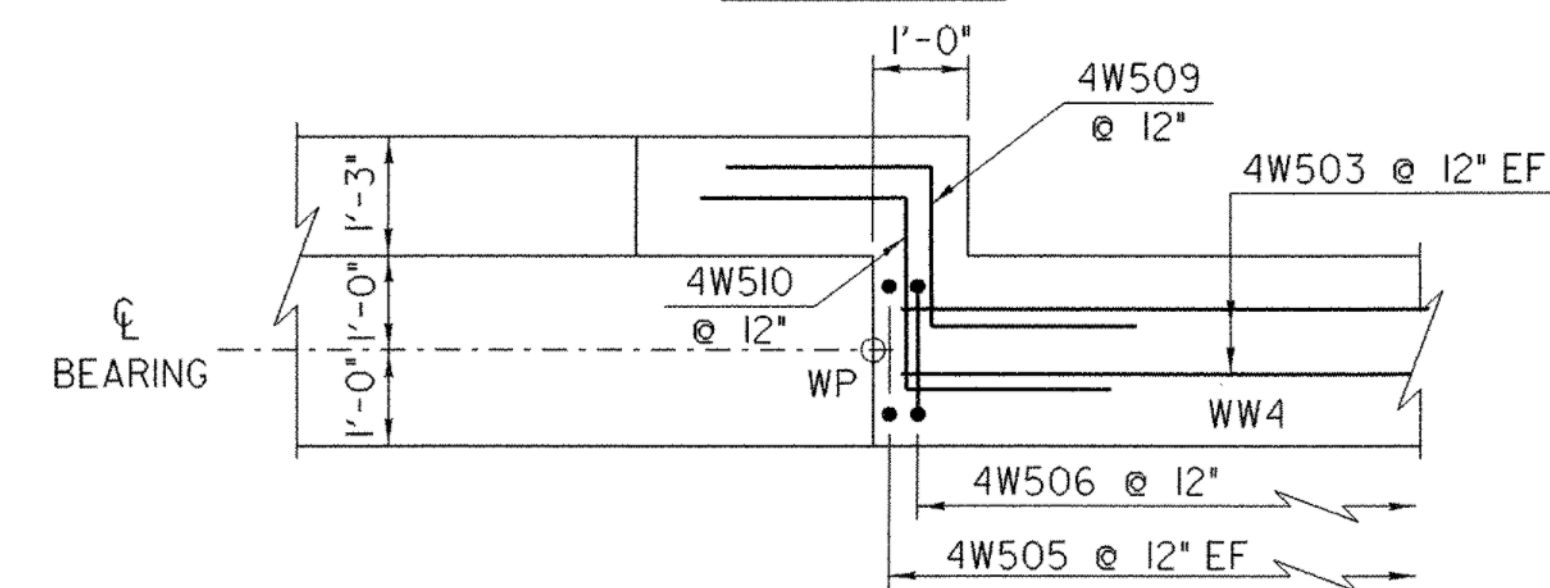

CORNER DETAIL WW4
ABOVE BRIDGE SEAT

SCALE 1/2" = 1'-0"
1 0 1 2

NOTE:

NF = NEAR FACE
FF = FAR FACE
EF = EACH FACE
▲ = CUT TO FIT IN FIELD
3' CLEAR UNLESS OTHERWISE
SPECIFIED ON THE PLANS
2'-2" BAR LAP UNLESS OTHERWISE
SPECIFIED ON THE PLANS

ABUTMENT #2 AND WINGWALL #4 HAVE BEEN
REVISED DUE TO THE OCCURRENCE OF COMPETENT
BEDROCK SHALLOWER THEN EXPECTED. SEE REVISED
SHEET, PLOT DATE 06-JUL-2007.

CORNER DETAIL

PROJECT NAME:	BARTON	FILE NAME:	/str5/01j168/sj168sub.dgn	PLOT DATE:	02-APR-2007
PROJECT NUMBER:	BRO 1449 (29)	PROJECT LEADER:	W. SYMONDS	DRAWN BY:	J. SALVATORI
		DESIGNED BY:	J. LACROIX	CHECKED BY:	T. SUMNER
			sj168abs.i	SHEET	56 OF 84