


# BANKING DIAGRAM

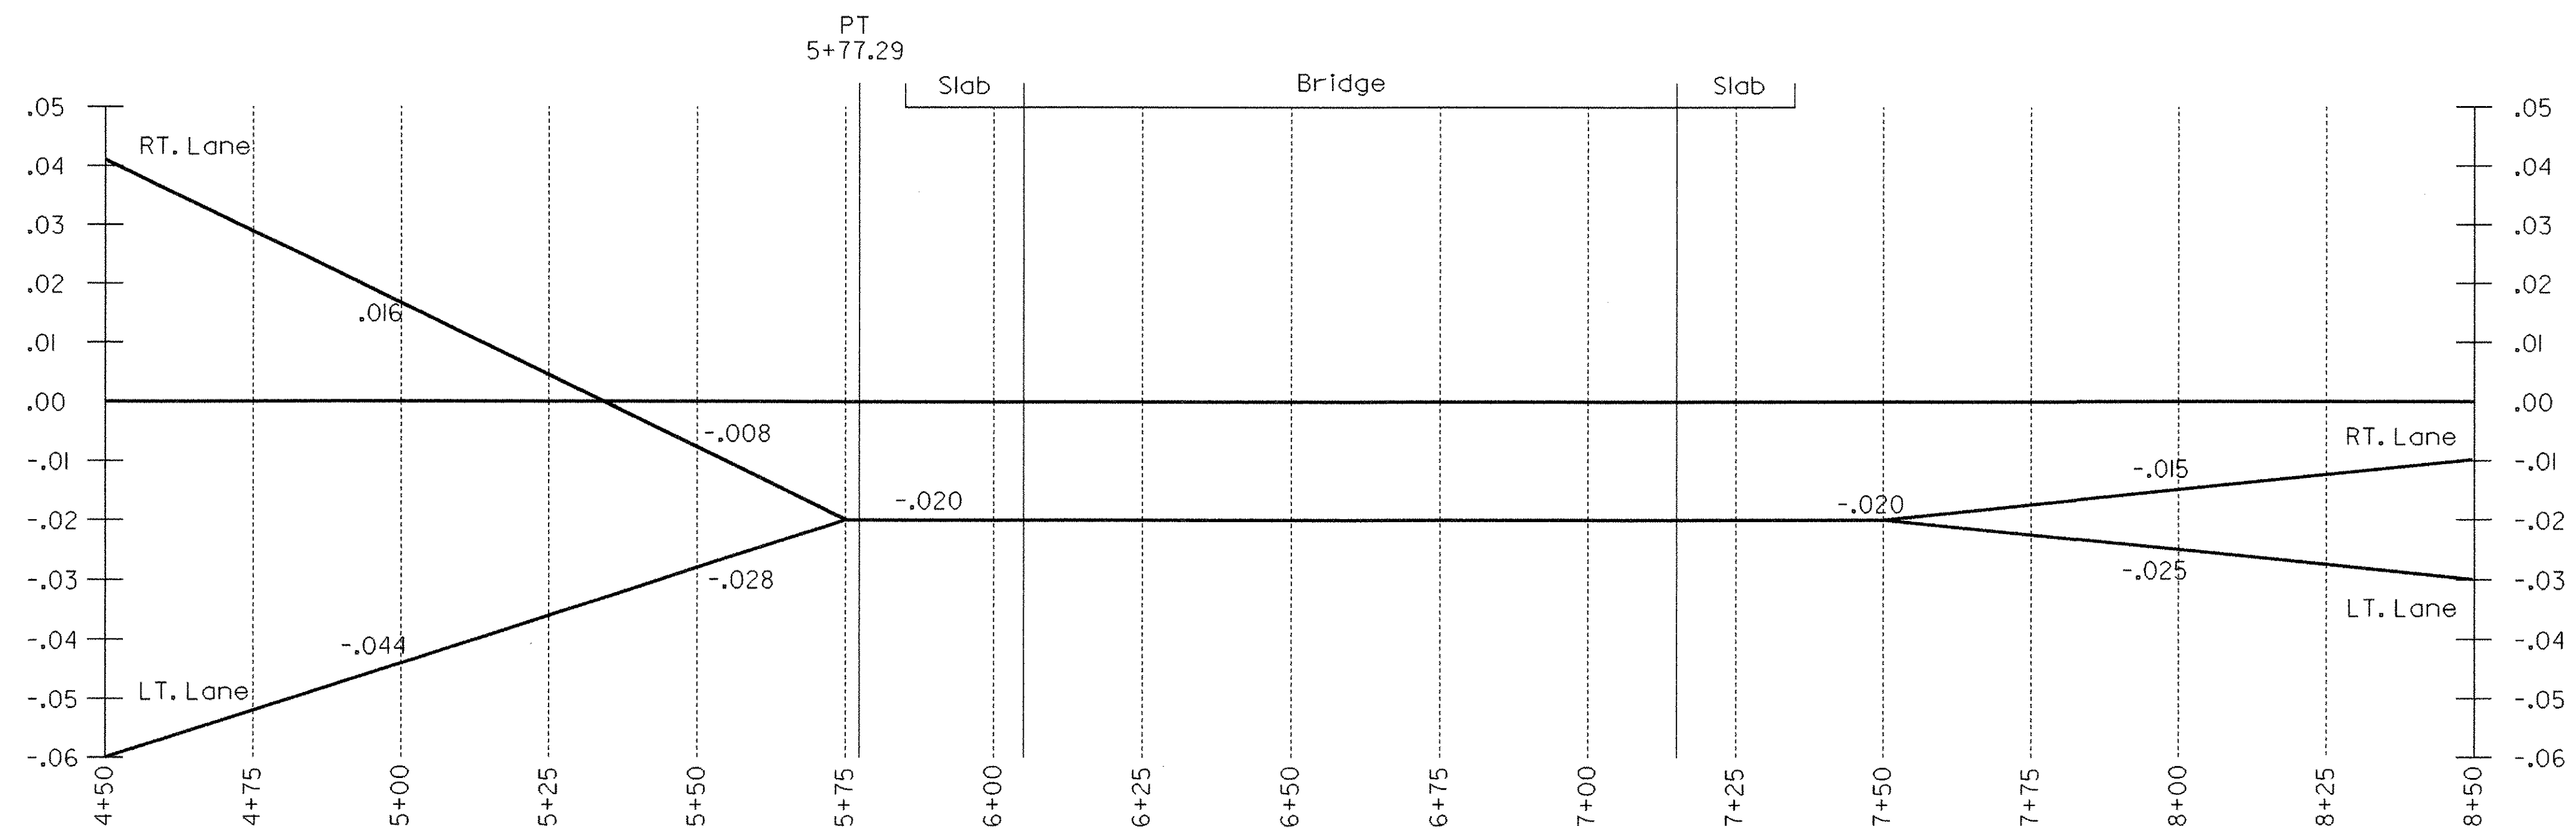

## BANKING DIAGRAM

|                                     |                        |
|-------------------------------------|------------------------|
| PROJECT NAME: BARTON                | PLOT DATE: 02-APR-2007 |
| PROJECT NUMBER: BRO 1449 (29)       | DRAWN BY: J. REED      |
| FILE NAME: /s+r5/01j168/sj168xs.dgn | CHECKED BY: J. LACROIX |
| PROJECT LEADER: W. SYMONDS          | SHEET 64 OF 84         |
| DESIGNED BY: J. REED                |                        |
| sj168bnk.l                          |                        |