
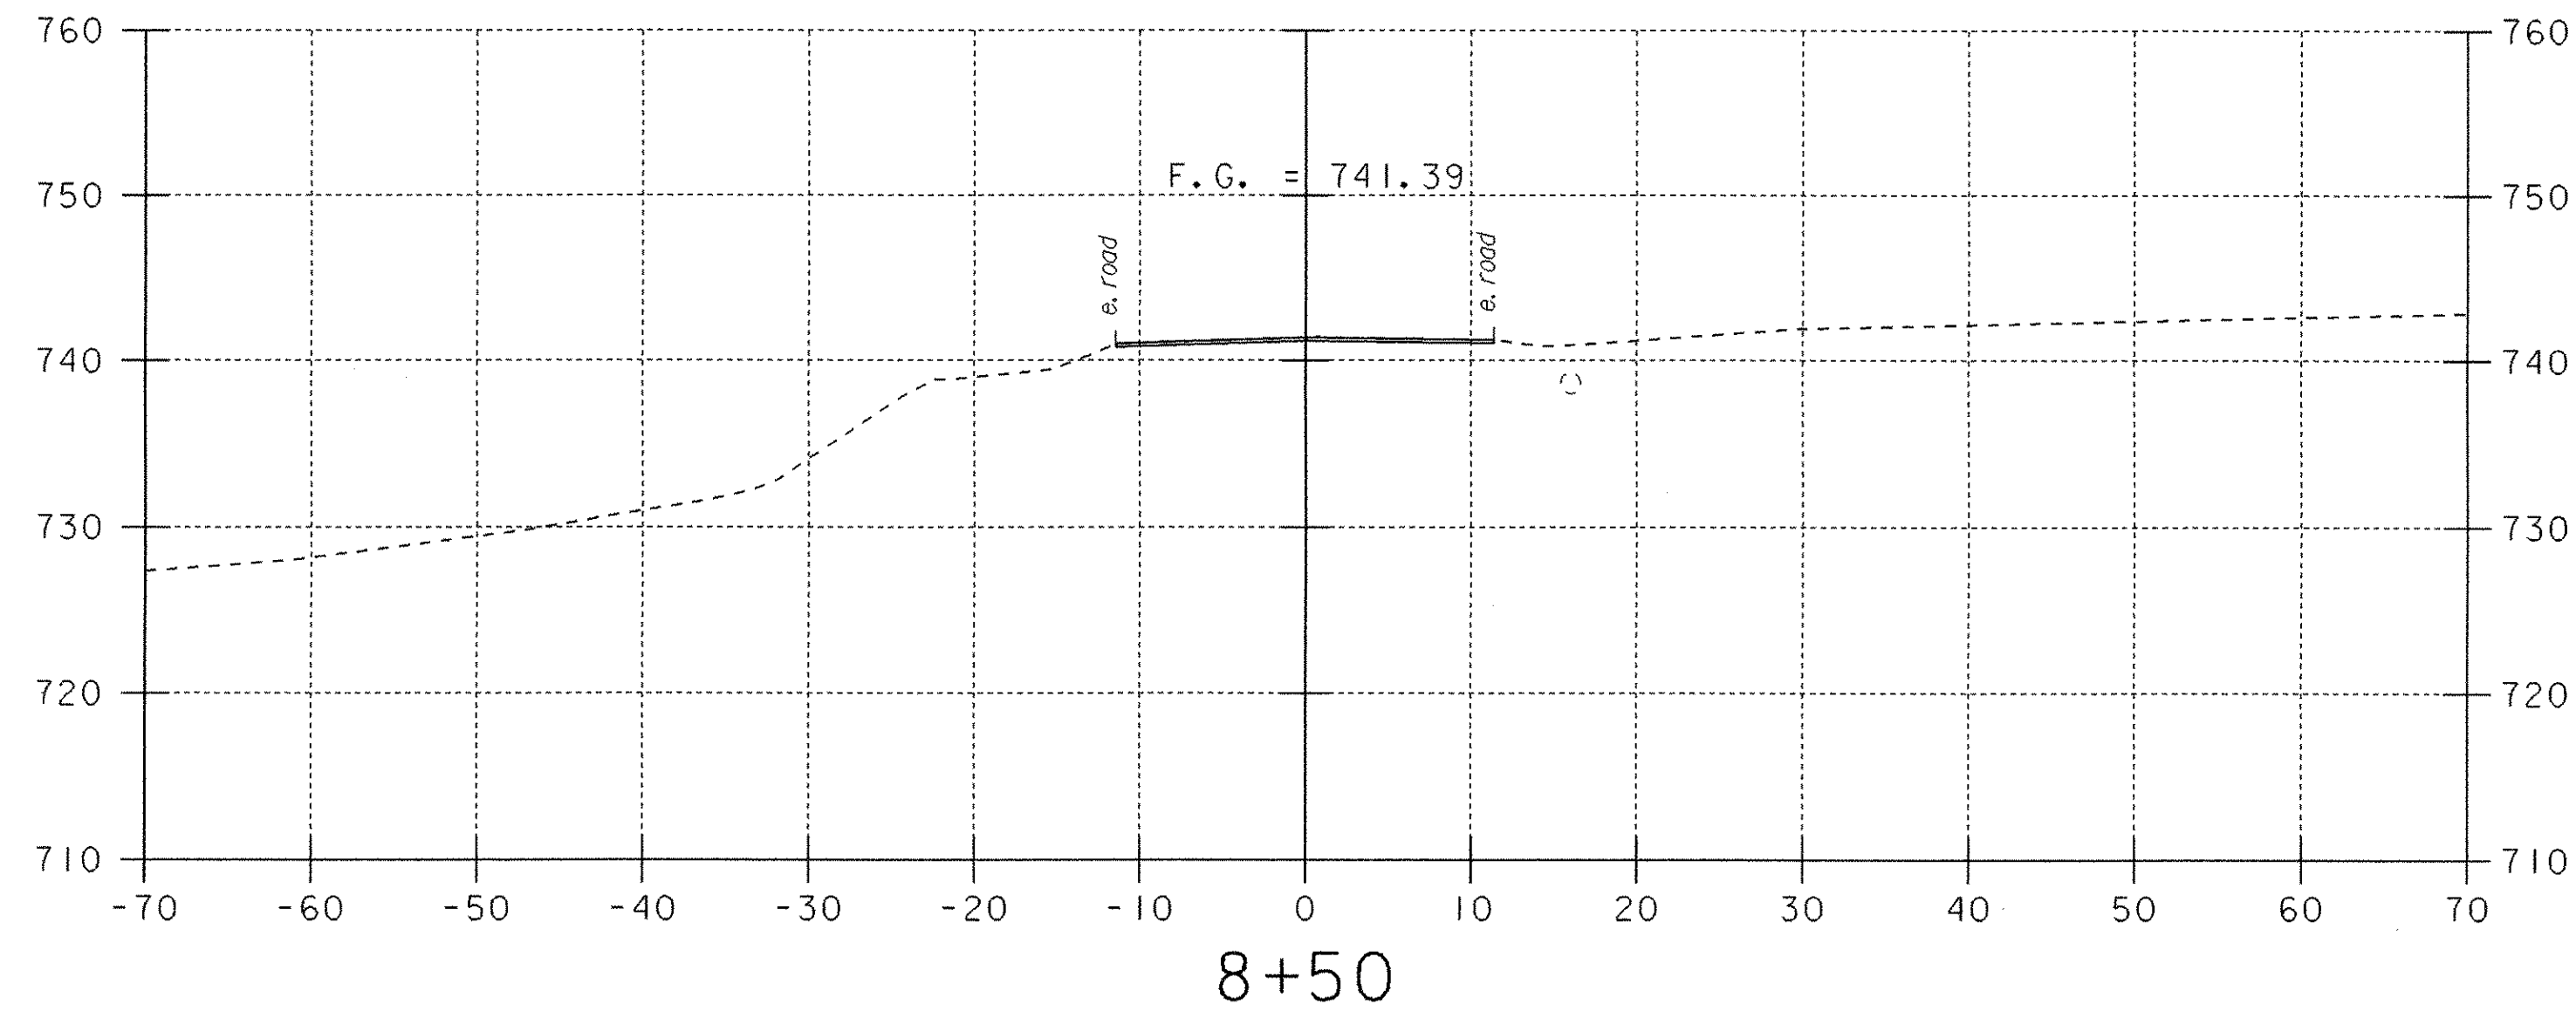


# MATERIAL TRANSITION DIAGRAM

N.T.S.

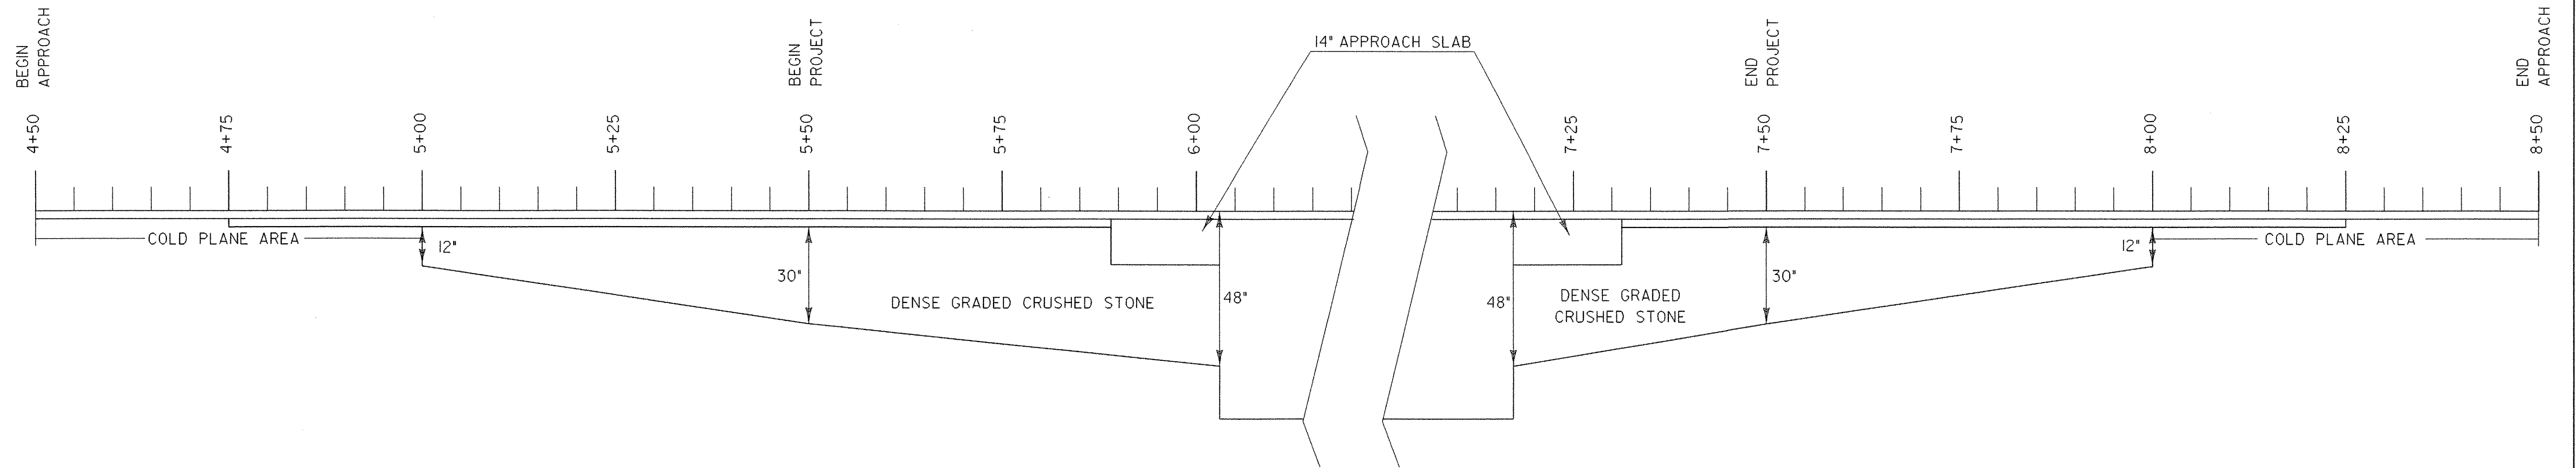

## ROADWAY CROSS SECTIONS

PROJECT NAME: BARTON	
PROJECT NUMBER: BRO 1449(29)	
FILE NAME: /s+r5/01j168/sj168xs.dgn	PLOT DATE: 02-APR-2007
PROJECT LEADER: W. SYMONDS	DRAWN BY: G. SHANGRAW
DESIGNED BY: W. SYMONDS	CHECKED BY: J. LACROIX
sj168x5.1	SHEET 74 OF 84

