


STA 20+56
 END ROADWAY QUANTITIES
 BEGIN CHANNEL QUANTITIES:
 STONE FILL, TYPE III
 GRUBBING MATERIAL
 GEOTEXTILE UNDER STONE FILL
 CHANNEL EXCAVATION OF EARTH

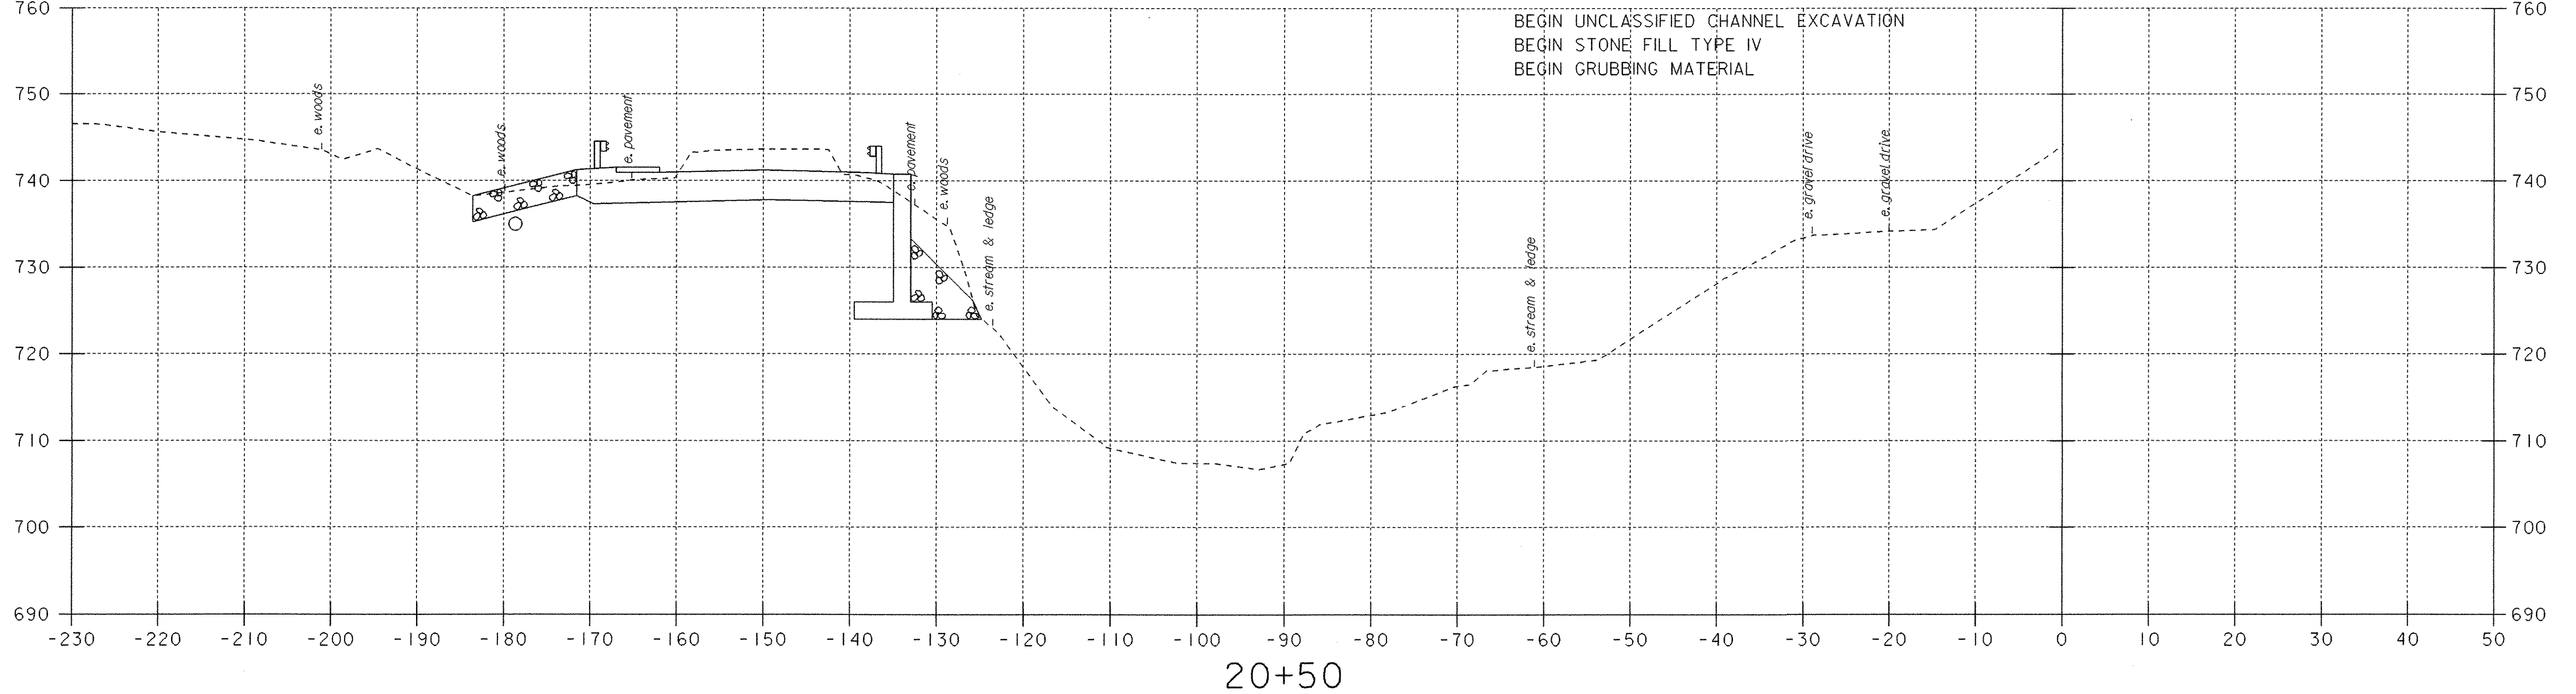

CHANNEL CROSS SECTIONS

PROJECT NAME:	BARTON	FILE NAME:	/str5/01j68/sj168xs.dgn	PLOT DATE:	02-APR-2007
PROJECT NUMBER:	BRO 1449 (29)	PROJECT LEADER:	W. SYMONDS	DRAWN BY:	J. REED
		DESIGNED BY:	J. REED	CHECKED BY:	J. LACROIX
			sj168cx2.i	SHEET	76 OF 84

