


109 HR

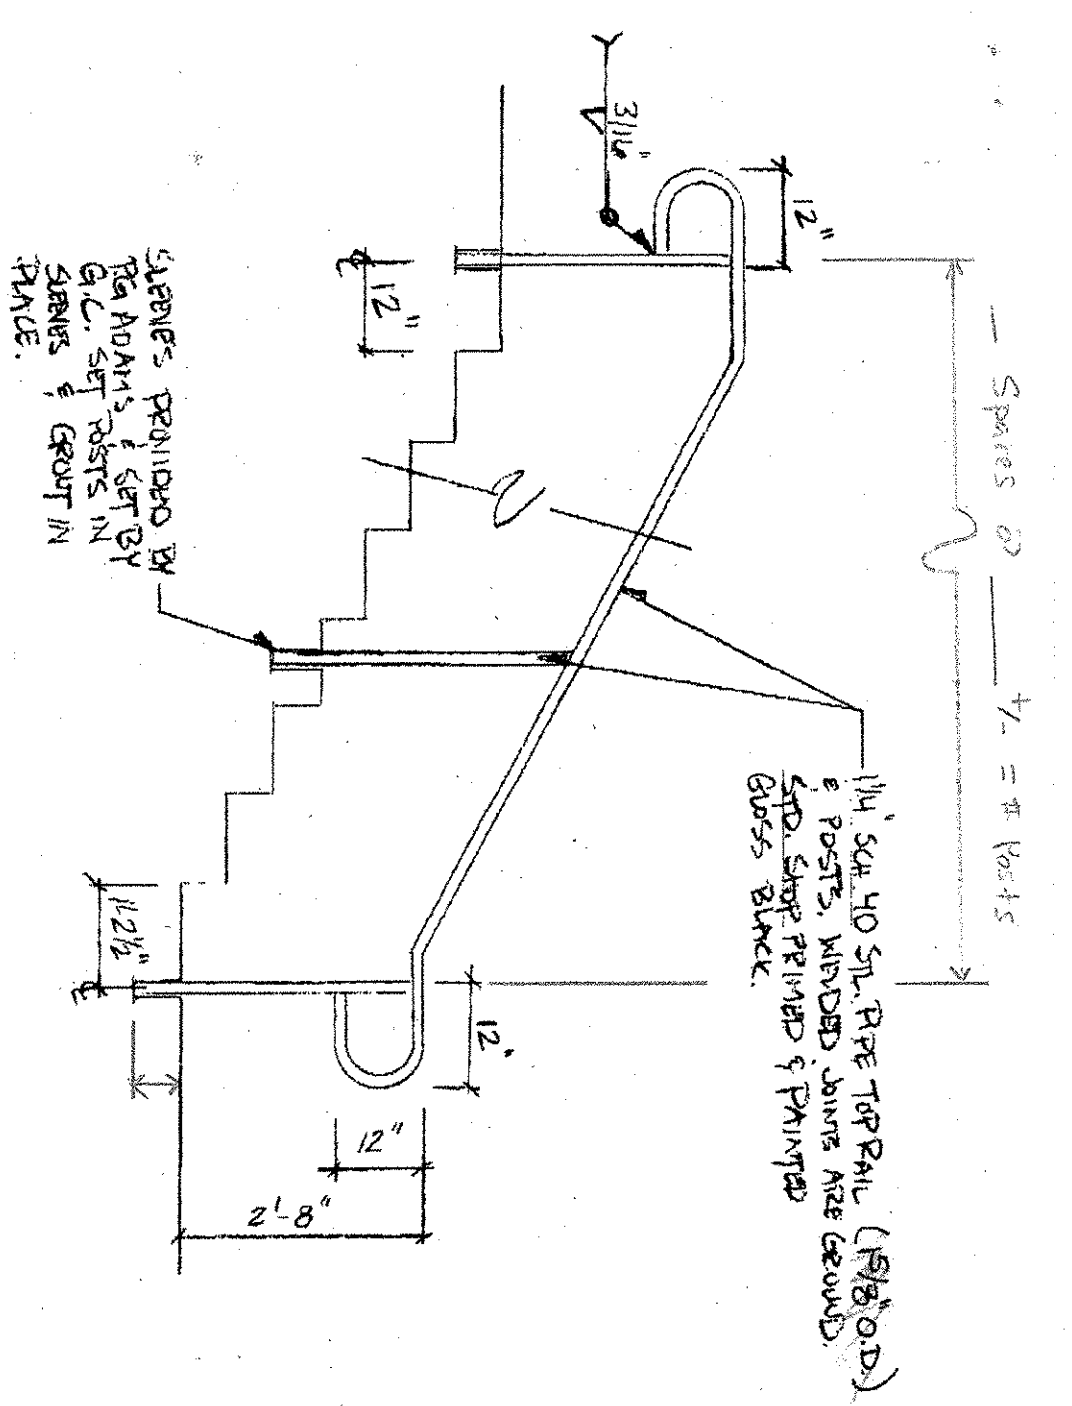

1 1/2" SCHED 40 STL PIPE TOP RAIL (SCHED 40)  
 \* POSTS, WELDED TO THE GROUND AND  
 AND SUPPORT FRAMES & FINISHES  
 ACCORDING TO SPEC.

\* SPACERS PAINTED BY  
 REG. PAINTERS & SET BY  
 G.C. SET POSTS IN  
 SPACES & GROUT IN  
 PLACE.

NOTE:  
 ALL WELDING SHALL  
 CONFORM TO THE  
 CODE FOR WELDING IN  
 BUILDING CONSTRUCTION  
 OF THE AMERICAN  
 WELDING SOCIETY  
 USING THE SMAW  
 PROCESS.

\* # Posts = \_\_\_\_\_  
 \* Detail Skews = \_\_\_\_\_

RECEIVED  
 APR 21 2008  
 SUBMITTED BY: JTS - JTS  
 APPROVED AS NOTED BY: KMH  
 DATE: 04/23/08

VT AOT, BARTON  
 P. ADAMS, INC.  
 4-10-08  
 REVISED: h23:08

2 RAILING ELEVATION & CONCEAL SMW  
 SCALE: 1/2" = 1'-0"